


MORRISON GEOTECHNIC PTY LTD

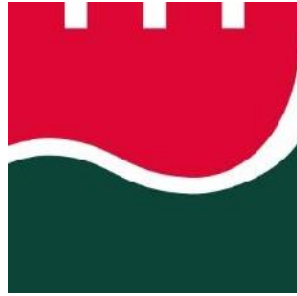

SOLID THINKING // GROUNDED RESULTS

LEVEL ONE COMPLIANCE REPORT

Prepared for:

Shadforths Civil Pty Ltd

DL20/027 – Bulk Earthworks Filling Operations

*Eden's Crossing Estate, Stage 21
Mt Juillerat Drive, Redbank Plains*

*Morrison Geotechnic Pty Ltd
ABN: 51 009 878 899
www.morrisongeo.com.au
a: Unit 1, 35 Limestone Street
Darra, Qld, 4076
Ph: (07) 3279 0900*

21st April 2020

Brisbane Office
 Job No: DL20/027
 Ref No: 16058
 Author: R. Mitchell

21st April 2020

Shadforths Civil Pty Ltd
 99 Sandalwood Lane
 Forest Glen Qld 4556

ATTENTION: MR MICHAEL PRITCHARD
 Email: Michael.Pritchard@shadcivil.com.au

Dear Sir,

**RE: LEVEL ONE COMPLIANCE REPORT FOR
 BULK EARTHWORKS FILLING OPERATIONS
 EDEN'S CROSSING ESTATE, STAGE 21
 MT JULLERAT DRIVE, REDBANK PLAINS**

Table of Contents

1.0	INTRODUCTION	2
1.1	General.....	2
1.2	Previous Earthworks.....	2
1.3	The Project.....	2
2.0	THE BRIEF	4
3.0	METHODOLOGY	4
3.1	Stripped Surface Assessment.....	4
3.2	Filling Operations	5
4.0	STATEMENT OF COMPLIANCE	8
5.0	EXCLUSIONS	8
6.0	LIMITATIONS	8
	ATTACHMENTS:	9
	Appendix A – Site Plan Showing Test Locations	9
	Appendix B – Laboratory Test Results Reports	9

1.0 INTRODUCTION


1.1 General

This report presents results of Level One Earthworks Inspections and associated Compaction Compliance testing carried out on Earthworks Fill constructed to form Residential Lots and embankments below subgrade at Eden's Crossing Estate Stages 21, Mount Juillerat Drive, Redbank Plains (The Site).

The work was commissioned by Mr. Michael Pritchard representing Shadforth Civil Pty Ltd (The Client), using Purchase Order 426750.

Earthworks operations were constructed by Shadforths Civil intermittently between 21st January 2020 and 24th March 2020 and CCA Winslow between May 2017 and March 2018.

Picture 1: Aerial View of the Site (Image Source: Nearmap.com 5th April 2020)

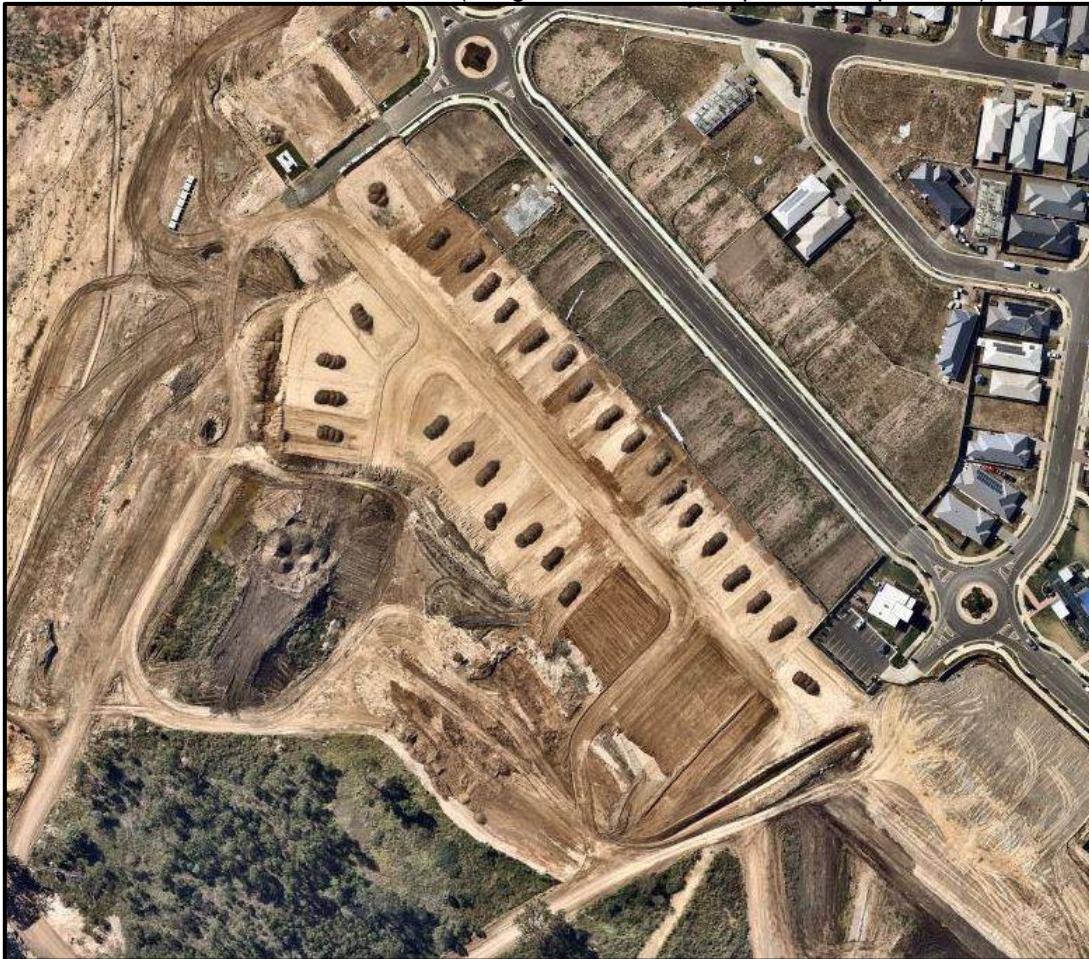

1.2 Previous Earthworks

As far as could be determined onsite, no previous earthworks have been carried out prior to May 2017.

1.3 The Project

The purpose for filling at The Site is to construct a Residential Subdivision which includes new pavements, residential building platforms and associated underground services.

KN Group Pty Ltd, Bulk Earthworks Contour Plan, Drawing No. 18-221-04, Sheet No. 04 of 25 Revision A, October 2019, indicates the extents and thickness of fill to be constructed at The Site.


The plan is considered a reasonable representation of the fill covered by this report.

The actual thickness of fill on an individual Lot can be obtained from the Developer as a Lot Disclosure Plan.

The Site is located within the Eden's Crossing Development and is bounded by future residential stages to the South, East and West, and existing residential developments to the North.

The area of works completed by CCA Winslow between May 2017 and March 2018 is presented below.

Figure 1: Area of Earthworks Completed by CCA Winslow (Stage 21 Shaded Orange).

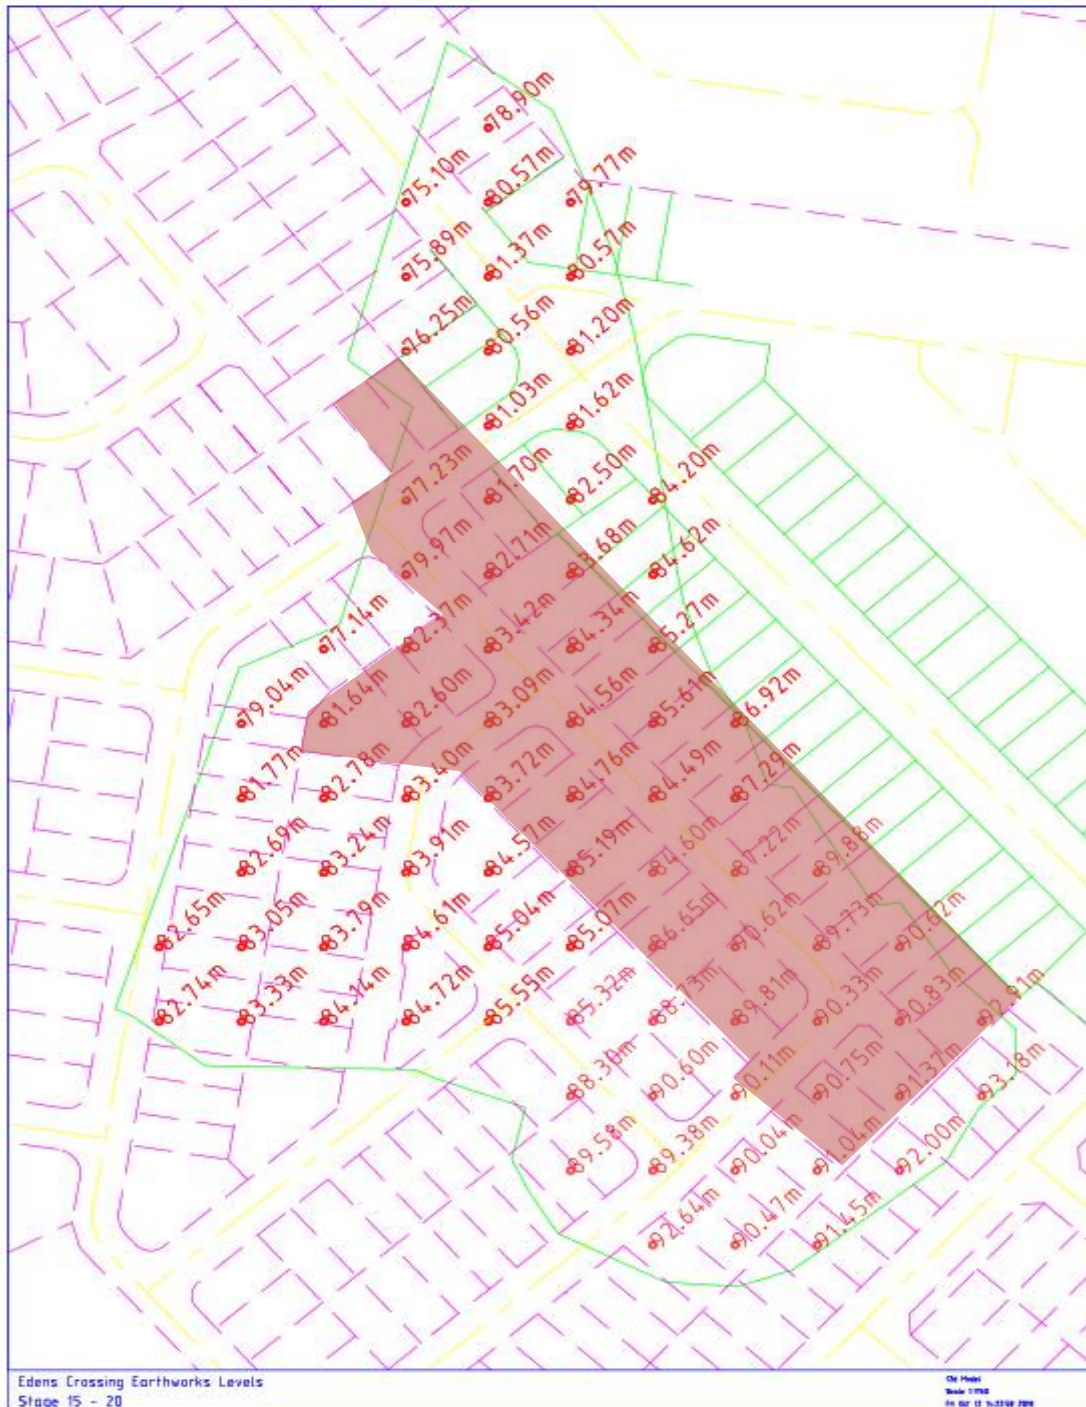

2.0 THE BRIEF

The Brief from the Client was limited to:

- Level One Inspection and Testing of the placement and compaction of fill materials in accordance with AS3798 2007 – “Guidelines on Earthworks for Commercial and Residential Developments”,
- Relative Density Control Testing in accordance with AS1289 – Testing of Soils for Engineering Purposes and at frequencies required in AS3798 Table 8.1.
- Ipswich City Council Project Specifications
- Notes on KN Group Pty Ltd Earthworks Drawings.

Low reactive fill materials the was used as 1.7m thick capping over potentially reactive soils was to generally conform to the following criteria: -

- Shrink Swell Index (Iss) – 1% Max.
- California Bearing Ratio – $\geq 15\%$
- Particle Size Distribution:
 - Max Particle Size – 26.5mm
 - % Passing 0.075mm - $\geq 15\%$
- Plasticity:
 - Liquid Limit – $\leq 35\%$
 - Plasticity Index – $> 6\% < 12\%$
- Permeability - 5×10^{-7} m/s Max.

3.0 METHODOLOGY

Earthworks Inspection and Testing was carried out on the stripped and exposed ground surfaces and during the placement and compaction of fill materials.

Field and laboratory testing included a walk over assessments of the existing ground conditions, observation of filling and compaction activities and field density testing using a nuclear soil moisture density gauge and Hilf compactions.

All work was carried out in accordance with AS 3798 (Guidelines on Earthworks for Commercial and Residential Developments) and AS1289 (Testing of Soils for Engineering Purposes).

Samples of the fill materials were collected and tested for conformance with the criteria presented in Section 2.

3.1 Stripped Surface Assessment

The fill areas at The Site were observed to be stripped and cleared of visible organic matter, deleterious, loose and unsuitable materials to depths exposing suitable natural ground.

Materials exposed after stripping and clearing the site which formed the natural foundation can be broadly summarised as:

- Natural - Silty Clay (CI - CH) – At least very stiff, medium to high and high plasticity, dark brown, traces of fine to medium grained sands, moist.

- Natural – Sandy Clay (CI) – at least very stiff, medium plasticity, pale brown mottled orange-red, fine to medium grained sand, traces of fine to medium gravel and moist.
- Natural – Basalt Rock (XW) – Extremely weathered, very low strength or better, red – brown – grey.
- Natural Siltstone – (XW) – Extremely weathered, very low strength, orange grey

Following the stripped surface assessment of the fill areas, the natural foundation was approved for filling using the following process:

- Walk over assessments confirming that the competent ground was exposed.
- Proof roll testing using large sized truck carrying out multiple passes confirming no movement of the foundation.

3.2 Filling Operations

Fill materials were sourced from onsite cuts, road box excavations and trench excavations. Materials used as fill can be broadly summarized as: -

- Lower Fill Materials – Below 1.2m from the finished earthworks levels
 - Silty Clay, (CI), medium to high plasticity, dark brown, traces of fine to medium sand and moist.
 - Sandy Clay (CI), medium plasticity fines, red – brown, fine to coarse sand, traces of fine to medium gravel and moist.
- Capping Materials – Upper 1.2m of the fill profile imported from Select Sources Onsite and WMI.
 - Clayey Sand (SC), fine to coarse sand, yellow – orange – brown, medium plasticity fines, traces of fine to medium gravel, and moist.
 - Ripped Sandstone – Gravelly Clayey Sand, fine to coarse sands, low plasticity, fine to coarse gravels, grey orange brown.
 - Ripped Basalt – Gravelly Sandy Clay, medium plasticity fines, fine to coarse sands, fine to coarse gravels – brown, dark brown.

Samples of the capping materials were collected and testing generally conformed with the criteria presented in Section 2 and are summarised below in Table 1. Test reports are attached.

Table 1 – Summary of Capping Materials Test Results.

Lab #	Particle Size Passing %		Plasticity Index			Shrink/Swell Index (ISS)	California Bearing Ratio
	26.5mm	0.075mm	LL	PI	LS		
D20-6667A	100	16	32	17	6.5	0.4	35
D20-6667B	100	20	25	7	0.5	0.2	18
D20-7175A	99	19	32	16	6.0	0.1	35
D20-7187A	100	24	29	12	5.5	0.7	19
D20-7211A	92	19	29	13	5.0	0.4	18
D20-7186A	100	21	32	16	6.5	0.1	11
D20-7236A	100	19	31	14	6.5	0.2	14
D20-7236B	100	21	30	14	5.5	0.7	10
D20-7236C	100	22	30	14	5.0	0.2	17
D20-7236D	100	21	32	16	5.5	0.3	8
D20-7236E	100	21	32	16	5.5	0.1	11

The tested materials generally conform with the specification with outliers in Plasticity Index (PI) testing above specification. However this is not considered to affect the performance of the fill as the Shrink Swell Index testing meets the Specification.

Placement and compaction of the fill materials was carried out using the following plant:

- Dozer
- Excavators
- Pad foot Roller
- Scrapers
- Water Truck
- Body Trucks
- 815 Compactor
- Grader
- Side Tippers
- 825 Compactor

The fill materials were moisture conditioned at the fill source and during placement to moisture contents suitable for compaction. Deleterious materials such as organics, sticks, roots and over size particles were sorted and removed during placement or were rejected for use.

Placement of the fill materials was carried out in layers appropriate for the above plant and compacted using the above plant carrying out multiple passes.

Our representative observed the filling process as described above and was assessed to be consistent for the entire thickness of fill.

Field density tests and laboratory compactions were carried out on the fill materials in accordance with Table 5.1 and 8.1 of AS3798 2007 (Guidelines on Earthworks for Commercial and Residential Developments) and tested to AS1289 test methods (Testing of Soils for Engineering Purposes). Testing achieved the required specification of 95% of the Hilf Density

Fill placed and compacted at measured density ratios less than 95% were tyned, moisture conditioned and re-compacted until the required specification was achieved. Retesting was carried out using Random Stratified Location methods.

The Location of the field density tests are shown on the Site Plans contained in Appendix A. These test locations and levels were not obtained by survey and therefore should only be considered as approximate.

Picture 3: View of the Site During Construction



Picture 4: View of the Site During Construction



4.0 STATEMENT OF COMPLIANCE

Our representatives observed the relevant earthworks operations including the stripped surface, fill placement and compaction operations and carried out field density tests and laboratory compaction tests in accordance with the required standard (AS3798, AS1289) and Specification. Testing achieved the required specification of 95% Standard at the test locations.

It is confirmed that Level One Inspection and Testing has been carried out on the earthworks fill to form the residential Lots and embankments below subgrade. Based on the observations made by our Geotechnicians and the results of the field and laboratory tests, the placed and compacted fill at the above project has, as far as we have been able to assess, been constructed in general accordance with the intent of AS3798 and the Specifications.

The fill can be deemed to be “controlled” in accordance with AS2870.

5.0 EXCLUSIONS

This statement does not include any topsoil, which may be placed for use as dressing, trench backfill or any other subsequent earthworks after 24th March 2020.

Assessments of material quality such as soaked CBR and site classifications are excluded from this commission.

Our on-site attendance specifically excludes assessments of fill material quality and engineering properties that are outside the requirements of AS3798 – 2007.

Footings and ground slabs for any structures constructed over natural soils or controlled fill should be designed to accommodate the characteristic ground surface movements and settlement potential.

Assessments of these design parameters are beyond the scope of this Report.

6.0 LIMITATIONS

This Report has been prepared by Morrison Geotechnic Pty Ltd (**Morrison Geotechnic**), and may include contributions from Morrison Geotechnic’s officers and employees, sub-contractors, sub-consultants or agents (**Contributors**).

This Report is for the sole benefit and use of Shadforth Civil Pty Ltd (**Client**), its designers, clients and relevant statutory authorities for the sole purpose of providing geotechnical advice and recommendations in respect of the Eden’s Crossing Estate, Stage 21, Mount Juillerat Drive, Redbank Plains (**Project**). The Report is only intended to address those issues expressly described in the Brief/ Work Instructions in this Report.

This Report should not be used or relied upon for any other purpose without Morrison Geotechnic’s prior written consent. Morrison Geotechnic and the Contributors do not accept any responsibility or liability in any way whatsoever for the use or reliance of this Report by anyone other than Shadforth Civil (**Client**), its designers, its clients and relevant statutory authorities or by anyone else for any purpose other than that for which it has been prepared.

Except with Morrison Geotechnic’s prior written consent, this Report may not be:

- (a) released to any other party, whether in whole or in part (other than to the Client’s officers, employees, advisers, designers, clients and relevant statutory authorities);
- (b) used or relied upon by any other party.

Morrison Geotechnic and the Contributors do not accept any liability or responsibility whatsoever for, or in respect of, any use or reliance upon this Report by any other party. Morrison Geotechnic is not obliged to enter into discussions with any third party in respect of this Report.

The information (including technical information and information obtained through discussions) on which this report is based has been provided by the Client and third parties. Morrison Geotechnic and the Contributors:

- (a) have relied upon and presumed the accuracy of this information;
- (b) have not verified the accuracy or reliability of this information (other than as expressly stated in this Report);
- (c) have not made any independent investigations or enquiries in respect of those matters of which it has no actual knowledge at the time of giving this Report to the Client; and
- (d) make no warranty or guarantee, expressed or implied, as to the accuracy or reliability of this information.

Morrison Geotechnic and the Contributors do not accept responsibility or liability for any incorrect assumptions related to this Report. For the avoidance of doubt, this Report:

- (a) is not an environmental, contamination or hazardous materials assessment; may be invalid, incomplete or inaccurate (including errors in the scope of work, investigation methodology, observations, opinions and advice) where the information provided to Morrison Geotechnic was invalid, incomplete or inaccurate;
- (b) is limited to observations of those parts of the site described in Section 1.0.

No warranty or guarantee, whether express or implied, is made in respect of the geotechnical data, information, advice, opinions and recommendations present in this Report.

If further information becomes available, or additional assumptions need to be made, Morrison Geotechnic reserves its right to amend this Report.

If you have any queries regarding the above, please contact our Brisbane office.

Yours faithfully



RHYS MITCHELL

For and on behalf of

MORRISON GEOTECHNIC PTY LIMITED

ATTACHMENTS:


Appendix A – Site Plan Showing Test Locations

Appendix B – Laboratory Test Reports

APPENDIX A

SITE PLAN

TEST LOCATIONS

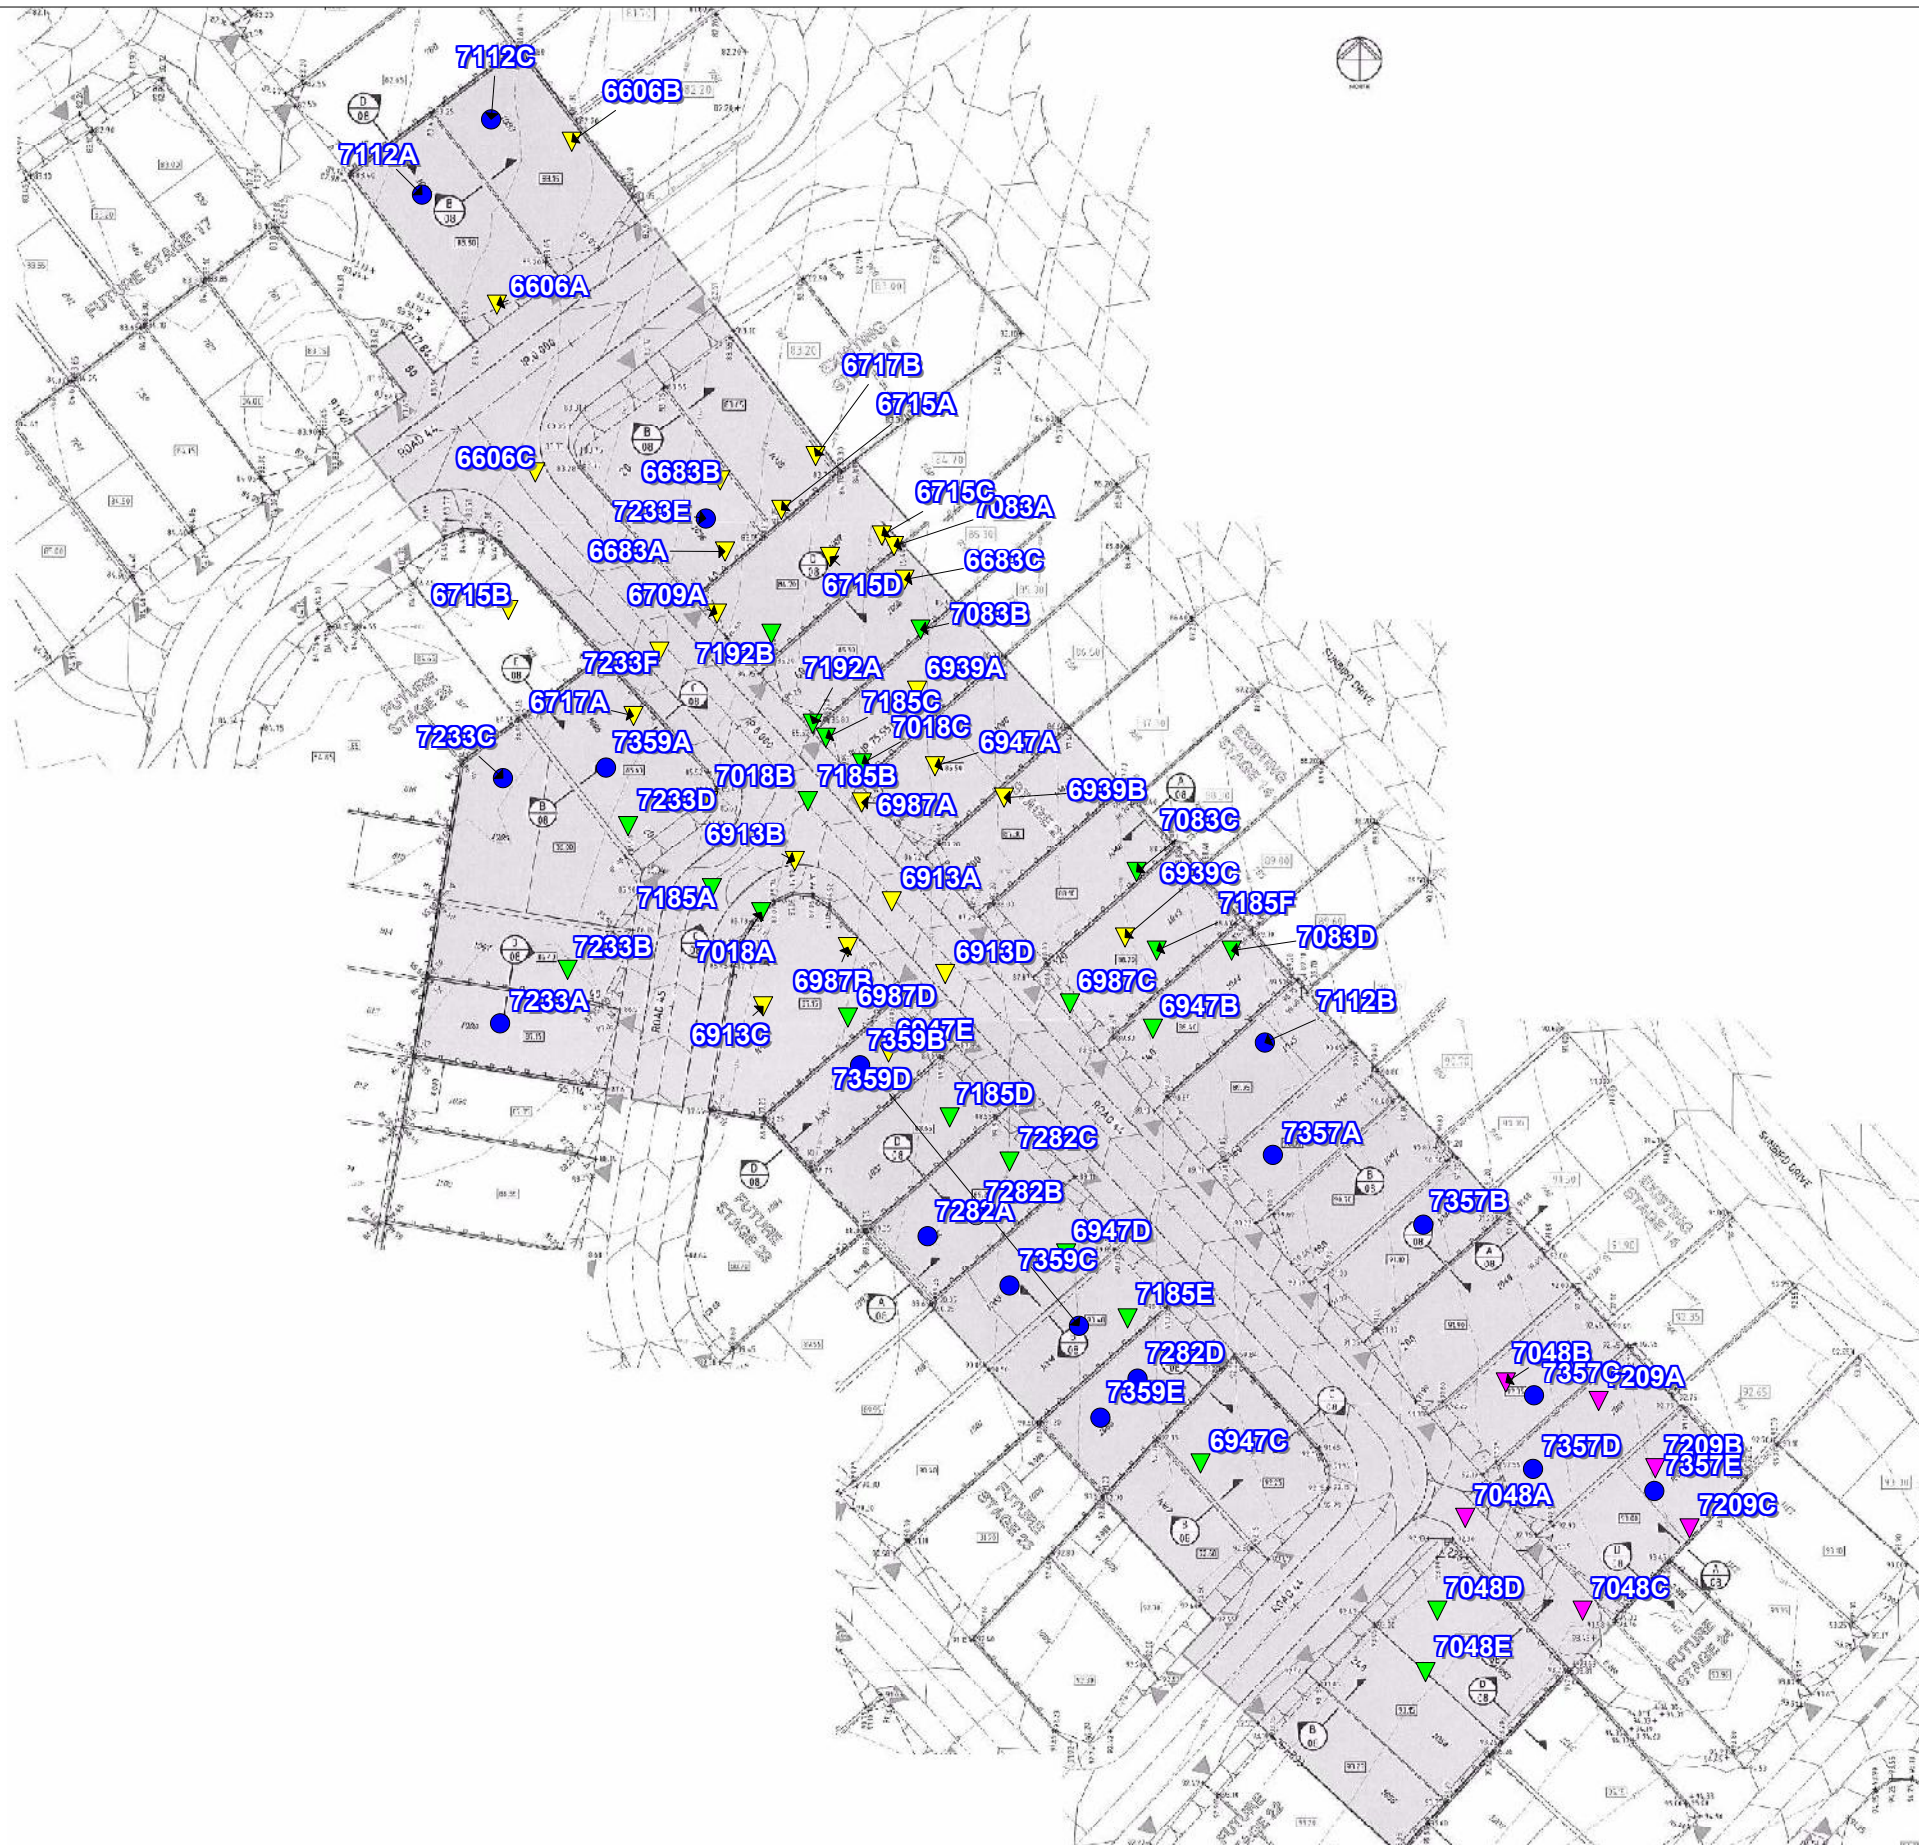

MORRISON GEOTECHNIC PTY LTD

ABN: 51 009 878 899

Unit 1/ 35 Limestone St, Darra 4076 Ph: 3279 0900
 Email: brisbanelab@morrisongeo.com.au

Engineers: M. Ballard
 D. Dragun
 Geologists: R. Howchin
 Laboratory: M. Morrison

LEGEND

- ▼ R.L 80.0 - 84.99
- ▼ R.L 85.0 - 89.99
- ▼ R.L 90.0 - 94.99
- Final Level

Map Description :	EARTHWORKS FIELD DENSITY TESTING - Level 1 Inspection		
Client :	SHADFORTHS PTY LTD		
Project :	EDENS CROSSING - STAGE 21		
Project No :	DL20/027	Drawing No :	DL20/027 - 01
		Scale :	Not to Scale



MORRISON GEOTECHNIC PTY LTD

ABN: 51 009 878 899

Unit 1/ 35 Limestone St, Darra 4076 Ph: 3279 0900
 Email: brisbanelab@morrisongeo.com.au Fax: 3279 0955

Engineers: D.Riley, J. Daly
 D.Dragun, & S.Wynne
 Geologists: L.Bexley & R.Howchin
 Laboratory: M.Morrison

LEGEND

- ▼ R.L 77.0 - 78.99
- ▼ R.L 79.0 - 80.99
- ▼ R.L 81.0 - 82.99
- ▼ R.L 83.0 - 84.99
- ▼ R.L 85.0 - 86.99
- Final Level

Map Description :	EARTHWORKS FIELD DENSITY TESTING - Level 1 Inspection		
Client :	CCA WINSLOW		
Project :	EDENS CROSSING, FUTURE STAGES 15-20		
Project No :	DL17/398	Drawing No :	DL17/398 - 01
		Scale :	Not to Scale

APPENDIX B

Laboratory Test Results Reports

Material Test Report

Report Number: DL20/027-6D
Issue Number: 1
Date Issued: 13/02/2020
Client: SHADFORTH'S CIVIL PTY LTD
 99 SANDALWOOD LANE, FOREST GLEN QLD 4556
Project Number: DL20/027
Project Name: EARTHWORKS SUPERVISION
Project Location: EDEN'S CROSSING, STAGE 21
Work Request: 6667
Sample Number: D20-6667B
Date Sampled: 28/01/2020
Dates Tested: 28/01/2020 - 12/02/2020
Sample Location: E: 484322, N: 6938458
Material: Capping Material
Material Source: White Rock Quarry / Sandstone




Accredited for compliance with ISO/IEC 17025 - Testing

Approved Signatory: Kiri Pitama
 Laboratory Technician
 NATA Accredited Laboratory Number: 1169

Particle Size Distribution (AS1289 3.6.1)				
Sieve	Passed %	Passing Limits	Retained %	Retained Limits
13.2 mm	100		0	
9.5 mm	100		0	
6.7 mm	99		1	
4.75 mm	99		0	
2.36 mm	97		2	
1.18 mm	89		7	
0.6 mm	76		13	
0.425 mm	63		13	
0.3 mm	47		16	
0.15 mm	26		21	
0.075 mm	20		7	

Atterberg Limit (AS1289 3.9.1 & 3.2.1 & 3.3.2)		Min	Max
Sample History	Oven Dried		
Preparation Method	Dry Sieve		
Liquid Limit (%)	25		
Plastic Limit (%)	18		
Plasticity Index (%)	7		
Weighted Plasticity Index (%)	444		

Linear Shrinkage (AS1289 3.4.1)		Min	Max
Linear Shrinkage (%)	0.5		
Cracking Crumbling Curling	None		

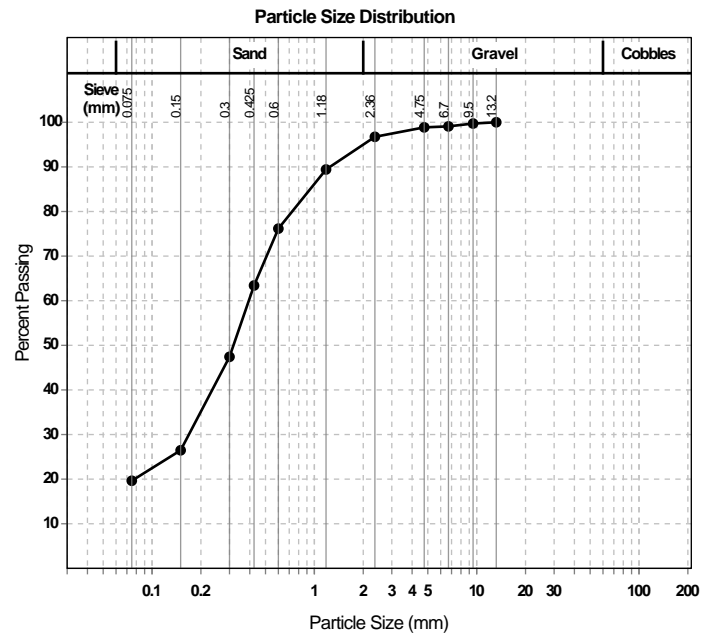

Material Test Report



Brisbane | Gold Coast | Maroochydore

Morrison Geotechnic Pty Ltd

ABN: 51 009 878 899

Brisbane Laboratory

Unit 1, 35 Limestone Darra QLD 4076

Phone: (07) 3279 0900

Email: greg@mgeo.com.au

Report Number: DL20/027-12
Issue Number: 1
Date Issued: 09/03/2020
Client: SHADFORTH'S CIVIL PTY LTD
 99 SANDALWOOD LANE, FOREST GLEN QLD 4556
Project Number: DL20/027
Project Name: EARTHWORKS SUPERVISION
Project Location: EDEN'S CROSSING, STAGE 21
Work Request: 7083
Date Sampled: 05/03/2020 08:00
Dates Tested: 05/03/2020 - 06/03/2020
Sampling Method: AS1289 1.2.1 6.4 (b) - Sampling from layers in earthworks or pavement - compacted
Specification: 95% STD
Site Selection: Selected by GTA
Material: Allotment Fill
Material Source: Onsite Cut



Accredited for compliance with ISO/IEC 17025 - Testing

Approved Signatory: Greg Gibson
 Senior Technician

NATA Accredited Laboratory Number: 1169

Compaction Control AS 1289 5.7.1 & 5.8.1 & 2.1.1				
Sample Number	D20-7083A	D20-7083B	D20-7083C	D20-7083D
Date Tested	05/03/2020	05/03/2020	05/03/2020	05/03/2020
Time Tested	08:15	08:20	08:30	08:40
Test Request #/Location	Stage 21	Stage 21	Stage 21	Stage 21
Easting	484143.74	484151.84	484170.41	484184.22
Northing	6939800.05	6939794.66	6939744.134	6939752.62
Elevation (m)	84.56	85.19	87.18	87.91
Soil Description	Allotment Fill	Allotment Fill	Allotment Fill	Allotment Fill
Test Depth (mm)	150	150	150	150
Sieve used to determine oversize (mm)	19.0	19.0	19.0	19.0
Percentage of Wet Oversize (%)	0.0	0.0	0.0	0.0
Field Wet Density (FWD) t/m ³	2.20	2.17	2.22	2.24
Field Moisture Content %	16.5	15.4	9.2	16.0
Field Dry Density (FDD) t/m ³	1.89	1.88	2.03	1.93
Peak Converted Wet Density t/m ³	2.15	2.16	2.16	2.15
Adjusted Peak Converted Wet Density t/m ³	**	**	**	**
Moisture Variation (Wv) %	0.5	1.5	0.5	2.5
Adjusted Moisture Variation %	**	**	**	**
Hilf Density Ratio (%)	102.0	100.0	102.5	104.5
Compaction Method	Standard	Standard	Standard	Standard

Moisture Variation Note:

Positive values = test is dry of OMC
 Negative values = test is wet of OMC

Material Test Report

Report Number: DL20/027-12
Issue Number: 1
Date Issued: 09/03/2020
Client: SHADFORTH'S CIVIL PTY LTD
 99 SANDALWOOD LANE, FOREST GLEN QLD 4556
Project Number: DL20/027
Project Name: EARTHWORKS SUPERVISION
Project Location: EDEN'S CROSSING, STAGE 21
Work Request: 7083
Date Sampled: 05/03/2020 08:00
Dates Tested: 05/03/2020 - 06/03/2020
Sampling Method: AS1289 1.2.1 6.4 (b) - Sampling from layers in earthworks or pavement - compacted
Specification: 95% STD
Site Selection: Selected by GTA
Material: Allotment Fill
Material Source: Onsite Cut



Accredited for compliance with ISO/IEC 17025 - Testing

Approved Signatory: Greg Gibson
 Senior Technician
 NATA Accredited Laboratory Number: 1169

Compaction Control AS 1289 5.7.1 & 5.8.1 & 2.1.1				
Sample Number	D20-7083E	D20-7083F	D20-7083G	D20-7083H
Date Tested	05/03/2020	05/03/2020	05/03/2020	05/03/2020
Time Tested	08:45	10:20	10:30	10:40
Test Request #/Location	Stage 21	Stage 21	Stage 21	Stage 21
Easting	484191.57	484149.25	484143.176	484141.10
Northing	6939744.134	6939711.26	6939722.160	6939732.30
Elevation (m)	88.5	87.8	86.86	82.40
Soil Description	Allotment Fill	Allotment Fill	Allotment Fill	Allotment Fill
Test Depth (mm)	150	150	150	150
Sieve used to determine oversize (mm)	19.0	19.0	19.0	19.0
Percentage of Wet Oversize (%)	0.0	0.0	0.0	0.0
Field Wet Density (FWD) t/m ³	2.26	2.12	2.10	2.08
Field Moisture Content %	14.1	9.4	9.1	9.4
Field Dry Density (FDD) t/m ³	1.98	1.94	1.92	1.90
Peak Converted Wet Density t/m ³	2.16	2.04	2.05	2.06
Adjusted Peak Converted Wet Density t/m ³	**	**	**	**
Moisture Variation (Wv) %	2.0	2.0	2.5	2.0
Adjusted Moisture Variation %	**	**	**	**
Hilf Density Ratio (%)	104.5	104.0	102.5	101.0
Compaction Method	Standard	Standard	Standard	Standard

Moisture Variation Note:

Positive values = test is dry of OMC
 Negative values = test is wet of OMC

Material Test Report



Brisbane | Gold Coast | Maroochydore

Morrison Geotechnic Pty Ltd

ABN: 51 009 878 899

Brisbane Laboratory

Unit 1, 35 Limestone Darra QLD 4076

Phone: (07) 3279 0900

Email: greg@mgeo.com.au

Report Number: DL20/027-5
Issue Number: 1
Date Issued: 11/02/2020
Client: SHADFORTH'S CIVIL PTY LTD
 99 SANDALWOOD LANE, FOREST GLEN QLD 4556
Project Number: DL20/027
Project Name: EARTHWORKS SUPERVISION
Project Location: EDEN'S CROSSING, STAGE 21
Work Request: 6715
Date Sampled: 31/01/2020
Dates Tested: 31/01/2020 - 04/02/2020
Sampling Method: AS1289 1.2.1 6.4 (b) - Sampling from layers in earthworks or pavement - compacted
Specification: 95% STD
Site Selection: Selected by GTA
Material: General Fill
Material Source: Import



Accredited for compliance with ISO/IEC 17025 - Testing

Approved Signatory: Greg Gibson
 Senior Technician

NATA Accredited Laboratory Number: 1169

Compaction Control AS 1289 5.7.1 & 5.8.1 & 2.1.1				
Sample Number	D20-6715A	D20-6715B	D20-6715C	D20-6715D
Date Tested	31/01/2020	31/01/2020	31/01/2020	31/01/2020
Time Tested	11:15	11:35	12:45	13:15
Test Request #/Location	Re-Test D20-6683A	Re-Test D20-6683B	Re-Test D20-6683C	Re-Test D20-6709A
Easting	484125.08	484129.86	484162.02	48124.32
Northing	6939806.64	6939814.74	6939811.56	6939803.04
Elevation (m)	RL: 82.78	RL: 82.65	RL: 83.47	RL: 83.21
Soil Description	Clayey Sand. Brown	Clayey Sand. Brown	Clayey Sand. Brown	Clayey Sand. Brown
Test Depth (mm)	150	150	150	150
Sieve used to determine oversize (mm)	19.0	19.0	19.0	19.0
Percentage of Wet Oversize (%)	8.9	12.3	8.9	18.4
Field Wet Density (FWD) t/m ³	2.17	2.17	2.26	2.21
Field Moisture Content %	34.9	14.9	14.2	16.0
Field Dry Density (FDD) t/m ³	1.61	1.89	1.98	1.90
Peak Converted Wet Density t/m ³	**	**	**	**
Adjusted Peak Converted Wet Density t/m ³	2.21	2.23	2.18	2.19
Moisture Variation (Wv) %	**	**	**	**
Adjusted Moisture Variation %	0.5	-1.5	1.0	0.0
Hilf Density Ratio (%)	98.5	97.0	103.5	100.5
Compaction Method	Standard	Standard	Standard	Standard

Moisture Variation Note:

Positive values = test is dry of OMC

Negative values = test is wet of OMC

Material Test Report



Brisbane | Gold Coast | Maroochydore

Morrison Geotechnic Pty Ltd

ABN: 51 009 878 899

Brisbane Laboratory

Unit 1, 35 Limestone Darra QLD 4076

Phone: (07) 3279 0900

Email: jwieland@mgeo.com.au

Report Number: DL20/027-19A
Issue Number: 1
Date Issued: 24/03/2020
Client: SHADFORTH'S CIVIL PTY LTD
 99 SANDALWOOD LANE, FOREST GLEN QLD 4556
Project Number: DL20/027
Project Name: EARTHWORKS SUPERVISION
Project Location: EDEN'S CROSSING, STAGE 21
Work Request: 7187
Sample Number: D20-7187A
Date Sampled: 13/03/2020
Dates Tested: 13/03/2020 - 19/03/2020
Sampling Method: AS 1289.1.2.1 6.4 (b) - Sampling from layers in earthworks or pavement - compacted
Sample Location: E: 484154, N: 6939727, Depth: RL87.1
Lot No: Capping Material
Material: (SC) Clayey Sand Brown
Material Source: Onsite Borrow Pit




Accredited for compliance with ISO/IEC 17025 - Testing

Approved Signatory: John Wieland

Senior Soil Technician

NATA Accredited Laboratory Number: 1169

California Bearing Ratio (AS 1289 6.1.1 & 2.1.1)		Min	Max
CBR taken at	5 mm		
CBR %	19		
Method of Compactive Effort	Standard		
Method used to Determine MDD	AS 1289 5.1.1 & 2.1.1		
Method used to Determine Plasticity	VISUAL		
Maximum Dry Density (t/m ³)	1.82		
Optimum Moisture Content (%)	12.5		
Laboratory Density Ratio (%)	100.0		
Laboratory Moisture Ratio (%)	100.0		
Dry Density after Soaking (t/m ³)	1.82		
Field Moisture Content (%)	10.2		
Moisture Content at Placement (%)	12.6		
Moisture Content Top 30mm (%)	13.1		
Moisture Content Rest of Sample (%)	14.5		
Mass Surcharge (kg)	4.5		
Soaking Period (days)	4		
Curing Hours	24		
Swell (%)	0.0		
Oversize Material (mm)	19		
Oversize Material Included	Excluded		
Oversize Material (%)			

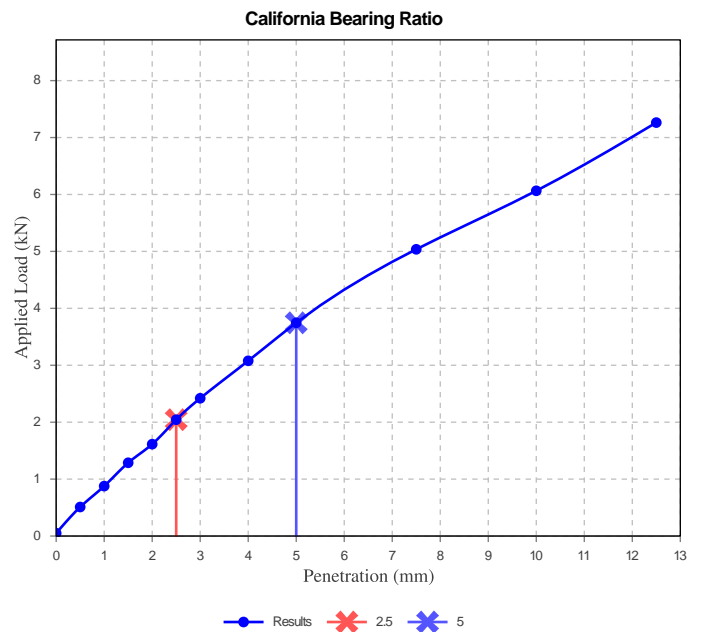

Material Test Report



Brisbane | Gold Coast | Maroochydore

Morrison Geotechnic Pty Ltd

ABN: 51 009 878 899

Brisbane Laboratory

Unit 1, 35 Limestone Darra QLD 4076

Phone: (07) 3279 0900

Email: jwieland@mgeo.com.au

Report Number: DL20/027-1
Issue Number: 1
Date Issued: 30/01/2020
Client: SHADFORTH'S CIVIL PTY LTD
 99 SANDALWOOD LANE, FOREST GLEN QLD 4556
Project Number: DL20/027
Project Name: EARTHWORKS SUPERVISION
Project Location: EDEN'S CROSSING, STAGE 21
Work Request: 6606
Date Sampled: 22/01/2020
Dates Tested: 22/01/2020 - 24/01/2020
Sampling Method: AS1289 1.2.1 6.4 (b) - Sampling from layers in earthworks or pavement - compacted
Specification: 95% STD
Site Selection: Selected by GTA
Material: Allotment Fill
Material Source: onsite



Accredited for compliance with ISO/IEC 17025 - Testing

Approved Signatory: John Wieland
 Senior Soil Technician
 NATA Accredited Laboratory Number: 1169

Compaction Control AS 1289 5.7.1 & 5.8.1 & 2.1.1			
Sample Number	D20-6606A	D20-6606B	D20-6606C
Date Tested	22/01/2020	22/01/2020	22/01/2020
Time Tested	13:30	13:40	13:50
Test Request #/Location	STG 21 - Lot Fill	STG 21 - Lot Fill	STG 21 - Road 44
Easting	484124	484102	484092
Northing	6939816	6939860	6939813
Layer / Reduced Level	1.2m Below F/L	1.2m Below F/L	0.8m Below F/L
Soil Description	Sandy Gravelly C2lay. Brown	Sandy Gravelly Clay. Brown	Sandy Gravelly Clay. Brown
Test Depth (mm)	150	150	150
Sieve used to determine oversize (mm)	19.0	19.0	19.0
Percentage of Wet Oversize (%)	3.0	0.0	0.0
Field Wet Density (FWD) t/m ³	2.13	2.08	2.07
Field Moisture Content %	**	**	14.1
Field Dry Density (FDD) t/m ³	**	**	1.82
Peak Converted Wet Density t/m ³	**	2.09	1.93
Adjusted Peak Converted Wet Density t/m ³	2.05	**	**
Moisture Variation (Wv) %	**	1.5	3.0
Adjusted Moisture Variation %	2.5	**	**
Hilf Density Ratio (%)	104.0	99.5	107.0
Compaction Method	Standard	Standard	Standard

Moisture Variation Note:

Positive values = test is dry of OMC
 Negative values = test is wet of OMC

Material Test Report



Brisbane | Gold Coast | Maroochydore

Morrison Geotechnic Pty Ltd

ABN: 51 009 878 899

Brisbane Laboratory

Unit 1, 35 Limestone Darra QLD 4076

Phone: (07) 3279 0900

Email: jwieland@mgeo.com.au

Report Number: DL20/027-2
Issue Number: 1
Date Issued: 31/01/2020
Client: SHADFORTH'S CIVIL PTY LTD
 99 SANDALWOOD LANE, FOREST GLEN QLD 4556
Project Number: DL20/027
Project Name: EARTHWORKS SUPERVISION
Project Location: EDEN'S CROSSING, STAGE 21
Work Request: 6683
Date Sampled: 29/01/2020
Dates Tested: 29/01/2020 - 30/01/2020
Sampling Method: AS1289 1.2.1 6.4 (b) - Sampling from layers in earthworks or pavement - compacted
Specification: 95% STD
Site Selection: Selected by GTA
Material: General Fill
Material Source: Import (on site stockpile)



Accredited for compliance with ISO/IEC 17025 - Testing

Approved Signatory: John Wieland
 Senior Soil Technician

NATA Accredited Laboratory Number: 1169

Compaction Control AS 1289 5.7.1 & 5.8.1 & 2.1.1			
Sample Number	D20-6683A	D20-6683B	D20-6683C
Date Tested	29/01/2020	29/01/2020	29/01/2020
Time Tested	12:41	13:07	13:35
Test Request #/Location	General Fill Area Stage 21	General Fill Area Stage 21	General Fill Area Stage 21
Easting	484125.08	484129.86	484162.02
Northing	6939806.64	6939814.74	6939811.56
Elevation (m)	82.78	82.65	83.47
Soil Description	(CI) Sandy Clay - Yellow Brown	(CI) Sandy Clay - Yellow Brown	(CI) Sandy Clay - Yellow Brown
Test Depth (mm)	150	150	150
Sieve used to determine oversize (mm)	37.5	37.5	37.5
Percentage of Wet Oversize (%)	**	**	**
Field Wet Density (FWD) t/m ³	1.96	1.96	1.94
Field Moisture Content %	9.9	10.4	12.9
Field Dry Density (FDD) t/m ³	1.79	1.78	1.72
Peak Converted Wet Density t/m ³	2.08	2.07	2.11
Adjusted Peak Converted Wet Density t/m ³	**	**	**
Moisture Variation (Wv) %	3.0	1.5	0.5
Adjusted Moisture Variation %	**	**	**
Hilf Density Ratio (%)	94.5	94.5	92.0
Compaction Method	Standard	Standard	Standard

Moisture Variation Note:

Positive values = test is dry of OMC

Negative values = test is wet of OMC

Material Test Report



Brisbane | Gold Coast | Maroochydore

Morrison Geotechnic Pty Ltd

ABN: 51 009 878 899

Brisbane Laboratory

Unit 1, 35 Limestone Darra QLD 4076

Phone: (07) 3279 0900

Email: greg@mgeo.com.au

Report Number: DL20/027-3
Issue Number: 1
Date Issued: 11/02/2020
Client: SHADFORTH'S CIVIL PTY LTD
 99 SANDALWOOD LANE, FOREST GLEN QLD 4556
Project Number: DL20/027
Project Name: EARTHWORKS SUPERVISION
Project Location: EDEN'S CROSSING, STAGE 21
Work Request: 6709
Date Sampled: 30/01/2020
Dates Tested: 30/01/2020 - 03/02/2020
Sampling Method: AS1289 1.2.1 6.4 (b) - Sampling from layers in earthworks or pavement - compacted
Specification: 95% STD
Site Selection: Selected by GTA
Material: General Fill
Material Source: Import (on site stockpile)



Accredited for compliance with ISO/IEC 17025 - Testing

Approved Signatory: Greg Gibson
 Senior Technician

NATA Accredited Laboratory Number: 1169

Compaction Control AS 1289 5.7.1 & 5.8.1 & 2.1.1			
Sample Number	D20-6709A		
Date Tested	30/01/2020		
Time Tested	14:16		
Test Request #/Location	General Fill Area Stage 21		
Easting	48124.32		
Northing	6939803.04		
Elevation (m)	83.21		
Soil Description	(CH/CI) Sandy Clay - Yellow Brown		
Test Depth (mm)	150		
Sieve used to determine oversize (mm)	19.0		
Percentage of Wet Oversize (%)	12.6		
Field Wet Density (FWD) t/m ³	1.94		
Field Moisture Content %	15.1		
Field Dry Density (FDD) t/m ³	1.68		
Peak Converted Wet Density t/m ³	**		
Adjusted Peak Converted Wet Density t/m ³	2.04		
Moisture Variation (Wv) %	**		
Adjusted Moisture Variation %	1.5		
Hilf Density Ratio (%)	95.0		
Compaction Method	Standard		

Moisture Variation Note:

Positive values = test is dry of OMC

Negative values = test is wet of OMC

Material Test Report

Report Number: DL20/027-6E
Issue Number: 1
Date Issued: 13/02/2020
Client: SHADFORTH'S CIVIL PTY LTD
99 SANDALWOOD LANE, FOREST GLEN QLD 4556
Project Number: DL20/027
Project Name: EARTHWORKS SUPERVISION
Project Location: EDEN'S CROSSING, STAGE 21
Work Request: 6667
Dates Tested: 28/01/2020 - 05/02/2020



Accredited for compliance with ISO/IEC 17025 - Testing



Approved Signatory: Kiri Pitama
Laboratory Technician
NATA Accredited Laboratory Number: 1169

Shrink Swell Index AS 1289 7.1.1 & 2.1.1					
Sample Number	D20-6667A	D20-6667B			
Date Sampled	28/01/2020	28/01/2020			
Date Tested	05/02/2020	05/02/2020			
Material Source	Remoulded	Remoulded			
Sample Location	E: 484309, N: 6938481	E: 484322, N: 6938458			
Inert Material Estimate (%)	**	**			
Pocket Penetrometer before (kPa)	-	-			
Pocket Penetrometer after (kPa)	190	360			
Shrinkage Moisture Content (%)	10.7	13.4			
Shrinkage (%)	0.8	0.4			
Swell Moisture Content Before (%)	10.6	13.3			
Swell Moisture Content After (%)	18.0	14.7			
Swell (%)	0.0	0.0			
Shrink Swell Index I _{ss} (%)	0.4	0.2			
Visual Description	Sandy Clay	Sandy Clay			
Cracking	SC	SC			
Crumbling	Yes	Yes			
Remarks	**	**			

Shrink Swell Index (I_{ss}) reported as the percentage vertical strain per pF change in suction.
NATA Accreditation does not cover the performance of pocket penetrometer readings.

Material Test Report



Brisbane | Gold Coast | Maroochydore

Morrison Geotechnic Pty Ltd

ABN: 51 009 878 899

Brisbane Laboratory

Unit 1, 35 Limestone Darra QLD 4076

Phone: (07) 3279 0900

Email: greg@mgeo.com.au

Report Number: DL20/027-14
Issue Number: 1
Date Issued: 17/03/2020
Client: SHADFORTH'S CIVIL PTY LTD
 99 SANDALWOOD LANE, FOREST GLEN QLD 4556
Project Number: DL20/027
Project Name: EARTHWORKS SUPERVISION
Project Location: EDEN'S CROSSING, STAGE 21
Work Request: 7192
Date Sampled: 14/03/2020 11:30
Dates Tested: 14/03/2020 - 17/03/2020
Sampling Method: AS 1289.1.2.1 6.4 (b) - Sampling from layers in earthworks or pavement - compacted
Specification: 95% STD
Site Selection: Selected by GTA
Material: Capping Layer
Material Source: Onsite Borrow Pit



Accredited for compliance with ISO/IEC 17025 - Testing

Approved Signatory: Greg Gibson
 Senior Technician

NATA Accredited Laboratory Number: 1169

Compaction Control AS 1289 5.7.1 & 5.8.1 & 2.1.1			
Sample Number	D20-7192A	D20-7192B	
Date Tested	14/03/2020	14/03/2020	
Time Tested	11:20	11:30	
Test Request #/Location	Capping Layer	Capping Layer	
Easting	484104	484101	
Northing	6939765	6939773	
Elevation (m)	85.3	85.4	
Soil Description	Clayey Sand. Brown	Clayey Sand. Brown	
Test Depth (mm)	150	150	
Sieve used to determine oversize (mm)	19.0	19.0	
Percentage of Wet Oversize (%)	0.0	0.0	
Field Wet Density (FWD) t/m ³	2.01	2.06	
Field Moisture Content %	7.6	6.7	
Field Dry Density (FDD) t/m ³	1.87	1.93	
Peak Converted Wet Density t/m ³	2.05	2.00	
Adjusted Peak Converted Wet Density t/m ³	**	**	
Moisture Variation (Wv) %	4.0	5.5	
Adjusted Moisture Variation %	**	**	
Hilf Density Ratio (%)	98.0	103.0	
Compaction Method	Standard	Standard	

Moisture Variation Note:

Positive values = test is dry of OMC

Negative values = test is wet of OMC

Material Test Report



Brisbane | Gold Coast | Maroochydore

Morrison Geotechnic Pty Ltd

ABN: 51 009 878 899

Brisbane Laboratory

Unit 1, 35 Limestone Darra QLD 4076

Phone: (07) 3279 0900

Email: greg@mgeo.com.au

Report Number: DL20/027-4
Issue Number: 1
Date Issued: 11/02/2020
Client: SHADFORTH'S CIVIL PTY LTD
 99 SANDALWOOD LANE, FOREST GLEN QLD 4556
Project Number: DL20/027
Project Name: EARTHWORKS SUPERVISION
Project Location: EDEN'S CROSSING, STAGE 21
Work Request: 6717
Date Sampled: 31/01/2020
Dates Tested: 31/01/2020 - 03/02/2020
Sampling Method: AS1289 1.2.1 6.4 (b) - Sampling from layers in earthworks or pavement - compacted
Specification: 95% STD
Site Selection: Selected by GTA
Material: General Fill
Material Source: Import (on site stockpile)



Accredited for compliance with ISO/IEC 17025 - Testing

Approved Signatory: Greg Gibson
 Senior Technician

NATA Accredited Laboratory Number: 1169

Compaction Control AS 1289 5.7.1 & 5.8.1 & 2.1.1			
Sample Number	D20-6717A	D20-6717B	
Date Tested	31/01/2020	31/01/2020	
Time Tested	10:00	10:10	
Test Request #/Location	General Fill Area Stage 21	General Fill Area Stage 21	
Easting	484135.11	484131.27	
Northing	6939806.27	6939812.72	
Elevation (m)	RL: 83.32	RL: 83.66	
Soil Description	Sandy Clay. Brown	Sandy Clay. Brown	
Test Depth (mm)	150	150	
Sieve used to determine oversize (mm)	19.0	19.0	
Percentage of Wet Oversize (%)	12.5	12.4	
Field Wet Density (FWD) t/m ³	2.18	2.23	
Field Moisture Content %	16.2	16.2	
Field Dry Density (FDD) t/m ³	1.88	1.92	
Peak Converted Wet Density t/m ³	**	**	
Adjusted Peak Converted Wet Density t/m ³	2.22	2.23	
Moisture Variation (Wv) %	**	**	
Adjusted Moisture Variation %	-1.0	-1.0	
Hilf Density Ratio (%)	98.0	100.0	
Compaction Method	Standard	Standard	

Moisture Variation Note:

Positive values = test is dry of OMC

Negative values = test is wet of OMC

Material Test Report



Brisbane | Gold Coast | Maroochydore

Morrison Geotechnic Pty Ltd

ABN: 51 009 878 899

Brisbane Laboratory

Unit 1, 35 Limestone Darra QLD 4076

Phone: (07) 3279 0900

Email: greg@mgeo.com.au

Report Number: DL20/027-26
Issue Number: 1
Date Issued: 30/03/2020
Client: SHADFORTH'S CIVIL PTY LTD
 99 SANDALWOOD LANE, FOREST GLEN QLD 4556
Project Number: DL20/027
Project Name: EARTHWORKS SUPERVISION
Project Location: EDEN'S CROSSING, STAGE 21
Work Request: 7359
Date Sampled: 24/03/2020 7:30
Dates Tested: 24/03/2020 - 30/03/2020
Sampling Method: AS 1289.1.2.1 6.4 (b) - Sampling from layers in earthworks or pavement - compacted
Specification: 95% STD
Site Selection: Selected by GTA
Material: Allotment Fill
Material Source: Onsite Cut



Accredited for compliance with ISO/IEC 17025 - Testing

Approved Signatory: Greg Gibson
 Senior Technician

NATA Accredited Laboratory Number: 1169

Compaction Control AS 1289 5.7.1 & 5.8.1 & 2.1.1					
Sample Number	D20-7359A	D20-7359B	D20-7359C	D20-7359D	D20-7359E
Date Tested	24/03/2020	24/03/2020	24/03/2020	24/03/2020	24/03/2020
Time Tested	07:15	07:20	07:30	07:40	07:55
Test Request #/Location	Lot 1095	Lot 1080	Lot 1083	Lot 1084	Lot 1085
Latitude	10m from Rear Boundary	15m from Rear Boundary	7m from Rear Boundary	10m from Rear Boundary	8m from Rear Boundary
Longitude	7m from Right Boundary	4m from Right Boundary	6m from Right Boundary	5m from Right Boundary	6m from Right Boundary
Layer / Reduced Level	F/L	F/L	F/L	F/L	F/L
Soil Description	Gravelly Sandy Clay. Brown	Gravelly Sandy Clay. Brown	Gravelly Sandy Clay. Brown	Gravelly Sandy Clay. Brown	Gravelly Sandy Clay. Brown
Test Depth (mm)	150	150	150	150	150
Sieve used to determine oversize (mm)	19.0	19.0	19.0	19.0	19.0
Percentage of Wet Oversize (%)	6.7	4.3	0.0	0.0	12.1
Field Wet Density (FWD) t/m ³	1.94	2.21	2.06	2.08	2.04
Field Moisture Content %	2.9	7.2	6.1	12.0	14.5
Field Dry Density (FDD) t/m ³	1.88	2.06	1.94	1.86	1.78
Peak Converted Wet Density t/m ³	**	**	1.95	2.06	**
Adjusted Peak Converted Wet Density t/m ³	1.85	2.12	**	**	2.15
Moisture Variation (Wv) %	**	**	4.5	1.0	**
Adjusted Moisture Variation %	4.5	4.5	**	**	0.5
Hilf Density Ratio (%)	105.0	104.0	105.5	101.0	95.0
Compaction Method	Standard	Standard	Standard	Standard	Standard

Moisture Variation Note:

Positive values = test is dry of OMC

Negative values = test is wet of OMC

Material Test Report



Brisbane | Gold Coast | Maroochydore

Morrison Geotechnic Pty Ltd

ABN: 51 009 878 899

Brisbane Laboratory

Unit 1, 35 Limestone Darra QLD 4076

Phone: (07) 3279 0900

Email: greg@mgeo.com.au

Report Number: DL20/027-26
Issue Number: 1
Date Issued: 30/03/2020
Client: SHADFORTH'S CIVIL PTY LTD
 99 SANDALWOOD LANE, FOREST GLEN QLD 4556
Project Number: DL20/027
Project Name: EARTHWORKS SUPERVISION
Project Location: EDEN'S CROSSING, STAGE 21
Work Request: 7359
Date Sampled: 24/03/2020 7:30
Dates Tested: 24/03/2020 - 30/03/2020
Sampling Method: AS 1289.1.2.1 6.4 (b) - Sampling from layers in earthworks or pavement - compacted
Specification: 95% STD
Site Selection: Selected by GTA
Material: Allotment Fill
Material Source: Onsite Cut



Accredited for compliance with ISO/IEC 17025 - Testing

Approved Signatory: Greg Gibson
 Senior Technician

NATA Accredited Laboratory Number: 1169

Compaction Control AS 1289 5.7.1 & 5.8.1 & 2.1.1					
Sample Number	D20-7359F	D20-7359G	D20-7359H	D20-7359I	D20-7359J
Date Tested	24/03/2020	24/03/2020	24/03/2020	24/03/2020	24/03/2020
Time Tested	08:10	08:20	08:35	08:45	09:00
Test Request #/Location	Lot 1086	Lot 1087	Lot 1053	Lot 1054	Lot 1055
Latitude	4m from Rear Boundary	12m from Rear Boundary	10m from Rear Boundary	8m from Rear Boundary	13m from Rear Boundary
Longitude	4m from Right Boundary	6m from Right Boundary	5m from Right Boundary	3m from Right Boundary	6m from Right Boundary
Layer / Reduced Level	F/L	F/L	F/L	F/L	F/L
Soil Description	Gravelly Sandy Clay. Brown	Gravelly Sandy Clay. Brown	Gravelly Sandy Clay. Brown	Gravelly Sandy Clay. Brown	Gravelly Sandy Clay. Brown
Test Depth (mm)	150	150	150	150	150
Sieve used to determine oversize (mm)	19.0	19.0	19.0	19.0	19.0
Percentage of Wet Oversize (%)	13.8	16.2	0.0	0.0	0.0
Field Wet Density (FWD) t/m ³	2.24	2.07	2.12	2.25	2.14
Field Moisture Content %	12.8	12.8	11.9	13.5	14.2
Field Dry Density (FDD) t/m ³	1.98	1.83	1.89	1.98	1.87
Peak Converted Wet Density t/m ³	**	**	2.06	2.15	2.16
Adjusted Peak Converted Wet Density t/m ³	2.19	2.06	**	**	**
Moisture Variation (Wv) %	**	**	2.5	2.0	2.0
Adjusted Moisture Variation %	1.5	0.5	**	**	**
Hilf Density Ratio (%)	102.0	100.5	102.5	104.5	99.0
Compaction Method	Standard	Standard	Standard	Standard	Standard

Moisture Variation Note:

Positive values = test is dry of OMC

Negative values = test is wet of OMC

Material Test Report

Report Number: DL20/027-6C
Issue Number: 1
Date Issued: 13/02/2020
Client: SHADFORTH'S CIVIL PTY LTD
 99 SANDALWOOD LANE, FOREST GLEN QLD 4556
Project Number: DL20/027
Project Name: EARTHWORKS SUPERVISION
Project Location: EDEN'S CROSSING, STAGE 21
Work Request: 6667
Sample Number: D20-6667A
Date Sampled: 28/01/2020
Dates Tested: 28/01/2020 - 12/02/2020
Sample Location: E: 484309, N: 6938481
Material: Capping Material
Material Source: White Rock Quarry / Sandstone




Accredited for compliance with ISO/IEC 17025 - Testing

Approved Signatory: Kiri Pitama
 Laboratory Technician
 NATA Accredited Laboratory Number: 1169

Particle Size Distribution (AS1289 3.6.1)				
Sieve	Passed %	Passing Limits	Retained %	Retained Limits
6.7 mm	100		0	
4.75 mm	100		0	
2.36 mm	99		1	
1.18 mm	90		8	
0.6 mm	70		20	
0.425 mm	51		19	
0.3 mm	32		19	
0.15 mm	21		11	
0.075 mm	16		5	

Atterberg Limit (AS1289 3.1.1 & 3.2.1 & 3.3.1)			Min	Max
Sample History	Oven Dried			
Preparation Method	Dry Sieve			
Liquid Limit (%)	32			
Plastic Limit (%)	15			
Plasticity Index (%)	17			
Weighted Plasticity Index (%)	873			

Linear Shrinkage (AS1289 3.4.1)			Min	Max
Linear Shrinkage (%)	6.5			
Cracking Crumbling Curling	Curling			

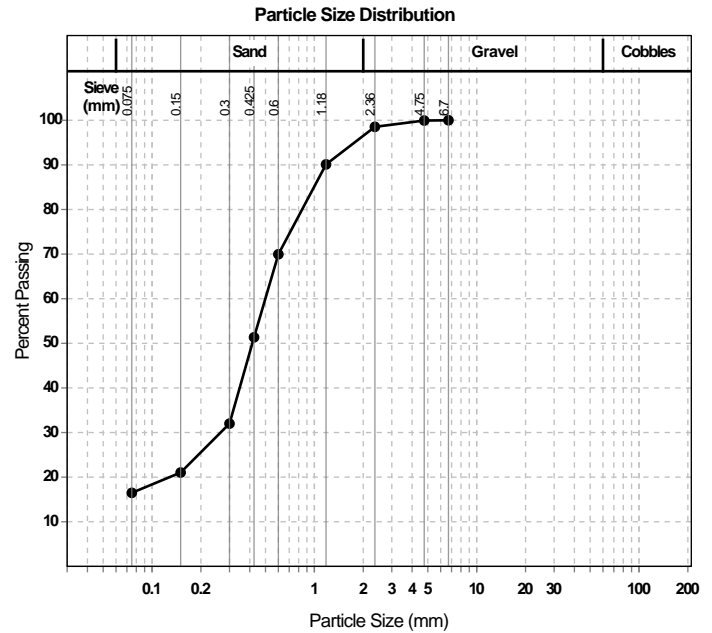

Material Test Report



Brisbane | Gold Coast | Maroochydore

Morrison Geotechnic Pty Ltd

ABN: 51 009 878 899

Brisbane Laboratory

Unit 1, 35 Limestone Darra QLD 4076

Phone: (07) 3279 0900

Email: darralab@morrisongeo.com.au

Report Number: DL20/027-6A
Issue Number: 1
Date Issued: 13/02/2020
Client: SHADFORTH'S CIVIL PTY LTD
 99 SANDALWOOD LANE, FOREST GLEN QLD 4556
Project Number: DL20/027
Project Name: EARTHWORKS SUPERVISION
Project Location: EDEN'S CROSSING, STAGE 21
Work Request: 6667
Sample Number: D20-6667A
Date Sampled: 28/01/2020
Dates Tested: 28/01/2020 - 01/02/2020
Sample Location: E: 484309, N: 6938481
Material: Capping Material
Material Source: White Rock Quarry / Sandstone




Accredited for compliance with ISO/IEC 17025 - Testing

Approved Signatory: Rhys Mitchell
 Senior Technician

NATA Accredited Laboratory Number: 1169

California Bearing Ratio (AS 1289 6.1.1 & 2.1.1)		Min	Max
CBR taken at	5 mm		
CBR %	35		
Method of Compactive Effort	Standard		
Method used to Determine MDD	AS 1289 5.1.1 & 2.1.1		
Method used to Determine Plasticity	VISUAL		
Maximum Dry Density (t/m ³)	1.84		
Optimum Moisture Content (%)	13.0		
Laboratory Density Ratio (%)	100.0		
Laboratory Moisture Ratio (%)	100.0		
Dry Density after Soaking (t/m ³)	1.84		
Field Moisture Content (%)	8.0		
Moisture Content at Placement (%)	13.0		
Moisture Content Top 30mm (%)	13.2		
Moisture Content Rest of Sample (%)	13.2		
Mass Surcharge (kg)	4.5		
Soaking Period (days)	4		
Curing Hours	2		
Swell (%)	0.0		
Oversize Material (mm)	19		
Oversize Material Included	Excluded		
Oversize Material (%)	0		

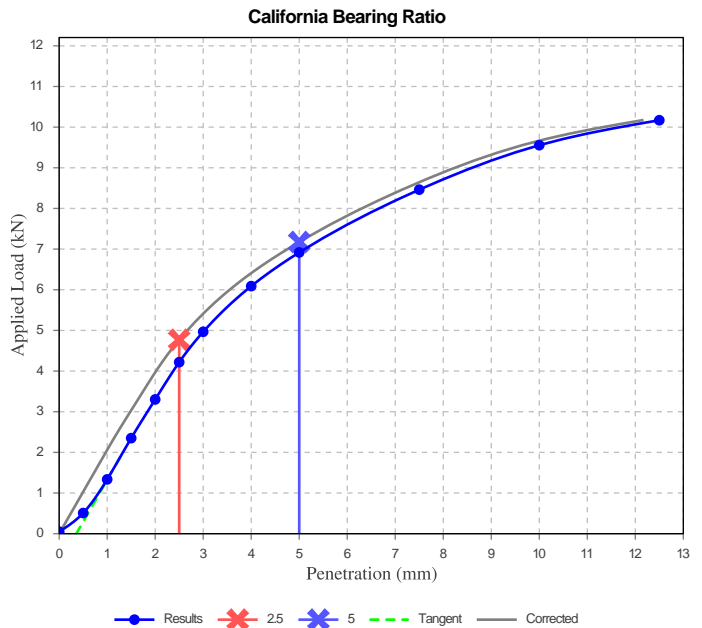

Dry Density - Moisture Relationship (AS 1289 5.1.1 & 2.1.1)	
Mould Type	1 LITRE MOULD A
Compaction	Standard
Maximum Dry Density (t/m ³)	1.84
Optimum Moisture Content (%)	13.0
Oversize Sieve (mm)	19
Oversize Material Wet (%)	0
Method used to Determine Plasticity	VISUAL
Curing Hours	2

Moisture Content (AS 1289 2.1.1)	
Moisture Content (%)	8.2

Material Test Report



Brisbane | Gold Coast | Maroochydore

Morrison Geotechnic Pty Ltd

ABN: 51 009 878 899

Brisbane Laboratory

Unit 1, 35 Limestone Darra QLD 4076

Phone: (07) 3279 0900

Email: darralab@morrisongeo.com.au

Report Number: DL20/027-6B
Issue Number: 1
Date Issued: 13/02/2020
Client: SHADFORTH'S CIVIL PTY LTD
 99 SANDALWOOD LANE, FOREST GLEN QLD 4556
Project Number: DL20/027
Project Name: EARTHWORKS SUPERVISION
Project Location: EDEN'S CROSSING, STAGE 21
Work Request: 6667
Sample Number: D20-6667B
Date Sampled: 28/01/2020
Dates Tested: 28/01/2020 - 01/02/2020
Sample Location: E: 484322, N: 6938458
Material: Capping Material
Material Source: White Rock Quarry / Sandstone




Accredited for compliance with ISO/IEC 17025 - Testing

Approved Signatory: Rhys Mitchell
 Senior Technician

NATA Accredited Laboratory Number: 1169

California Bearing Ratio (AS 1289 6.1.1 & 2.1.1)		Min	Max
CBR taken at	5 mm		
CBR %	18		
Method of Compactive Effort	Standard		
Method used to Determine MDD	AS 1289 5.1.1 & 2.1.1		
Method used to Determine Plasticity	VISUAL		
Maximum Dry Density (t/m ³)	1.92		
Optimum Moisture Content (%)	12.5		
Laboratory Density Ratio (%)	100.0		
Laboratory Moisture Ratio (%)	102.5		
Dry Density after Soaking (t/m ³)	1.92		
Field Moisture Content (%)	7.3		
Moisture Content at Placement (%)	12.6		
Moisture Content Top 30mm (%)	13.4		
Moisture Content Rest of Sample (%)	12.8		
Mass Surcharge (kg)	4.5		
Soaking Period (days)	4		
Curing Hours	2		
Swell (%)	0.0		
Oversize Material (mm)	19		
Oversize Material Included	Excluded		
Oversize Material (%)	0		

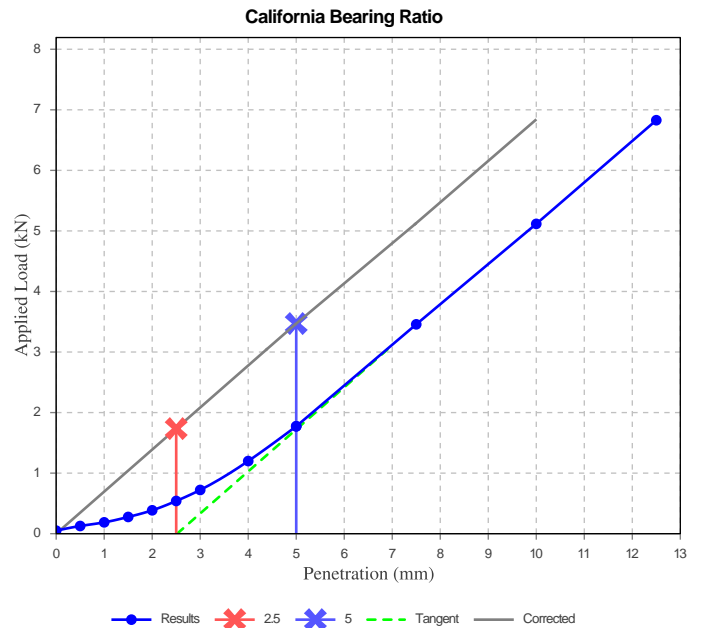

Dry Density - Moisture Relationship (AS 1289 5.1.1 & 2.1.1)	
Mould Type	1 LITRE MOULD A
Compaction	Standard
Maximum Dry Density (t/m ³)	1.92
Optimum Moisture Content (%)	12.5
Oversize Sieve (mm)	19
Oversize Material Wet (%)	0
Method used to Determine Plasticity	VISUAL
Curing Hours	2

Moisture Content (AS 1289 2.1.1)	
Moisture Content (%)	7.8

Material Test Report



Brisbane | Gold Coast | Maroochydore

Morrison Geotechnic Pty Ltd

ABN: 51 009 878 899

Brisbane Laboratory

Unit 1, 35 Limestone Darra QLD 4076

Phone: (07) 3279 0900

Email: nathaniel@mgeo.com.au

Report Number: DL20/027-16
Issue Number: 1
Date Issued: 17/03/2020
Client: SHADFORTH'S CIVIL PTY LTD
 99 SANDALWOOD LANE, FOREST GLEN QLD 4556
Project Number: DL20/027
Project Name: EARTHWORKS SUPERVISION
Project Location: EDEN'S CROSSING, STAGE 21
Work Request: 7112
Date Sampled: 06/03/2020
Dates Tested: 06/03/2020 - 10/03/2020
Sampling Method: AS 1289.1.2.1 6.4 (b) - Sampling from layers in earthworks or pavement - compacted
Specification: 95% STD
Site Selection: Selected by GTA
Material: Allotment Fill
Material Source: Onsite Cut



Accredited for compliance with ISO/IEC 17025 - Testing

Approved Signatory: Nathaniel O'Haire
 Branch Manager

NATA Accredited Laboratory Number: 1169

Compaction Control AS 1289 5.7.1 & 5.8.1 & 2.1.1			
Sample Number	D20-7112A	D20-7112B	D20-7112C
Date Tested	06/03/2020	06/03/2020	06/03/2020
Time Tested	10:00	10:10	10:20
Test Request #/Location	Stage 21	Stage 21	Stage 21
Location	4.5m from Left Boundary, 10m from Rear Boundary.	5m from Left Boundary, 8m from Rear Boundary.	4m from Left Boundary, 10m from Rear Boundary.
Layer / Reduced Level	FSL	FSL	FSL
Soil Description	Clayey Gravel	Clayey Gravel	Clayey Gravel
Test Depth (mm)	150	150	150
Sieve used to determine oversize (mm)	19.0	19.0	19.0
Percentage of Wet Oversize (%)	0.0	8.7	0.0
Field Wet Density (FWD) t/m ³	2.08	2.06	2.08
Field Moisture Content %	10.1	12.8	8.3
Field Dry Density (FDD) t/m ³	1.89	1.83	1.92
Peak Converted Wet Density t/m ³	2.04	**	2.04
Adjusted Peak Converted Wet Density t/m ³	**	2.12	**
Moisture Variation (Wv) %	3.5	**	4.0
Adjusted Moisture Variation %	**	2.0	**
Hilf Density Ratio (%)	102.0	97.5	102.0
Compaction Method	Standard	Standard	Standard

Moisture Variation Note:

Positive values = test is dry of OMC
 Negative values = test is wet of OMC

Material Test Report

Report Number: DL20/027-7
Issue Number: 1
Date Issued: 26/02/2020
Client: SHADFORTH'S CIVIL PTY LTD
 99 SANDALWOOD LANE, FOREST GLEN QLD 4556
Project Number: DL20/027
Project Name: EARTHWORKS SUPERVISION
Project Location: EDEN'S CROSSING, STAGE 21
Work Request: 6913
Date Sampled: 24/02/2020
Dates Tested: 24/02/2020 - 26/02/2020
Sampling Method: AS1289 1.2.1 6.4 (b) - Sampling from layers in earthworks or pavement - compacted
Specification: 95% STD
Site Selection: Selected by GTA
Material: Stage 21 - Allotment Fill
Material Source: Onsite



Accredited for compliance with ISO/IEC 17025 - Testing



Approved Signatory: Liam Davidson
 Senior Technician
 NATA Accredited Laboratory Number: 1169

Compaction Control AS 1289 5.7.1 & 5.8.1 & 2.1.1				
Sample Number	D20-6913A	D20-6913B	D20-6913C	D20-6913D
Date Tested	24/02/2020	24/02/2020	24/02/2020	24/02/2020
Time Tested	08:14	08:25	08:31	08:38
Test Request #/Location	Stage 21 - Allotment Fill	Stage 21 - Allotment Fill	Stage 21 - Allotment Fill	Stage 21 - Allotment Fill
Easting	6939745	6939738	6939739	6939726
Northing	0484137	0484099	0484109	0484114
Elevation (m)	84.041	83.365	84.149	84.049
Soil Description	Gravelly Sandy Clay. Brown	Gravelly Sandy Clay. Brown	Gravelly Sandy Clay. Brown	Gravelly Sandy Clay. Brown
Test Depth (mm)	150	150	150	150
Sieve used to determine oversize (mm)	19.0	19.0	19.0	37.5
Percentage of Wet Oversize (%)	0.0	0.0	0.0	0.0
Field Wet Density (FWD) t/m ³	2.05	2.10	2.16	2.05
Field Moisture Content %	10.0	11.8	10.4	10.2
Field Dry Density (FDD) t/m ³	1.86	1.88	1.95	1.86
Peak Converted Wet Density t/m ³	2.10	2.10	2.07	2.08
Adjusted Peak Converted Wet Density t/m ³	**	**	**	**
Moisture Variation (Wv) %	2.0	1.5	2.5	1.5
Adjusted Moisture Variation %	**	**	**	**
Hilf Density Ratio (%)	97.5	100.0	104.0	98.5
Compaction Method	Standard	Standard	Standard	Standard

Moisture Variation Note:

Positive values = test is dry of OMC
 Negative values = test is wet of OMC

Material Test Report



Brisbane | Gold Coast | Maroochydore

Morrison Geotechnic Pty Ltd

ABN: 51 009 878 899

Brisbane Laboratory

Unit 1, 35 Limestone Darra QLD 4076

Phone: (07) 3279 0900

Email: jwieland@mgeo.com.au

Report Number: DL20/027-8
Issue Number: 1
Date Issued: 27/02/2020
Client: SHADFORTH'S CIVIL PTY LTD
 99 SANDALWOOD LANE, FOREST GLEN QLD 4556
Project Number: DL20/027
Project Name: EARTHWORKS SUPERVISION
Project Location: EDEN'S CROSSING, STAGE 21
Work Request: 6939
Date Sampled: 25/02/2020 13:45
Dates Tested: 25/02/2020 - 26/02/2020
Sampling Method: AS1289 1.2.1 6.4 (b) - Sampling from layers in earthworks or pavement - compacted
Specification: 95% STD
Site Selection: Selected by GTA
Material: Allotment Fill
Material Source: Onsite Cut (Sandy Clay)



Accredited for compliance with ISO/IEC 17025 - Testing

Approved Signatory: John Wieland
 Senior Soil Technician

NATA Accredited Laboratory Number: 1169

Compaction Control AS 1289 5.7.1 & 5.8.1 & 2.1.1			
Sample Number	D20-6939A	D20-6939B	D20-6939C
Date Tested	25/02/2020	25/02/2020	25/02/2020
Time Tested	13:45	13:55	14:05
Test Request #/Location	Stage 21	Stage 21	Stage 21
Easting	484134.700	484147.282	484165.000
Northing	6939775.20	6939759.840	6939740.500
Elevation (m)	84.1	84.838	85.740
Soil Description	Sandy Clay. Brown	Sandy Clay. Brown	Sandy Clay. Brown
Test Depth (mm)	150	150	150
Sieve used to determine oversize (mm)	19.0	19.0	19.0
Percentage of Wet Oversize (%)	0.0	0.0	0.0
Field Wet Density (FWD) t/m ³	2.06	2.05	2.04
Field Moisture Content %	18.7	26.7	24.7
Field Dry Density (FDD) t/m ³	1.74	1.62	1.63
Peak Converted Wet Density t/m ³	2.03	2.09	1.94
Adjusted Peak Converted Wet Density t/m ³	**	**	**
Moisture Variation (Wv) %	-0.5	0.0	-0.5
Adjusted Moisture Variation %	**	**	**
Hilf Density Ratio (%)	101.5	98.0	105.0
Compaction Method	Standard	Standard	Standard

Moisture Variation Note:

Positive values = test is dry of OMC

Negative values = test is wet of OMC

Material Test Report

Report Number: DL20/027-9
Issue Number: 1
Date Issued: 28/02/2020
Client: SHADFORTH'S CIVIL PTY LTD
99 SANDALWOOD LANE, FOREST GLEN QLD 4556
Contact: Cam
Project Number: DL20/027
Project Name: EARTHWORKS SUPERVISION
Project Location: EDEN'S CROSSING, STAGE 21
Work Request: 6947
Date Sampled: 26/02/2020
Dates Tested: 26/02/2020 - 28/02/2020
Sampling Method: AS1289 1.2.1 6.4 (b) - Sampling from layers in earthworks or pavement - compacted
Specification: 95% STD
Site Selection: Selected by GTA
Material: Allotment Fill (Sandy Clay)
Material Source: Onsite Cut



Accredited for compliance with ISO/IEC 17025 - Testing



Approved Signatory: Liam Davidson
Senior Technician

NATA Accredited Laboratory Number: 1169

Compaction Control AS 1289 5.7.1 & 5.8.1 & 2.1.1

Sample Number	D20-6947A	D20-6947B	D20-6947C	D20-6947D	D20-6947E
Date Tested	26/02/2020	26/02/2020	26/02/2020	26/02/2020	26/02/2020
Time Tested	10:05	10:15	10:20	10:30	10:35
Test Request #/Location	Stage 21/24	Stage 21/24	Stage 21/24	Stage 21/24	Stage 21/24
Easting	484147.62	484169.94	484166.14	484187.190	484114.86
Northing	6939762.80	6936738.97	6939689.18	6939714.33	6939729.0
Elevation (m)	84.83	85.95	86.46	87.26	84.621
Soil Description	Sandy Clay. Brown	Sandy Clay. Brown	Sandy Clay. Brown	Sandy Clay. Brown	Sandy Clay. Brown
Test Depth (mm)	150	150	150	150	150
Sieve used to determine oversize (mm)	37.5	19.0	19.0	19.0	19.0
Percentage of Wet Oversize (%)	**	0.0	0.0	0.0	0.0
Field Wet Density (FWD) t/m ³	1.95	1.94	1.96	1.99	1.95
Field Moisture Content %	25.3	26.7	17.2	20.0	25.6
Field Dry Density (FDD) t/m ³	1.55	1.53	1.67	1.66	1.55
Peak Converted Wet Density t/m ³	1.93	1.98	1.98	1.99	1.90
Adjusted Peak Converted Wet Density t/m ³	**	**	**	**	**
Moisture Variation (Wv) %	-0.5	0.5	0.5	0.0	0.0
Adjusted Moisture Variation %	**	**	**	**	**
Hilf Density Ratio (%)	100.5	98.0	99.0	100.5	103.0
Compaction Method	Standard	Standard	Standard	Standard	Standard

Moisture Variation Note:

Positive values = test is dry of OMC

Negative values = test is wet of OMC

Material Test Report

Report Number: DL20/027-9
Issue Number: 1
Date Issued: 28/02/2020
Client: SHADFORTH'S CIVIL PTY LTD
99 SANDALWOOD LANE, FOREST GLEN QLD 4556
Contact: Cam
Project Number: DL20/027
Project Name: EARTHWORKS SUPERVISION
Project Location: EDEN'S CROSSING, STAGE 21
Work Request: 6947
Date Sampled: 26/02/2020
Dates Tested: 26/02/2020 - 28/02/2020
Sampling Method: AS1289 1.2.1 6.4 (b) - Sampling from layers in earthworks or pavement - compacted
Specification: 95% STD
Site Selection: Selected by GTA
Material: Allotment Fill (Sandy Clay)
Material Source: Onsite Cut



Accredited for compliance with ISO/IEC 17025 - Testing



Approved Signatory: Liam Davidson
Senior Technician

NATA Accredited Laboratory Number: 1169

Compaction Control AS 1289 5.7.1 & 5.8.1 & 2.1.1

Sample Number	D20-6947F	D20-6947G	D20-6947H	D20-6947I	
Date Tested	26/02/2020	26/02/2020	26/02/2020	26/02/2020	
Time Tested	10:40	10:50	14:05	14:18	
Test Request #/Location	Stage 21/24	Stage 21/24	Stage 21/24	Stage 21/24	
Easting	484118.154	484229.321	484117.720	484132.45	
Northing	6939749.391	6939708.992	6939749.769	6939723.500	
Elevation (m)	84.397	83.989	84.300	85.05	
Soil Description	Sandy Clay, Brown	Sandy Clay, Brown	Sandy Clay, Brown	Sandy Clay, Brown	
Test Depth (mm)	150	150	150	150	
Sieve used to determine oversize (mm)	19.0	19.0	19.0	19.0	
Percentage of Wet Oversize (%)	0.0	0.0	0.0	0.0	
Field Wet Density (FWD) t/m ³	1.92	1.89	2.12	1.90	
Field Moisture Content %	28.9	22.5	23.1	32.1	
Field Dry Density (FDD) t/m ³	1.49	1.54	1.72	1.44	
Peak Converted Wet Density t/m ³	1.89	1.98	2.07	1.88	
Adjusted Peak Converted Wet Density t/m ³	**	**	**	**	
Moisture Variation (Wv) %	0.5	0.5	2.0	0.0	
Adjusted Moisture Variation %	**	**	**	**	
Hilf Density Ratio (%)	102.0	95.5	102.0	101.5	
Compaction Method	Standard	Standard	Standard	Standard	

Moisture Variation Note:

Positive values = test is dry of OMC

Negative values = test is wet of OMC

Material Test Report



Brisbane | Gold Coast | Maroochydore

Morrison Geotechnic Pty Ltd

ABN: 51 009 878 899

Brisbane Laboratory

Unit 1, 35 Limestone Darra QLD 4076

Phone: (07) 3279 0900

Email: darralab@morrisongeo.com.au

Report Number: DL20/027-22A
Issue Number: 1
Date Issued: 26/03/2020
Client: SHADFORTH'S CIVIL PTY LTD
 99 SANDALWOOD LANE, FOREST GLEN QLD 4556
Project Number: DL20/027
Project Name: EARTHWORKS SUPERVISION
Project Location: EDEN'S CROSSING, STAGE 21
Work Request: 7211
Sample Number: D20-7211A
Date Sampled: 16/03/2020
Dates Tested: 16/03/2020 - 25/03/2020
Sampling Method: AS 1289.1.2.1 6.4 (b) - Sampling from layers in earthworks or pavement - compacted
Sample Location: E: 484242.9, N: 6939682.4, Depth: 91.6
Lot No: Capping Layer - Select Fill
Material: Clayey Sand
Material Source: Imported



Accredited for compliance with ISO/IEC 17025 - Testing


Kiri Pitama

Approved Signatory: Kiri Pitama

Laboratory Technician

NATA Accredited Laboratory Number: 1169

Particle Size Distribution (AS1289 3.6.1)				
Sieve	Passed %	Passing Limits	Retained %	Retained Limits
53 mm	100		0	
37.5 mm	98		2	
26.5 mm	92		6	
19 mm	90		3	
13.2 mm	87		2	
9.5 mm	86		1	
6.7 mm	85		1	
4.75 mm	85		0	
2.36 mm	84		1	
1.18 mm	81		3	
0.6 mm	73		8	
0.425 mm	66		7	
0.3 mm	43		23	
0.15 mm	24		19	
0.075 mm	19		5	

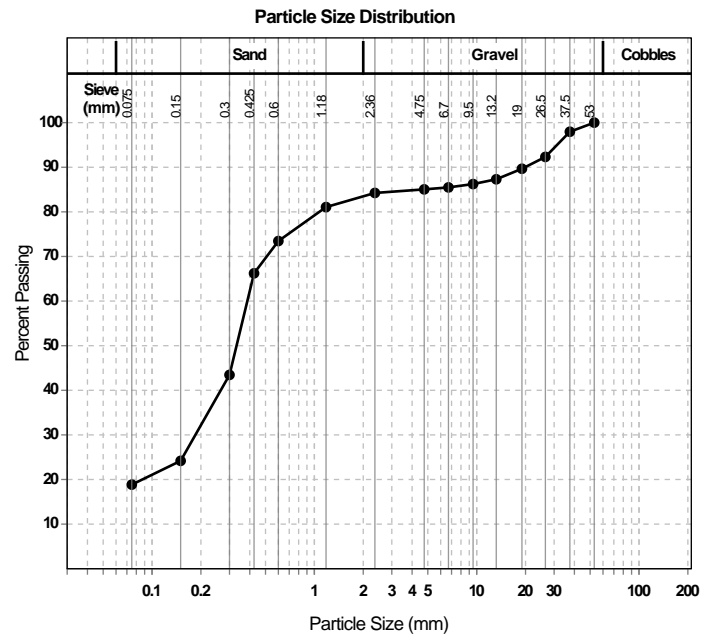

Atterberg Limit (AS1289 3.1.1 & 3.2.1 & 3.3.1)			Min	Max
Sample History	Oven Dried			
Preparation Method	Dry Sieve			
Liquid Limit (%)	29			
Plastic Limit (%)	16			
Plasticity Index (%)	13			
Weighted Plasticity Index (%)	861			

Linear Shrinkage (AS1289 3.4.1)			Min	Max
Linear Shrinkage (%)	5.0			
Cracking Crumbling Curling	Curling			

Material Test Report



Brisbane | Gold Coast | Maroochydore

Morrison Geotechnic Pty Ltd

ABN: 51 009 878 899

Brisbane Laboratory

Unit 1, 35 Limestone Darra QLD 4076

Phone: (07) 3279 0900

Email: darralab@morrisongeo.com.au

Report Number: DL20/027-22C
Issue Number: 1
Date Issued: 30/03/2020
Client: SHADFORTH'S CIVIL PTY LTD
 99 SANDALWOOD LANE, FOREST GLEN QLD 4556
Project Number: DL20/027
Project Name: EARTHWORKS SUPERVISION
Project Location: EDEN'S CROSSING, STAGE 21
Work Request: 7211
Sample Number: D20-7211A
Date Sampled: 16/03/2020
Dates Tested: 16/03/2020 - 23/03/2020
Sampling Method: AS 1289.1.2.1 6.4 (b) - Sampling from layers in earthworks or pavement - compacted
Sample Location: E: 484242.9, N: 6939682.4, Depth: 91.6
Lot No: Capping Layer - Select Fill
Material: Clayey Sand
Material Source: Imported




Accredited for compliance with ISO/IEC 17025 - Testing

Approved Signatory: Rhys Mitchell
 Senior Technician

NATA Accredited Laboratory Number: 1169

California Bearing Ratio (AS 1289 6.1.1 & 2.1.1)		Min	Max
CBR taken at	5 mm		
CBR %	18		
Method of Compactive Effort	Standard		
Method used to Determine MDD	AS 1289 5.1.1 & 2.1.1		
Method used to Determine Plasticity	Visual		
Maximum Dry Density (t/m ³)	1.87		
Optimum Moisture Content (%)	13.0		
Laboratory Density Ratio (%)	100.5		
Laboratory Moisture Ratio (%)	100.0		
Dry Density after Soaking (t/m ³)	1.88		
Field Moisture Content (%)	9.1		
Moisture Content at Placement (%)	12.9		
Moisture Content Top 30mm (%)	13.3		
Moisture Content Rest of Sample (%)	13.7		
Mass Surcharge (kg)	4.5		
Soaking Period (days)	4		
Curing Hours	24		
Swell (%)	0.0		
Oversize Material (mm)	19		
Oversize Material Included	Excluded		
Oversize Material (%)			

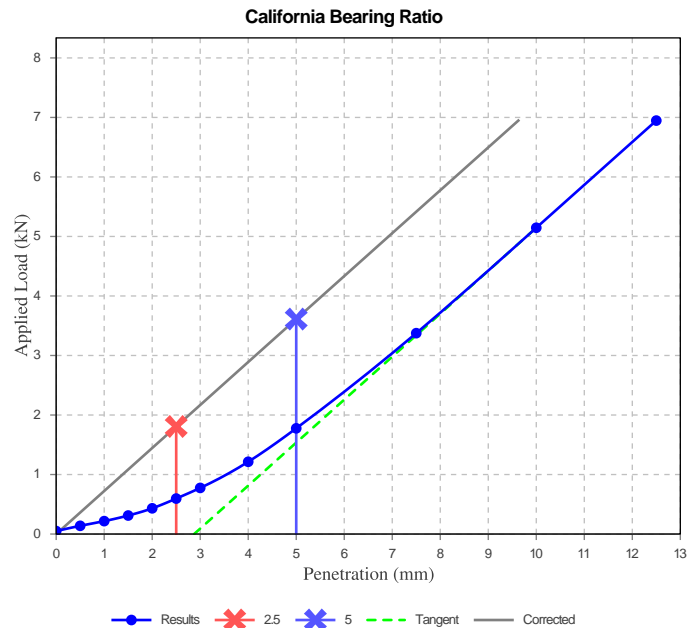

Material Test Report

Report Number: DL20/027-10
Issue Number: 1
Date Issued: 04/03/2020
Client: SHADFORTH'S CIVIL PTY LTD
 99 SANDALWOOD LANE, FOREST GLEN QLD 4556
Contact: Cam
Project Number: DL20/027
Project Name: EARTHWORKS SUPERVISION
Project Location: EDEN'S CROSSING, STAGE 21
Work Request: 6987
Date Sampled: 28/02/2020 06:30
Dates Tested: 28/02/2020 - 03/03/2020
Sampling Method: AS1289 1.2.1 6.4 (b) - Sampling from layers in earthworks or pavement - compacted
Specification: 95% STD
Site Selection: Selected by GTA
Material: Allotment Fill
Material Source: Onsite Cut



Accredited for compliance with ISO/IEC 17025 - Testing

Approved Signatory: Greg Gibson
 Senior Technician
 NATA Accredited Laboratory Number: 1169

Compaction Control AS 1289 5.7.1 & 5.8.1 & 2.1.1				
Sample Number	D20-6987A	D20-6987B	D20-6987C	D20-6987D
Date Tested	28/02/2020	28/02/2020	28/02/2020	28/02/2020
Time Tested	07:00	07:05	07:10	07:15
Test Request #/Location	Stage 21	Stage 21	Stage 21	Stage 21
Easting	6939753.83	6939741.27	6939726.34	6939709.95
Northing	484109.61	484125.48	484144.19	484162.76
Elevation (m)	84.44	84.97	85.80	87.35
Soil Description	Clay, Brown	Clay, Brown	Clay, Brown	Clay, Brown
Test Depth (mm)	150	150	150	150
Sieve used to determine oversize (mm)	19.0	19.0	37.5	19.0
Percentage of Wet Oversize (%)	0.0	0.0	0.0	0.0
Field Wet Density (FWD) t/m ³	1.90	1.86	1.85	1.90
Field Moisture Content %	30.5	34.7	31.9	30.6
Field Dry Density (FDD) t/m ³	1.45	1.38	1.40	1.45
Peak Converted Wet Density t/m ³	1.87	1.79	1.78	1.87
Adjusted Peak Converted Wet Density t/m ³	**	**	**	**
Moisture Variation (Wv) %	0.0	0.5	1.0	0.5
Adjusted Moisture Variation %	**	**	**	**
Hilf Density Ratio (%)	101.5	104.0	103.5	101.5
Compaction Method	Standard	Standard	Standard	Standard

Moisture Variation Note:

Positive values = test is dry of OMC
 Negative values = test is wet of OMC

Material Test Report

Report Number: DL20/027-10
Issue Number: 1
Date Issued: 04/03/2020
Client: SHADFORTH'S CIVIL PTY LTD
 99 SANDALWOOD LANE, FOREST GLEN QLD 4556
Contact: Cam
Project Number: DL20/027
Project Name: EARTHWORKS SUPERVISION
Project Location: EDEN'S CROSSING, STAGE 21
Work Request: 6987
Date Sampled: 28/02/2020 06:30
Dates Tested: 28/02/2020 - 03/03/2020
Sampling Method: AS1289 1.2.1 6.4 (b) - Sampling from layers in earthworks or pavement - compacted
Specification: 95% STD
Site Selection: Selected by GTA
Material: Allotment Fill
Material Source: Onsite Cut



Accredited for compliance with ISO/IEC 17025 - Testing

Approved Signatory: Greg Gibson
 Senior Technician
 NATA Accredited Laboratory Number: 1169

Compaction Control AS 1289 5.7.1 & 5.8.1 & 2.1.1				
Sample Number	D20-6987E	D20-6987F	D20-6987G	D20-6987H
Date Tested	28/02/2020	28/02/2020	28/02/2020	28/02/2020
Time Tested	07:20	07:25	07:30	07:40
Test Request #/Location	Stage 21	Stage 21	Stage 21	Stage 21
Easting	6939698.18	6939688.36	6939669.27	6939689.18
Northing	484173.69	484183.13	484193.93	484209.84
Elevation (m)	87.98	88.65	89.55	89.25
Soil Description	Clay, Brown	Clay, Brown	Clay, Brown	Sandy Clay, Brown
Test Depth (mm)	150	150	150	150
Sieve used to determine oversize (mm)	19.0	19.0	19.0	19.0
Percentage of Wet Oversize (%)	0.0	0.0	0.0	0.0
Field Wet Density (FWD) t/m ³	1.80	1.78	1.90	2.01
Field Moisture Content %	29.8	33.1	23.6	17.7
Field Dry Density (FDD) t/m ³	1.39	1.34	1.54	1.70
Peak Converted Wet Density t/m ³	1.88	1.80	1.89	1.99
Adjusted Peak Converted Wet Density t/m ³	**	**	**	**
Moisture Variation (Wv) %	0.5	1.0	0.5	3.0
Adjusted Moisture Variation %	**	**	**	**
Hilf Density Ratio (%)	96.0	99.0	100.5	101.0
Compaction Method	Standard	Standard	Standard	Standard

Moisture Variation Note:

Positive values = test is dry of OMC
 Negative values = test is wet of OMC

Material Test Report

Report Number: DL20/027-11
Issue Number: 1
Date Issued: 09/03/2020
Client: SHADFORTH'S CIVIL PTY LTD
 99 SANDALWOOD LANE, FOREST GLEN QLD 4556
Project Number: DL20/027
Project Name: EARTHWORKS SUPERVISION
Project Location: EDEN'S CROSSING, STAGE 21
Work Request: 7018
Date Sampled: 02/03/2020
Dates Tested: 02/03/2020 - 04/03/2020
Sampling Method: AS1289 1.2.1 6.4 (b) - Sampling from layers in earthworks or pavement - compacted
Specification: 95% STD
Site Selection: Selected by GTA
Material: Allotment Fill
Material Source: Onsite Cut



Accredited for compliance with ISO/IEC 17025 - Testing



Approved Signatory: Liam Davidson
 Senior Technician
 NATA Accredited Laboratory Number: 1169

Compaction Control AS 1289 5.7.1 & 5.8.1 & 2.1.1			
Sample Number	D20-7018A	D20-7018B	D20-7018C
Date Tested	02/03/2020	02/03/2020	02/03/2020
Time Tested	14:05	14:10	14:20
Test Request #/Location	Stage 21 N/W Fill Area	Stage 21 N/W Fill Area	Stage 21 N/W Fill Area
Easting	484091.933	484093.895	484113.930
Northing	6939737.680	6939752.725	6939760.890
Elevation (m)	85.24	84.87	83.86
Soil Description	Allotment Fill	Allotment Fill	Allotment Fill
Test Depth (mm)	150	150	150
Sieve used to determine oversize (mm)	19.0	19.0	19.0
Percentage of Wet Oversize (%)	0.0	0.0	0.0
Field Wet Density (FWD) t/m ³	1.80	1.92	1.99
Field Moisture Content %	25.4	27.3	24.1
Field Dry Density (FDD) t/m ³	1.44	1.51	1.61
Peak Converted Wet Density t/m ³	1.88	1.90	1.93
Adjusted Peak Converted Wet Density t/m ³	**	**	**
Moisture Variation (Wv) %	0.5	0.5	0.5
Adjusted Moisture Variation %	**	**	**
Hilf Density Ratio (%)	96.0	101.0	103.0
Compaction Method	Standard	Standard	Standard

Moisture Variation Note:

Positive values = test is dry of OMC
 Negative values = test is wet of OMC

Material Test Report



Brisbane | Gold Coast | Maroochydore

Morrison Geotechnic Pty Ltd

ABN: 51 009 878 899

Brisbane Laboratory

Unit 1, 35 Limestone Darra QLD 4076

Phone: (07) 3279 0900

Email: greg@mgeo.com.au

Report Number: DL20/027-13
Issue Number: 1
Date Issued: 09/03/2020
Client: SHADFORTH'S CIVIL PTY LTD
 99 SANDALWOOD LANE, FOREST GLEN QLD 4556
Project Number: DL20/027
Project Name: EARTHWORKS SUPERVISION
Project Location: EDEN'S CROSSING, STAGE 21
Work Request: 7048
Date Sampled: 03/03/2020
Dates Tested: 03/03/2020 - 05/03/2020
Sampling Method: AS1289 1.2.1 6.4 (b) - Sampling from layers in earthworks or pavement - compacted
Specification: 95% STD
Site Selection: Selected by GTA
Material: Allotment Fill
Material Source: Onsite Cut.



Accredited for compliance with ISO/IEC 17025 - Testing

Approved Signatory: Greg Gibson
 Senior Technician

NATA Accredited Laboratory Number: 1169

Compaction Control AS 1289 5.7.1 & 5.8.1 & 2.1.1					
Sample Number	D20-7048A	D20-7048B	D20-7048C	D20-7048D	D20-7048E
Date Tested	03/03/2020	03/03/2020	03/03/2020	03/03/2020	03/03/2020
Time Tested	10:30	10:35	10:45	10:50	11:00
Test Request #/Location	Stage 21	Stage 21	Stage 21	Stage 21	Stage 21
Easting	484197.1	484208.4	484223.1	484188.3	484181.8
Northing	6939651.4	6939662.0	6939620.0	6939641.4	6939628.2
Elevation (m)	91.0	90.82	91.6	89.10	88.8
Soil Description	Allotment Fill	Allotment Fill	Allotment Fill	Allotment Fill	Allotment Fill
Test Depth (mm)	150	150	150	150	150
Sieve used to determine oversize (mm)	19.0	19.0	19.0	19.0	19.0
Percentage of Wet Oversize (%)	0.0	0.0	0.0	0.0	0.0
Field Wet Density (FWD) t/m ³	1.92	1.94	1.74	1.90	2.01
Field Moisture Content %	22.4	22.1	36.0	32.3	16.2
Field Dry Density (FDD) t/m ³	1.57	1.59	1.28	1.44	1.73
Peak Converted Wet Density t/m ³	1.88	1.88	1.69	1.82	1.93
Adjusted Peak Converted Wet Density t/m ³	**	**	**	**	**
Moisture Variation (Wv) %	2.5	3.0	3.5	2.5	4.0
Adjusted Moisture Variation %	**	**	**	**	**
Hilf Density Ratio (%)	102.5	103.0	103.0	104.5	104.0
Compaction Method	Standard	Standard	Standard	Standard	Standard

Moisture Variation Note:

Positive values = test is dry of OMC

Negative values = test is wet of OMC

Material Test Report



Brisbane | Gold Coast | Maroochydore

Morrison Geotechnic Pty Ltd

ABN: 51 009 878 899

Brisbane Laboratory

Unit 1, 35 Limestone Darra QLD 4076

Phone: (07) 3279 0900

Email: greg@mgeo.com.au

Report Number: DL20/027-15
Issue Number: 1
Date Issued: 17/03/2020
Client: SHADFORTH'S CIVIL PTY LTD
 99 SANDALWOOD LANE, FOREST GLEN QLD 4556
Project Number: DL20/027
Project Name: EARTHWORKS SUPERVISION
Project Location: EDEN'S CROSSING, STAGE 21
Work Request: 7185
Date Sampled: 13/03/2020 10:50
Dates Tested: 13/03/2020 - 16/03/2020
Sampling Method: AS 1289.1.2.1 6.4 (b) - Sampling from layers in earthworks or pavement - compacted
Specification: 95% STD
Material: Capping Layer Fill
Material Source: Imported



Accredited for compliance with ISO/IEC 17025 - Testing

Approved Signatory: Greg Gibson
 Senior Technician

NATA Accredited Laboratory Number: 1169

Compaction Control AS 1289 5.7.1 & 5.8.1 & 2.1.1						
Sample Number	D20-7185A	D20-7185B	D20-7185C	D20-7185D	D20-7185E	D20-7185F
Date Tested	13/03/2020	13/03/2020	13/03/2020	13/03/2020	13/03/2020	13/03/2020
Time Tested	10:30	10:40	10:50	11:20	11:30	11:40
Test Request #/Location	Capping layer	Capping layer	Capping layer	Capping layer	Capping layer	Capping layer
Easting	484086	484095	484106	484153	484185	484172
Northing	6939737	6939751	6939763	6939713	6939709	6939739
Elevation (m)	85.7	85.4	85.1	86.1	86.3	86.4
Soil Description	Clayey Sand. Brown	Clayey Sand. Brown	Clayey Sand. Brown	Clayey Sand. Brown	Clayey Sand. Brown	Clayey Sand. Brown
Test Depth (mm)	150	150	150	150	150	150
Sieve used to determine oversize (mm)	19.0	19.0	19.0	19.0	19.0	19.0
Percentage of Wet Oversize (%)	**	0.0	0.0	0.0	0.0	0.0
Field Wet Density (FWD) t/m ³	2.07	2.05	2.06	1.99	2.06	2.04
Field Moisture Content %	10.9	7.6	8.3	8.6	6.7	9.2
Field Dry Density (FDD) t/m ³	1.87	1.91	1.90	1.84	1.93	1.87
Peak Converted Wet Density t/m ³	2.13	2.04	2.13	2.04	2.00	2.07
Adjusted Peak Converted Wet Density t/m ³	**	**	**	**	**	**
Moisture Variation (Wv) %	0.0	3.5	2.5	2.5	3.5	2.0
Adjusted Moisture Variation %	**	**	**	**	**	**
Hilf Density Ratio (%)	97.0	101.0	97.0	97.5	102.5	99.0
Compaction Method	Standard	Standard	Standard	Standard	Standard	Standard

Moisture Variation Note:

Positive values = test is dry of OMC
 Negative values = test is wet of OMC

Material Test Report

Report Number: DL20/027-17
Issue Number: 1
Date Issued: 19/03/2020
Client: SHADFORTH'S CIVIL PTY LTD
99 SANDALWOOD LANE, FOREST GLEN QLD 4556
Project Number: DL20/027
Project Name: EARTHWORKS SUPERVISION
Project Location: EDEN'S CROSSING, STAGE 21
Work Request: 7209
Date Sampled: 16/03/2020
Dates Tested: 16/03/2020 - 17/03/2020
Sampling Method: AS 1289.1.2.1 6.4 (b) - Sampling from layers in earthworks or pavement - compacted
Specification: 95% STD
Site Selection: Selected by GTA
Material: Capping Layer Fill
Material Source: Imported



Accredited for compliance with ISO/IEC 17025 - Testing



Approved Signatory: Liam Davidson
Senior Technician
NATA Accredited Laboratory Number: 1169

Compaction Control AS 1289 5.7.1 & 5.8.1 & 2.1.1			
Sample Number	D20-7209A	D20-7209B	D20-7209C
Date Tested	16/03/2020	16/03/2020	16/03/2020
Time Tested	10:30	10:40	10:50
Test Request #/Location	Capping Layer	Capping Layer	Capping Layer
Easting	484242.9	484252.6	484267.6
Northing	6939682.4	6939673.0	6939654.5
Elevation (m)	91.6	92.0	92.5
Soil Description	Clayey Sand	Clayey Sand	Clayey Sand
Test Depth (mm)	150	150	150
Sieve used to determine oversize (mm)	19.0	19.0	19.0
Percentage of Wet Oversize (%)	0.0	0.0	0.0
Field Wet Density (FWD) t/m ³	2.05	2.10	2.09
Field Moisture Content %	10.9	12.1	10.8
Field Dry Density (FDD) t/m ³	1.85	1.87	1.89
Peak Converted Wet Density t/m ³	2.04	2.05	2.04
Adjusted Peak Converted Wet Density t/m ³	**	**	**
Moisture Variation (Wv) %	2.5	1.0	1.5
Adjusted Moisture Variation %	**	**	**
Hilf Density Ratio (%)	100.5	102.5	102.5
Compaction Method	Standard	Standard	Standard

Moisture Variation Note:

Positive values = test is dry of OMC
Negative values = test is wet of OMC

Material Test Report



Brisbane | Gold Coast | Maroochydore

Morrison Geotechnic Pty Ltd

ABN: 51 009 878 899

Brisbane Laboratory

Unit 1, 35 Limestone Darra QLD 4076

Phone: (07) 3279 0900

Email: jwieland@mgeo.com.au

Report Number: DL20/027-18A
Issue Number: 1
Date Issued: 24/03/2020
Client: SHADFORTH'S CIVIL PTY LTD
 99 SANDALWOOD LANE, FOREST GLEN QLD 4556
Project Number: DL20/027
Project Name: EARTHWORKS SUPERVISION
Project Location: EDEN'S CROSSING, STAGE 21
Work Request: 7175
Sample Number: D20-7175A
Date Sampled: 12/03/2020
Dates Tested: 12/03/2020 - 19/03/2020
Sampling Method: AS 1289.1.2.1 6.4 (b) - Sampling from layers in earthworks or pavement - compacted
Sample Location: E: 484063, N: 6939524, Depth: 0.3m below FL
Lot No: Capping Material
Material: Sandstone - Sandy Clay / Clayey Sand
Material Source: Onsite Burrow Area



Accredited for compliance with ISO/IEC 17025 - Testing




Approved Signatory: John Wieland

Senior Soil Technician

NATA Accredited Laboratory Number: 1169

California Bearing Ratio (AS 1289 6.1.1 & 2.1.1)	Min	Max
CBR taken at	5 mm	
CBR %	35	
Method of Compactive Effort	Standard	
Method used to Determine MDD	AS 1289 5.1.1 & 2.1.1	
Method used to Determine Plasticity	VISUAL	
Maximum Dry Density (t/m ³)	1.88	
Optimum Moisture Content (%)	12.5	
Laboratory Density Ratio (%)	100.5	
Laboratory Moisture Ratio (%)	100.0	
Dry Density after Soaking (t/m ³)	1.88	
Field Moisture Content (%)	7.6	
Moisture Content at Placement (%)	12.7	
Moisture Content Top 30mm (%)	12.5	
Moisture Content Rest of Sample (%)	13.2	
Mass Surcharge (kg)	4.5	
Soaking Period (days)		
Curing Hours	48	
Swell (%)	0.0	
Oversize Material (mm)	19	
Oversize Material Included	Excluded	
Oversize Material (%)	15.3	

A correction of 1.3mm was applied to the penetration curve

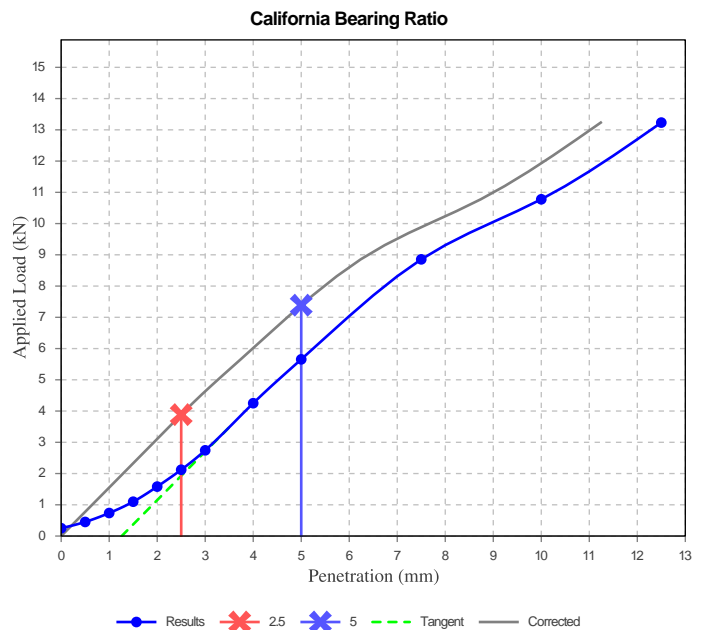

Material Test Report



Brisbane | Gold Coast | Maroochydore

Morrison Geotechnic Pty Ltd

ABN: 51 009 878 899

Brisbane Laboratory

Unit 1, 35 Limestone Darra QLD 4076

Phone: (07) 3279 0900

Email: darralab@morrisongeo.com.au

Report Number: DL20/027-18B
Issue Number: 1
Date Issued: 25/03/2020
Client: SHADFORTH'S CIVIL PTY LTD
 99 SANDALWOOD LANE, FOREST GLEN QLD 4556
Project Number: DL20/027
Project Name: EARTHWORKS SUPERVISION
Project Location: EDEN'S CROSSING, STAGE 21
Work Request: 7175
Sample Number: D20-7175A
Date Sampled: 12/03/2020
Dates Tested: 12/03/2020 - 20/03/2020
Sampling Method: AS 1289.1.2.1 6.4 (b) - Sampling from layers in earthworks or pavement - compacted
Sample Location: E: 484063, N: 6939524, Depth: 0.3m below FL
Lot No: Capping Material
Material: Sandstone - Sandy Clay / Clayey Sand
Material Source: Onsite Burrow Area



Accredited for compliance with ISO/IEC 17025 - Testing


Kiri Pitama

Approved Signatory: Kiri Pitama

Laboratory Technician

NATA Accredited Laboratory Number: 1169

Particle Size Distribution (AS1289 3.6.1)				
Sieve	Passed %	Passing Limits	Retained %	Retained Limits
37.5 mm	100		0	
26.5 mm	99		1	
19 mm	98		2	
13.2 mm	95		3	
9.5 mm	93		1	
6.7 mm	93		1	
4.75 mm	92		1	
2.36 mm	91		2	
1.18 mm	86		5	
0.6 mm	76		9	
0.425 mm	66		10	
0.3 mm	45		21	
0.15 mm	24		21	
0.075 mm	19		5	

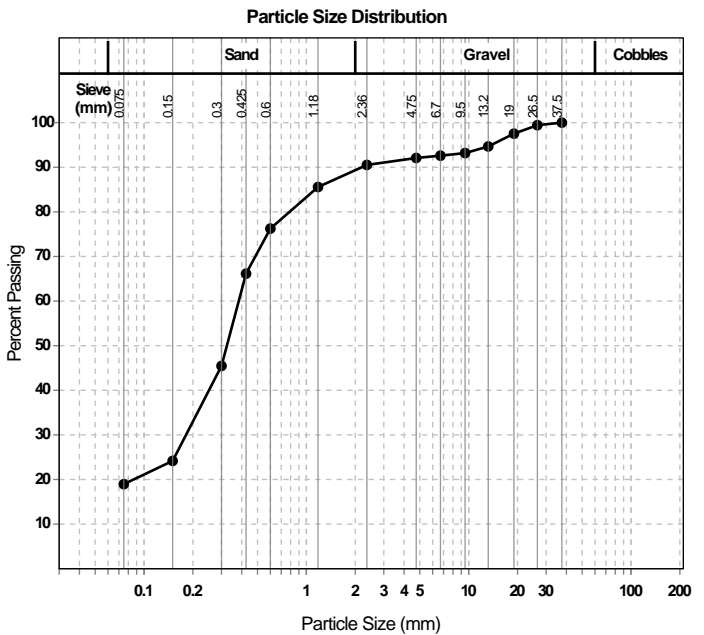

Atterberg Limit (AS1289 3.1.1 & 3.2.1 & 3.3.1)		Min	Max
Sample History	Oven Dried		
Preparation Method	Dry Sieve		
Liquid Limit (%)	32		
Plastic Limit (%)	16		
Plasticity Index (%)	16		
Weighted Plasticity Index (%)	1058		

Linear Shrinkage (AS1289 3.4.1)		Min	Max
Linear Shrinkage (%)	6.0		
Cracking Crumbling Curling	Curling		

Material Test Report

Report Number: DL20/027-18C
Issue Number: 1
Date Issued: 25/03/2020
Client: SHADFORTH'S CIVIL PTY LTD
99 SANDALWOOD LANE, FOREST GLEN QLD 4556
Project Number: DL20/027
Project Name: EARTHWORKS SUPERVISION
Project Location: EDEN'S CROSSING, STAGE 21
Work Request: 7175
Sample Number: D20-7175A
Date Sampled: 12/03/2020
Dates Tested: 12/03/2020 - 18/03/2020
Sampling Method: AS 1289.1.2.1 6.4 (b) - Sampling from layers in earthworks or pavement - compacted
Sample Location: E: 484063, N: 6939524, Depth: 0.3m below FL
Lot No: **Capping Material**
Material: Sandstone - Sandy Clay / Clayey Sand
Material Source: Onsite Burrow Area

**MORRISON
GEOTECHNIC**
Brisbane | Gold Coast | Maroochydore
Morrison Geotechnic Pty Ltd
ABN: 51 009 878 899
Brisbane Laboratory
Unit 1, 35 Limestone Darra QLD 4076
Phone: (07) 3279 0900
Email: darralab@morrisongeo.com.au



Accredited for compliance with ISO/IEC 17025 - Testing

Approved Signatory: Kiri Pitama
Laboratory Technician
NATA Accredited Laboratory Number: 1169

Shrink Swell Index (AS 1289 7.1.1 & 2.1.1)	
Iss (%)	0.1
Visual Description	Clayey Sand
* Shrink Swell Index (Iss) reported as the percentage vertical strain per pF change in suction.	

Core Shrinkage Test	
Shrinkage Strain - Oven Dried (%)	0.1
Estimated % by volume of significant inert inclusions	
Cracking	Uncracked
Crumbling	Yes
Moisture Content (%)	12.0

Swell Test	
Initial Pocket Penetrometer (kPa)	>600
Final Pocket Penetrometer (kPa)	570
Initial Moisture Content (%)	12.5
Final Moisture Content (%)	15.6
Swell (%)	0.0
* NATA Accreditation does not cover the performance of pocket penetrometer readings.	

Material Test Report



Brisbane | Gold Coast | Maroochydore

Morrison Geotechnic Pty Ltd

ABN: 51 009 878 899

Brisbane Laboratory

Unit 1, 35 Limestone Darra QLD 4076

Phone: (07) 3279 0900

Email: darralab@morrisongeo.com.au

Report Number: DL20/027-19B
Issue Number: 1
Date Issued: 27/03/2020
Client: SHADFORTH'S CIVIL PTY LTD
 99 SANDALWOOD LANE, FOREST GLEN QLD 4556
Project Number: DL20/027
Project Name: EARTHWORKS SUPERVISION
Project Location: EDEN'S CROSSING, STAGE 21
Work Request: 7187
Sample Number: D20-7187A
Date Sampled: 13/03/2020
Dates Tested: 13/03/2020 - 20/03/2020
Sampling Method: AS 1289.1.2.1 6.4 (b) - Sampling from layers in earthworks or pavement - compacted
Sample Location: E: 484154, N: 6939727, Depth: RL87.1
Lot No: Capping Material
Material: (SC) Clayey Sand Brown
Material Source: Onsite Borrow Pit



Accredited for compliance with ISO/IEC 17025 - Testing

Approved Signatory: Kiri Pitama

Laboratory Technician

NATA Accredited Laboratory Number: 1169

Particle Size Distribution (AS1289 3.6.1)					
Sieve	Passed %	Passing Limits	Retained %	Retained Limits	
26.5 mm	100		0		
19 mm	100		0		
13.2 mm	99		1		
9.5 mm	98		1		
6.7 mm	97		1		
4.75 mm	97		1		
2.36 mm	96		1		
1.18 mm	92		4		
0.6 mm	84		8		
0.425 mm	74		10		
0.3 mm	52		22		
0.15 mm	29		23		
0.075 mm	24		6		

Atterberg Limit (AS1289 3.1.1 & 3.2.1 & 3.3.1)		Min	Max
Sample History	Oven Dried		
Preparation Method	Dry Sieve		
Liquid Limit (%)	29		
Plastic Limit (%)	17		
Plasticity Index (%)	12		
Weighted Plasticity Index (%)	890		

Linear Shrinkage (AS1289 3.4.1)		Min	Max
Linear Shrinkage (%)	5.5		
Cracking Crumbling Curling	Curling		

Material Test Report

Report Number: DL20/027-19C
Issue Number: 1
Date Issued: 27/03/2020
Client: SHADFORTH'S CIVIL PTY LTD
99 SANDALWOOD LANE, FOREST GLEN QLD 4556
Project Number: DL20/027
Project Name: EARTHWORKS SUPERVISION
Project Location: EDEN'S CROSSING, STAGE 21
Work Request: 7187
Sample Number: D20-7187A
Date Sampled: 13/03/2020
Dates Tested: 13/03/2020 - 24/03/2020
Sampling Method: AS 1289.1.2.1 6.4 (b) - Sampling from layers in earthworks or pavement - compacted
Sample Location: E: 484154, N: 6939727, Depth: RL87.1
Lot No: **Capping Material**
Material: (SC) Clayey Sand Brown
Material Source: Onsite Borrow Pit

**MORRISON
GEOTECHNIC**
Brisbane | Gold Coast | Maroochydore
Morrison Geotechnic Pty Ltd
ABN: 51 009 878 899
Brisbane Laboratory
Unit 1, 35 Limestone Darra QLD 4076
Phone: (07) 3279 0900
Email: darralab@morrisongeo.com.au



Accredited for compliance with ISO/IEC 17025 - Testing

Approved Signatory: Kiri Pitama
Laboratory Technician
NATA Accredited Laboratory Number: 1169

Shrink Swell Index (AS 1289 7.1.1 & 2.1.1)	
Iss (%)	0.7
Visual Description	Clayey Sand
* Shrink Swell Index (Iss) reported as the percentage vertical strain per pF change in suction.	

Core Shrinkage Test	
Shrinkage Strain - Oven Dried (%)	1.3
Estimated % by volume of significant inert inclusions	
Cracking	Uncracked
Crumbling	Yes
Moisture Content (%)	14.0

Swell Test	
Initial Pocket Penetrometer (kPa)	>600
Final Pocket Penetrometer (kPa)	270
Initial Moisture Content (%)	13.5
Final Moisture Content (%)	17.1
Swell (%)	0.0
* NATA Accreditation does not cover the performance of pocket penetrometer readings.	

Material Test Report



Brisbane | Gold Coast | Maroochydore

Morrison Geotechnic Pty Ltd

ABN: 51 009 878 899

Brisbane Laboratory

Unit 1, 35 Limestone Darra QLD 4076

Phone: (07) 3279 0900

Email: nathaniel@mgeo.com.au

Report Number: DL20/027-20
Issue Number: 1
Date Issued: 24/03/2020
Client: SHADFORTH'S CIVIL PTY LTD
 99 SANDALWOOD LANE, FOREST GLEN QLD 4556
Project Number: DL20/027
Project Name: EARTHWORKS SUPERVISION
Project Location: EDEN'S CROSSING, STAGE 21
Work Request: 7233
Date Sampled: 17/03/2020
Dates Tested: 17/03/2020 - 19/03/2020
Sampling Method: AS 1289.1.2.1 6.4 (b) - Sampling from layers in earthworks or pavement - compacted
Specification: 95% STD
Site Selection: Selected by GTA
Material: Capping Layer - Select Fill
Material Source: Imported



Accredited for compliance with ISO/IEC 17025 - Testing

Approved Signatory: Nathaniel O'Haire
 Branch Manager

NATA Accredited Laboratory Number: 1169

Compaction Control AS 1289 5.7.1 & 5.8.1 & 2.1.1						
Sample Number	D20-7233A	D20-7233B	D20-7233C	D20-7233D	D20-7233E	D20-7233F
Date Tested	17/03/2020	17/03/2020	17/03/2020	17/03/2020	17/03/2020	17/03/2020
Time Tested	10:00	10:10	10:20	10:30	10:40	10:50
Test Request #/Location	Capping Layer - Select Fill - Lot 1098	Capping Layer - Select Fill - Lot 1097	Capping Layer - Select Fill - Lot 1096	Capping Layer - Select Fill - Lot 1095	Capping Layer - Select Fill - Lot 1036	Capping Layer - Select Fill - Lot 1037
Easting	4m from North Boundary	5m from South Boundary	5m from North Boundary	10m from North Boundary	10m from North Boundary	4m from North Boundary
Northing	10m from West Boundary	6m from East Boundary	4m from West Boundary	5m from East Boundary	5m from East Boundary	4m from West Boundary
Layer / Reduced Level	FL	0.5m Below FL	FL	0.5m Below FL	FL	0.5m Below FL
Soil Description	Clayey Sand	Clayey Sand	Clayey Sand	Clayey Sand	Clayey Sand	Clayey Sand
Test Depth (mm)	150	150	150	150	150	150
Sieve used to determine oversize (mm)	19.0	19.0	19.0	19.0	19.0	19.0
Percentage of Wet Oversize (%)	0.0	0.0	0.0	0.0	0.0	0.0
Field Wet Density (FWD) t/m ³	2.07	2.08	2.03	2.06	2.03	2.07
Field Moisture Content %	8.4	8.0	5.6	5.2	6.5	6.0
Field Dry Density (FDD) t/m ³	1.91	1.92	1.92	1.95	1.91	1.96
Peak Converted Wet Density t/m ³	2.01	2.01	1.96	1.95	1.99	1.98
Adjusted Peak Converted Wet Density t/m ³	**	**	**	**	**	**
Moisture Variation (Wv) %	4.5	4.0	6.5	7.0	5.0	6.0
Adjusted Moisture Variation %	**	**	**	**	**	**
Hilf Density Ratio (%)	103.0	103.0	103.5	105.0	102.0	105.0
Compaction Method	Standard	Standard	Standard	Standard	Standard	Standard

Moisture Variation Note:

Positive values = test is dry of OMC

Negative values = test is wet of OMC

Material Test Report



Brisbane | Gold Coast | Maroochydore

Morrison Geotechnic Pty Ltd

ABN: 51 009 878 899

Brisbane Laboratory

Unit 1, 35 Limestone Darra QLD 4076

Phone: (07) 3279 0900

Email: nathaniel@mgeo.com.au

Report Number: DL20/027-20
Issue Number: 1
Date Issued: 24/03/2020
Client: SHADFORTH'S CIVIL PTY LTD
 99 SANDALWOOD LANE, FOREST GLEN QLD 4556
Project Number: DL20/027
Project Name: EARTHWORKS SUPERVISION
Project Location: EDEN'S CROSSING, STAGE 21
Work Request: 7233
Date Sampled: 17/03/2020
Dates Tested: 17/03/2020 - 19/03/2020
Sampling Method: AS 1289.1.2.1 6.4 (b) - Sampling from layers in earthworks or pavement - compacted
Specification: 95% STD
Site Selection: Selected by GTA
Material: Capping Layer - Select Fill
Material Source: Imported



Accredited for compliance with ISO/IEC 17025 - Testing

Approved Signatory: Nathaniel O'Haire
 Branch Manager

NATA Accredited Laboratory Number: 1169

Compaction Control AS 1289 5.7.1 & 5.8.1 & 2.1.1						
Sample Number	D20-7233G	D20-7233H	D20-7233I	D20-7233J	D20-7233K	D20-7233L
Date Tested	17/03/2020	17/03/2020	17/03/2020	17/03/2020	17/03/2020	17/03/2020
Time Tested	11:00	11:10	11:20	11:30	11:40	11:50
Test Request #/Location	Capping Layer - Select Fill - Lot 1038	Capping Layer - Select Fill - Lot 1041	Capping Layer - Select Fill - Lot 1043	Capping Layer - Select Fill - Lot 1045	Capping Layer - Select Fill - Lot 1047	Capping Layer - Select Fill - Lot 1049
Easting	4m from North Boundary	4m from South Boundary	5m from South Boundary	5m from North Boundary	5m from North Boundary	4m from South Boundary
Northing	6m from East Boundary	8m from East Boundary	5m from West Boundary	8m from East Boundary	8m from West Boundary	7m from East Boundary
Layer / Reduced Level	FL	FL	0.5m Below FL	FL	FL	FL
Soil Description	Clayey Sand	Clayey Sand	Clayey Sand	Clayey Sand	Clayey Sand	Clayey Sand
Test Depth (mm)	150	150	150	150	150	150
Sieve used to determine oversize (mm)	19.0	19.0	19.0	19.0	19.0	19.0
Percentage of Wet Oversize (%)	0.0	0.0	0.0	0.0	0.0	0.0
Field Wet Density (FWD) t/m ³	2.04	2.07	2.03	2.04	2.06	2.06
Field Moisture Content %	7.2	7.5	6.2	7.2	10.4	10.1
Field Dry Density (FDD) t/m ³	1.90	1.92	1.92	1.91	1.87	1.87
Peak Converted Wet Density t/m ³	2.02	2.02	1.97	2.00	2.03	2.01
Adjusted Peak Converted Wet Density t/m ³	**	**	**	**	**	**
Moisture Variation (Wv) %	4.0	3.0	4.0	4.5	2.5	3.0
Adjusted Moisture Variation %	**	**	**	**	**	**
Hilf Density Ratio (%)	101.0	102.5	103.5	102.5	101.5	102.5
Compaction Method	Standard	Standard	Standard	Standard	Standard	Standard

Moisture Variation Note:

Positive values = test is dry of OMC
 Negative values = test is wet of OMC

Material Test Report



Brisbane | Gold Coast | Maroochydore

Morrison Geotechnic Pty Ltd

ABN: 51 009 878 899

Brisbane Laboratory

Unit 1, 35 Limestone Darra QLD 4076

Phone: (07) 3279 0900

Email: nathaniel@mgeo.com.au

Report Number: DL20/027-20
Issue Number: 1
Date Issued: 24/03/2020
Client: SHADFORTH'S CIVIL PTY LTD
 99 SANDALWOOD LANE, FOREST GLEN QLD 4556
Project Number: DL20/027
Project Name: EARTHWORKS SUPERVISION
Project Location: EDEN'S CROSSING, STAGE 21
Work Request: 7233
Date Sampled: 17/03/2020
Dates Tested: 17/03/2020 - 19/03/2020
Sampling Method: AS 1289.1.2.1 6.4 (b) - Sampling from layers in earthworks or pavement - compacted
Specification: 95% STD
Site Selection: Selected by GTA
Material: Capping Layer - Select Fill
Material Source: Imported



Accredited for compliance with ISO/IEC 17025 - Testing

Approved Signatory: Nathaniel O'Haire
 Branch Manager

NATA Accredited Laboratory Number: 1169

Compaction Control AS 1289 5.7.1 & 5.8.1 & 2.1.1						
Sample Number	D20-7233M	D20-7233N	D20-7233O			
Date Tested	17/03/2020	17/03/2020	17/03/2020			
Time Tested	12:00	12:10	12:20			
Test Request #/Location	Capping Layer - Select Fill - Lot 1083	Capping Layer - Select Fill - Lot 1081	Capping Layer - Select Fill - Lot 1079			
Easting	5m from North Boundary	4m from South Boundary	6m from North Boundary			
Northing	7m from West Boundary	8m from West Boundary	6m from East Boundary			
Layer / Reduced Level	0.5m Below FL	FL	FL			
Soil Description	Clayey Sand	Clayey Sand	Clayey Sand			
Test Depth (mm)	150	150	150			
Sieve used to determine oversize (mm)	19.0	19.0	19.0			
Percentage of Wet Oversize (%)	0.0	0.0	0.0			
Field Wet Density (FWD) t/m ³	2.04	2.06	2.00			
Field Moisture Content %	9.2	8.1	7.4			
Field Dry Density (FDD) t/m ³	1.87	1.91	1.86			
Peak Converted Wet Density t/m ³	2.00	1.99	1.99			
Adjusted Peak Converted Wet Density t/m ³	**	**	**			
Moisture Variation (Wv) %	3.0	2.5	3.0			
Adjusted Moisture Variation %	**	**	**			
Hilf Density Ratio (%)	102.0	103.5	100.5			
Compaction Method	Standard	Standard	Standard			

Moisture Variation Note:

Positive values = test is dry of OMC
 Negative values = test is wet of OMC

Material Test Report

Report Number: DL20/027-21
Issue Number: 1
Date Issued: 25/03/2020
Client: SHADFORTH'S CIVIL PTY LTD
 99 SANDALWOOD LANE, FOREST GLEN QLD 4556
Project Number: DL20/027
Project Name: EARTHWORKS SUPERVISION
Project Location: EDEN'S CROSSING, STAGE 21
Work Request: 7282
Date Sampled: 18/03/2020
Dates Tested: 18/03/2020 - 25/03/2020
Sampling Method: AS 1289.1.2.1 6.4 (b) - Sampling from layers in earthworks or pavement - compacted
Specification: 95% STD
Site Selection: Selected by GTA
Material: Capping Layer - Select Fill
Material Source: Imported - Burrow Area



Accredited for compliance with ISO/IEC 17025 - Testing

Approved Signatory: Rhys Mitchell
 Senior Technician
 NATA Accredited Laboratory Number: 1169

Compaction Control AS 1289 5.7.1 & 5.8.1 & 2.1.1				
Sample Number	D20-7282A	D20-7282B	D20-7282C	D20-7282D
Date Tested	18/03/2020	18/03/2020	18/03/2020	18/03/2020
Time Tested	10:30	10:40	10:50	11:00
Test Request #/Location	Capping Layer - Select Fill - Lot 1082	Capping Layer - Select Fill - Lot 1082	Capping Layer - Select Fill - Lot 1082	Capping Layer - Select Fill - Lot 1085
Easting	4m from South Boundary	4m from North Boundary	6m from North Boundary	4m from North Boundary
Northing	5m from West Boundary	7m from East Boundary	6m from East Boundary	7m from East Boundary
Layer / Reduced Level	FL	0.8m Below FL	0.5m Below FL	FL
Soil Description	Clayey Sand	Clayey Sand	Clayey Sand	Clayey Sand
Test Depth (mm)	150	150	150	150
Sieve used to determine oversize (mm)	19.0	19.0	19.0	19.0
Percentage of Wet Oversize (%)	0.0	0.0	0.0	0.0
Field Wet Density (FWD) t/m ³	2.10	2.02	2.14	2.06
Field Moisture Content %	11.6	8.2	10.7	8.2
Field Dry Density (FDD) t/m ³	1.88	1.87	1.94	1.90
Peak Converted Wet Density t/m ³	2.07	2.03	2.08	2.00
Adjusted Peak Converted Wet Density t/m ³	**	**	**	**
Moisture Variation (Wv) %	1.5	3.0	2.5	2.5
Adjusted Moisture Variation %	**	**	**	**
Hilf Density Ratio (%)	101.0	99.5	103.0	102.5
Compaction Method	Standard	Standard	Standard	Standard

Moisture Variation Note:

Positive values = test is dry of OMC
 Negative values = test is wet of OMC

Material Test Report

Report Number: DL20/027-22B
Issue Number: 1
Date Issued: 26/03/2020
Client: SHADFORTH'S CIVIL PTY LTD
99 SANDALWOOD LANE, FOREST GLEN QLD 4556
Project Number: DL20/027
Project Name: EARTHWORKS SUPERVISION
Project Location: EDEN'S CROSSING, STAGE 21
Work Request: 7211
Sample Number: D20-7211A
Date Sampled: 16/03/2020
Dates Tested: 16/03/2020 - 23/03/2020
Sampling Method: AS 1289.1.2.1 6.4 (b) - Sampling from layers in earthworks or pavement - compacted
Sample Location: E: 484242.9, N: 6939682.4, Depth: 91.6
Lot No: Capping Layer - Select Fill
Material: Clayey Sand
Material Source: Imported

**MORRISON
GEOTECHNIC**
Brisbane | Gold Coast | Maroochydore
Morrison Geotechnic Pty Ltd
ABN: 51 009 878 899
Brisbane Laboratory
Unit 1, 35 Limestone Darra QLD 4076
Phone: (07) 3279 0900
Email: darralab@morrisongeo.com.au



Accredited for compliance with ISO/IEC 17025 - Testing

Approved Signatory: Kiri Pitama
Laboratory Technician
NATA Accredited Laboratory Number: 1169

Shrink Swell Index (AS 1289 7.1.1 & 2.1.1)	
Iss (%)	0.4
Visual Description	Clayey Sand
* Shrink Swell Index (Iss) reported as the percentage vertical strain per pF change in suction.	

Core Shrinkage Test	
Shrinkage Strain - Oven Dried (%)	0.8
Estimated % by volume of significant inert inclusions	
Cracking	Uncracked
Crumbling	Yes
Moisture Content (%)	12.6

Swell Test	
Initial Pocket Penetrometer (kPa)	>600
Final Pocket Penetrometer (kPa)	170
Initial Moisture Content (%)	12.1
Final Moisture Content (%)	18.5
Swell (%)	0.0
* NATA Accreditation does not cover the performance of pocket penetrometer readings.	

Material Test Report



Brisbane | Gold Coast | Maroochydore

Morrison Geotechnic Pty Ltd

ABN: 51 009 878 899

Brisbane Laboratory

Unit 1, 35 Limestone Darra QLD 4076

Phone: (07) 3279 0900

Email: darralab@morrisongeo.com.au

Report Number: DL20/027-23A
Issue Number: 1
Date Issued: 27/03/2020
Client: SHADFORTH'S CIVIL PTY LTD
 99 SANDALWOOD LANE, FOREST GLEN QLD 4556
Project Number: DL20/027
Project Name: EARTHWORKS SUPERVISION
Project Location: EDEN'S CROSSING, STAGE 21
Work Request: 7186
Sample Number: D20-7186A
Date Sampled: 13/03/2020
Dates Tested: 13/03/2020 - 24/03/2020
Sampling Method: AS 1289.1.2.1 6.4 (b) - Sampling from layers in earthworks or pavement - compacted
Sample Location: E: 484086, N: 6939737, Depth: RL 85.7
Lot No: Capping Material
Material: (SC) Clayey Sand Brown
Material Source: Onsite Burrow Area



Accredited for compliance with ISO/IEC 17025 - Testing

K. Pitama

Approved Signatory: Kiri Pitama


Laboratory Technician

NATA Accredited Laboratory Number: 1169

Particle Size Distribution (AS1289 3.6.1)				
Sieve	Passed %	Passing Limits	Retained %	Retained Limits
26.5 mm	100		0	
19 mm	99		1	
13.2 mm	97		2	
9.5 mm	96		1	
6.7 mm	95		1	
4.75 mm	95		0	
2.36 mm	93		1	
1.18 mm	88		5	
0.6 mm	78		10	
0.425 mm	68		10	
0.3 mm	48		21	
0.15 mm	28		20	
0.075 mm	21		7	

Atterberg Limit (AS1289 3.1.1 & 3.2.1 & 3.3.1)		Min	Max
Sample History	Oven Dried		
Preparation Method	Dry Sieve		
Liquid Limit (%)	32		
Plastic Limit (%)	16		
Plasticity Index (%)	16		
Weighted Plasticity Index (%)	1096		

Linear Shrinkage (AS1289 3.4.1)		Min	Max
Linear Shrinkage (%)	6.5		
Cracking Crumbling Curling	Curling		

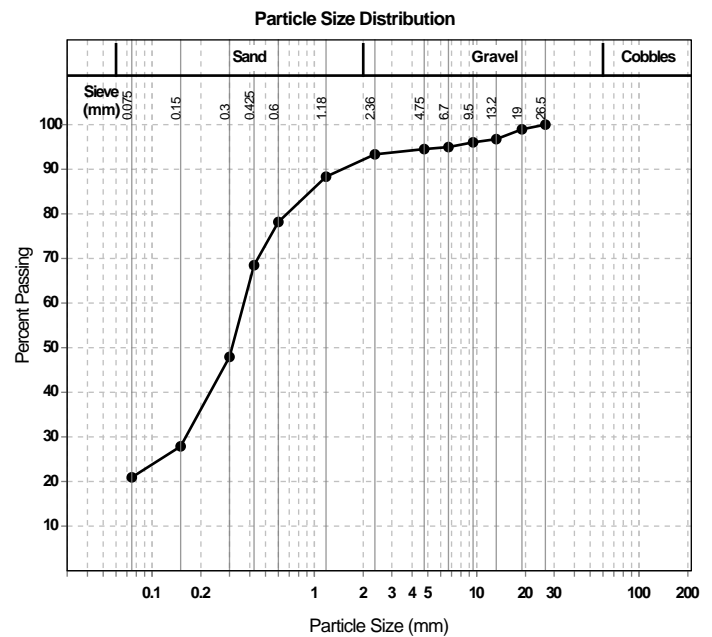

Material Test Report



Brisbane | Gold Coast | Maroochydore

Morrison Geotechnic Pty Ltd

ABN: 51 009 878 899

Brisbane Laboratory

Unit 1, 35 Limestone Darra QLD 4076

Phone: (07) 3279 0900

Email: nathaniel@mgeo.com.au

Report Number: DL20/027-24K
Issue Number: 1
Date Issued: 07/04/2020
Client: SHADFORTH'S CIVIL PTY LTD
 99 SANDALWOOD LANE, FOREST GLEN QLD 4556
Project Number: DL20/027
Project Name: EARTHWORKS SUPERVISION
Project Location: EDEN'S CROSSING, STAGE 21
Work Request: 7236
Sample Number: D20-7236D
Date Sampled: 17/03/2020
Dates Tested: 17/03/2020 - 27/03/2020
Sampling Method: AS 1289.1.2.1 6.4 (b) - Sampling from layers in earthworks or pavement - compacted
Sample Location: Lot 1053, 7m From South Boundary, 5m from West Boundary (FL)
Lot No: Capping Material
Material: Clayey Sand / Sandy Clay
Material Source: Imported from Burrow Area

Accredited for compliance with ISO/IEC 17025 - Testing




Approved Signatory: Nathaniel O'Haire
 Branch Manager

NATA Accredited Laboratory Number: 1169

California Bearing Ratio (AS 1289 6.1.1 & 2.1.1)		Min	Max
CBR taken at	5 mm		
CBR %	8		
Method of Compactive Effort	Standard		
Method used to Determine MDD	AS 1289 5.1.1 & 2.1.1		
Method used to Determine Plasticity	VISUAL		
Maximum Dry Density (t/m ³)	1.85		
Optimum Moisture Content (%)	12.5		
Laboratory Density Ratio (%)	100.5		
Laboratory Moisture Ratio (%)	100.0		
Dry Density after Soaking (t/m ³)	1.86		
Field Moisture Content (%)	5.4		
Moisture Content at Placement (%)	12.3		
Moisture Content Top 30mm (%)	12.8		
Moisture Content Rest of Sample (%)	14.6		
Mass Surcharge (kg)	4.5		
Soaking Period (days)	4		
Curing Hours	48		
Swell (%)	0.0		
Oversize Material (mm)	19		
Oversize Material Included	Excluded		
Oversize Material (%)	0		

California Bearing Ratio

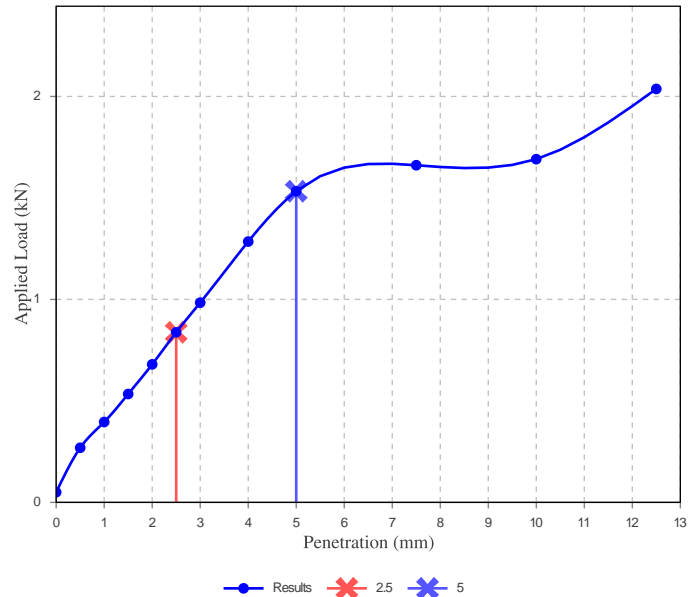

Material Test Report

Report Number: DL20/027-23B
Issue Number: 1
Date Issued: 27/03/2020
Client: SHADFORTH'S CIVIL PTY LTD
99 SANDALWOOD LANE, FOREST GLEN QLD 4556
Project Number: DL20/027
Project Name: EARTHWORKS SUPERVISION
Project Location: EDEN'S CROSSING, STAGE 21
Work Request: 7186
Sample Number: D20-7186A
Date Sampled: 13/03/2020
Dates Tested: 13/03/2020 - 25/03/2020
Sampling Method: AS 1289.1.2.1 6.4 (b) - Sampling from layers in earthworks or pavement - compacted
Sample Location: E: 484086, N: 6939737, Depth: RL 85.7
Lot No: **Capping Material**
Material: (SC) Clayey Sand Brown
Material Source: Onsite Burrow Area

**MORRISON
GEOTECHNIC**
Brisbane | Gold Coast | Maroochydore
Morrison Geotechnic Pty Ltd
ABN: 51 009 878 899
Brisbane Laboratory
Unit 1, 35 Limestone Darra QLD 4076
Phone: (07) 3279 0900
Email: darralab@morrisongeo.com.au



Accredited for compliance with ISO/IEC 17025 - Testing

Approved Signatory: Kiri Pitama
Laboratory Technician
NATA Accredited Laboratory Number: 1169

Shrink Swell Index (AS 1289 7.1.1 & 2.1.1)

Iss (%)	0.1
Visual Description	Clayey Sand
* Shrink Swell Index (Iss) reported as the percentage vertical strain per pF change in suction.	

Core Shrinkage Test

Shrinkage Strain - Oven Dried (%)	0.2
Estimated % by volume of significant inert inclusions	
Cracking	Uncracked
Crumbling	Yes
Moisture Content (%)	13.1

Swell Test

Initial Pocket Penetrometer (kPa)	>600
Final Pocket Penetrometer (kPa)	300
Initial Moisture Content (%)	13.5
Final Moisture Content (%)	17.4
Swell (%)	0.0

* NATA Accreditation does not cover the performance of pocket penetrometer readings.

Material Test Report



Brisbane | Gold Coast | Maroochydore

Morrison Geotechnic Pty Ltd

ABN: 51 009 878 899

Brisbane Laboratory

Unit 1, 35 Limestone Darra QLD 4076

Phone: (07) 3279 0900

Email: jwieland@mgeo.com.au

Report Number: DL20/027-23C
Issue Number: 1
Date Issued: 27/03/2020
Client: SHADFORTH'S CIVIL PTY LTD
 99 SANDALWOOD LANE, FOREST GLEN QLD 4556
Project Number: DL20/027
Project Name: EARTHWORKS SUPERVISION
Project Location: EDEN'S CROSSING, STAGE 21
Work Request: 7186
Sample Number: D20-7186A
Date Sampled: 13/03/2020
Dates Tested: 13/03/2020 - 20/03/2020
Sampling Method: AS 1289.1.2.1 6.4 (b) - Sampling from layers in earthworks or pavement - compacted
Sample Location: E: 484086, N: 6939737, Depth: RL 85.7
Lot No: Capping Material
Material: (SC) Clayey Sand Brown
Material Source: Onsite Burrow Area

Accredited for compliance with ISO/IEC 17025 - Testing




Approved Signatory: John Wieland

Senior Soil Technician

NATA Accredited Laboratory Number: 1169

California Bearing Ratio (AS 1289 6.1.1 & 2.1.1)		Min	Max
CBR taken at	5 mm		
CBR %	11		
Method of Compactive Effort	Standard		
Method used to Determine MDD	AS 1289 5.1.1 & 2.1.1		
Method used to Determine Plasticity	VISUAL		
Maximum Dry Density (t/m ³)	1.82		
Optimum Moisture Content (%)	13.0		
Laboratory Density Ratio (%)	100.5		
Laboratory Moisture Ratio (%)	100.0		
Dry Density after Soaking (t/m ³)	1.83		
Field Moisture Content (%)	7.1		
Moisture Content at Placement (%)	13.2		
Moisture Content Top 30mm (%)	13.3		
Moisture Content Rest of Sample (%)	13.7		
Mass Surcharge (kg)	4.5		
Soaking Period (days)	4		
Curing Hours	48		
Swell (%)	0.0		
Oversize Material (mm)	19		
Oversize Material Included	Excluded		
Oversize Material (%)			

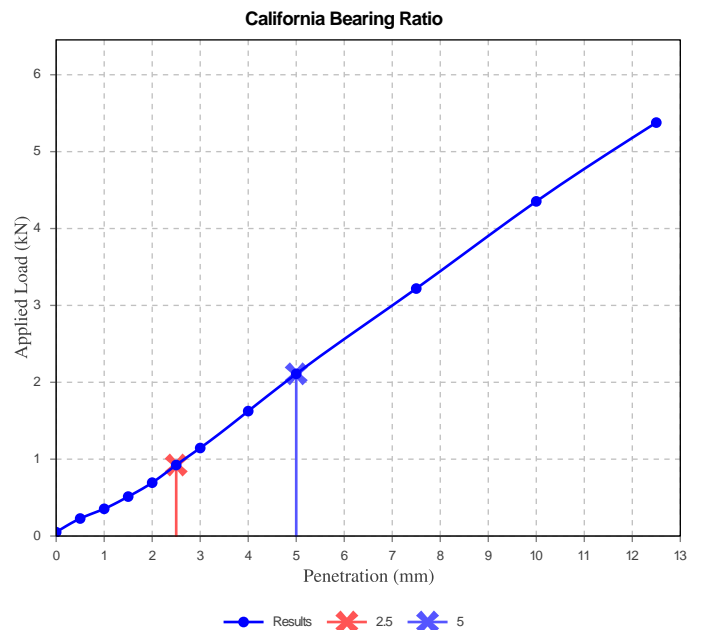

Material Test Report

Report Number: DL20/027-24A
Issue Number: 1
Date Issued: 31/03/2020
Client: SHADFORTH'S CIVIL PTY LTD
 99 SANDALWOOD LANE, FOREST GLEN QLD 4556
Project Number: DL20/027
Project Name: EARTHWORKS SUPERVISION
Project Location: EDEN'S CROSSING, STAGE 21
Work Request: 7236
Sample Number: D20-7236A
Date Sampled: 17/03/2020
Dates Tested: 17/03/2020 - 24/03/2020
Sampling Method: AS 1289.1.2.1 6.4 (b) - Sampling from layers in earthworks or pavement - compacted
Sample Location: Lot 1084, 8m From North Boundary, 6m From West Boundary (0.8m Below FL)
Lot No: Capping Material
Material: Clayey Sand / Sandy Clay
Material Source: Imported from Burrow Area




Accredited for compliance with ISO/IEC 17025 - Testing

Approved Signatory: Kiri Pitama
 Laboratory Technician
 NATA Accredited Laboratory Number: 1169

Particle Size Distribution (AS1289 3.6.1)				
Sieve	Passed %	Passing Limits	Retained %	Retained Limits
26.5 mm	100		0	
19 mm	99		1	
13.2 mm	95		3	
9.5 mm	93		3	
6.7 mm	92		0	
4.75 mm	92		0	
2.36 mm	91		1	
1.18 mm	86		5	
0.6 mm	76		10	
0.425 mm	66		10	
0.3 mm	45		21	
0.15 mm	25		19	
0.075 mm	19		6	

Atterberg Limit (AS1289 3.1.1 & 3.2.1 & 3.3.1)		Min	Max
Sample History	Oven Dried		
Preparation Method	Dry Sieve		
Liquid Limit (%)	31		
Plastic Limit (%)	17		
Plasticity Index (%)	14		
Weighted Plasticity Index (%)	927		

Linear Shrinkage (AS1289 3.4.1)		Min	Max
Linear Shrinkage (%)	6.5		
Cracking Crumbling Curling	Cracking & Curling		

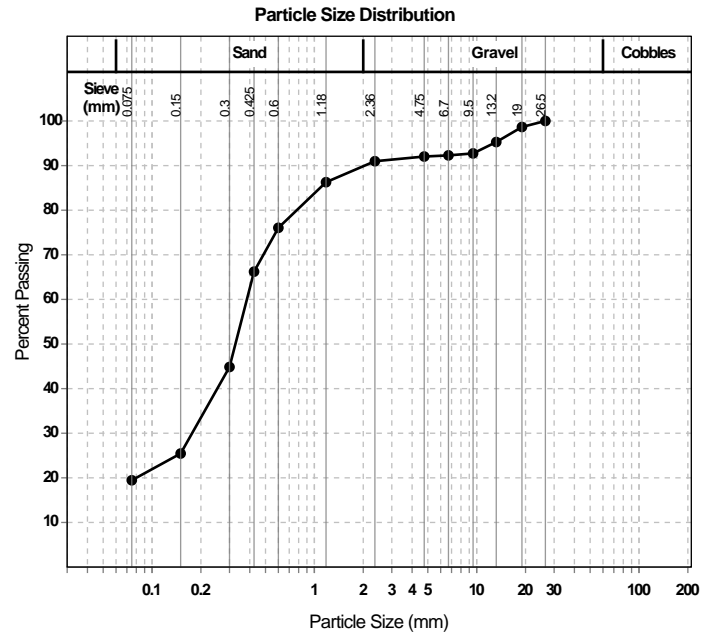

Material Test Report



Brisbane | Gold Coast | Maroochydore

Morrison Geotechnic Pty Ltd

ABN: 51 009 878 899

Brisbane Laboratory

Unit 1, 35 Limestone Darra QLD 4076

Phone: (07) 3279 0900

Email: nathaniel@mgeo.com.au

Report Number: DL20/027-24H
Issue Number: 1
Date Issued: 07/04/2020
Client: SHADFORTH'S CIVIL PTY LTD
 99 SANDALWOOD LANE, FOREST GLEN QLD 4556
Project Number: DL20/027
Project Name: EARTHWORKS SUPERVISION
Project Location: EDEN'S CROSSING, STAGE 21
Work Request: 7236
Sample Number: D20-7236A
Date Sampled: 17/03/2020
Dates Tested: 17/03/2020 - 27/03/2020
Sampling Method: AS 1289.1.2.1 6.4 (b) - Sampling from layers in earthworks or pavement - compacted
Sample Location: Lot 1084, 8m From North Boundary, 6m From West Boundary (0.8m Below FL)
Lot No: Capping Material
Material: Clayey Sand / Sandy Clay
Material Source: Imported from Burrow Area


Accredited for compliance with ISO/IEC 17025 - Testing



Approved Signatory: Nathaniel O'Haire
 Branch Manager

NATA Accredited Laboratory Number: 1169

California Bearing Ratio (AS 1289 6.1.1 & 2.1.1)		Min	Max
CBR taken at	5 mm		
CBR %	14		
Method of Compactive Effort	Standard		
Method used to Determine MDD	AS 1289 5.1.1 & 2.1.1		
Method used to Determine Plasticity	VISUAL		
Maximum Dry Density (t/m ³)	1.84		
Optimum Moisture Content (%)	12.5		
Laboratory Density Ratio (%)	100.5		
Laboratory Moisture Ratio (%)	100.0		
Dry Density after Soaking (t/m ³)	1.85		
Field Moisture Content (%)	5.9		
Moisture Content at Placement (%)	12.4		
Moisture Content Top 30mm (%)	13.1		
Moisture Content Rest of Sample (%)	14.1		
Mass Surcharge (kg)	4.5		
Soaking Period (days)	4		
Curing Hours	48		
Swell (%)	0.0		
Oversize Material (mm)	19		
Oversize Material Included	Excluded		
Oversize Material (%)	0		

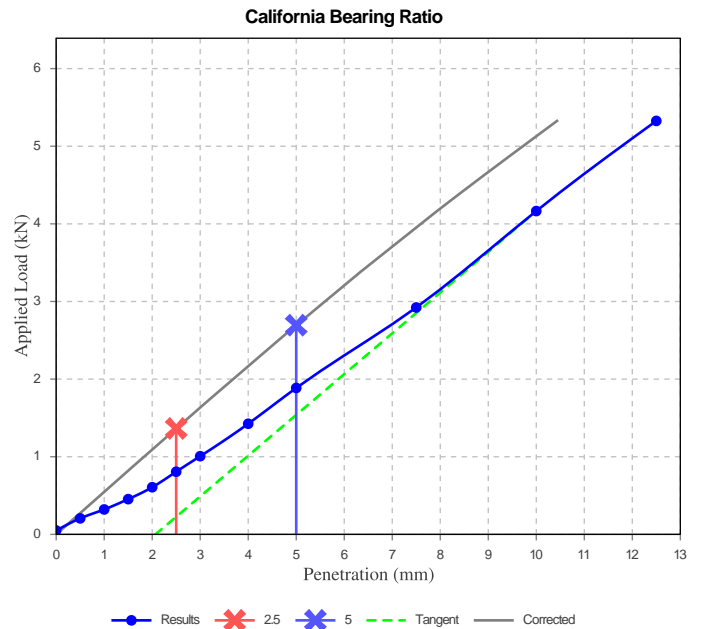

Material Test Report

Report Number: DL20/027-24B
Issue Number: 1
Date Issued: 31/03/2020
Client: SHADFORTH'S CIVIL PTY LTD
 99 SANDALWOOD LANE, FOREST GLEN QLD 4556
Project Number: DL20/027
Project Name: EARTHWORKS SUPERVISION
Project Location: EDEN'S CROSSING, STAGE 21
Work Request: 7236
Sample Number: D20-7236B
Date Sampled: 17/03/2020
Dates Tested: 17/03/2020 - 25/03/2020
Sampling Method: AS 1289.1.2.1 6.4 (b) - Sampling from layers in earthworks or pavement - compacted
Sample Location: Lot 1079, 6m from West Boundary, 6m from South Boundary (FL)
Lot No: Capping Material
Material: Clayey Sand / Sandy Clay
Material Source: Imported from Burrow Area




Accredited for compliance with ISO/IEC 17025 - Testing

Approved Signatory: Kiri Pitama
 Laboratory Technician
 NATA Accredited Laboratory Number: 1169

Particle Size Distribution (AS1289 3.6.1)				
Sieve	Passed %	Passing Limits	Retained %	Retained Limits
26.5 mm	100		0	
19 mm	100		0	
13.2 mm	98		2	
9.5 mm	97		1	
6.7 mm	96		1	
4.75 mm	96		0	
2.36 mm	94		1	
1.18 mm	89		6	
0.6 mm	78		10	
0.425 mm	69		9	
0.3 mm	49		21	
0.15 mm	28		20	
0.075 mm	21		7	

Atterberg Limit (AS1289 3.1.1 & 3.2.1 & 3.3.1)		Min	Max
Sample History	Oven Dried		
Preparation Method	Dry Sieve		
Liquid Limit (%)	30		
Plastic Limit (%)	16		
Plasticity Index (%)	14		
Weighted Plasticity Index (%)	968		

Linear Shrinkage (AS1289 3.4.1)		Min	Max
Linear Shrinkage (%)	5.5		
Cracking Crumbling Curling	Cracking & Curling		

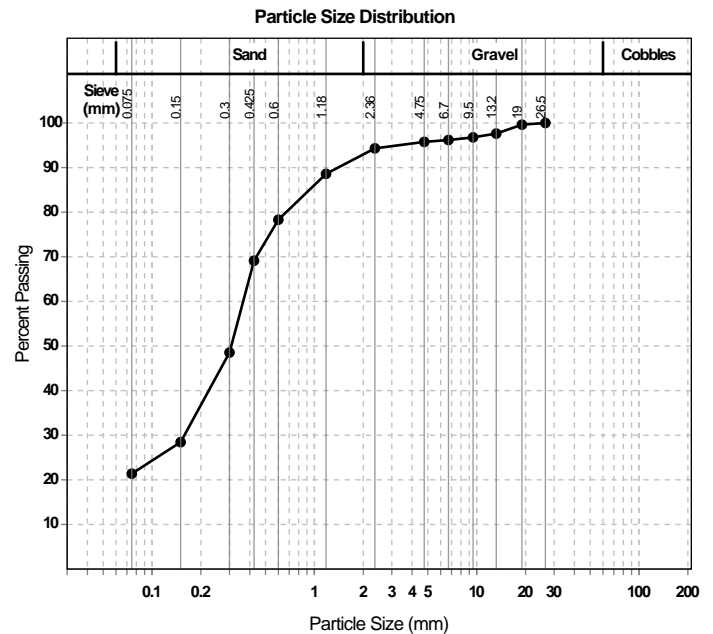

Material Test Report



Brisbane | Gold Coast | Maroochydore

Morrison Geotechnic Pty Ltd

ABN: 51 009 878 899

Brisbane Laboratory

Unit 1, 35 Limestone Darra QLD 4076

Phone: (07) 3279 0900

Email: darralab@morrisongeo.com.au

Report Number: DL20/027-24C
Issue Number: 1
Date Issued: 31/03/2020
Client: SHADFORTH'S CIVIL PTY LTD
 99 SANDALWOOD LANE, FOREST GLEN QLD 4556
Project Number: DL20/027
Project Name: EARTHWORKS SUPERVISION
Project Location: EDEN'S CROSSING, STAGE 21
Work Request: 7236
Sample Number: D20-7236C
Date Sampled: 17/03/2020
Dates Tested: 17/03/2020 - 26/03/2020
Sampling Method: AS 1289.1.2.1 6.4 (b) - Sampling from layers in earthworks or pavement - compacted
Sample Location: Lot 1096, 6m From North Boundary, 4m from East Boundary (FL)
Lot No: Capping Material
Material: Clayey Sand / Sandy Clay
Material Source: Imported from Burrow Area



Accredited for compliance with ISO/IEC 17025 - Testing

Kiri Pitama

Approved Signatory: Kiri Pitama


Laboratory Technician

NATA Accredited Laboratory Number: 1169

Particle Size Distribution (AS1289 3.6.1)				
Sieve	Passed %	Passing Limits	Retained %	Retained Limits
19 mm	100		0	
13.2 mm	100		0	
9.5 mm	100		0	
6.7 mm	99		0	
4.75 mm	99		0	
2.36 mm	98		2	
1.18 mm	92		5	
0.6 mm	82		10	
0.425 mm	72		10	
0.3 mm	51		21	
0.15 mm	30		21	
0.075 mm	22		8	

Atterberg Limit (AS1289 3.1.1 & 3.2.1 & 3.3.1)		Min	Max
Sample History	Oven Dried		
Preparation Method	Dry Sieve		
Liquid Limit (%)	30		
Plastic Limit (%)	16		
Plasticity Index (%)	14		
Weighted Plasticity Index (%)	1013		

Linear Shrinkage (AS1289 3.4.1)		Min	Max
Linear Shrinkage (%)	5.0		
Cracking Crumbling Curling	Cracking & Curling		

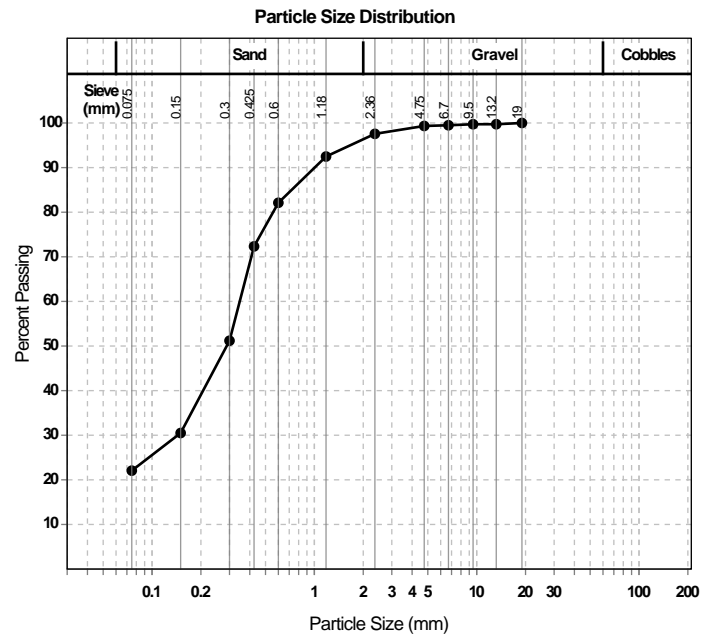

Material Test Report



Brisbane | Gold Coast | Maroochydore

Morrison Geotechnic Pty Ltd

ABN: 51 009 878 899

Brisbane Laboratory

Unit 1, 35 Limestone Darra QLD 4076

Phone: (07) 3279 0900

Email: darralab@morrisongeo.com.au

Report Number: DL20/027-24D
Issue Number: 1
Date Issued: 31/03/2020
Client: SHADFORTH'S CIVIL PTY LTD
 99 SANDALWOOD LANE, FOREST GLEN QLD 4556
Project Number: DL20/027
Project Name: EARTHWORKS SUPERVISION
Project Location: EDEN'S CROSSING, STAGE 21
Work Request: 7236
Sample Number: D20-7236D
Date Sampled: 17/03/2020
Dates Tested: 17/03/2020 - 26/03/2020
Sampling Method: AS 1289.1.2.1 6.4 (b) - Sampling from layers in earthworks or pavement - compacted
Sample Location: Lot 1053, 7m From South Boundary, 5m from West Boundary (FL)
Lot No: Capping Material
Material: Clayey Sand / Sandy Clay
Material Source: Imported from Burrow Area



Accredited for compliance with ISO/IEC 17025 - Testing

K. Pitama

Approved Signatory: Kiri Pitama


Laboratory Technician

NATA Accredited Laboratory Number: 1169

Particle Size Distribution (AS1289 3.6.1)				
Sieve	Passed %	Passing Limits	Retained %	Retained Limits
26.5 mm	100		0	
19 mm	99		1	
13.2 mm	97		2	
9.5 mm	97		0	
6.7 mm	97		0	
4.75 mm	97		0	
2.36 mm	95		2	
1.18 mm	89		6	
0.6 mm	79		10	
0.425 mm	69		10	
0.3 mm	48		22	
0.15 mm	27		20	
0.075 mm	21		6	

Atterberg Limit (AS1289 3.1.1 & 3.2.1 & 3.3.1)		Min	Max
Sample History	Oven Dried		
Preparation Method	Dry Sieve		
Liquid Limit (%)	32		
Plastic Limit (%)	16		
Plasticity Index (%)	16		
Weighted Plasticity Index (%)	1107		

Linear Shrinkage (AS1289 3.4.1)		Min	Max
Linear Shrinkage (%)	5.5		
Cracking Crumbling Curling	Cracking & Curling		

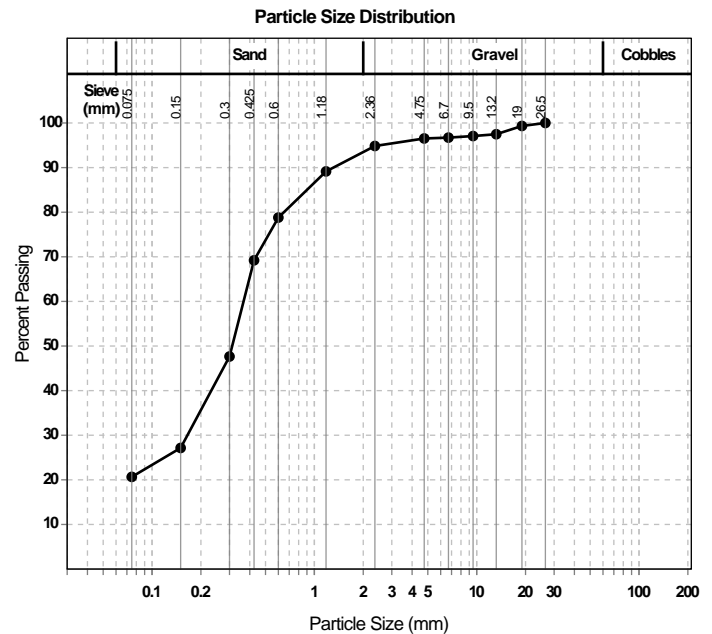

Material Test Report

Report Number: DL20/027-24E
Issue Number: 1
Date Issued: 31/03/2020
Client: SHADFORTH'S CIVIL PTY LTD
 99 SANDALWOOD LANE, FOREST GLEN QLD 4556
Project Number: DL20/027
Project Name: EARTHWORKS SUPERVISION
Project Location: EDEN'S CROSSING, STAGE 21
Work Request: 7236
Sample Number: D20-7236E
Date Sampled: 17/03/2020
Dates Tested: 17/03/2020 - 23/03/2020
Sampling Method: AS 1289.1.2.1 6.4 (b) - Sampling from layers in earthworks or pavement - compacted
Sample Location: Lot 1049, 4m from South Boundary, 8m from West Boundary (FL)
Lot No: Capping Material
Material: Clayey Sand / Sandy Clay
Material Source: Imported from Burrow Area




Accredited for compliance with ISO/IEC 17025 - Testing

Approved Signatory: Kiri Pitama
 Laboratory Technician
 NATA Accredited Laboratory Number: 1169

Particle Size Distribution (AS1289 3.6.1)				
Sieve	Passed %	Passing Limits	Retained %	Retained Limits
26.5 mm	100		0	
19 mm	100		0	
13.2 mm	97		3	
9.5 mm	96		1	
6.7 mm	95		1	
4.75 mm	95		0	
2.36 mm	94		0	
1.18 mm	89		6	
0.6 mm	79		10	
0.425 mm	69		10	
0.3 mm	48		21	
0.15 mm	28		20	
0.075 mm	21		7	

Atterberg Limit (AS1289 3.1.1 & 3.2.1 & 3.3.1)		Min	Max
Sample History	Oven Dried		
Preparation Method	Dry Sieve		
Liquid Limit (%)	32		
Plastic Limit (%)	16		
Plasticity Index (%)	16		
Weighted Plasticity Index (%)	1104		

Linear Shrinkage (AS1289 3.4.1)		Min	Max
Linear Shrinkage (%)	5.5		
Cracking Crumbling Curling	Cracking & Curling		

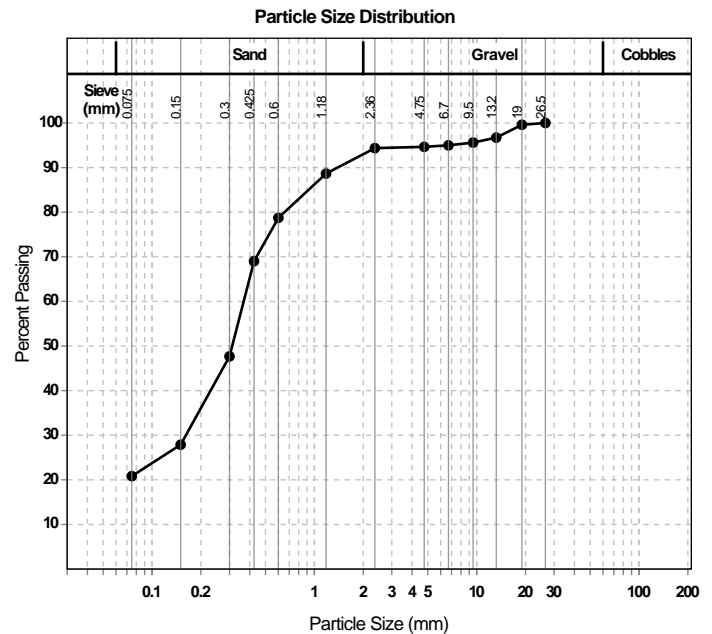

Material Test Report

Report Number: DL20/027-24F
Issue Number: 1
Date Issued: 31/03/2020
Client: SHADFORTH'S CIVIL PTY LTD
99 SANDALWOOD LANE, FOREST GLEN QLD 4556
Project Number: DL20/027
Project Name: EARTHWORKS SUPERVISION
Project Location: EDEN'S CROSSING, STAGE 21
Work Request: 7236
Dates Tested: 17/03/2020 - 25/03/2020



Accredited for compliance with ISO/IEC 17025 - Testing

Approved Signatory: Kiri Pitama
Laboratory Technician
NATA Accredited Laboratory Number: 1169

Shrink Swell Index AS 1289 7.1.1 & 2.1.1					
Sample Number	D20-7236A	D20-7236B	D20-7236C	D20-7236D	D20-7236E
Date Sampled	17/03/2020	17/03/2020	17/03/2020	17/03/2020	17/03/2020
Date Tested	25/03/2020	25/03/2020	25/03/2020	25/03/2020	25/03/2020
Material Source	Remoulded	Remoulded	Remoulded	Remoulded	Remoulded
Sample Location	Lot 1084, 8m From North Boundary, 6m From West Boundary (0.8m Below FL)	Lot 1079, 6m from West Boundary, 6m from South Boundary (FL)	Lot 1096, 6m From North Boundary, 4m from East Boundary (FL)	Lot 1053, 7m From South Boundary, 5m from West Boundary (FL)	Lot 1049, 4m from South Boundary, 8m from West Boundary (FL)
Inert Material Estimate (%)	**	**	**	**	**
Pocket Penetrometer before (kPa)	>600	>600	>600	>600	>600
Pocket Penetrometer after (kPa)	580	380	580	270	340
Shrinkage Moisture Content (%)	12.3	13.9	13.3	12.6	11.8
Shrinkage (%)	0.4	1.3	0.3	0.6	0.1
Swell Moisture Content Before (%)	12.3	13.6	12.7	12.0	11.2
Swell Moisture Content After (%)	15.0	15.9	15.2	17.8	16.2
Swell (%)	0.0	0.0	0.0	0.0	0.0
Shrink Swell Index Iss (%)	0.2	0.7	0.2	0.3	0.1
Visual Description	Clayey Sand	Clayey Sand	Clayey Sand	Clayey Sand	Clayey Sand
Cracking	UC	UC	UC	UC	UC
Crumbling	Yes	Yes	Yes	Yes	Yes
Remarks	**	**	**	**	**

Shrink Swell Index (Iss) reported as the percentage vertical strain per pF change in suction.

Cracking Terminology: UC Uncracked, SC Slightly Cracked, MC Moderately Cracked, HC Highly Cracked, FR Fragmented.

NATA Accreditation does not cover the performance of pocket penetrometer readings.

Material Test Report



Brisbane | Gold Coast | Maroochydore

Morrison Geotechnic Pty Ltd

ABN: 51 009 878 899

Brisbane Laboratory

Unit 1, 35 Limestone Darra QLD 4076

Phone: (07) 3279 0900

Email: nathaniel@mgeo.com.au

Report Number: DL20/027-24I
Issue Number: 1
Date Issued: 07/04/2020
Client: SHADFORTH'S CIVIL PTY LTD
 99 SANDALWOOD LANE, FOREST GLEN QLD 4556
Project Number: DL20/027
Project Name: EARTHWORKS SUPERVISION
Project Location: EDEN'S CROSSING, STAGE 21
Work Request: 7236
Sample Number: D20-7236B
Date Sampled: 17/03/2020
Dates Tested: 17/03/2020 - 27/03/2020
Sampling Method: AS 1289.1.2.1 6.4 (b) - Sampling from layers in earthworks or pavement - compacted
Sample Location: Lot 1079, 6m from West Boundary, 6m from South Boundary (FL)
Lot No: Capping Material
Material: Clayey Sand / Sandy Clay
Material Source: Imported from Burrow Area

Accredited for compliance with ISO/IEC 17025 - Testing




Approved Signatory: Nathaniel O'Haire
 Branch Manager

NATA Accredited Laboratory Number: 1169

California Bearing Ratio (AS 1289 6.1.1 & 2.1.1)		Min	Max
CBR taken at	5 mm		
CBR %	10		
Method of Compactive Effort	Standard		
Method used to Determine MDD	AS 1289 5.1.1 & 2.1.1		
Method used to Determine Plasticity	VISUAL		
Maximum Dry Density (t/m ³)	1.86		
Optimum Moisture Content (%)	14.0		
Laboratory Density Ratio (%)	100.5		
Laboratory Moisture Ratio (%)	100.0		
Dry Density after Soaking (t/m ³)	1.87		
Field Moisture Content (%)	7.4		
Moisture Content at Placement (%)	13.9		
Moisture Content Top 30mm (%)	14.8		
Moisture Content Rest of Sample (%)	13.6		
Mass Surcharge (kg)	4.5		
Soaking Period (days)	4		
Curing Hours	120		
Swell (%)	0.0		
Oversize Material (mm)	19		
Oversize Material Included	Excluded		
Oversize Material (%)	0		

California Bearing Ratio

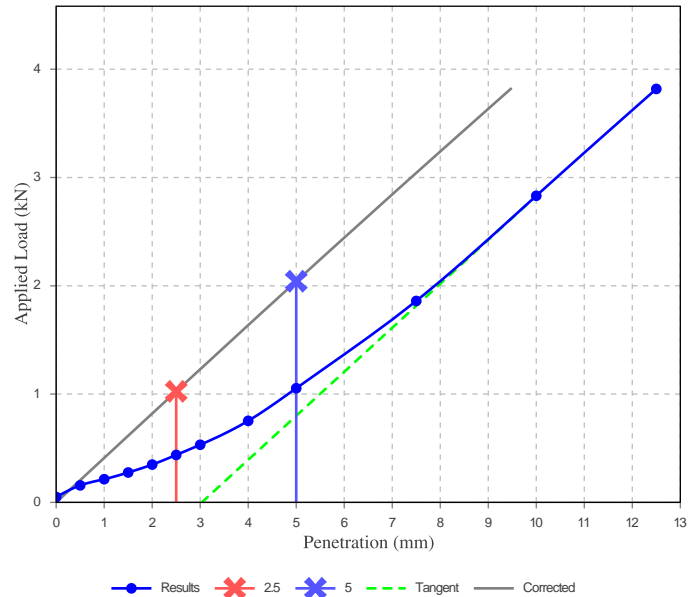

Material Test Report



Brisbane | Gold Coast | Maroochydore

Morrison Geotechnic Pty Ltd

ABN: 51 009 878 899

Brisbane Laboratory

Unit 1, 35 Limestone Darra QLD 4076

Phone: (07) 3279 0900

Email: nathaniel@mgeo.com.au

Report Number: DL20/027-24J
Issue Number: 1
Date Issued: 07/04/2020
Client: SHADFORTH'S CIVIL PTY LTD
 99 SANDALWOOD LANE, FOREST GLEN QLD 4556
Project Number: DL20/027
Project Name: EARTHWORKS SUPERVISION
Project Location: EDEN'S CROSSING, STAGE 21
Work Request: 7236
Sample Number: D20-7236C
Date Sampled: 17/03/2020
Dates Tested: 17/03/2020 - 27/03/2020
Sampling Method: AS 1289.1.2.1 6.4 (b) - Sampling from layers in earthworks or pavement - compacted
Sample Location: Lot 1096, 6m From North Boundary, 4m from East Boundary (FL)
Lot No: Capping Material
Material: Clayey Sand / Sandy Clay
Material Source: Imported from Burrow Area


Accredited for compliance with ISO/IEC 17025 - Testing



Approved Signatory: Nathaniel O'Haire
 Branch Manager

NATA Accredited Laboratory Number: 1169

California Bearing Ratio (AS 1289 6.1.1 & 2.1.1)		Min	Max
CBR taken at	5 mm		
CBR %	17		
Method of Compactive Effort	Standard		
Method used to Determine MDD	AS 1289 5.1.1 & 2.1.1		
Method used to Determine Plasticity	VISUAL		
Maximum Dry Density (t/m ³)	1.85		
Optimum Moisture Content (%)	13.0		
Laboratory Density Ratio (%)	100.5		
Laboratory Moisture Ratio (%)	100.0		
Dry Density after Soaking (t/m ³)	1.86		
Field Moisture Content (%)	7.1		
Moisture Content at Placement (%)	12.8		
Moisture Content Top 30mm (%)	13.8		
Moisture Content Rest of Sample (%)	13.8		
Mass Surcharge (kg)	4.5		
Soaking Period (days)	4		
Curing Hours	48		
Swell (%)	0.0		
Oversize Material (mm)	19		
Oversize Material Included	Excluded		
Oversize Material (%)	0		

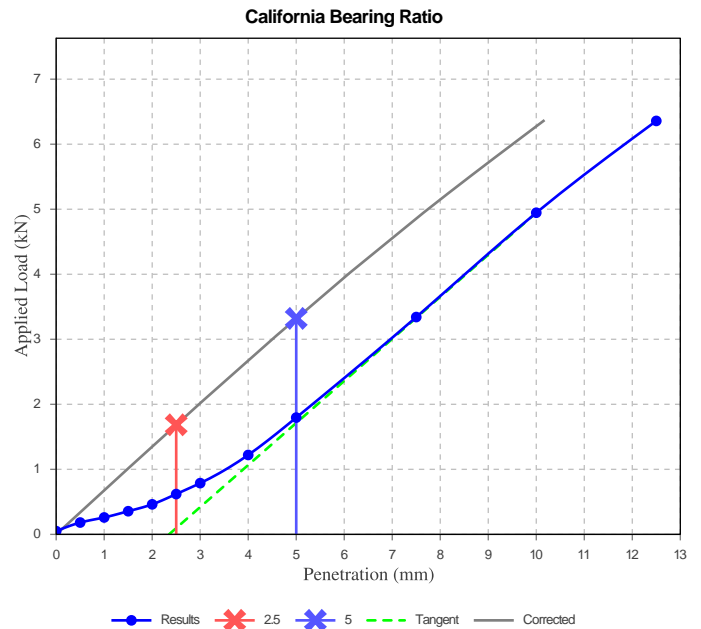

Material Test Report



Brisbane | Gold Coast | Maroochydore

Morrison Geotechnic Pty Ltd

ABN: 51 009 878 899

Brisbane Laboratory

Unit 1, 35 Limestone Darra QLD 4076

Phone: (07) 3279 0900

Email: nathaniel@mgeo.com.au

Report Number: DL20/027-24L
Issue Number: 1
Date Issued: 07/04/2020
Client: SHADFORTH'S CIVIL PTY LTD
 99 SANDALWOOD LANE, FOREST GLEN QLD 4556
Project Number: DL20/027
Project Name: EARTHWORKS SUPERVISION
Project Location: EDEN'S CROSSING, STAGE 21
Work Request: 7236
Sample Number: D20-7236E
Date Sampled: 17/03/2020
Dates Tested: 17/03/2020 - 27/03/2020
Sampling Method: AS 1289.1.2.1 6.4 (b) - Sampling from layers in earthworks or pavement - compacted
Sample Location: Lot 1049, 4m from South Boundary, 8m from West Boundary (FL)
Lot No: Capping Material
Material: Clayey Sand / Sandy Clay
Material Source: Imported from Burrow Area

Accredited for compliance with ISO/IEC 17025 - Testing




Approved Signatory: Nathaniel O'Haire
 Branch Manager

NATA Accredited Laboratory Number: 1169

California Bearing Ratio (AS 1289 6.1.1 & 2.1.1)		Min	Max
CBR taken at	5 mm		
CBR %	11		
Method of Compactive Effort	Standard		
Method used to Determine MDD	AS 1289 5.1.1 & 2.1.1		
Method used to Determine Plasticity	VISUAL		
Maximum Dry Density (t/m ³)	1.86		
Optimum Moisture Content (%)	12.0		
Laboratory Density Ratio (%)	101.0		
Laboratory Moisture Ratio (%)	100.0		
Dry Density after Soaking (t/m ³)	1.87		
Field Moisture Content (%)	5.4		
Moisture Content at Placement (%)	11.8		
Moisture Content Top 30mm (%)	12.8		
Moisture Content Rest of Sample (%)	14.2		
Mass Surcharge (kg)	4.5		
Soaking Period (days)	4		
Curing Hours	48		
Swell (%)	0.5		
Oversize Material (mm)	19		
Oversize Material Included	Excluded		
Oversize Material (%)	0		

California Bearing Ratio

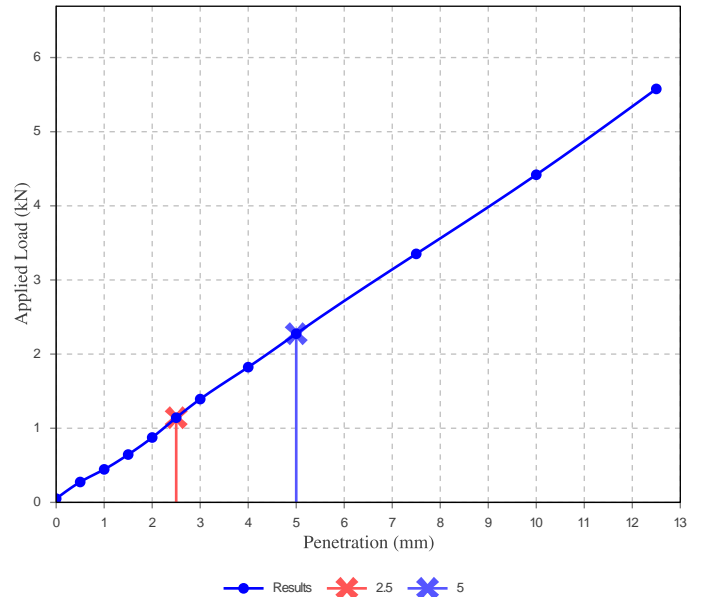

Material Test Report

Report Number: DL20/027-25
Issue Number: 1
Date Issued: 30/03/2020
Client: SHADFORTH'S CIVIL PTY LTD
 99 SANDALWOOD LANE, FOREST GLEN QLD 4556
Project Number: DL20/027
Project Name: EARTHWORKS SUPERVISION
Project Location: EDEN'S CROSSING, STAGE 21
Work Request: 7357
Date Sampled: 23/03/2020 13:30
Dates Tested: 24/03/2020 - 27/03/2020
Sampling Method: AS 1289.1.2.1 6.4 (b) - Sampling from layers in earthworks or pavement - compacted
Specification: 95% STD
Site Selection: Selected by GTA
Material: Allotment Fill
Material Source: Onsite Cut



Accredited for compliance with ISO/IEC 17025 - Testing

Approved Signatory: Greg Gibson
 Senior Technician
 NATA Accredited Laboratory Number: 1169

Compaction Control AS 1289 5.7.1 & 5.8.1 & 2.1.1					
Sample Number	D20-7357A	D20-7357B	D20-7357C	D20-7357D	D20-7357E
Date Tested	23/03/2020	23/03/2020	23/03/2020	23/03/2020	23/03/2020
Time Tested	13:50	14:00	14:10	14:20	14:30
Test Request #/Location	Lot 1046	Lot 1048	Lot 1050	Lot 1051	Lot 1052
Line / Offset	16m from Rear Boundary	8m from Rear Boundary	11m from Rear Boundary	13m from Rear Boundary	6m from Rear Boundary
Offset	4m from Left Boundary	5m from Left Boundary	6m from Left Boundary	3.5m from Left Boundary	5.5m from Left Boundary
Layer / Reduced Level	F/L	F/L	F/L	F/L	F/L
Soil Description	Gravelly Sandy Clay. Brown	Gravelly Sandy Clay. Brown	Gravelly Sandy Clay. Brown	Gravelly Sandy Clay. Brown	Gravelly Sandy Clay. Brown
Test Depth (mm)	150	150	150	150	150
Sieve used to determine oversize (mm)	19.0	19.0	19.0	19.0	19.0
Percentage of Wet Oversize (%)	0.0	0.0	0.0	0.0	0.0
Field Wet Density (FWD) t/m ³	2.02	2.02	1.94	1.98	1.97
Field Moisture Content %	8.9	6.0	5.1	5.1	6.6
Field Dry Density (FDD) t/m ³	1.86	1.90	1.85	1.89	1.85
Peak Converted Wet Density t/m ³	2.01	1.94	1.93	1.94	1.99
Adjusted Peak Converted Wet Density t/m ³	**	**	**	**	**
Moisture Variation (Wv) %	5.0	4.5	5.5	4.5	5.0
Adjusted Moisture Variation %	**	**	**	**	**
Hilf Density Ratio (%)	101.0	104.0	100.5	102.5	99.0
Compaction Method	Standard	Standard	Standard	Standard	Standard

Moisture Variation Note:

Positive values = test is dry of OMC
 Negative values = test is wet of OMC



MORRISON
GEOTECHNIC

Brisbane | Gold Coast | Maroochydore
Unit 1, 35 Limestone Street (PO Box 3063), Darra Q 4076 P (07) 3279 0900 F (07) 3279 0955

ABN: 51 009 878 899

www.morrisongeo.com.au

Hilf Density Ratio Report

Client :	CCA WINSLOW	Report Number:	DL17/398 - 5
Address :	1587 IPSWICH ROAD, ROCKLEA, QLD, 4106	Report Date :	21/08/2017
Project Name :	EARTHWORKS SUPERVISION	Order Number :	33832
Project Number :	DL17/398	Test Method :	AS1289.5.8.1 & 5.7.1
Location:	EDEN'S CROSSING , FUTURE STAGES 15-20		Page 1 of 1

Sample Number :	233043	233044	233045	233046
Test Number :	12	13	14	15
Sampling Method :	-	-	-	-
Date Sampled :	03/08/2017	03/08/2017	03/08/2017	03/08/2017
Date Tested :	03/08/2017	03/08/2017	03/08/2017	03/08/2017
Material Type :	Bulk Fill	Bulk Fill	Bulk Fill	Bulk Fill
Material Source :	On Site	On Site	On Site	On Site
Lot Number :	-	-	-	-
Sample Location :	E 0484161 N 6939710 2.8m Below Final Level	E 0484157 N 6939661 2.8m Below Final Level	E 0484186 N 6939644 2.5m Below Final Level	E 0484202 N 6939671 2.2m Below Final Level
Test Depth (mm) :	150	150	150	150
Layer Depth (mm) :	-	-	-	-
Maximum Size (mm) :	19	19	19	19
Oversize Wet (%) :	-	-	-	-
Oversize Dry (%) :	-	-	-	-
Oversize Density (t/m ³) :	-	-	-	-
Field Moisture Content (%) :	21.1	18.8	29.4	26.9
Hilf MDR Number :	233043	233044	233045	233046
Hilf MDR Method :	AS1289.5.1.1 & 5.7.1	AS1289.5.1.1 & 5.7.1	AS1289.5.1.1 & 5.7.1	AS1289.5.1.1 & 5.7.1
Compactive Effort :	Standard	Standard	Standard	Standard
Field Density Method :	AS1289.5.8.1 & 5.7.1	AS1289.5.8.1 & 5.7.1	AS1289.5.8.1 & 5.7.1	AS1289.5.8.1 & 5.7.1
Moisture Method :	AS1289.2.1.1	AS1289.2.1.1	AS1289.2.1.1	AS1289.2.1.1
Moisture Ratio (%) :	90	89.5	96	96
Field Wet Density (t/m ³) :	1.978	1.926	1.877	1.846
Optimum Moisture Content (%) :	23.5	21.0	30.6	28.0
Moisture Variation :	2.4	2.3	1.1	1.1
Peak Converted Wet Density (t/m ³) :	1.882	1.878	1.852	1.859
Hilf Density Ratio (%) :	105.0	102.5	101.5	99.5
Minimum Specification :	95	95	95	95
Moisture Specification :	-	-	-	-
Site Selection :	-	-	-	-
Soil Description :	-	-	-	-
Remarks :	-			



Accredited for compliance with ISO/IEC 17025.

APPROVED SIGNATORY

Liam A Mcdowall

Liam Mcdowall (Brisbane) - Branch Manager
NATA Accreditation Number
1162 / 1169

Document Code RF89-11



Hilf Density Ratio Report

Client :	CCA WINSLOW	Report Number:	DL17/398 - 1
Address :	1587 IPSWICH ROAD, ROCKLEA, QLD, 4106	Report Date :	11/08/2017
Project Name :	EARTHWORKS SUPERVISION	Order Number :	33832
Project Number :	DL17/398	Test Method :	AS1289.5.8.1 & 5.7.1
Location:	EDEN'S CROSSING , FUTURE STAGES 15-20		Page 1 of 1

Sample Number :	233032	233033	233034	
Test Number :	1	2	3	
Sampling Method :	-	-	-	
Date Sampled :	29/07/2017	29/07/2017	29/07/2017	
Date Tested :	29/07/2017	29/07/2017	29/07/2017	
Material Type :	Bulk Fill	Bulk Fill	Bulk Fill	
Material Source :	On Site	On Site	On Site	
Lot Number :	-	-	-	
Sample Location :	E 484150.739 N 6939689.218 RL 83.095	E 484146.015 N 6939703.855 RL 82.504	E 484133.045 N 6939682.634 RL 82.509	
Test Depth (mm) :	150	150	150	
Layer Depth (mm) :	-	-	-	
Maximum Size (mm) :	19	19	19	
Oversize Wet (%) :	-	-	-	
Oversize Dry (%) :	-	-	-	
Oversize Density (t/m ³) :	-	-	-	
Field Moisture Content (%) :	28.2	32.3	31.6	
Hilf MDR Number :	233032	233033	233034	
Hilf MDR Method :	AS1289.5.1.1 & 5.7.1	AS1289.5.1.1 & 5.7.1	AS1289.5.1.1 & 5.7.1	
Compactive Effort :	Standard	Standard	Standard	
Field Density Method :	AS1289.5.8.1 & 5.7.1	AS1289.5.8.1 & 5.7.1	AS1289.5.8.1 & 5.7.1	
Moisture Method :	AS1289.2.1.1	AS1289.2.1.1	AS1289.2.1.1	
Moisture Ratio (%) :	92.5	101.5	109.5	
Field Wet Density (t/m ³) :	1.941	1.970	1.867	
Optimum Moisture Content (%) :	30.5	31.8	28.8	
Moisture Variation :	2.1	-0.5	-2.8	
Peak Converted Wet Density (t/m ³) :	1.876	1.916	1.830	
Hilf Density Ratio (%) :	103.5	103.0	102.0	
Minimum Specification :	95	95	95	
Moisture Specification :	-	-	-	
Site Selection :	-	-	-	
Soil Description :	-	-	-	
Remarks :	-			



Accredited for compliance with ISO/IEC 17025.

APPROVED SIGNATORY

Sam Woodley (Brisbane) - Laboratory Manager
NATA Accreditation Number
1162 / 1169



MORRISON
GEOTECHNIC

Brisbane | Gold Coast | Maroochydore
Unit 1, 35 Limestone Street (PO Box 3063), Darra Q 4076 P (07) 3279 0900 F (07) 3279 0955
ABN: 51 009 878 899
www.morrisonge.com.au

Hilf Density Ratio Report

Client :	CCA WINSLOW	Report Number:	DL17/398 - 2
Address :	1587 IPSWICH ROAD, ROCKLEA, QLD, 4106	Report Date :	11/08/2017
Project Name :	EARTHWORKS SUPERVISION	Order Number :	33832
Project Number :	DL17/398	Test Method :	AS1289.5.8.1 & 5.7.1
Location:	EDEN'S CROSSING , FUTURE STAGES 15-20		Page 1 of 1

Sample Number :	233035	233036	233037	
Test Number :	4	5	6	
Sampling Method :	-	-	-	
Date Sampled :	31/07/2017	31/07/2017	31/07/2017	
Date Tested :	31/07/2017	31/07/2017	31/07/2017	
Material Type :	Bulk Fill	Bulk Fill	Bulk Fill	
Material Source :	On Site	On Site	On Site	
Lot Number :	-	-	-	
Sample Location :	E 0484125.272 N 6939664.591 RL 83.820	E 0484137.377 N 6939679.380 RL 83.667	E 0484150.878 N 6939695.861 RL 83.746	
Test Depth (mm) :	150	150	150	
Layer Depth (mm) :	-	-	-	
Maximum Size (mm) :	19	19	19	
Oversize Wet (%) :	-	-	-	
Oversize Dry (%) :	-	-	-	
Oversize Density (t/m ³) :	-	-	-	
Field Moisture Content (%) :	21.8	26.9	25.3	
Hilf MDR Number :	233035	233036	233037	
Hilf MDR Method :	AS1289.5.1.1 & 5.7.1	AS1289.5.1.1 & 5.7.1	AS1289.5.1.1 & 5.7.1	
Compactive Effort :	Standard	Standard	Standard	
Field Density Method :	AS1289.5.8.1 & 5.7.1	AS1289.5.8.1 & 5.7.1	AS1289.5.8.1 & 5.7.1	
Moisture Method :	AS1289.2.1.1	AS1289.2.1.1	AS1289.2.1.1	
Moisture Ratio (%) :	90	89.5	88	
Field Wet Density (t/m ³) :	1.972	1.744	1.877	
Optimum Moisture Content (%) :	24.2	30.0	28.8	
Moisture Variation :	2.3	3.0	3.3	
Peak Converted Wet Density (t/m ³) :	1.910	1.821	1.841	
Hilf Density Ratio (%) :	103.0	96.0	102.0	
Minimum Specification :	95	95	95	
Moisture Specification :	-	-	-	
Site Selection :	-	-	-	
Soil Description :	-	-	-	
Remarks :	-			



Accredited for compliance with ISO/IEC 17025.

APPROVED SIGNATORY

Sam Woodley (Brisbane) - Laboratory Manager
NATA Accreditation Number
1162 / 1169

Document Code RF89-11



Hilf Density Ratio Report

Client :	CCA WINSLOW	Report Number:	DL17/398 - 27
Address :	1587 IPSWICH ROAD, ROCKLEA, QLD, 4106	Report Date :	16/01/2018
Project Name :	EARTHWORKS SUPERVISION	Order Number :	33832
Project Number :	DL17/398	Test Method :	AS1289.5.8.1 & 5.7.1
Location:	EDEN'S CROSSING , FUTURE STAGES 15-20	Page 1 of 1	

Sample Number :	240081		
Test Number :	79		
Sampling Method :	-		
Date Sampled :	10/01/2018		
Date Tested :	10/01/2018		
Material Type :	Bulk Fill		
Material Source :	On Site		
Lot Number :	-		
Sample Location :	E 484059.9 N 6939725.9 RL 79.149		
Test Depth (mm) :	150		
Layer Depth (mm) :	-		
Maximum Size (mm) :	19		
Oversize Wet (%) :	-		
Oversize Dry (%) :	-		
Oversize Density (t/m ³) :	-		
Field Moisture Content (%) :	18.6		
Hilf MDR Number :	240081		
Hilf MDR Method :	AS1289.5.1.1 & 5.7.1		
Compactive Effort :	Standard		
Field Density Method :	AS1289.5.8.1 & 5.7.1		
Moisture Method :	AS1289.2.1.1		
Moisture Ratio (%) :	101		
Field Wet Density (t/m ³) :	2.044		
Optimum Moisture Content (%) :	18.4		
Moisture Variation :	-0.2		
Peak Converted Wet Density (t/m ³) :	2.052		
Hilf Density Ratio (%) :	99.5		
Minimum Specification :	95		
Moisture Specification :	+ or - 2%		
Site Selection :	-		
Soil Description :	-		
Remarks :	-		



Accredited for compliance with ISO/IEC 17025.

APPROVED SIGNATORY

Liam A McOwail

Liam Mcdowall (Brisbane) - Branch Manager
NATA Accreditation Number
1162 / 1169



MORRISON
GEOTECHNIC

Brisbane | Gold Coast | Maroochydore
Unit 1, 35 Limestone Street (PO Box 3063), Darra Q 4076 P (07) 3279 0900 F (07) 3279 0955

ABN: 51 009 878 899

www.morrisonge.com.au

Hilf Density Ratio Report

Client :	CCA WINSLOW	Report Number:	DL17/398 - 10
Address :	1587 IPSWICH ROAD, ROCKLEA, QLD, 4106	Report Date :	22/08/2017
Project Name :	EARTHWORKS SUPERVISION	Order Number :	33832
Project Number :	DL17/398	Test Method :	AS1289.5.8.1 & 5.7.1
Location:	EDEN'S CROSSING , FUTURE STAGES 15-20		Page 1 of 1

Sample Number :	233058	233059	233060	233061
Test Number :	27	28	29	30
Sampling Method :	-	-	-	-
Date Sampled :	05/08/2017	05/08/2017	05/08/2017	05/08/2017
Date Tested :	05/08/2017	05/08/2017	05/08/2017	05/08/2017
Material Type :	Bulk Fill (Capping Layer)	Bulk Fill (Capping Layer)	Bulk Fill (Capping Layer)	Bulk Fill (Capping Layer)
Material Source :	On Site (Crushed Basalt)	On Site (Crushed Basalt)	On Site (Crushed Basalt)	On Site (Crushed Basalt)
Lot Number :	-	-	-	-
Sample Location :	E 484200.100 N 6939566.948 RL 90.519 Final Level	E 484184.890 N 6939568.577 RL 89.978 Final Level	E 484170.777 N 6939576.884 RL 89.223 Final Level	E 484139.952 N 6939598.619 RL 88.207 Final Level
Test Depth (mm) :	150	150	150	150
Layer Depth (mm) :	-	-	-	-
Maximum Size (mm) :	19	19	19	19
Oversize Wet (%) :	-	-	-	-
Oversize Dry (%) :	-	-	-	-
Oversize Density (t/m ³) :	-	-	-	-
Field Moisture Content (%) :	10.7	12.4	9.7	11.8
Hilf MDR Number :	233058	233059	233060	233061
Hilf MDR Method :	AS1289.5.1.1 & 5.7.1	AS1289.5.1.1 & 5.7.1	AS1289.5.1.1 & 5.7.1	AS1289.5.1.1 & 5.7.1
Compactive Effort :	Standard	Standard	Standard	Standard
Field Density Method :	AS1289.5.8.1 & 5.7.1	AS1289.5.8.1 & 5.7.1	AS1289.5.8.1 & 5.7.1	AS1289.5.8.1 & 5.7.1
Moisture Method :	AS1289.2.1.1	AS1289.2.1.1	AS1289.2.1.1	AS1289.2.1.1
Moisture Ratio (%) :	72	83.5	70.5	83
Field Wet Density (t/m ³) :	2.258	2.287	2.224	2.285
Optimum Moisture Content (%) :	14.8	14.8	13.7	14.2
Moisture Variation :	4.0	2.4	3.9	2.3
Peak Converted Wet Density (t/m ³) :	2.183	2.219	2.204	2.245
Hilf Density Ratio (%) :	103.5	103.0	101.0	102.0
Minimum Specification :	95	95	95	95
Moisture Specification :	-	-	-	-
Site Selection :	-	-	-	-
Soil Description :	-	-	-	-
Remarks :	-			



Accredited for compliance with ISO/IEC 17025.

APPROVED SIGNATORY

Liam A Mcdowall

Liam Mcdowall (Brisbane) - Branch Manager
NATA Accreditation Number
1162 / 1169

Document Code RF89-11



MORRISON
GEOTECHNIC

Brisbane | Gold Coast | Maroochydore
Unit 1, 35 Limestone Street (PO Box 3063), Darra Q 4076 P (07) 3279 0900 F (07) 3279 0955

ABN: 51 009 878 899

www.morrisonge.com.au

Hilf Density Ratio Report

Client :	CCA WINSLOW	Report Number:	DL17/398 - 14
Address :	1587 IPSWICH ROAD, ROCKLEA, QLD, 4106	Report Date :	23/08/2017
Project Name :	EARTHWORKS SUPERVISION	Order Number :	33832
Project Number :	DL17/398	Test Method :	AS1289.5.8.1 & 5.7.1
Location:	EDEN'S CROSSING , FUTURE STAGES 15-20		Page 1 of 1

Sample Number :	233104	233105	233106	233107
Test Number :	38	39	40	41
Sampling Method :	-	-	-	-
Date Sampled :	08/08/2017	08/08/2017	08/08/2017	08/08/2017
Date Tested :	08/08/2017	08/08/2017	08/08/2017	08/08/2017
Material Type :	Bulk Fill (Capping Layer)	Bulk Fill (Capping Layer)	Bulk Fill (Capping Layer)	Bulk Fill (Capping Layer)
Material Source :	On Site (Crushed Basalt)	On Site (Crushed Basalt)	On Site (Crushed Basalt)	On Site (Crushed Basalt)
Lot Number :	-	-	-	-
Sample Location :	E 484217.874 N 6939676.530 RL 89.091 Final Level	E 484229.355 N 6939653.382 RL 89.899 Final Level	E 484229.223 N 6939599.195 RL 90.930	E 484242.357 N 6939611.667 RL 91.157
Test Depth (mm) :	150	150	150	150
Layer Depth (mm) :	-	-	-	-
Maximum Size (mm) :	19	19	19	19
Oversize Wet (%) :	-	-	-	-
Oversize Dry (%) :	-	-	-	-
Oversize Density (t/m ³) :	-	-	-	-
Field Moisture Content (%) :	14.1	10.1	10.5	14.6
Hilf MDR Number :	233104	233105	233106	233107
Hilf MDR Method :	AS1289.5.1.1 & 5.7.1	AS1289.5.1.1 & 5.7.1	AS1289.5.1.1 & 5.7.1	AS1289.5.1.1 & 5.7.1
Compactive Effort :	Standard	Standard	Standard	Standard
Field Density Method :	AS1289.5.8.1 & 5.7.1	AS1289.5.8.1 & 5.7.1	AS1289.5.8.1 & 5.7.1	AS1289.5.8.1 & 5.7.1
Moisture Method :	AS1289.2.1.1	AS1289.2.1.1	AS1289.2.1.1	AS1289.2.1.1
Moisture Ratio (%) :	82.5	82.5	95.5	86.5
Field Wet Density (t/m ³) :	2.100	2.091	2.081	2.088
Optimum Moisture Content (%) :	17.1	12.2	11.0	16.9
Moisture Variation :	2.9	2.1	0.4	2.3
Peak Converted Wet Density (t/m ³) :	2.101	2.116	2.170	2.027
Hilf Density Ratio (%) :	100.0	99.0	96.0	103.0
Minimum Specification :	95	95	95	95
Moisture Specification :	-	-	-	-
Site Selection :	-	-	-	-
Soil Description :	-	-	-	-
Remarks :	-			



Accredited for compliance with ISO/IEC 17025.

APPROVED SIGNATORY

Liam A Mcdowall

Liam Mcdowall (Brisbane) - Branch Manager
NATA Accreditation Number
1162 / 1169

Document Code RF89-11



MORRISON
GEOTECHNIC

Brisbane | Gold Coast | Maroochydore
Unit 1, 35 Limestone Street (PO Box 3063), Darra Q 4076 P (07) 3279 0900 F (07) 3279 0955

ABN: 51 009 878 899

www.morrisonge.com.au

Hilf Density Ratio Report

Client :	CCA WINSLOW	Report Number:	DL17/398 - 3
Address :	1587 IPSWICH ROAD, ROCKLEA, QLD, 4106	Report Date :	21/08/2017
Project Name :	EARTHWORKS SUPERVISION	Order Number :	33832
Project Number :	DL17/398	Test Method :	AS1289.5.8.1 & 5.7.1
Location:	EDEN'S CROSSING , FUTURE STAGES 15-20		Page 1 of 1

Sample Number :	233038	233039	233040	233041
Test Number :	7	8	9	10
Sampling Method :	-	-	-	-
Date Sampled :	01/08/2017	01/08/2017	01/08/2017	01/08/2017
Date Tested :	01/08/2017	01/08/2017	01/08/2017	01/08/2017
Material Type :	Bulk Fill	Bulk Fill	Bulk Fill	Bulk Fill
Material Source :	On Site	On Site	On Site	On Site
Lot Number :	-	-	-	-
Sample Location :	E 484120.1 N 6939651.7 RL 84.6	E 484128.1 N 6939672.5 RL 84.2	E 484118.7 N 6939718.3 RL 80.6	E 484110.1 N 6939692.3 RL 81.6
Test Depth (mm) :	150	150	150	150
Layer Depth (mm) :	-	-	-	-
Maximum Size (mm) :	19	19	19	19
Oversize Wet (%) :	-	-	-	-
Oversize Dry (%) :	-	-	-	-
Oversize Density (t/m ³) :	-	-	-	-
Field Moisture Content (%) :	28.3	31.8	26.2	21.7
Hilf MDR Number :	233038	233039	233040	233041
Hilf MDR Method :	AS1289.5.1.1 & 5.7.1	AS1289.5.1.1 & 5.7.1	AS1289.5.1.1 & 5.7.1	AS1289.5.1.1 & 5.7.1
Compactive Effort :	Standard	Standard	Standard	Standard
Field Density Method :	AS1289.5.8.1 & 5.7.1	AS1289.5.8.1 & 5.7.1	AS1289.5.8.1 & 5.7.1	AS1289.5.8.1 & 5.7.1
Moisture Method :	AS1289.2.1.1	AS1289.2.1.1	AS1289.2.1.1	AS1289.2.1.1
Moisture Ratio (%) :	88.5	93	99	82.5
Field Wet Density (t/m ³) :	1.911	1.859	1.816	1.852
Optimum Moisture Content (%) :	32.1	34.1	26.5	26.3
Moisture Variation :	3.4	2.2	0.2	4.5
Peak Converted Wet Density (t/m ³) :	1.837	1.793	1.847	1.799
Hilf Density Ratio (%) :	104.0	103.5	98.5	103.0
Minimum Specification :	95	95	95	95
Moisture Specification :	-	-	-	-
Site Selection :	-	-	-	-
Soil Description :	-	-	-	-
Remarks :	-			



Accredited for compliance with ISO/IEC 17025.

APPROVED SIGNATORY

Liam A Mcdowall

Liam Mcdowall (Brisbane) - Branch Manager
NATA Accreditation Number
1162 / 1169

Document Code RF89-11




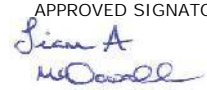
MORRISON
GEOTECHNIC

Brisbane | Gold Coast | Maroochydore
Unit 1, 35 Limestone Street (PO Box 3063), Darra Q 4076 P (07) 3279 0900 F (07) 3279 0955
ABN: 51 009 878 899
www.morrisonge.com.au

Hilf Density Ratio Report

Client :	CCA WINSLOW	Report Number:	DL17/398 - 4
Address :	1587 IPSWICH ROAD, ROCKLEA, QLD, 4106	Report Date :	21/08/2017
Project Name :	EARTHWORKS SUPERVISION	Order Number :	33832
Project Number :	DL17/398	Test Method :	AS1289.5.8.1 & 5.7.1
Location:	EDEN'S CROSSING , FUTURE STAGES 15-20	Page 1 of 1	

Sample Number :	233042		
Test Number :	11		
Sampling Method :	-		
Date Sampled :	01/08/2017		
Date Tested :	01/08/2017		
Material Type :	Bulk Fill		
Material Source :	On Site		
Lot Number :	-		
Sample Location :	E 484099.0 N 6939665.3 RL 82.9		
Test Depth (mm) :	150		
Layer Depth (mm) :	-		
Maximum Size (mm) :	19		
Oversize Wet (%) :	-		
Oversize Dry (%) :	-		
Oversize Density (t/m ³) :	-		
Field Moisture Content (%) :	21.9		
Hilf MDR Number :	233042		
Hilf MDR Method :	AS1289.5.1.1 & 5.7.1		
Compactive Effort :	Standard		
Field Density Method :	AS1289.5.8.1 & 5.7.1		
Moisture Method :	AS1289.2.1.1		
Moisture Ratio (%) :	84		
Field Wet Density (t/m ³) :	1.907		
Optimum Moisture Content (%) :	26.0		
Moisture Variation :	4.0		
Peak Converted Wet Density (t/m ³) :	1.837		
Hilf Density Ratio (%) :	104.0		
Minimum Specification :	95		
Moisture Specification :	-		
Site Selection :	-		
Soil Description :	-		
Remarks :	-		

 <p align="center">Accredited for compliance with ISO/IEC 17025.</p>	<p>APPROVED SIGNATORY</p>  <p>Liam McDowall (Brisbane) - Branch Manager NATA Accreditation Number 1162 / 1169</p>
	<p>Document Code RF89-11</p>



Hilf Density Ratio Report

Client :	CCA WINSLOW	Report Number:	DL17/398 - 52
Address :	1587 IPSWICH ROAD, ROCKLEA, QLD, 4106	Report Date :	02/03/2018
Project Name :	EARTHWORKS SUPERVISION	Order Number :	37618
Project Number :	DL17/398	Test Method :	AS1289.5.8.1 & 5.7.1
Location:	EDEN'S CROSSING , FUTURE STAGES 15-20	Page 1 of 1	

Sample Number :	241859	241860	241861	241862
Test Number :	150	151	152	153
Sampling Method :	-	-	-	-
Date Sampled :	14/02/2018	14/02/2018	14/02/2018	14/02/2018
Date Tested :	14/02/2018	14/02/2018	14/02/2018	14/02/2018
Material Type :	Bulk Fill	Bulk Fill	Bulk Fill	Bulk Fill
Material Source :	On Site	On Site	On Site	On Site
Lot Number :	-	-	-	-
Sample Location :	E 484101.259 N 6939799.218 RL 78.017	E 484108.745 N 6939825.950 RL 78.541	E 484122.140 N 6939815.212 RL 79.486	E 484115.117 N 6939786.400 RL 78.922
Test Depth (mm) :	150	150	150	150
Layer Depth (mm) :	-	-	-	-
Maximum Size (mm) :	19	19	19	19
Oversize Wet (%) :	-	-	-	-
Oversize Dry (%) :	-	-	-	-
Oversize Density (t/m ³) :	-	-	-	-
Field Moisture Content (%) :	21.6	25.4	19.9	17.8
Hilf MDR Number :	241859	241860	241861	241862
Hilf MDR Method :	AS1289.5.1.1 & 5.7.1	AS1289.5.1.1 & 5.7.1	AS1289.5.1.1 & 5.7.1	AS1289.5.1.1 & 5.7.1
Compactive Effort :	Standard	Standard	Standard	Standard
Field Density Method :	AS1289.5.8.1 & 5.7.1	AS1289.5.8.1 & 5.7.1	AS1289.5.8.1 & 5.7.1	AS1289.5.8.1 & 5.7.1
Moisture Method :	AS1289.2.1.1	AS1289.2.1.1	AS1289.2.1.1	AS1289.2.1.1
Moisture Ratio (%) :	99.5	101	97.5	89.5
Field Wet Density (t/m ³) :	2.078	2.017	2.072	1.970
Optimum Moisture Content (%) :	21.7	25.2	20.4	19.9
Moisture Variation :	0.1	-0.2	0.5	2.0
Peak Converted Wet Density (t/m ³) :	2.062	2.040	2.041	2.062
Hilf Density Ratio (%) :	101.0	99.0	101.5	95.5
Minimum Specification :	95	95	95	95
Moisture Specification :	+ or - 2%	+ or - 2%	+ or - 2%	+ or - 2%
Site Selection :	-	-	-	-
Soil Description :	-	-	-	-
Remarks :	-			



Accredited for compliance with ISO/IEC 17025 - Testing.

APPROVED SIGNATORY

Liam A Mcdowall

Liam Mcdowall (Brisbane) - Branch Manager
NATA Accreditation Number
1162 / 1169


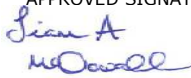


Hilf Density Ratio Report

Client :	CCA WINSLOW	Report Number:	DL17/398 - 46
Address :	1587 IPSWICH ROAD, ROCKLEA, QLD, 4106	Report Date :	19/02/2018
Project Name :	EARTHWORKS SUPERVISION	Order Number :	37618
Project Number :	DL17/398	Test Method :	AS1289.5.8.1 & 5.7.1
Location:	EDEN'S CROSSING , FUTURE STAGES 15-20	Page 1 of 1	

Sample Number :	241616	241617	241618	241619
Test Number :	131	132	133	134
Sampling Method :	-	-	-	-
Date Sampled :	08/02/2018	08/02/2018	08/02/2018	08/02/2018
Date Tested :	08/02/2018	08/02/2018	08/02/2018	08/02/2018
Material Type :	Bulk Fill	Bulk Fill	Bulk Fill	Bulk Fill
Material Source :	On Site	On Site	On Site	On Site
Lot Number :	-	-	-	-
Sample Location :	E 484066.945 N 6939720.523 RL 82.310	E 484087.957 N 6939730.400 RL 82.334	E 484098.366 N 6939704.852 RL 83.635	E 484115.227 N 6939735.093 RL 82.600
Test Depth (mm) :	150	150	150	150
Layer Depth (mm) :	-	-	-	-
Maximum Size (mm) :	19	19	19	19
Oversize Wet (%) :	-	-	19	-
Oversize Dry (%) :	-	-	-	-
Oversize Density (t/m ³) :	-	-	2.481	-
Field Moisture Content (%) :	23.0	16.6	21.0	17.9
Hilf MDR Number :	241616	241617	241618	241619
Hilf MDR Method :	AS1289.5.1.1 & 5.7.1	AS1289.5.1.1 & 5.7.1	AS1289.5.1.1 & 5.7.1	AS1289.5.1.1 & 5.7.1
Compactive Effort :	Standard	Standard	Standard	Standard
Field Density Method :	AS1289.5.8.1 & 5.7.1	AS1289.5.8.1 & 5.7.1	AS1289.5.8.1 & 5.7.1	AS1289.5.8.1 & 5.7.1
Moisture Method :	AS1289.2.1.1	AS1289.2.1.1	AS1289.2.1.1	AS1289.2.1.1
Moisture Ratio (%) :	91.5	100.5	99	90
Field Wet Density (t/m ³) :	1.927	1.957	2.154	1.971
Optimum Moisture Content (%) :	25.1	16.5	21.2	19.9
Moisture Variation :	1.9	-0.1	0.2	1.9
Peak Converted Wet Density (t/m ³) :	1.986	2.060	2.085*	1.996
Hilf Density Ratio (%) :	97.0	95.0	103.5	99.0
Minimum Specification :	95	95	95	95
Moisture Specification :	+ or - 2%	+ or - 2%	+ or - 2%	+ or - 2%
Site Selection :	-	-	-	-
Soil Description :	-	-	-	-
Remarks :	-			

* - denotes adjusted for oversize

 <p>Accredited for compliance with ISO/IEC 17025.</p>	<p>APPROVED SIGNATORY</p>  <p>Liam Mcdowall (Brisbane) - Branch Manager NATA Accreditation Number 1162 / 1169</p>
--	--



MORRISON
GEOTECHNIC

Brisbane | Gold Coast | Maroochydore
Unit 1, 35 Limestone Street (PO Box 3063), Darra Q 4076 P (07) 3279 0900 F (07) 3279 0955
ABN: 51 009 878 899
www.morrisonge.com.au

Hilf Density Ratio Report

Client :	CCA WINSLOW	Report Number:	DL17/398 - 6
Address :	1587 IPSWICH ROAD, ROCKLEA, QLD, 4106	Report Date :	21/08/2017
Project Name :	EARTHWORKS SUPERVISION	Order Number :	33832
Project Number :	DL17/398	Test Method :	AS1289.5.8.1 & 5.7.1
Location:	EDEN'S CROSSING , FUTURE STAGES 15-20	Page 1 of 1	

Sample Number :	233047	233048	
Test Number :	16	17	
Sampling Method :	-	-	
Date Sampled :	03/08/2017	03/08/2017	
Date Tested :	03/08/2017	03/08/2017	
Material Type :	Bulk Fill	Bulk Fill	
Material Source :	On Site	On Site	
Lot Number :	-	-	
Sample Location :	E 0484226 N 6939625 1m Below Final Level	E 0484217 N 6939640 2m Below Final Level	
Test Depth (mm) :	150	150	
Layer Depth (mm) :	-	-	
Maximum Size (mm) :	19	19	
Oversize Wet (%) :	-	-	
Oversize Dry (%) :	-	-	
Oversize Density (t/m ³) :	-	-	
Field Moisture Content (%) :	14.7	26.4	
Hilf MDR Number :	233047	233048	
Hilf MDR Method :	AS1289.5.1.1 & 5.7.1	AS1289.5.1.1 & 5.7.1	
Compactive Effort :	Standard	Standard	
Field Density Method :	AS1289.5.8.1 & 5.7.1	AS1289.5.8.1 & 5.7.1	
Moisture Method :	AS1289.2.1.1	AS1289.2.1.1	
Moisture Ratio (%) :	82.5	97.5	
Field Wet Density (t/m ³) :	2.035	1.790	
Optimum Moisture Content (%) :	17.8	27.1	
Moisture Variation :	3.0	0.7	
Peak Converted Wet Density (t/m ³) :	1.982	1.872	
Hilf Density Ratio (%) :	102.5	95.5	
Minimum Specification :	95	95	
Moisture Specification :	-	-	
Site Selection :	-	-	
Soil Description :	-	-	
Remarks :	-		



Accredited for compliance with ISO/IEC 17025.

APPROVED SIGNATORY

Liam A Mcdowall

Liam Mcdowall (Brisbane) - Branch Manager
 NATA Accreditation Number
 1162 / 1169

Document Code RF89-11



MORRISON
GEOTECHNIC

Brisbane | Gold Coast | Maroochydore
Unit 1, 35 Limestone Street (PO Box 3063), Darra Q 4076 P (07) 3279 0900 F (07) 3279 0955
ABN: 51 009 878 899
www.morrisonge.com.au

Hilf Density Ratio Report

Client :	CCA WINSLOW	Report Number:	DL17/398 - 50
Address :	1587 IPSWICH ROAD, ROCKLEA, QLD, 4106	Report Date :	22/02/2018
Project Name :	EARTHWORKS SUPERVISION	Order Number :	37618
Project Number :	DL17/398	Test Method :	AS1289.5.8.1 & 5.7.1
Location:	EDEN'S CROSSING , FUTURE STAGES 15-20	Page 1 of 1	

Sample Number :	241762	241763	241764	241765
Test Number :	144	145	146	147
Sampling Method :	-	-	-	-
Date Sampled :	13/02/2018	13/02/2018	13/02/2018	13/02/2018
Date Tested :	13/02/2018	13/02/2018	13/02/2018	13/02/2018
Material Type :	Bulk Fill	Bulk Fill	Bulk Fill	Bulk Fill
Material Source :	On Site	On Site	On Site	On Site
Lot Number :	-	-	-	-
Sample Location :	E 484054.579 N 6939741.264 RL 80.310	E 484048.493 N 6939719.242 RL 81.509	E 484039.981 N 6939695.341 RL 82.262	E 484051.214 N 6939706.448 RL 82.560
Test Depth (mm) :	150	150	150	150
Layer Depth (mm) :	-	-	-	-
Maximum Size (mm) :	19	19	19	19
Oversize Wet (%) :	-	-	-	-
Oversize Dry (%) :	-	-	-	-
Oversize Density (t/m ³) :	-	-	-	-
Field Moisture Content (%) :	27.7	16.6	25.9	23.5
Hilf MDR Number :	241762	241763	241764	241765
Hilf MDR Method :	AS1289.5.1.1 & 5.7.1	AS1289.5.1.1 & 5.7.1	AS1289.5.1.1 & 5.7.1	AS1289.5.1.1 & 5.7.1
Compactive Effort :	Standard	Standard	Standard	Standard
Field Density Method :	AS1289.5.8.1 & 5.7.1	AS1289.5.8.1 & 5.7.1	AS1289.5.8.1 & 5.7.1	AS1289.5.8.1 & 5.7.1
Moisture Method :	AS1289.2.1.1	AS1289.2.1.1	AS1289.2.1.1	AS1289.2.1.1
Moisture Ratio (%) :	100.5	98.5	92.5	92
Field Wet Density (t/m ³) :	1.910	2.007	1.858	2.006
Optimum Moisture Content (%) :	27.6	16.8	28.0	25.5
Moisture Variation :	-0.1	0.2	2.0	1.8
Peak Converted Wet Density (t/m ³) :	1.966	1.996	1.955	2.001
Hilf Density Ratio (%) :	97.0	100.5	95.0	100.0
Minimum Specification :	95	95	95	95
Moisture Specification :	+ or - 2%	+ or - 2%	+ or - 2%	+ or - 2%
Site Selection :	-	-	-	-
Soil Description :	-	-	-	-
Remarks :	-			



Accredited for compliance with ISO/IEC 17025.

APPROVED SIGNATORY

Liam A Mcdowall

Liam Mcdowall (Brisbane) - Branch Manager
NATA Accreditation Number
1162 / 1169

Document Code RF89-11



Hilf Density Ratio Report

Client :	CCA WINSLOW	Report Number:	DL17/398 - 29
Address :	1587 IPSWICH ROAD, ROCKLEA, QLD, 4106	Report Date :	25/01/2018
Project Name :	EARTHWORKS SUPERVISION	Order Number :	33832
Project Number :	DL17/398	Test Method :	AS1289.5.8.1 & 5.7.1
Location:	EDEN'S CROSSING , FUTURE STAGES 15-20	Page 1 of 1	

Sample Number :	240297	240298	
Test Number :	84	85	
Sampling Method :	-	-	
Date Sampled :	15/01/2018	15/01/2018	
Date Tested :	15/01/2018	15/01/2018	
Material Type :	Bulk Fill	Bulk Fill	
Material Source :	On Site	On Site	
Lot Number :	-	-	
Sample Location :	E 484051.137 N 6939698.140 RL 80.290	E 484061.062 N 6939732.618 RL 79.269	
Test Depth (mm) :	150	150	
Layer Depth (mm) :	-	-	
Maximum Size (mm) :	19	19	
Oversize Wet (%) :	-	-	
Oversize Dry (%) :	-	-	
Oversize Density (t/m ³) :	-	-	
Field Moisture Content (%) :	25.8	25.0	
Hilf MDR Number :	240297	240298	
Hilf MDR Method :	AS1289.5.1.1 & 5.7.1	AS1289.5.1.1 & 5.7.1	
Compactive Effort :	Standard	Standard	
Field Density Method :	AS1289.5.8.1 & 5.7.1	AS1289.5.8.1 & 5.7.1	
Moisture Method :	AS1289.2.1.1	AS1289.2.1.1	
Moisture Ratio (%) :	92.5	92	
Field Wet Density (t/m ³) :	1.832	1.791	
Optimum Moisture Content (%) :	28.0	27.2	
Moisture Variation :	2.0	2.0	
Peak Converted Wet Density (t/m ³) :	1.908	1.890	
Hilf Density Ratio (%) :	96.0	95.0	
Minimum Specification :	95	95	
Moisture Specification :	-	-	
Site Selection :	-	-	
Soil Description :	-	-	
Remarks :	-		



Accredited for compliance with ISO/IEC 17025.

APPROVED SIGNATORY

Sam Woodley (Brisbane) - Laboratory Manager
NATA Accreditation Number
1162 / 1169



Hilf Density Ratio Report

Client :	CCA WINSLOW	Report Number:	DL17/398 - 35
Address :	1587 IPSWICH ROAD, ROCKLEA, QLD, 4106	Report Date :	02/02/2018
Project Name :	EARTHWORKS SUPERVISION	Order Number :	36008
Project Number :	DL17/398	Test Method :	AS1289.5.8.1 & 5.7.1
Location:	EDEN'S CROSSING , FUTURE STAGES 15-20	Page 1 of 1	

Sample Number :	240685	240686	240687	
Test Number :	100	101	102	
Sampling Method :	-	-	-	
Date Sampled :	19/01/2018	19/01/2018	19/01/2018	
Date Tested :	19/01/2018	19/01/2018	19/01/2018	
Material Type :	Bulk Fill	Bulk Fill	Bulk Fill	
Material Source :	On Site	On Site	On Site	
Lot Number :	-	-	-	
Sample Location :	E 484069.500 N 6939673.56 RL 82.572	E 484083.455 N 6939678.366 RL 82.626	E 484079.861 N 6939702.624 RL 81.464	
Test Depth (mm) :	150	150	150	
Layer Depth (mm) :	-	-	-	
Maximum Size (mm) :	19	19	19	
Oversize Wet (%) :	-	-	-	
Oversize Dry (%) :	-	-	-	
Oversize Density (t/m ³) :	-	-	-	
Field Moisture Content (%) :	15.0	12.9	13.5	
Hilf MDR Number :	240685	240686	240687	
Hilf MDR Method :	AS1289.5.1.1 & 5.7.1	AS1289.5.1.1 & 5.7.1	AS1289.5.1.1 & 5.7.1	
Compactive Effort :	Standard	Standard	Standard	
Field Density Method :	AS1289.5.8.1 & 5.7.1	AS1289.5.8.1 & 5.7.1	AS1289.5.8.1 & 5.7.1	
Moisture Method :	AS1289.2.1.1	AS1289.2.1.1	AS1289.2.1.1	
Moisture Ratio (%) :	102	87	87.5	
Field Wet Density (t/m ³) :	2.004	1.881	1.905	
Optimum Moisture Content (%) :	14.7	14.8	15.4	
Moisture Variation :	-0.3	2.0	1.9	
Peak Converted Wet Density (t/m ³) :	2.061	1.976	1.990	
Hilf Density Ratio (%) :	97.0	95.0	95.5	
Minimum Specification :	95	95	95	
Moisture Specification :	+ or - 2%	+ or - 2%	+ or - 2%	
Site Selection :	-	-	-	
Soil Description :	-	-	-	
Remarks :	-			



Accredited for compliance with ISO/IEC 17025.

APPROVED SIGNATORY

Liam A Mcdowall

Liam Mcdowall (Brisbane) - Branch Manager
NATA Accreditation Number
1162 / 1169



MORRISON
GEOTECHNIC

Brisbane | Gold Coast | Maroochydore
Unit 1, 35 Limestone Street (PO Box 3063), Darra Q 4076 P (07) 3279 0900 F (07) 3279 0955
ABN: 51 009 878 899
www.morrisonge.com.au

Hilf Density Ratio Report

Client :	CCA WINSLOW	Report Number:	DL17/398 - 26
Address :	1587 IPSWICH ROAD, ROCKLEA, QLD, 4106	Report Date :	16/01/2018
Project Name :	EARTHWORKS SUPERVISION	Order Number :	33832
Project Number :	DL17/398	Test Method :	AS1289.5.8.1 & 5.7.1
Location:	EDEN'S CROSSING , FUTURE STAGES 15-20	Page 1 of 1	

Sample Number :	240037	240038	240039	
Test Number :	76	77	78	
Sampling Method :	-	-	-	
Date Sampled :	09/01/2018	09/01/2018	09/01/2018	
Date Tested :	09/01/2018	09/01/2018	09/01/2018	
Material Type :	Bulk Fill	Bulk Fill	Bulk Fill	
Material Source :	On Site	On Site	On Site	
Lot Number :	-	-	-	
Sample Location :	E 484082.245 N 6939717.122 RL 80.995	E 484069.505 N 6939720.319 RL 80.577	E 484061.505 N 6939699.860 RL 81.134	
Test Depth (mm) :	150	150	150	
Layer Depth (mm) :	-	-	-	
Maximum Size (mm) :	19	19	19	
Oversize Wet (%) :	-	-	-	
Oversize Dry (%) :	-	-	-	
Oversize Density (t/m ³) :	-	-	-	
Field Moisture Content (%) :	22.1	22.9	22.5	
Hilf MDR Number :	240037	240038	240039	
Hilf MDR Method :	AS1289.5.1.1 & 5.7.1	AS1289.5.1.1 & 5.7.1	AS1289.5.1.1 & 5.7.1	
Compactive Effort :	Standard	Standard	Standard	
Field Density Method :	AS1289.5.8.1 & 5.7.1	AS1289.5.8.1 & 5.7.1	AS1289.5.8.1 & 5.7.1	
Moisture Method :	AS1289.2.1.1	AS1289.2.1.1	AS1289.2.1.1	
Moisture Ratio (%) :	99.5	100.5	99	
Field Wet Density (t/m ³) :	2.052	2.009	2.048	
Optimum Moisture Content (%) :	22.2	22.8	22.7	
Moisture Variation :	0.1	-0.1	0.1	
Peak Converted Wet Density (t/m ³) :	2.035	2.027	2.019	
Hilf Density Ratio (%) :	101.0	99.0	101.5	
Minimum Specification :	95	95	95	
Moisture Specification :	+ or - 2%	+ or - 2%	+ or - 2%	
Site Selection :	-	-	-	
Soil Description :	-	-	-	
Remarks :	-			



Accredited for compliance with ISO/IEC 17025.

APPROVED SIGNATORY

Liam A Mcdowall

Liam Mcdowall (Brisbane) - Branch Manager
NATA Accreditation Number
1162 / 1169

Document Code RF89-11



MORRISON
GEOTECHNIC

Brisbane | Gold Coast | Maroochydore
Unit 1, 35 Limestone Street (PO Box 3063), Darra Q 4076 P (07) 3279 0900 F (07) 3279 0955
ABN: 51 009 878 899
www.morrisonge.com.au

Hilf Density Ratio Report

Client :	CCA WINSLOW	Report Number:	DL17/398 - 7
Address :	1587 IPSWICH ROAD, ROCKLEA, QLD, 4106	Report Date :	21/08/2017
Project Name :	EARTHWORKS SUPERVISION	Order Number :	33832
Project Number :	DL17/398	Test Method :	AS1289.5.8.1 & 5.7.1
Location:	EDEN'S CROSSING , FUTURE STAGES 15-20	Page 1 of 1	

Sample Number :	233049	233050	233051	
Test Number :	18	19	20	
Sampling Method :	-	-	-	
Date Sampled :	03/08/2017	03/08/2017	03/08/2017	
Date Tested :	03/08/2017	03/08/2017	03/08/2017	
Material Type :	Bulk Fill (Capping Layer)	Bulk Fill (Capping Layer)	Bulk Fill (Capping Layer)	
Material Source :	On Site (Crushed Basalt)	On Site (Crushed Basalt)	On Site (Crushed Basalt)	
Lot Number :	-	-	-	
Sample Location :	E 484235.053 N 6939695.713 RL 89.057	E 484249.482 N 6939680.030 RL 89.667	E 484254.583 N 6939658.408 RL 89.975	
Test Depth (mm) :	150	150	150	
Layer Depth (mm) :	-	-	-	
Maximum Size (mm) :	19	19	19	
Oversize Wet (%) :	-	-	-	
Oversize Dry (%) :	-	-	-	
Oversize Density (t/m ³) :	-	-	-	
Field Moisture Content (%) :	9.7	9.3	12.1	
Hilf MDR Number :	233049	233050	233051	
Hilf MDR Method :	AS1289.5.1.1 & 5.7.1	AS1289.5.1.1 & 5.7.1	AS1289.5.1.1 & 5.7.1	
Compactive Effort :	Standard	Standard	Standard	
Field Density Method :	AS1289.5.8.1 & 5.7.1	AS1289.5.8.1 & 5.7.1	AS1289.5.8.1 & 5.7.1	
Moisture Method :	AS1289.2.1.1	AS1289.2.1.1	AS1289.2.1.1	
Moisture Ratio (%) :	70.5	66.5	75	
Field Wet Density (t/m ³) :	2.133	2.187	2.105	
Optimum Moisture Content (%) :	13.7	14.0	16.1	
Moisture Variation :	4.0	4.6	3.9	
Peak Converted Wet Density (t/m ³) :	2.128	2.126	2.156	
Hilf Density Ratio (%) :	100.0	103.0	97.5	
Minimum Specification :	95	95	95	
Moisture Specification :	-	-	-	
Site Selection :	-	-	-	
Soil Description :	-	-	-	
Remarks :	-			



Accredited for compliance with ISO/IEC 17025.

APPROVED SIGNATORY

Liam A Mcdowall

Liam Mcdowall (Brisbane) - Branch Manager
NATA Accreditation Number
1162 / 1169

Document Code RF89-11



MORRISON
GEOTECHNIC

Brisbane | Gold Coast | Maroochydore
Unit 1, 35 Limestone Street (PO Box 3063), Darra Q 4076 P (07) 3279 0900 F (07) 3279 0955

ABN: 51 009 878 899

www.morrisonge.com.au

Hilf Density Ratio Report

Client :	CCA WINSLOW	Report Number:	DL17/398 - 8
Address :	1587 IPSWICH ROAD, ROCKLEA, QLD, 4106	Report Date :	21/08/2017
Project Name :	EARTHWORKS SUPERVISION	Order Number :	33832
Project Number :	DL17/398	Test Method :	AS1289.5.8.1 & 5.7.1
Location:	EDEN'S CROSSING , FUTURE STAGES 15-20		Page 1 of 1

Sample Number :	233052	233053	
Test Number :	21	22	
Sampling Method :	-	-	
Date Sampled :	03/08/2017	03/08/2017	
Date Tested :	03/08/2017	03/08/2017	
Material Type :	Bulk Fill (Capping Layer)	Bulk Fill (Capping Layer)	
Material Source :	On Site (Crushed Basalt)	On Site (Crushed Basalt)	
Lot Number :	-	-	
Sample Location :	E 484236.737 N 6939698.674 RL 89.623	E 484247.899 N 6939678.013 RL 90.092	
Test Depth (mm) :	150	150	
Layer Depth (mm) :	-	-	
Maximum Size (mm) :	19	19	
Oversize Wet (%) :	-	-	
Oversize Dry (%) :	-	-	
Oversize Density (t/m ³) :	-	-	
Field Moisture Content (%) :	11.0	11.5	
Hilf MDR Number :	233052	233053	
Hilf MDR Method :	AS1289.5.1.1 & 5.7.1	AS1289.5.1.1 & 5.7.1	
Compactive Effort :	Standard	Standard	
Field Density Method :	AS1289.5.8.1 & 5.7.1	AS1289.5.8.1 & 5.7.1	
Moisture Method :	AS1289.2.1.1	AS1289.2.1.1	
Moisture Ratio (%) :	81.5	73.5	
Field Wet Density (t/m ³) :	2.184	2.199	
Optimum Moisture Content (%) :	13.5	15.7	
Moisture Variation :	2.4	4.0	
Peak Converted Wet Density (t/m ³) :	2.197	2.134	
Hilf Density Ratio (%) :	99.5	103.0	
Minimum Specification :	95	95	
Moisture Specification :	-	-	
Site Selection :	-	-	
Soil Description :	-	-	
Remarks :	-		



Accredited for compliance with ISO/IEC 17025.

APPROVED SIGNATORY

Liam A Mcdowall

Liam Mcdowall (Brisbane) - Branch Manager
NATA Accreditation Number
1162 / 1169

Document Code RF89-11



Hilf Density Ratio Report

Client :	CCA WINSLOW	Report Number:	DL17/398 - 49
Address :	1587 IPSWICH ROAD, ROCKLEA, QLD, 4106	Report Date :	22/02/2018
Project Name :	EARTHWORKS SUPERVISION	Order Number :	37618
Project Number :	DL17/398	Test Method :	AS1289.5.8.1 & 5.7.1
Location:	EDEN'S CROSSING , FUTURE STAGES 15-20	Page 1 of 1	

Sample Number :	241657	241658	241659	241660
Test Number :	140	141	142	143
Sampling Method :	-	-	-	-
Date Sampled :	09/02/2018	09/02/2018	09/02/2018	09/02/2018
Date Tested :	09/02/2018	09/02/2018	09/02/2018	09/02/2018
Material Type :	Bulk Fill	Bulk Fill	Bulk Fill	Bulk Fill
Material Source :	On Site	On Site	On Site	On Site
Lot Number :	-	-	-	-
Sample Location :	E 484056.366 N 6939747.986 RL 78.487	E 484047.671 N 6939733.068 RL 79.005	E 484037.192 N 6939708.800 RL 80.348	E 484032.942 N 6939675.653 RL 81.750
Test Depth (mm) :	150	150	150	150
Layer Depth (mm) :	-	-	-	-
Maximum Size (mm) :	19	19	19	19
Oversize Wet (%) :	-	-	-	-
Oversize Dry (%) :	-	-	-	-
Oversize Density (t/m ³) :	-	-	-	-
Field Moisture Content (%) :	24.1	24.7	31.5	34.6
Hilf MDR Number :	241657	241658	241659	241660
Hilf MDR Method :	AS1289.5.1.1 & 5.7.1	AS1289.5.1.1 & 5.7.1	AS1289.5.1.1 & 5.7.1	AS1289.5.1.1 & 5.7.1
Compactive Effort :	Standard	Standard	Standard	Standard
Field Density Method :	AS1289.5.8.1 & 5.7.1	AS1289.5.8.1 & 5.7.1	AS1289.5.8.1 & 5.7.1	AS1289.5.8.1 & 5.7.1
Moisture Method :	AS1289.2.1.1	AS1289.2.1.1	AS1289.2.1.1	AS1289.2.1.1
Moisture Ratio (%) :	91	92.5	93.5	94
Field Wet Density (t/m ³) :	1.948	1.940	1.857	1.781
Optimum Moisture Content (%) :	26.5	26.7	33.6	36.8
Moisture Variation :	2.2	1.9	2.0	2.0
Peak Converted Wet Density (t/m ³) :	1.966	1.910	1.829	1.795
Hilf Density Ratio (%) :	99.0	101.5	101.5	99.0
Minimum Specification :	95	95	95	95
Moisture Specification :	-	-	-	-
Site Selection :	-	-	-	-
Soil Description :	Silty CLAY	Silty CLAY	Silty CLAY	Silty CLAY
Remarks :	-			



Accredited for compliance with ISO/IEC 17025.

APPROVED SIGNATORY

Liam A Mcdowall

Liam Mcdowall (Brisbane) - Branch Manager
NATA Accreditation Number
1162 / 1169



MORRISON
GEOTECHNIC

Brisbane | Gold Coast | Maroochydore
Unit 1, 35 Limestone Street (PO Box 3063), Darra Q 4076 P (07) 3279 0900 F (07) 3279 0955

ABN: 51 009 878 899

www.morrisonge.com.au

Hilf Density Ratio Report

Client :	CCA WINSLOW	Report Number:	DL17/398 - 18
Address :	1587 IPSWICH ROAD, ROCKLEA, QLD, 4106	Report Date :	29/08/2017
Project Name :	EARTHWORKS SUPERVISION	Order Number :	33832
Project Number :	DL17/398	Test Method :	AS1289.5.8.1 & 5.7.1
Location:	EDEN'S CROSSING , FUTURE STAGES 15-20		Page 1 of 1

Sample Number :	233335	233336	233337	233338
Test Number :	50	51	52	53
Sampling Method :	-	-	-	-
Date Sampled :	10/08/2017	10/08/2017	10/08/2017	10/08/2017
Date Tested :	10/08/2017	10/08/2017	10/08/2017	10/08/2017
Material Type :	Bulk Fill	Bulk Fill	Bulk Fill	Bulk Fill
Material Source :	On Site	On Site	On Site	On Site
Lot Number :	-	-	-	-
Sample Location :	E 484178.603 N 6939625.738 RL 87.133	E 484178.900 N 6939608.528 RL 87.026	E 484207.623 N 6939568.469 RL 89.128	E 484181.847 N 6939584.018 RL 88.386
Test Depth (mm) :	150	150	150	150
Layer Depth (mm) :	-	-	-	-
Maximum Size (mm) :	19	19	19	19
Oversize Wet (%) :	-	-	-	-
Oversize Dry (%) :	-	-	-	-
Oversize Density (t/m ³) :	-	-	-	-
Field Moisture Content (%) :	21.1	23.5	14.0	21.3
Hilf MDR Number :	233335	233336	233337	233338
Hilf MDR Method :	AS1289.5.1.1 & 5.7.1	AS1289.5.1.1 & 5.7.1	AS1289.5.1.1 & 5.7.1	AS1289.5.1.1 & 5.7.1
Compactive Effort :	Standard	Standard	Standard	Standard
Field Density Method :	AS1289.5.8.1 & 5.7.1	AS1289.5.8.1 & 5.7.1	AS1289.5.8.1 & 5.7.1	AS1289.5.8.1 & 5.7.1
Moisture Method :	AS1289.2.1.1	AS1289.2.1.1	AS1289.2.1.1	AS1289.2.1.1
Moisture Ratio (%) :	89	90	82.5	86.5
Field Wet Density (t/m ³) :	1.918	1.964	1.870	1.839
Optimum Moisture Content (%) :	23.7	26.1	17.0	24.6
Moisture Variation :	2.4	2.5	3.0	3.1
Peak Converted Wet Density (t/m ³) :	1.914	1.894	1.953	1.914
Hilf Density Ratio (%) :	100.0	103.5	96.0	96.0
Minimum Specification :	95	95	95	95
Moisture Specification :	-	-	-	-
Site Selection :	-	-	-	-
Soil Description :	-	-	-	-
Remarks :	-			



Accredited for compliance with ISO/IEC 17025.

APPROVED SIGNATORY

Liam A Mcdowall

Liam Mcdowall (Brisbane) - Branch Manager
NATA Accreditation Number
1162 / 1169

Document Code RF89-11



MORRISON
GEOTECHNIC

Brisbane | Gold Coast | Maroochydore
Unit 1, 35 Limestone Street (PO Box 3063), Darra Q 4076 P (07) 3279 0900 F (07) 3279 0955

ABN: 51 009 878 899

www.morrisonge.com.au

Hilf Density Ratio Report

Client :	CCA WINSLOW	Report Number:	DL17/398 - 11
Address :	1587 IPSWICH ROAD, ROCKLEA, QLD, 4106	Report Date :	22/08/2017
Project Name :	EARTHWORKS SUPERVISION	Order Number :	33832
Project Number :	DL17/398	Test Method :	AS1289.5.8.1 & 5.7.1
Location:	EDEN'S CROSSING , FUTURE STAGES 15-20		Page 1 of 1

Sample Number :	233062	233063	233064
Test Number :	31	32	33
Sampling Method :	-	-	-
Date Sampled :	07/08/2017	07/08/2017	07/08/2017
Date Tested :	07/08/2017	07/08/2017	07/08/2017
Material Type :	Bulk Fill	Bulk Fill	Bulk Fill
Material Source :	On Site	On Site	On Site
Lot Number :	-	-	-
Sample Location :	E 484210.721 N 6939695.084 RL 87.534	E 484219.112 N 6939674.609 RL 88.374	E 484231.614 N 6939654.434 RL 89.088
Test Depth (mm) :	150	150	150
Layer Depth (mm) :	-	-	-
Maximum Size (mm) :	19	19	19
Oversize Wet (%) :	-	-	-
Oversize Dry (%) :	-	-	-
Oversize Density (t/m ³) :	-	-	-
Field Moisture Content (%) :	25.5	23.2	29.8
Hilf MDR Number :	233062	233063	233064
Hilf MDR Method :	AS1289.5.1.1 & 5.7.1	AS1289.5.1.1 & 5.7.1	AS1289.5.1.1 & 5.7.1
Compactive Effort :	Standard	Standard	Standard
Field Density Method :	AS1289.5.8.1 & 5.7.1	AS1289.5.8.1 & 5.7.1	AS1289.5.8.1 & 5.7.1
Moisture Method :	AS1289.2.1.1	AS1289.2.1.1	AS1289.2.1.1
Moisture Ratio (%) :	94	99	98
Field Wet Density (t/m ³) :	2.104	2.127	1.934
Optimum Moisture Content (%) :	27.2	23.5	30.3
Moisture Variation :	1.5	0.2	0.5
Peak Converted Wet Density (t/m ³) :	2.022	2.107	1.889
Hilf Density Ratio (%) :	104.0	101.0	102.5
Minimum Specification :	95	95	95
Moisture Specification :	+ or - 2%	+ or - 2%	+ or - 2%
Site Selection :	-	-	-
Soil Description :	-	-	-
Remarks :	-	-	-



Accredited for compliance with ISO/IEC 17025.

APPROVED SIGNATORY

Liam A Mcdowall

Liam Mcdowall (Brisbane) - Branch Manager
NATA Accreditation Number
1162 / 1169

Document Code RF89-11



MORRISON
GEOTECHNIC

Brisbane | Gold Coast | Maroochydore
Unit 1, 35 Limestone Street (PO Box 3063), Darra Q 4076 P (07) 3279 0900 F (07) 3279 0955

ABN: 51 009 878 899

www.morrisonge.com.au

Hilf Density Ratio Report

Client :	CCA WINSLOW	Report Number:	DL17/398 - 12
Address :	1587 IPSWICH ROAD, ROCKLEA, QLD, 4106	Report Date :	22/08/2017
Project Name :	EARTHWORKS SUPERVISION	Order Number :	33832
Project Number :	DL17/398	Test Method :	AS1289.5.8.1 & 5.7.1
Location:	EDEN'S CROSSING , FUTURE STAGES 15-20		Page 1 of 1

Sample Number :	233065	233066	
Test Number :	34	35	
Sampling Method :	-	-	
Date Sampled :	07/08/2017	07/08/2017	
Date Tested :	07/08/2017	07/08/2017	
Material Type :	Bulk Fill	Bulk Fill	
Material Source :	On Site	On Site	
Lot Number :	-	-	
Sample Location :	E 484208.8 N 6939698.3 RL 87.0	E 484218.8 N 6939674.4 RL 88.1	
Test Depth (mm) :	150	150	
Layer Depth (mm) :	-	-	
Maximum Size (mm) :	19	19	
Oversize Wet (%) :	-	-	
Oversize Dry (%) :	-	-	
Oversize Density (t/m ³) :	-	-	
Field Moisture Content (%) :	25.0	26.9	
Hilf MDR Number :	233065	233066	
Hilf MDR Method :	AS1289.5.1.1 & 5.7.1	AS1289.5.1.1 & 5.7.1	
Compactive Effort :	Standard	Standard	
Field Density Method :	AS1289.5.8.1 & 5.7.1	AS1289.5.8.1 & 5.7.1	
Moisture Method :	AS1289.2.1.1	AS1289.2.1.1	
Moisture Ratio (%) :	99	99	
Field Wet Density (t/m ³) :	1.923	1.912	
Optimum Moisture Content (%) :	25.3	27.2	
Moisture Variation :	0.2	0.2	
Peak Converted Wet Density (t/m ³) :	1.902	1.911	
Hilf Density Ratio (%) :	101.0	100.0	
Minimum Specification :	95	95	
Moisture Specification :	+ or - 2%	+ or - 2%	
Site Selection :	-	-	
Soil Description :	-	-	
Remarks :	-		



Accredited for compliance with ISO/IEC 17025.

APPROVED SIGNATORY

Liam A Mcdowall

Liam Mcdowall (Brisbane) - Branch Manager
NATA Accreditation Number
1162 / 1169

Document Code RF89-11



Hilf Density Ratio Report

Client :	CCA WINSLOW	Report Number:	DL17/398 - 13
Address :	1587 IPSWICH ROAD, ROCKLEA, QLD, 4106	Report Date :	22/08/2017
Project Name :	EARTHWORKS SUPERVISION	Order Number :	33832
Project Number :	DL17/398	Test Method :	AS1289.5.8.1 & 5.7.1
Location:	EDEN'S CROSSING , FUTURE STAGES 15-20		Page 1 of 1

Sample Number :	233067	233068	
Test Number :	36	37	
Sampling Method :	-	-	
Date Sampled :	07/08/2017	07/08/2017	
Date Tested :	07/08/2017	07/08/2017	
Material Type :	Bulk Fill (Capping Layer)	Bulk Fill (Capping Layer)	
Material Source :	On Site (Crushed Basalt)	On Site (Crushed Basalt)	
Lot Number :	-	-	
Sample Location :	E 484246.4 N 6939658.4 RL 90.4	E 484231.8 N 6939687.2 RL 89.8	
Test Depth (mm) :	150	150	
Layer Depth (mm) :	-	-	
Maximum Size (mm) :	19	19	
Oversize Wet (%) :	-	-	
Oversize Dry (%) :	-	-	
Oversize Density (t/m ³) :	-	-	
Field Moisture Content (%) :	10.3	14.9	
Hilf MDR Number :	233067	233068	
Hilf MDR Method :	AS1289.5.1.1 & 5.7.1	AS1289.5.1.1 & 5.7.1	
Compactive Effort :	Standard	Standard	
Field Density Method :	AS1289.5.8.1 & 5.7.1	AS1289.5.8.1 & 5.7.1	
Moisture Method :	AS1289.2.1.1	AS1289.2.1.1	
Moisture Ratio (%) :	78.5	100.5	
Field Wet Density (t/m ³) :	2.241	2.271	
Optimum Moisture Content (%) :	13.1	14.8	
Moisture Variation :	2.8	-0.1	
Peak Converted Wet Density (t/m ³) :	2.168	2.260	
Hilf Density Ratio (%) :	103.5	100.5	
Minimum Specification :	95	95	
Moisture Specification :	-	-	
Site Selection :	-	-	
Soil Description :	-	-	
Remarks :	-		



Accredited for compliance with ISO/IEC 17025.

APPROVED SIGNATORY

Liam A Mcdowall

Liam Mcdowall (Brisbane) - Branch Manager
NATA Accreditation Number
1162 / 1169



MORRISON
GEOTECHNIC

Brisbane | Gold Coast | Maroochydore
Unit 1, 35 Limestone Street (PO Box 3063), Darra Q 4076 P (07) 3279 0900 F (07) 3279 0955
ABN: 51 009 878 899
www.morrisonge.com.au

Hilf Density Ratio Report

Client :	CCA WINSLOW	Report Number:	DL17/398 - 69
Address :	1587 IPSWICH ROAD, ROCKLEA, QLD, 4106	Report Date :	23/03/2018
Project Name :	EARTHWORKS SUPERVISION	Order Number :	37618
Project Number :	DL17/398	Test Method :	AS1289.5.8.1 & 5.7.1
Location:	EDEN'S CROSSING , FUTURE STAGES 15-20	Page 1 of 1	

Sample Number :	242679	242680	242681	242682
Test Number :	211	212	213	214
Sampling Method :	-	-	-	-
Date Sampled :	15/03/2018	15/03/2018	15/03/2018	15/03/2018
Date Tested :	15/03/2018	15/03/2018	15/03/2018	15/03/2018
Material Type :	Bulk Fill	Bulk Fill	Bulk Fill	Bulk Fill
Material Source :	On Site	On Site	On Site	On Site
Lot Number :	-	-	-	-
Sample Location :	E 484162.704 N 6939744.357 RL 84.994	E 484155.883 N 6939760.784 RL 84.384	E 484165.729 N 6939764.377 RL 84.705	E 484160.522 N 6939784.473 RL 83.921
Test Depth (mm) :	150	150	150	150
Layer Depth (mm) :	-	-	-	-
Maximum Size (mm) :	19	19	19	19
Oversize Wet (%) :	-	-	-	-
Oversize Dry (%) :	-	-	-	-
Oversize Density (t/m ³) :	-	-	-	-
Field Moisture Content (%) :	17.1	18.7	17.8	19.6
Hilf MDR Number :	242679	242680	242681	242682
Hilf MDR Method :	AS1289.5.1.1 & 5.7.1	AS1289.5.1.1 & 5.7.1	AS1289.5.1.1 & 5.7.1	AS1289.5.1.1 & 5.7.1
Compactive Effort :	Standard	Standard	Standard	Standard
Field Density Method :	AS1289.5.8.1 & 5.7.1	AS1289.5.8.1 & 5.7.1	AS1289.5.8.1 & 5.7.1	AS1289.5.8.1 & 5.7.1
Moisture Method :	AS1289.2.1.1	AS1289.2.1.1	AS1289.2.1.1	AS1289.2.1.1
Moisture Ratio (%) :	100.5	99.5	98.5	100.5
Field Wet Density (t/m ³) :	1.906	1.949	1.867	2.044
Optimum Moisture Content (%) :	17.0	18.8	18.0	19.5
Moisture Variation :	-0.1	0.1	0.2	-0.1
Peak Converted Wet Density (t/m ³) :	1.995	2.043	1.953	2.098
Hilf Density Ratio (%) :	95.5	95.5	95.5	97.5
Minimum Specification :	95	95	95	95
Moisture Specification :	+ or - 2%	+ or - 2%	+ or - 2%	+ or - 2%
Site Selection :	-	-	-	-
Soil Description :	SILTY CLAY	SILTY CLAY	SILTY CLAY	SILTY CLAY
Remarks :	-			



Accredited for compliance with ISO/IEC 17025 - Testing.

APPROVED SIGNATORY

Liam A Mcdowall

Liam Mcdowall (Brisbane) - Branch Manager
NATA Accreditation Number
1162 / 1169

Document Code RF89-11



MORRISON
GEOTECHNIC


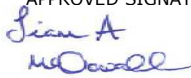
Brisbane | Gold Coast | Maroochydore
Unit 1, 35 Limestone Street (PO Box 3063), Darra Q 4076 P (07) 3279 0900 F (07) 3279 0955
ABN: 51 009 878 899
www.morrisonge.com.au

Hilf Density Ratio Report

Client :	CCA WINSLOW	Report Number:	DL17/398 - 58
Address :	1587 IPSWICH ROAD, ROCKLEA, QLD, 4106	Report Date :	08/03/2018
Project Name :	EARTHWORKS SUPERVISION	Order Number :	37618
Project Number :	DL17/398	Test Method :	AS1289.5.8.1 & 5.7.1
Location:	EDEN'S CROSSING , FUTURE STAGES 15-20	Page 1 of 1	

Sample Number :	242376	242377	242378	242379
Test Number :	172	173	174	175
Sampling Method :	-	-	-	-
Date Sampled :	01/03/2018	01/03/2018	01/03/2018	01/03/2018
Date Tested :	01/03/2018	01/03/2018	01/03/2018	01/03/2018
Material Type :	Bulk Fill	Bulk Fill	Bulk Fill	Bulk Fill
Material Source :	On Site	On Site	On Site	On Site
Lot Number :	-	-	-	-
Sample Location :	E 484164.307 N 6939799.614 RL 83.298	E 484156.322 N 6939790.237 RL 82.731	E 484160.883 N 6939776.470 RL 83.291	E 484152.753 N 6939764.257 RL 83.167
Test Depth (mm) :	150	150	150	150
Layer Depth (mm) :	150	150	150	150
Maximum Size (mm) :	19	19	19	19
Oversize Wet (%) :	-	14	15	-
Oversize Dry (%) :	-	-	-	-
Oversize Density (t/m ³) :	-	2.553	2.569	-
Field Moisture Content (%) :	22.7	18.9	20.1	24.6
Hilf MDR Number :	242376	242377	242378	242379
Hilf MDR Method :	AS1289.5.1.1 & 5.7.1	AS1289.5.1.1 & 5.7.1	AS1289.5.1.1 & 5.7.1	AS1289.5.1.1 & 5.7.1
Compactive Effort :	Standard	Standard	Standard	Standard
Field Density Method :	AS1289.5.8.1 & 5.7.1	AS1289.5.8.1 & 5.7.1	AS1289.5.8.1 & 5.7.1	AS1289.5.8.1 & 5.7.1
Moisture Method :	AS1289.2.1.1	AS1289.2.1.1	AS1289.2.1.1	AS1289.2.1.1
Moisture Ratio (%) :	96.5	93	98	100
Field Wet Density (t/m ³) :	1.946	2.190	2.150	2.052
Optimum Moisture Content (%) :	23.5	20.3	20.5	24.6
Moisture Variation :	0.7	1.3	0.3	0.0
Peak Converted Wet Density (t/m ³) :	1.908	2.156*	2.178*	2.025
Hilf Density Ratio (%) :	102.0	101.5	98.5	101.5
Minimum Specification :	95	95	95	95
Moisture Specification :	+ or - 2%	+ or - 2%	+ or - 2%	+ or - 2%
Site Selection :	-	-	-	-
Soil Description :	Sandy Clay	Sandy Clay	Sandy Clay	Sandy Clay
Remarks :	-			

* - denotes adjusted for oversize

 Accredited for compliance with ISO/IEC 17025 - Testing.	APPROVED SIGNATORY  Liam Mcdowall (Brisbane) - Branch Manager NATA Accreditation Number 1162 / 1169
---	--



MORRISON
GEOTECHNIC

Brisbane | Gold Coast | Maroochydore
Unit 1, 35 Limestone Street (PO Box 3063), Darra Q 4076 P (07) 3279 0900 F (07) 3279 0955

ABN: 51 009 878 899

www.morrisonge.com.au

Hilf Density Ratio Report

Client :	CCA WINSLOW	Report Number:	DL17/398 - 15
Address :	1587 IPSWICH ROAD, ROCKLEA, QLD, 4106	Report Date :	23/08/2017
Project Name :	EARTHWORKS SUPERVISION	Order Number :	33832
Project Number :	DL17/398	Test Method :	AS1289.5.8.1 & 5.7.1
Location:	EDEN'S CROSSING , FUTURE STAGES 15-20		Page 1 of 1

Sample Number :	233108	233109	
Test Number :	42	43	
Sampling Method :	-	-	
Date Sampled :	08/08/2017	08/08/2017	
Date Tested :	08/08/2017	08/08/2017	
Material Type :	Bulk Fill	Bulk Fill	
Material Source :	On Site	On Site	
Lot Number :	-	-	
Sample Location :	E 484204.367 N 6939674.430 RL 87.619	E 484214.100 N 6939652.862 RL 88.511	
Test Depth (mm) :	150	150	
Layer Depth (mm) :	-	-	
Maximum Size (mm) :	19	19	
Oversize Wet (%) :	-	-	
Oversize Dry (%) :	-	-	
Oversize Density (t/m ³) :	-	-	
Field Moisture Content (%) :	22.0	22.8	
Hilf MDR Number :	233108	233109	
Hilf MDR Method :	AS1289.5.1.1 & 5.7.1	AS1289.5.1.1 & 5.7.1	
Compactive Effort :	Standard	Standard	
Field Density Method :	AS1289.5.8.1 & 5.7.1	AS1289.5.8.1 & 5.7.1	
Moisture Method :	AS1289.2.1.1	AS1289.2.1.1	
Moisture Ratio (%) :	98.5	91.5	
Field Wet Density (t/m ³) :	1.901	1.998	
Optimum Moisture Content (%) :	22.4	24.9	
Moisture Variation :	0.4	2.0	
Peak Converted Wet Density (t/m ³) :	1.921	1.975	
Hilf Density Ratio (%) :	99.0	101.0	
Minimum Specification :	95	95	
Moisture Specification :	+ or - 2%	+ or - 2%	
Site Selection :	-	-	
Soil Description :	-	-	
Remarks :	-		



Accredited for compliance with ISO/IEC 17025.

APPROVED SIGNATORY

Liam A Mcdowall

Liam Mcdowall (Brisbane) - Branch Manager
NATA Accreditation Number
1162 / 1169

Document Code RF89-11



MORRISON
GEOTECHNIC

Brisbane | Gold Coast | Maroochydore
Unit 1, 35 Limestone Street (PO Box 3063), Darra Q 4076 P (07) 3279 0900 F (07) 3279 0955
ABN: 51 009 878 899
www.morrisonge.com.au

Hilf Density Ratio Report

Client :	CCA WINSLOW	Report Number:	DL17/398 - 25
Address :	1587 IPSWICH ROAD, ROCKLEA, QLD, 4106	Report Date :	16/01/2018
Project Name :	EARTHWORKS SUPERVISION	Order Number :	33832
Project Number :	DL17/398	Test Method :	AS1289.5.8.1 & 5.7.1
Location:	EDEN'S CROSSING , FUTURE STAGES 15-20	Page 1 of 1	

Sample Number :	240033	240034	240035	240036
Test Number :	72	73	74	75
Sampling Method :	-	-	-	-
Date Sampled :	09/01/2018	09/01/2018	09/01/2018	09/01/2018
Date Tested :	09/01/2018	09/01/2018	09/01/2018	09/01/2018
Material Type :	Bulk Fill	Bulk Fill	Bulk Fill	Bulk Fill
Material Source :	On Site	On Site	On Site	On Site
Lot Number :	-	-	-	-
Sample Location :	E 484065.479 N 6939754.619 RL 79.210	E 484059.109 N 6939735.950 RL 79.780	E 484076.784 N 6939678.617 RL 82.605	E 484080.209 N 6939694.628 RL 81.798
Test Depth (mm) :	150	150	150	150
Layer Depth (mm) :	-	-	-	-
Maximum Size (mm) :	19	19	19	19
Oversize Wet (%) :	10	10	-	-
Oversize Dry (%) :	-	-	-	-
Oversize Density (t/m ³) :	2.473	2.483	-	-
Field Moisture Content (%) :	16.8	12.5	24.9	27.1
Hilf MDR Number :	240033	240034	240035	240036
Hilf MDR Method :	AS1289.5.1.1 & 5.7.1	AS1289.5.1.1 & 5.7.1	AS1289.5.1.1 & 5.7.1	AS1289.5.1.1 & 5.7.1
Compactive Effort :	Standard	Standard	Standard	Standard
Field Density Method :	AS1289.5.8.1 & 5.7.1	AS1289.5.8.1 & 5.7.1	AS1289.5.8.1 & 5.7.1	AS1289.5.8.1 & 5.7.1
Moisture Method :	AS1289.2.1.1	AS1289.2.1.1	AS1289.2.1.1	AS1289.2.1.1
Moisture Ratio (%) :	99	101	101	101
Field Wet Density (t/m ³) :	2.160	2.237	2.060	1.855
Optimum Moisture Content (%) :	17.0	12.4	24.7	26.8
Moisture Variation :	0.2	-0.1	-0.2	-0.2
Peak Converted Wet Density (t/m ³) :	2.127*	2.14*	2.054	1.936
Hilf Density Ratio (%) :	101.5	104.5	100.5	96.0
Minimum Specification :	95	95	95	95
Moisture Specification :	+ or - 2%	+ or - 2%	+ or - 2%	+ or - 2%
Site Selection :	-	-	-	-
Soil Description :	-	-	-	-
Remarks :	-			

* - denotes adjusted for oversize



Accredited for compliance with ISO/IEC 17025.

APPROVED SIGNATORY

Liam A Mcdowall

Liam Mcdowall (Brisbane) - Branch Manager
NATA Accreditation Number
1162 / 1169

Document Code RF89-11


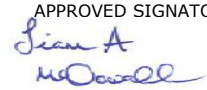


Hilf Density Ratio Report

Client :	CCA WINSLOW	Report Number:	DL17/398 - 57
Address :	1587 IPSWICH ROAD, ROCKLEA, QLD, 4106	Report Date :	02/03/2018
Project Name :	EARTHWORKS SUPERVISION	Order Number :	37618
Project Number :	DL17/398	Test Method :	AS1289.5.8.1 & 5.7.1
Location:	EDEN'S CROSSING , FUTURE STAGES 15-20	Page 1 of 1	

Sample Number :	242205	242206	242207	242208
Test Number :	168	169	170	171
Sampling Method :	-	-	-	-
Date Sampled :	21/02/2018	21/02/2018	21/02/2018	21/02/2018
Date Tested :	21/02/2018	21/02/2018	21/02/2018	21/02/2018
Material Type :	Bulk Fill	Bulk Fill	Bulk Fill	Bulk Fill
Material Source :	On Site	On Site	On Site	On Site
Lot Number :	-	-	-	-
Sample Location :	E 484107.769 N 6939809.077 RL 80.154	E 484099.934 N 6939779.085 RL 80.002	E 484124.143 N 6939802.429 RL 81.104	E 484117.909 N 6939774.110 RL 81.001
Test Depth (mm) :	150	150	150	150
Layer Depth (mm) :	-	-	-	-
Maximum Size (mm) :	19	19	19	19
Oversize Wet (%) :	-	-	-	13
Oversize Dry (%) :	-	-	-	-
Oversize Density (t/m ³) :	-	-	-	2.610
Field Moisture Content (%) :	17.7	18.5	21.0	10.1
Hilf MDR Number :	242205	242206	242207	242208
Hilf MDR Method :	AS1289.5.1.1 & 5.7.1	AS1289.5.1.1 & 5.7.1	AS1289.5.1.1 & 5.7.1	AS1289.5.1.1 & 5.7.1
Compactive Effort :	Standard	Standard	Standard	Standard
Field Density Method :	AS1289.5.8.1 & 5.7.1	AS1289.5.8.1 & 5.7.1	AS1289.5.8.1 & 5.7.1	AS1289.5.8.1 & 5.7.1
Moisture Method :	AS1289.2.1.1	AS1289.2.1.1	AS1289.2.1.1	AS1289.2.1.1
Moisture Ratio (%) :	86.5	98	93.5	82
Field Wet Density (t/m ³) :	2.031	2.051	2.072	2.093
Optimum Moisture Content (%) :	20.4	18.9	22.5	12.3
Moisture Variation :	2.6	0.3	1.4	2.2
Peak Converted Wet Density (t/m ³) :	2.027	2.049	1.982	2.096*
Hilf Density Ratio (%) :	100.0	100.0	104.5	100.0
Minimum Specification :	95	95	95	95
Moisture Specification :	-	-	-	-
Site Selection :	-	-	-	-
Soil Description :	-	-	-	-
Remarks :	-			

* - denotes adjusted for oversize

 Accredited for compliance with ISO/IEC 17025 - Testing.	<p>APPROVED SIGNATORY</p>  Liam Mcdowall (Brisbane) - Branch Manager NATA Accreditation Number 1162 / 1169
---	---



MORRISON
GEOTECHNIC

Brisbane | Gold Coast | Maroochydore
Unit 1, 35 Limestone Street (PO Box 3063), Darra Q 4076 P (07) 3279 0900 F (07) 3279 0955

ABN: 51 009 878 899

www.morrisonge.com.au

Hilf Density Ratio Report

Client :	CCA WINSLOW	Report Number:	DL17/398 - 16
Address :	1587 IPSWICH ROAD, ROCKLEA, QLD, 4106	Report Date :	26/08/2017
Project Name :	EARTHWORKS SUPERVISION	Order Number :	33832
Project Number :	DL17/398	Test Method :	AS1289.5.8.1 & 5.7.1
Location:	EDEN'S CROSSING , FUTURE STAGES 15-20	Page 1 of 1	

Sample Number :	233216	233217	233218	233219
Test Number :	44	45	46	47
Sampling Method :	-	-	-	-
Date Sampled :	09/08/2017	09/08/2017	09/08/2017	09/08/2017
Date Tested :	09/08/2017	09/08/2017	09/08/2017	09/08/2017
Material Type :	Bulk Fill	Bulk Fill	Bulk Fill	Bulk Fill
Material Source :	On Site	On Site	On Site	On Site
Lot Number :	-	-	-	-
Sample Location :	E 484204.100 N 6939673.744 RL 88.068	E 484201.060 N 6939646.807 RL 88.798	E 484205.030 N 6939632.421 RL 87.991	E 484190.965 N 6939642.963 RL 86.974
Test Depth (mm) :	150	150	150	150
Layer Depth (mm) :	150	150	150	150
Maximum Size (mm) :	19	19	19	19
Oversize Wet (%) :	-	-	-	-
Oversize Dry (%) :	-	-	-	-
Oversize Density (t/m ³) :	-	-	-	-
Field Moisture Content (%) :	22.4	21.7	14.6	13.2
Hilf MDR Number :	233216	233217	233218	233219
Hilf MDR Method :	AS1289.5.1.1 & 5.7.1	AS1289.5.1.1 & 5.7.1	AS1289.5.1.1 & 5.7.1	AS1289.5.1.1 & 5.7.1
Compactive Effort :	Standard	Standard	Standard	Standard
Field Density Method :	AS1289.5.8.1 & 5.7.1	AS1289.5.8.1 & 5.7.1	AS1289.5.8.1 & 5.7.1	AS1289.5.8.1 & 5.7.1
Moisture Method :	AS1289.2.1.1	AS1289.2.1.1	AS1289.2.1.1	AS1289.2.1.1
Moisture Ratio (%) :	88.5	88	74.5	77.5
Field Wet Density (t/m ³) :	2.013	1.909	1.950	1.892
Optimum Moisture Content (%) :	25.3	24.6	19.6	17.0
Moisture Variation :	2.6	2.8	4.9	3.8
Peak Converted Wet Density (t/m ³) :	1.940	1.927	1.966	1.937
Hilf Density Ratio (%) :	104.0	99.0	99.0	97.5
Minimum Specification :	95	95	95	95
Moisture Specification :	-	-	-	-
Site Selection :	-	-	-	-
Soil Description :	-	-	-	-
Remarks :	-			



Accredited for compliance with ISO/IEC 17025.

APPROVED SIGNATORY

Liam A Mcdowall

Liam Mcdowall (Brisbane) - Branch Manager
NATA Accreditation Number
1162 / 1169

Document Code RF89-11



Hilf Density Ratio Report

Client :	CCA WINSLOW	Report Number:	DL17/398 - 48
Address :	1587 IPSWICH ROAD, ROCKLEA, QLD, 4106	Report Date :	19/02/2018
Project Name :	EARTHWORKS SUPERVISION	Order Number :	37618
Project Number :	DL17/398	Test Method :	AS1289.5.8.1 & 5.7.1
Location:	EDEN'S CROSSING , FUTURE STAGES 15-20	Page 1 of 1	

Sample Number :	241624		
Test Number :	139		
Sampling Method :	-		
Date Sampled :	08/02/2018		
Date Tested :	08/02/2018		
Material Type :	Bulk Fill		
Material Source :	On Site		
Lot Number :	-		
Sample Location :	E 484104.527 N 6939735.252 RL 82.444		
Test Depth (mm) :	150		
Layer Depth (mm) :	-		
Maximum Size (mm) :	19		
Oversize Wet (%) :	-		
Oversize Dry (%) :	-		
Oversize Density (t/m ³) :	-		
Field Moisture Content (%) :	22.7		
Hilf MDR Number :	241624		
Hilf MDR Method :	AS1289.5.1.1 & 5.7.1		
Compactive Effort :	Standard		
Field Density Method :	AS1289.5.8.1 & 5.7.1		
Moisture Method :	AS1289.2.1.1		
Moisture Ratio (%) :	100.5		
Field Wet Density (t/m ³) :	2.013		
Optimum Moisture Content (%) :	22.5		
Moisture Variation :	-0.1		
Peak Converted Wet Density (t/m ³) :	2.035		
Hilf Density Ratio (%) :	99.0		
Minimum Specification :	95		
Moisture Specification :	+ or - 2%		
Site Selection :	-		
Soil Description :	-		
Remarks :	-		



Accredited for compliance with ISO/IEC 17025.

APPROVED SIGNATORY

Liam Mcdowall (Brisbane) - Branch Manager
NATA Accreditation Number
1162 / 1169



MORRISON
GEOTECHNIC

Brisbane | Gold Coast | Maroochydore
Unit 1, 35 Limestone Street (PO Box 3063), Darra Q 4076 P (07) 3279 0900 F (07) 3279 0955
ABN: 51 009 878 899
www.morrisonge.com.au

Hilf Density Ratio Report

Client :	CCA WINSLOW	Report Number:	DL17/398 - 17
Address :	1587 IPSWICH ROAD, ROCKLEA, QLD, 4106	Report Date :	26/08/2017
Project Name :	EARTHWORKS SUPERVISION	Order Number :	33832
Project Number :	DL17/398	Test Method :	AS1289.5.8.1 & 5.7.1
Location:	EDEN'S CROSSING , FUTURE STAGES 15-20	Page 1 of 1	

Sample Number :	233220	233221	
Test Number :	48	49	
Sampling Method :	-	-	
Date Sampled :	09/08/2017	09/08/2017	
Date Tested :	09/08/2017	09/08/2017	
Material Type :	Bulk Fill	Bulk Fill	
Material Source :	On Site	On Site	
Lot Number :	-	-	
Sample Location :	E 484188.765 N 6939641.200 RL 87.712	E 484200.020 N 6939624.265 RL 88.550	
Test Depth (mm) :	150	150	
Layer Depth (mm) :	150	150	
Maximum Size (mm) :	19	19	
Oversize Wet (%) :	-	-	
Oversize Dry (%) :	-	-	
Oversize Density (t/m ³) :	-	-	
Field Moisture Content (%) :	21.1	19.3	
Hilf MDR Number :	233220	233221	
Hilf MDR Method :	AS1289.5.1.1 & 5.7.1	AS1289.5.1.1 & 5.7.1	
Compactive Effort :	Standard	Standard	
Field Density Method :	AS1289.5.8.1 & 5.7.1	AS1289.5.8.1 & 5.7.1	
Moisture Method :	AS1289.2.1.1	AS1289.2.1.1	
Moisture Ratio (%) :	86	88	
Field Wet Density (t/m ³) :	1.955	1.985	
Optimum Moisture Content (%) :	24.5	21.9	
Moisture Variation :	3.2	2.5	
Peak Converted Wet Density (t/m ³) :	1.932	1.966	
Hilf Density Ratio (%) :	101.0	101.0	
Minimum Specification :	95	95	
Moisture Specification :	-	-	
Site Selection :	-	-	
Soil Description :	-	-	
Remarks :	-		



Accredited for compliance with ISO/IEC 17025.

APPROVED SIGNATORY

Liam A Mcdowall

Liam Mcdowall (Brisbane) - Branch Manager
 NATA Accreditation Number
 1162 / 1169

Document Code RF89-11



MORRISON
GEOTECHNIC

Brisbane | Gold Coast | Maroochydore
Unit 1, 35 Limestone Street (PO Box 3063), Darra Q 4076 P (07) 3279 0900 F (07) 3279 0955
ABN: 51 009 878 899
www.morrisonge.com.au

Hilf Density Ratio Report

Client :	CCA WINSLOW	Report Number:	DL17/398 - 38
Address :	1587 IPSWICH ROAD, ROCKLEA, QLD, 4106	Report Date :	02/02/2018
Project Name :	EARTHWORKS SUPERVISION	Order Number :	36008
Project Number :	DL17/398	Test Method :	AS1289.5.8.1 & 5.7.1
Location:	EDEN'S CROSSING , FUTURE STAGES 15-20	Page 1 of 1	

Sample Number :	240717	240718	
Test Number :	108	109	
Sampling Method :	-	-	
Date Sampled :	20/01/2018	20/01/2018	
Date Tested :	20/01/2018	20/01/2018	
Material Type :	Bulk Fill	Bulk Fill	
Material Source :	On Site	On Site	
Lot Number :	-	-	
Sample Location :	E 484072.514 N 6939757.810 RL 79.174	E 484053.974 N 6939715.145 RL 80.519	
Test Depth (mm) :	150	150	
Layer Depth (mm) :	-	-	
Maximum Size (mm) :	19	19	
Oversize Wet (%) :	-	-	
Oversize Dry (%) :	-	-	
Oversize Density (t/m ³) :	-	-	
Field Moisture Content (%) :	17.7	14.5	
Hilf MDR Number :	240717	240718	
Hilf MDR Method :	AS1289.5.1.1 & 5.7.1	AS1289.5.1.1 & 5.7.1	
Compactive Effort :	Standard	Standard	
Field Density Method :	AS1289.5.8.1 & 5.7.1	AS1289.5.8.1 & 5.7.1	
Moisture Method :	AS1289.2.1.1	AS1289.2.1.1	
Moisture Ratio (%) :	98.5	96.5	
Field Wet Density (t/m ³) :	1.845	1.850	
Optimum Moisture Content (%) :	17.9	15.0	
Moisture Variation :	0.2	0.5	
Peak Converted Wet Density (t/m ³) :	1.937	1.940	
Hilf Density Ratio (%) :	95.0	95.5	
Minimum Specification :	95	95	
Moisture Specification :	+ or - 2%	+ or - 2%	
Site Selection :	-	-	
Soil Description :	-	-	
Remarks :	-		



Accredited for compliance with ISO/IEC 17025.

APPROVED SIGNATORY

Liam A Mcdowall

Liam Mcdowall (Brisbane) - Branch Manager
NATA Accreditation Number
1162 / 1169

Document Code RF89-11



MORRISON
GEOTECHNIC

Brisbane | Gold Coast | Maroochydore
Unit 1, 35 Limestone Street (PO Box 3063), Darra Q 4076 P (07) 3279 0900 F (07) 3279 0955

ABN: 51 009 878 899

www.morrisonge.com.au

Hilf Density Ratio Report

Client :	CCA WINSLOW	Report Number:	DL17/398 - 19
Address :	1587 IPSWICH ROAD, ROCKLEA, QLD, 4106	Report Date :	29/08/2017
Project Name :	EARTHWORKS SUPERVISION	Order Number :	33832
Project Number :	DL17/398	Test Method :	AS1289.5.8.1 & 5.7.1
Location:	EDEN'S CROSSING , FUTURE STAGES 15-20		Page 1 of 1

Sample Number :	233339	233340	233341
Test Number :	54	55	56
Sampling Method :	-	-	-
Date Sampled :	10/08/2017	10/08/2017	10/08/2017
Date Tested :	10/08/2017	10/08/2017	10/08/2017
Material Type :	Bulk Fill (Capping Layer)	Bulk Fill (Capping Layer)	Bulk Fill (Capping Layer)
Material Source :	On Site (Crushed Basalt)	On Site (Crushed Basalt)	On Site (Crushed Basalt)
Lot Number :	-	-	-
Sample Location :	E 484244.311 N 6939620.023 Final Level	E 484232.300 N 6939618.948 Final Level	E 484223.904 N 6939602.141 Final Level
Test Depth (mm) :	150	150	150
Layer Depth (mm) :	2.239	-	-
Maximum Size (mm) :	19	19	19
Oversize Wet (%) :	-	-	-
Oversize Dry (%) :	-	-	-
Oversize Density (t/m ³) :	-	-	-
Field Moisture Content (%) :	10.0	12.4	10.3
Hilf MDR Number :	233339	233340	233341
Hilf MDR Method :	AS1289.5.1.1 & 5.7.1	AS1289.5.1.1 & 5.7.1	AS1289.5.1.1 & 5.7.1
Compactive Effort :	Standard	Standard	Standard
Field Density Method :	AS1289.5.8.1 & 5.7.1	AS1289.5.8.1 & 5.7.1	AS1289.5.8.1 & 5.7.1
Moisture Method :	AS1289.2.1.1	AS1289.2.1.1	AS1289.2.1.1
Moisture Ratio (%) :	69.5	97	80.5
Field Wet Density (t/m ³) :	2.239	2.200	2.166
Optimum Moisture Content (%) :	14.4	12.8	12.8
Moisture Variation :	4.3	0.3	2.5
Peak Converted Wet Density (t/m ³) :	2.130	2.196	2.134
Hilf Density Ratio (%) :	105.0	100.0	101.5
Minimum Specification :	95	95	95
Moisture Specification :	-	-	-
Site Selection :	-	-	-
Soil Description :	-	-	-
Remarks :	-		



Accredited for compliance with ISO/IEC 17025.

APPROVED SIGNATORY

Liam A Mcdowall

Liam Mcdowall (Brisbane) - Branch Manager
NATA Accreditation Number
1162 / 1169

Document Code RF89-11



MORRISON
GEOTECHNIC

Brisbane | Gold Coast | Maroochydore
Unit 1, 35 Limestone Street (PO Box 3063), Darra Q 4076 P (07) 3279 0900 F (07) 3279 0955

ABN: 51 009 878 899

www.morrisonge.com.au

Hilf Density Ratio Report

Client :	CCA WINSLOW	Report Number:	DL17/398 - 20
Address :	1587 IPSWICH ROAD, ROCKLEA, QLD, 4106	Report Date :	30/08/2017
Project Name :	EARTHWORKS SUPERVISION	Order Number :	33832
Project Number :	DL17/398	Test Method :	AS1289.5.8.1 & 5.7.1
Location:	EDEN'S CROSSING , FUTURE STAGES 15-20	Page 1 of 1	

Sample Number :	233461	233462	233463	233464
Test Number :	57	58	59	60
Sampling Method :	-	-	-	-
Date Sampled :	11/08/2017	11/08/2017	11/08/2017	11/08/2017
Date Tested :	11/08/2017	11/08/2017	11/08/2017	11/08/2017
Material Type :	Bulk Fill	Bulk Fill	Bulk Fill	Bulk Fill
Material Source :	On Site	On Site	On Site	On Site
Lot Number :	-	-	-	-
Sample Location :	E 484155.075 N 6939640.985 RL 85.404	E 484166.069 N 6939625.787 RL 86.286	E 484178.253 N 6939639.834 RL 86.861	E 484195.858 N 6939607.992 RL 88.598
Test Depth (mm) :	150	150	150	150
Layer Depth (mm) :	150	150	150	150
Maximum Size (mm) :	19	19	19	19
Oversize Wet (%) :	-	-	-	-
Oversize Dry (%) :	-	-	-	-
Oversize Density (t/m ³) :	-	-	-	-
Field Moisture Content (%) :	21.2	24.5	15.8	18.2
Hilf MDR Number :	233461	233462	233463	233464
Hilf MDR Method :	AS1289.5.1.1 & 5.7.1	AS1289.5.1.1 & 5.7.1	AS1289.5.1.1 & 5.7.1	AS1289.5.1.1 & 5.7.1
Compactive Effort :	Standard	Standard	Standard	Standard
Field Density Method :	AS1289.5.8.1 & 5.7.1	AS1289.5.8.1 & 5.7.1	AS1289.5.8.1 & 5.7.1	AS1289.5.8.1 & 5.7.1
Moisture Method :	AS1289.2.1.1	AS1289.2.1.1	AS1289.2.1.1	AS1289.2.1.1
Moisture Ratio (%) :	85	88.5	79.5	80.5
Field Wet Density (t/m ³) :	1.905	1.848	1.895	1.964
Optimum Moisture Content (%) :	25.0	27.6	19.9	22.6
Moisture Variation :	3.7	3.0	3.9	4.3
Peak Converted Wet Density (t/m ³) :	1.820	1.838	1.976	1.870
Hilf Density Ratio (%) :	104.5	100.5	96.0	105.0
Minimum Specification :	95	95	95	95
Moisture Specification :	-	-	-	-
Site Selection :	-	-	-	-
Soil Description :	-	-	-	-
Remarks :	-			



Accredited for compliance with ISO/IEC 17025.

APPROVED SIGNATORY

Liam A Mcdowall

Liam Mcdowall (Brisbane) - Branch Manager
NATA Accreditation Number
1162 / 1169

Document Code RF89-11



Hilf Density Ratio Report

Client :	CCA WINSLOW	Report Number:	DL17/398 - 21
Address :	1587 IPSWICH ROAD, ROCKLEA, QLD, 4106	Report Date :	30/08/2017
Project Name :	EARTHWORKS SUPERVISION	Order Number :	33832
Project Number :	DL17/398	Test Method :	AS1289.5.8.1 & 5.7.1
Location:	EDEN'S CROSSING , FUTURE STAGES 15-20		Page 1 of 1

Sample Number :	233602	233603	233604	
Test Number :	61	62	63	
Sampling Method :	-	-	-	
Date Sampled :	15/08/2017	15/08/2017	15/08/2017	
Date Tested :	15/08/2017	15/08/2017	15/08/2017	
Material Type :	Bulk Fill (Capping Layer)	Bulk Fill (Capping Layer)	Bulk Fill (Capping Layer)	
Material Source :	On Site	On Site	On Site	
Lot Number :	-	-	-	
Sample Location :	E 484210.231 N 6939602.924 RL 89.994	E 484200.816 N 6939615.874 RL 89.101	E 484191.390 N 6939629.749 RL 88.614	
Test Depth (mm) :	150	150	150	
Layer Depth (mm) :	150	150	150	
Maximum Size (mm) :	19	19	19	
Oversize Wet (%) :	-	-	-	
Oversize Dry (%) :	-	-	-	
Oversize Density (t/m ³) :	-	-	-	
Field Moisture Content (%) :	21.3	18.7	14.5	
Hilf MDR Number :	233602	233603	233604	
Hilf MDR Method :	AS1289.5.1.1 & 5.7.1	AS1289.5.1.1 & 5.7.1	AS1289.5.1.1 & 5.7.1	
Compactive Effort :	Standard	Standard	Standard	
Field Density Method :	AS1289.5.8.1 & 5.7.1	AS1289.5.8.1 & 5.7.1	AS1289.5.8.1 & 5.7.1	
Moisture Method :	AS1289.2.1.1	AS1289.2.1.1	AS1289.2.1.1	
Moisture Ratio (%) :	94	95	82.5	
Field Wet Density (t/m ³) :	1.987	2.064	1.988	
Optimum Moisture Content (%) :	22.6	19.7	17.6	
Moisture Variation :	1.3	0.9	3.0	
Peak Converted Wet Density (t/m ³) :	1.987	2.054	2.079	
Hilf Density Ratio (%) :	100.0	100.5	95.5	
Minimum Specification :	95	95	95	
Moisture Specification :	-	-	-	
Site Selection :	-	-	-	
Soil Description :	-	-	-	
Remarks :	-			



Accredited for compliance with ISO/IEC 17025.

APPROVED SIGNATORY

Liam A Mcdowall

Liam Mcdowall (Brisbane) - Branch Manager
NATA Accreditation Number
1162 / 1169



MORRISON
GEOTECHNIC


Brisbane | Gold Coast | Maroochydore
Unit 1, 35 Limestone Street (PO Box 3063), Darra Q 4076 P (07) 3279 0900 F (07) 3279 0955
ABN: 51 009 878 899
www.morrisonge.com.au

Hilf Density Ratio Report

Client :	CCA WINSLOW	Report Number:	DL17/398 - 66
Address :	1587 IPSWICH ROAD, ROCKLEA, QLD, 4106	Report Date :	15/03/2018
Project Name :	EARTHWORKS SUPERVISION	Order Number :	37618
Project Number :	DL17/398	Test Method :	AS1289.5.8.1 & 5.7.1
Location:	EDEN'S CROSSING , FUTURE STAGES 15-20	Page 1 of 1	

Sample Number :	242575	242576	242577	242578
Test Number :	200	201	202	203
Sampling Method :	-	-	-	-
Date Sampled :	13/03/2018	13/03/2018	13/03/2018	13/03/2018
Date Tested :	13/03/2018	13/03/2018	13/03/2018	13/03/2018
Material Type :	Bulk Fill	Bulk Fill	Bulk Fill	Bulk Fill
Material Source :	On Site	On Site	On Site	On Site
Lot Number :	-	-	-	-
Sample Location :	E 484121.169 N 6939897.174 RL 78.146	E 484122.036 N 6939879.545 RL 78.654	E 484123.528 N 6939864.741 RL 79.644	E 484131.723 N 6939881.515 RL 79.440
Test Depth (mm) :	150	150	150	150
Layer Depth (mm) :	-	-	-	-
Maximum Size (mm) :	19	19	19	19
Oversize Wet (%) :	10	-	12	-
Oversize Dry (%) :	-	-	-	-
Oversize Density (t/m ³) :	2.564	-	2.099	-
Field Moisture Content (%) :	21.2	19.8	30.1	18.2
Hilf MDR Number :	242575	242576	242577	242578
Hilf MDR Method :	AS1289.5.1.1 & 5.7.1	AS1289.5.1.1 & 5.7.1	AS1289.5.1.1 & 5.7.1	AS1289.5.1.1 & 5.7.1
Compactive Effort :	Standard	Standard	Standard	Standard
Field Density Method :	AS1289.5.8.1 & 5.7.1	AS1289.5.8.1 & 5.7.1	AS1289.5.8.1 & 5.7.1	AS1289.5.8.1 & 5.7.1
Moisture Method :	AS1289.2.1.1	AS1289.2.1.1	AS1289.2.1.1	AS1289.2.1.1
Moisture Ratio (%) :	101	100.5	101	102.5
Field Wet Density (t/m ³) :	2.132	2.032	2.035	2.008
Optimum Moisture Content (%) :	21.0	19.7	29.8	17.8
Moisture Variation :	-0.2	-0.1	-0.2	-0.5
Peak Converted Wet Density (t/m ³) :	2.118*	2.111	1.947*	2.110
Hilf Density Ratio (%) :	100.5	96.5	104.5	95.0
Minimum Specification :	95	95	95	95
Moisture Specification :	+ or - 2%	+ or - 2%	+ or - 2%	+ or - 2%
Site Selection :	-	-	-	-
Soil Description :	-	-	-	-
Remarks :	-			

* - denotes adjusted for oversize

 <p>Accredited for compliance with ISO/IEC 17025 - Testing.</p>	<p>APPROVED SIGNATORY</p> <p><i>Liam A Mcdowall</i></p> <p>Liam Mcdowall (Brisbane) - Branch Manager NATA Accreditation Number 1162 / 1169</p>
	<p>Document Code RF89-11</p>



MORRISON
GEOTECHNIC

Brisbane | Gold Coast | Maroochydore
Unit 1, 35 Limestone Street (PO Box 3063), Darra Q 4076 P (07) 3279 0900 F (07) 3279 0955

ABN: 51 009 878 899

www.morrisonge.com.au

Hilf Density Ratio Report

Client :	CCA WINSLOW	Report Number:	DL17/398 - 24
Address :	1587 IPSWICH ROAD, ROCKLEA, QLD, 4106	Report Date :	31/08/2017
Project Name :	EARTHWORKS SUPERVISION	Order Number :	33832
Project Number :	DL17/398	Test Method :	AS1289.5.8.1 & 5.7.1
Location:	EDEN'S CROSSING , FUTURE STAGES 15-20		Page 1 of 1

Sample Number :	233639	233640	
Test Number :	70	71	
Sampling Method :	-	-	
Date Sampled :	16/08/2017	16/08/2017	
Date Tested :	16/08/2017	16/08/2017	
Material Type :	Bulk Fill (Capping Layer)	Bulk Fill (Capping Layer)	
Material Source :	On Site (Crushed Basalt)	On Site (Crushed Basalt)	
Lot Number :	-	-	
Sample Location :	E 484182.435 N 6939604.985 RL 89.120	E 484169.530 N 6939593.310 RL 88.720	
Test Depth (mm) :	150	150	
Layer Depth (mm) :	-	-	
Maximum Size (mm) :	19	19	
Oversize Wet (%) :	-	-	
Oversize Dry (%) :	-	-	
Oversize Density (t/m ³) :	-	-	
Field Moisture Content (%) :	13.1	11.6	
Hilf MDR Number :	233639	233640	
Hilf MDR Method :	AS1289.5.1.1 & 5.7.1	AS1289.5.1.1 & 5.7.1	
Compactive Effort :	Standard	Standard	
Field Density Method :	AS1289.5.8.1 & 5.7.1	AS1289.5.8.1 & 5.7.1	
Moisture Method :	AS1289.2.1.1	AS1289.2.1.1	
Moisture Ratio (%) :	75.5	83	
Field Wet Density (t/m ³) :	2.171	2.108	
Optimum Moisture Content (%) :	17.4	14.0	
Moisture Variation :	4.1	2.4	
Peak Converted Wet Density (t/m ³) :	2.105	2.124	
Hilf Density Ratio (%) :	103.0	99.0	
Minimum Specification :	95	95	
Moisture Specification :	-	-	
Site Selection :	-	-	
Soil Description :	-	-	
Remarks :	-		



Accredited for compliance with ISO/IEC 17025.

APPROVED SIGNATORY

Liam A Mcdowall

Liam Mcdowall (Brisbane) - Branch Manager
NATA Accreditation Number
1162 / 1169

Document Code RF89-11



MORRISON
GEOTECHNIC

Brisbane | Gold Coast | Maroochydore
Unit 1, 35 Limestone Street (PO Box 3063), Darra Q 4076 P (07) 3279 0900 F (07) 3279 0955

ABN: 51 009 878 899

www.morrisonge.com.au

Hilf Density Ratio Report

Client :	CCA WINSLOW	Report Number:	DL17/398 - 22
Address :	1587 IPSWICH ROAD, ROCKLEA, QLD, 4106	Report Date :	30/08/2017
Project Name :	EARTHWORKS SUPERVISION	Order Number :	33832
Project Number :	DL17/398	Test Method :	AS1289.5.8.1 & 5.7.1
Location:	EDEN'S CROSSING , FUTURE STAGES 15-20		Page 1 of 1

Sample Number :	233605	233606	233607	
Test Number :	64	65	66	
Sampling Method :	-	-	-	
Date Sampled :	15/08/2017	15/08/2017	15/08/2017	
Date Tested :	15/08/2017	15/08/2017	15/08/2017	
Material Type :	Bulk Fill (Capping Layer)	Bulk Fill (Capping Layer)	Bulk Fill (Capping Layer)	
Material Source :	On Site (Crushed Basalt)	On Site (Crushed Basalt)	On Site (Crushed Basalt)	
Lot Number :	-	-	-	
Sample Location :	E 484207.589 N 6939586.412 RL 90.487	E 484200.097 N 6939596.705 RL 90.033	E 484194.420 N 6939604.893 RL 89.769	
Test Depth (mm) :	150	150	150	
Layer Depth (mm) :	150	150	150	
Maximum Size (mm) :	19	19	19	
Oversize Wet (%) :	-	-	-	
Oversize Dry (%) :	-	-	-	
Oversize Density (t/m ³) :	-	-	-	
Field Moisture Content (%) :	13.7	12.5	12.2	
Hilf MDR Number :	233605	233606	233607	
Hilf MDR Method :	AS1289.5.1.1 & 5.7.1	AS1289.5.1.1 & 5.7.1	AS1289.5.1.1 & 5.7.1	
Compactive Effort :	Standard	Standard	Standard	
Field Density Method :	AS1289.5.8.1 & 5.7.1	AS1289.5.8.1 & 5.7.1	AS1289.5.8.1 & 5.7.1	
Moisture Method :	AS1289.2.1.1	AS1289.2.1.1	AS1289.2.1.1	
Moisture Ratio (%) :	84.5	83	83	
Field Wet Density (t/m ³) :	2.180	2.248	2.253	
Optimum Moisture Content (%) :	16.2	15.0	14.7	
Moisture Variation :	2.4	2.5	2.4	
Peak Converted Wet Density (t/m ³) :	2.113	2.156	2.155	
Hilf Density Ratio (%) :	103.0	104.5	104.5	
Minimum Specification :	95	95	95	
Moisture Specification :	-	-	-	
Site Selection :	-	-	-	
Soil Description :	-	-	-	
Remarks :	-	-	-	



Accredited for compliance with ISO/IEC 17025.

APPROVED SIGNATORY

Liam A Mcdowall

Liam Mcdowall (Brisbane) - Branch Manager
NATA Accreditation Number
1162 / 1169

Document Code RF89-11



MORRISON
GEOTECHNIC

Brisbane | Gold Coast | Maroochydore
Unit 1, 35 Limestone Street (PO Box 3063), Darra Q 4076 P (07) 3279 0900 F (07) 3279 0955
ABN: 51 009 878 899
www.morrisonge.com.au

Hilf Density Ratio Report

Client :	CCA WINSLOW	Report Number:	DL17/398 - 56
Address :	1587 IPSWICH ROAD, ROCKLEA, QLD, 4106	Report Date :	02/03/2018
Project Name :	EARTHWORKS SUPERVISION	Order Number :	37618
Project Number :	DL17/398	Test Method :	AS1289.5.8.1 & 5.7.1
Location:	EDEN'S CROSSING , FUTURE STAGES 15-20	Page 1 of 1	

Sample Number :	242079	242080	242081	242082
Test Number :	164	165	166	167
Sampling Method :	-	-	-	-
Date Sampled :	19/02/2018	19/02/2018	19/02/2018	19/02/2018
Date Tested :	19/02/2018	19/02/2018	19/02/2018	19/02/2018
Material Type :	Bulk Fill	Bulk Fill	Bulk Fill	Bulk Fill
Material Source :	On Site	On Site	On Site	On Site
Lot Number :	-	-	-	-
Sample Location :	E 484111.59 N 6939751.16 RL 81.92	E 484113.91 N 6939771.86 RL 80.49	E 484118.93 N 6939794.46 RL 80.58	E 484112.39 N 6939816.16 RL 80.25
Test Depth (mm) :	150	150	150	150
Layer Depth (mm) :	150	150	150	150
Maximum Size (mm) :	19	19	19	19
Oversize Wet (%) :	-	-	-	-
Oversize Dry (%) :	-	-	-	-
Oversize Density (t/m ³) :	-	-	-	-
Field Moisture Content (%) :	16.0	11.8	11.4	22.4
Hilf MDR Number :	242079	242080	242081	242082
Hilf MDR Method :	AS1289.5.1.1 & 5.7.1	AS1289.5.1.1 & 5.7.1	AS1289.5.1.1 & 5.7.1	AS1289.5.1.1 & 5.7.1
Compactive Effort :	Standard	Standard	Standard	Standard
Field Density Method :	AS1289.5.8.1 & 5.7.1	AS1289.5.8.1 & 5.7.1	AS1289.5.8.1 & 5.7.1	AS1289.5.8.1 & 5.7.1
Moisture Method :	AS1289.2.1.1	AS1289.2.1.1	AS1289.2.1.1	AS1289.2.1.1
Moisture Ratio (%) :	89.5	88	85.5	91.5
Field Wet Density (t/m ³) :	1.987	1.997	2.012	2.038
Optimum Moisture Content (%) :	17.8	13.4	13.3	24.4
Moisture Variation :	1.8	1.7	2.0	2.0
Peak Converted Wet Density (t/m ³) :	2.048	2.057	1.976	1.945
Hilf Density Ratio (%) :	97.0	97.0	102.0	105.0
Minimum Specification :	95	95	95	95
Moisture Specification :	+ or - 2%	+ or - 2%	+ or - 2%	+ or - 2%
Site Selection :	-	-	-	-
Soil Description :	-	-	-	-
Remarks :	-			



Accredited for compliance with ISO/IEC 17025 - Testing.

APPROVED SIGNATORY

Liam A Mcdowall

Liam Mcdowall (Brisbane) - Branch Manager
NATA Accreditation Number
1162 / 1169

Document Code RF89-11



MORRISON
GEOTECHNIC

Brisbane | Gold Coast | Maroochydore
Unit 1, 35 Limestone Street (PO Box 3063), Darra Q 4076 P (07) 3279 0900 F (07) 3279 0955

ABN: 51 009 878 899

www.morrisonge.com.au

Hilf Density Ratio Report

Client :	CCA WINSLOW	Report Number:	DL17/398 - 23
Address :	1587 IPSWICH ROAD, ROCKLEA, QLD, 4106	Report Date :	30/08/2017
Project Name :	EARTHWORKS SUPERVISION	Order Number :	33832
Project Number :	DL17/398	Test Method :	AS1289.5.8.1 & 5.7.1
Location:	EDEN'S CROSSING , FUTURE STAGES 15-20		Page 1 of 1

Sample Number :	233636	233637	233638
Test Number :	67	68	69
Sampling Method :	-	-	-
Date Sampled :	16/08/2017	16/08/2017	16/08/2017
Date Tested :	16/08/2017	16/08/2017	16/08/2017
Material Type :	Bulk Fill	Bulk Fill	Bulk Fill
Material Source :	On Site	On Site	On Site
Lot Number :	-	-	-
Sample Location :	E 484169 N 6939601 RL 87.8	E 484176 N 6939607 RL 88.2	E 484170 N 6939598 RL 87.8
Test Depth (mm) :	150	150	150
Layer Depth (mm) :	150	150	150
Maximum Size (mm) :	19	19	19
Oversize Wet (%) :	-	-	-
Oversize Dry (%) :	-	-	-
Oversize Density (t/m ³) :	-	-	-
Field Moisture Content (%) :	27.4	27.3	23.9
Hilf MDR Number :	233636	233637	233638
Hilf MDR Method :	AS1289.5.1.1 & 5.7.1	AS1289.5.1.1 & 5.7.1	AS1289.5.1.1 & 5.7.1
Compactive Effort :	Standard	Standard	Standard
Field Density Method :	AS1289.5.8.1 & 5.7.1	AS1289.5.8.1 & 5.7.1	AS1289.5.8.1 & 5.7.1
Moisture Method :	AS1289.2.1.1	AS1289.2.1.1	AS1289.2.1.1
Moisture Ratio (%) :	98.5	99	90.5
Field Wet Density (t/m ³) :	1.688	1.726	1.804
Optimum Moisture Content (%) :	27.8	27.5	26.3
Moisture Variation :	0.4	0.3	2.4
Peak Converted Wet Density (t/m ³) :	1.721	1.776	1.817
Hilf Density Ratio (%) :	98.0	97.0	99.5
Minimum Specification :	95	95	95
Moisture Specification :	-	-	-
Site Selection :	-	-	-
Soil Description :	-	-	-
Remarks :	-		



Accredited for compliance with ISO/IEC 17025.

APPROVED SIGNATORY

Liam A Mcdowall

Liam Mcdowall (Brisbane) - Branch Manager
NATA Accreditation Number
1162 / 1169

Document Code RF89-11



Hilf Density Ratio Report

Client :	CCA WINSLOW	Report Number:	DL17/398 - 64
Address :	1587 IPSWICH ROAD, ROCKLEA, QLD, 4106	Report Date :	08/03/2018
Project Name :	EARTHWORKS SUPERVISION	Order Number :	37618
Project Number :	DL17/398	Test Method :	AS1289.5.8.1 & 5.7.1
Location:	EDEN'S CROSSING , FUTURE STAGES 15-20	Page 1 of 1	

Sample Number :	242436	242437	242438	242439
Test Number :	193	194	195	196
Sampling Method :	-	-	-	-
Date Sampled :	03/03/2018	03/03/2018	03/03/2018	03/03/2018
Date Tested :	03/03/2018	03/03/2018	03/03/2018	03/03/2018
Material Type :	Bulk Fill	Bulk Fill	Bulk Fill	Bulk Fill
Material Source :	On Site	On Site	On Site	On Site
Lot Number :	-	-	-	-
Sample Location :	E 484123.011 N 6939861.764 RL 78.888	E 484115.119 N 6939879.784 RL 76.680	E 484126.682 N 6939880.145 RL 78.569	E 484136.730 N 6939859.444 RL 79.914
Test Depth (mm) :	150	150	150	150
Layer Depth (mm) :	150	150	150	150
Maximum Size (mm) :	19	19	19	19
Oversize Wet (%) :	-	-	-	-
Oversize Dry (%) :	-	-	-	-
Oversize Density (t/m ³) :	-	-	-	-
Field Moisture Content (%) :	18.5	15.5	11.9	15.0
Hilf MDR Number :	242436	242437	242438	242439
Hilf MDR Method :	AS1289.5.1.1 & 5.7.1	AS1289.5.1.1 & 5.7.1	AS1289.5.1.1 & 5.7.1	AS1289.5.1.1 & 5.7.1
Compactive Effort :	Standard	Standard	Standard	Standard
Field Density Method :	AS1289.5.8.1 & 5.7.1	AS1289.5.8.1 & 5.7.1	AS1289.5.8.1 & 5.7.1	AS1289.5.8.1 & 5.7.1
Moisture Method :	AS1289.2.1.1	AS1289.2.1.1	AS1289.2.1.1	AS1289.2.1.1
Moisture Ratio (%) :	98	95.5	92	97
Field Wet Density (t/m ³) :	2.050	2.086	2.043	2.051
Optimum Moisture Content (%) :	18.8	16.2	12.9	15.5
Moisture Variation :	0.3	0.7	1.0	0.5
Peak Converted Wet Density (t/m ³) :	2.111	2.132	2.087	2.107
Hilf Density Ratio (%) :	97.0	98.0	98.0	97.5
Minimum Specification :	95	95	95	95
Moisture Specification :	+ or - 2%	+ or - 2%	+ or - 2%	+ or - 2%
Site Selection :	-	-	-	-
Soil Description :	Sandy Clay	Sandy Clay	Sandy Clay	Sandy Clay
Remarks :	-			



Accredited for compliance with ISO/IEC 17025 - Testing.

APPROVED SIGNATORY

Liam A Mcdowall

Liam Mcdowall (Brisbane) - Branch Manager
NATA Accreditation Number
1162 / 1169



Hilf Density Ratio Report

Client :	CCA WINSLOW	Report Number:	DL17/398 - 28
Address :	1587 IPSWICH ROAD, ROCKLEA, QLD, 4106	Report Date :	19/01/2018
Project Name :	EARTHWORKS SUPERVISION	Order Number :	33832
Project Number :	DL17/398	Test Method :	AS1289.5.8.1 & 5.7.1
Location:	EDEN'S CROSSING , FUTURE STAGES 15-20	Page 1 of 1	

Sample Number :	240175	240176	240177	240178
Test Number :	80	81	82	83
Sampling Method :	-	-	-	-
Date Sampled :	12/01/2018	12/01/2018	12/01/2018	12/01/2018
Date Tested :	12/01/2018	12/01/2018	12/01/2018	12/01/2018
Material Type :	Bulk Fill	Bulk Fill	Bulk Fill	Bulk Fill
Material Source :	On Site	On Site	On Site	On Site
Lot Number :	-	-	-	-
Sample Location :	E 484083.474 N 6939715.456 RL 80.315	E 484094.239 N 6939740.988 RL 79.540	E 484098.017 N 6939698.481 RL 81.201	E 484080.606 N 6939712.33 RL 81.501
Test Depth (mm) :	150	150	150	150
Layer Depth (mm) :	-	-	-	-
Maximum Size (mm) :	19	19	19	19
Oversize Wet (%) :	-	-	-	-
Oversize Dry (%) :	-	-	-	-
Oversize Density (t/m ³) :	-	-	-	-
Field Moisture Content (%) :	34.0	23.2	26.9	29.8
Hilf MDR Number :	240175	240176	240177	240178
Hilf MDR Method :	AS1289.5.1.1 & 5.7.1	AS1289.5.1.1 & 5.7.1	AS1289.5.1.1 & 5.7.1	AS1289.5.1.1 & 5.7.1
Compactive Effort :	Standard	Standard	Standard	Standard
Field Density Method :	AS1289.5.8.1 & 5.7.1	AS1289.5.8.1 & 5.7.1	AS1289.5.8.1 & 5.7.1	AS1289.5.8.1 & 5.7.1
Moisture Method :	AS1289.2.1.1	AS1289.2.1.1	AS1289.2.1.1	AS1289.2.1.1
Moisture Ratio (%) :	95	91.5	95.5	94
Field Wet Density (t/m ³) :	1.770	1.742	1.820	1.792
Optimum Moisture Content (%) :	35.9	25.3	28.2	31.7
Moisture Variation :	1.8	2.1	1.2	1.8
Peak Converted Wet Density (t/m ³) :	1.766	1.809	1.818	1.842
Hilf Density Ratio (%) :	100.0	96.5	100.0	97.5
Minimum Specification :	95	95	95	95
Moisture Specification :	+ or - 2%	+ or - 2%	+ or - 2%	+ or - 2%
Site Selection :	-	-	-	-
Soil Description :	-	-	-	-
Remarks :	-			



Accredited for compliance with ISO/IEC 17025.

APPROVED SIGNATORY

Liam A Mcdowall

Liam Mcdowall (Brisbane) - Branch Manager
NATA Accreditation Number
1162 / 1169



Hilf Density Ratio Report

Client :	CCA WINSLOW	Report Number:	DL17/398 - 30
Address :	1587 IPSWICH ROAD, ROCKLEA, QLD, 4106	Report Date :	25/01/2018
Project Name :	EARTHWORKS SUPERVISION	Order Number :	33832
Project Number :	DL17/398	Test Method :	AS1289.5.8.1 & 5.7.1
Location:	EDEN'S CROSSING , FUTURE STAGES 15-20	Page 1 of 1	

Sample Number :	240424	240425	240426	240427
Test Number :	86	87	88	89
Sampling Method :	-	-	-	-
Date Sampled :	16/01/2018	16/01/2018	16/01/2018	16/01/2018
Date Tested :	16/01/2018	16/01/2018	16/01/2018	16/01/2018
Material Type :	Bulk Fill	Bulk Fill	Bulk Fill	Bulk Fill
Material Source :	On Site	On Site	On Site	On Site
Lot Number :	-	-	-	-
Sample Location :	E 484113.273 N 6939734.817 RL 80.294	E 484098.364 N 6939724.142 RL 80.590	E 484099.610 N 6939700.422 RL 81.654	E 484084.549 N 6939684.687 RL 81.797
Test Depth (mm) :	150	150	150	150
Layer Depth (mm) :	-	-	-	-
Maximum Size (mm) :	19	19	19	19
Oversize Wet (%) :	-	-	-	-
Oversize Dry (%) :	-	-	-	-
Oversize Density (t/m ³) :	-	-	-	-
Field Moisture Content (%) :	24.5	19.1	23.0	21.0
Hilf MDR Number :	240424	240425	240426	240427
Hilf MDR Method :	AS1289.5.1.1 & 5.7.1	AS1289.5.1.1 & 5.7.1	AS1289.5.1.1 & 5.7.1	AS1289.5.1.1 & 5.7.1
Compactive Effort :	Standard	Standard	Standard	Standard
Field Density Method :	AS1289.5.8.1 & 5.7.1	AS1289.5.8.1 & 5.7.1	AS1289.5.8.1 & 5.7.1	AS1289.5.8.1 & 5.7.1
Moisture Method :	AS1289.2.1.1	AS1289.2.1.1	AS1289.2.1.1	AS1289.2.1.1
Moisture Ratio (%) :	92	90.5	91.5	91
Field Wet Density (t/m ³) :	1.804	1.894	1.804	1.873
Optimum Moisture Content (%) :	26.6	21.2	25.1	23.0
Moisture Variation :	2.1	2.0	2.1	2.0
Peak Converted Wet Density (t/m ³) :	1.846	1.901	1.852	1.885
Hilf Density Ratio (%) :	97.5	99.5	97.5	99.5
Minimum Specification :	95	95	95	95
Moisture Specification :	+ or - 2%	+ or - 2%	+ or - 2%	+ or - 2%
Site Selection :	-	-	-	-
Soil Description :	-	-	-	-
Remarks :	-			



Accredited for compliance with ISO/IEC 17025.

APPROVED SIGNATORY



Sam Woodley (Brisbane) - Laboratory Manager
NATA Accreditation Number
1162 / 1169



Hilf Density Ratio Report

Client :	CCA WINSLOW	Report Number:	DL17/398 - 31
Address :	1587 IPSWICH ROAD, ROCKLEA, QLD, 4106	Report Date :	25/01/2018
Project Name :	EARTHWORKS SUPERVISION	Order Number :	33832
Project Number :	DL17/398	Test Method :	AS1289.5.8.1 & 5.7.1
Location:	EDEN'S CROSSING , FUTURE STAGES 15-20	Page 1 of 1	

Sample Number :	240428		
Test Number :	90		
Sampling Method :	-		
Date Sampled :	16/01/2018		
Date Tested :	16/01/2018		
Material Type :	Bulk Fill		
Material Source :	On Site		
Lot Number :	-		
Sample Location :	E 484085.467 N 6939663.085 RL 83.102		
Test Depth (mm) :	150		
Layer Depth (mm) :	-		
Maximum Size (mm) :	19		
Oversize Wet (%) :	-		
Oversize Dry (%) :	-		
Oversize Density (t/m ³) :	-		
Field Moisture Content (%) :	19.5		
Hilf MDR Number :	240428		
Hilf MDR Method :	AS1289.5.1.1 & 5.7.1		
Compactive Effort :	Standard		
Field Density Method :	AS1289.5.8.1 & 5.7.1		
Moisture Method :	AS1289.2.1.1		
Moisture Ratio (%) :	90.5		
Field Wet Density (t/m ³) :	1.877		
Optimum Moisture Content (%) :	21.5		
Moisture Variation :	2.0		
Peak Converted Wet Density (t/m ³) :	1.889		
Hilf Density Ratio (%) :	99.5		
Minimum Specification :	95		
Moisture Specification :	+ or - 2%		
Site Selection :	-		
Soil Description :	-		
Remarks :	-		

 NATA <small>VIC-13 RECOGNISED ACCREDITATION</small>	Accredited for compliance with ISO/IEC 17025.	APPROVED SIGNATORY  Sam Woodley (Brisbane) - Laboratory Manager NATA Accreditation Number 1162 / 1169
		Document Code RF89-11



Hilf Density Ratio Report

Client :	CCA WINSLOW	Report Number:	DL17/398 - 62
Address :	1587 IPSWICH ROAD, ROCKLEA, QLD, 4106	Report Date :	08/03/2018
Project Name :	EARTHWORKS SUPERVISION	Order Number :	37618
Project Number :	DL17/398	Test Method :	AS1289.5.8.1 & 5.7.1
Location:	EDEN'S CROSSING , FUTURE STAGES 15-20	Page 1 of 1	

Sample Number :	242428	242429	242430	242431
Test Number :	185	186	187	188
Sampling Method :	-	-	-	-
Date Sampled :	03/03/2018	03/03/2018	03/03/2018	03/03/2018
Date Tested :	03/03/2018	03/03/2018	03/03/2018	03/03/2018
Material Type :	Bulk Fill	Bulk Fill	Bulk Fill	Bulk Fill
Material Source :	On Site	On Site	On Site	On Site
Lot Number :	-	-	-	-
Sample Location :	E 484109 N 6939873 RL 78.600	E 484109 N 6939882 RL 77.670	E 484110 N 6939893 RL 76.903	E 484119 N 6939874 RL 78.250
Test Depth (mm) :	150	150	150	150
Layer Depth (mm) :	150	150	150	150
Maximum Size (mm) :	19	19	19	19
Oversize Wet (%) :	-	-	-	-
Oversize Dry (%) :	-	-	-	-
Oversize Density (t/m ³) :	-	-	-	-
Field Moisture Content (%) :	18.4	16.2	15.2	21.7
Hilf MDR Number :	242428	242429	242430	242431
Hilf MDR Method :	AS1289.5.1.1 & 5.7.1	AS1289.5.1.1 & 5.7.1	AS1289.5.1.1 & 5.7.1	AS1289.5.1.1 & 5.7.1
Compactive Effort :	Standard	Standard	Standard	Standard
Field Density Method :	AS1289.5.8.1 & 5.7.1	AS1289.5.8.1 & 5.7.1	AS1289.5.8.1 & 5.7.1	AS1289.5.8.1 & 5.7.1
Moisture Method :	AS1289.2.1.1	AS1289.2.1.1	AS1289.2.1.1	AS1289.2.1.1
Moisture Ratio (%) :	95	91.5	95.5	99.5
Field Wet Density (t/m ³) :	2.006	1.997	2.052	1.968
Optimum Moisture Content (%) :	19.3	17.7	15.9	21.8
Moisture Variation :	0.9	1.5	0.7	0.1
Peak Converted Wet Density (t/m ³) :	2.063	1.991	2.066	2.027
Hilf Density Ratio (%) :	97.0	100.5	99.5	97.0
Minimum Specification :	95	95	95	95
Moisture Specification :	+ or - 2%	+ or - 2%	+ or - 2%	+ or - 2%
Site Selection :	-	-	-	-
Soil Description :	Sandy Clay	Sandy Clay	Sandy Clay	Sandy Clay
Remarks :	-			



Accredited for compliance with ISO/IEC 17025 - Testing.

APPROVED SIGNATORY

Liam A Mcdowall

Liam Mcdowall (Brisbane) - Branch Manager
NATA Accreditation Number
1162 / 1169



MORRISON
GEOTECHNIC

Brisbane | Gold Coast | Maroochydore
Unit 1, 35 Limestone Street (PO Box 3063), Darra Q 4076 P (07) 3279 0900 F (07) 3279 0955
ABN: 51 009 878 899
www.morrisonge.com.au

Hilf Density Ratio Report

Client :	CCA WINSLOW	Report Number:	DL17/398 - 32
Address :	1587 IPSWICH ROAD, ROCKLEA, QLD, 4106	Report Date :	30/01/2018
Project Name :	EARTHWORKS SUPERVISION	Order Number :	33832
Project Number :	DL17/398	Test Method :	AS1289.5.8.1 & 5.7.1
Location:	EDEN'S CROSSING , FUTURE STAGES 15-20	Page 1 of 1	

Sample Number :	240613	240614	240615	240616
Test Number :	91	92	93	94
Sampling Method :	-	-	-	-
Date Sampled :	18/01/2018	18/01/2018	18/01/2018	18/01/2018
Date Tested :	18/01/2018	18/01/2018	18/01/2018	18/01/2018
Material Type :	Bulk Fill	Bulk Fill	Bulk Fill	Bulk Fill
Material Source :	On Site	On Site	On Site	On Site
Lot Number :	-	-	-	-
Sample Location :	E 484050.596 N 6939651.457 RL 83.012	E 484047.127 N 6939672.996 RL 81.924	E 484063.542 N 6939698.318 RL 80.875	E 484063.727 N 6939724.304 RL 80.044
Test Depth (mm) :	150	150	150	150
Layer Depth (mm) :	-	-	-	-
Maximum Size (mm) :	19	19	19	19
Oversize Wet (%) :	-	-	-	-
Oversize Dry (%) :	-	-	-	-
Oversize Density (t/m ³) :	-	-	-	-
Field Moisture Content (%) :	49.5	13.9	23.9	14.7
Hilf MDR Number :	240613	240614	240615	240616
Hilf MDR Method :	AS1289.5.1.1 & 5.7.1	AS1289.5.1.1 & 5.7.1	AS1289.5.1.1 & 5.7.1	AS1289.5.1.1 & 5.7.1
Compactive Effort :	Standard	Standard	Standard	Standard
Field Density Method :	AS1289.5.8.1 & 5.7.1	AS1289.5.8.1 & 5.7.1	AS1289.5.8.1 & 5.7.1	AS1289.5.8.1 & 5.7.1
Moisture Method :	AS1289.2.1.1	AS1289.2.1.1	AS1289.2.1.1	AS1289.2.1.1
Moisture Ratio (%) :	99	88	101.5	90
Field Wet Density (t/m ³) :	1.766	1.833	1.987	1.963
Optimum Moisture Content (%) :	50.1	15.8	23.5	16.3
Moisture Variation :	0.5	2.0	-0.4	1.6
Peak Converted Wet Density (t/m ³) :	1.825	1.931	2.017	2.030
Hilf Density Ratio (%) :	97.0	95.0	98.5	96.5
Minimum Specification :	95	95	95	95
Moisture Specification :	+ or - 2%	+ or - 2%	+ or - 2%	+ or - 2%
Site Selection :	-	-	-	-
Soil Description :	-	-	-	-
Remarks :	-			



Accredited for compliance with ISO/IEC 17025.

APPROVED SIGNATORY

Liam A Mcdowall

Liam Mcdowall (Brisbane) - Branch Manager
NATA Accreditation Number
1162 / 1169

Document Code RF89-11



MORRISON
GEOTECHNIC


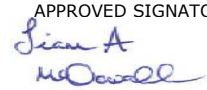
Brisbane | Gold Coast | Maroochydore
Unit 1, 35 Limestone Street (PO Box 3063), Darra Q 4076 P (07) 3279 0900 F (07) 3279 0955
ABN: 51 009 878 899
www.morrisonge.com.au

Hilf Density Ratio Report

Client :	CCA WINSLOW	Report Number:	DL17/398 - 61
Address :	1587 IPSWICH ROAD, ROCKLEA, QLD, 4106	Report Date :	08/03/2018
Project Name :	EARTHWORKS SUPERVISION	Order Number :	37618
Project Number :	DL17/398	Test Method :	AS1289.5.8.1 & 5.7.1
Location:	EDEN'S CROSSING , FUTURE STAGES 15-20	Page 1 of 1	

Sample Number :	242414	242416	242417	242418
Test Number :	181	182	183	184
Sampling Method :	-	-	-	-
Date Sampled :	02/03/2018	02/03/2018	02/03/2018	02/03/2018
Date Tested :	02/03/2018	02/03/2018	02/03/2018	02/03/2018
Material Type :	Bulk Fill	Bulk Fill	Bulk Fill	Bulk Fill
Material Source :	On Site	On Site	On Site	On Site
Lot Number :	-	-	-	-
Sample Location :	E 484098.778 N 6939757.514 RL 82.433	E 484106.219 N 6939785.914 RL 81.695	E 484116.485 N 6939784.205 RL 81.854	E 484115.575 N 6939814.536 RL 81.204
Test Depth (mm) :	150	150	150	150
Layer Depth (mm) :	150	150	150	150
Maximum Size (mm) :	19	19	19	19
Oversize Wet (%) :	12	-	-	-
Oversize Dry (%) :	-	-	-	-
Oversize Density (t/m ³) :	2.507	-	-	-
Field Moisture Content (%) :	16.8	15.1	16.7	14.8
Hilf MDR Number :	242414	242416	242417	242418
Hilf MDR Method :	AS1289.5.1.1 & 5.7.1	AS1289.5.1.1 & 5.7.1	AS1289.5.1.1 & 5.7.1	AS1289.5.1.1 & 5.7.1
Compactive Effort :	Standard	Standard	Standard	Standard
Field Density Method :	AS1289.5.8.1 & 5.7.1	AS1289.5.8.1 & 5.7.1	AS1289.5.8.1 & 5.7.1	AS1289.5.8.1 & 5.7.1
Moisture Method :	AS1289.2.1.1	AS1289.2.1.1	AS1289.2.1.1	AS1289.2.1.1
Moisture Ratio (%) :	101.5	101.5	104.5	100
Field Wet Density (t/m ³) :	2.121	2.099	2.059	2.073
Optimum Moisture Content (%) :	16.6	14.9	16.0	14.8
Moisture Variation :	-0.2	-0.2	-0.7	0.0
Peak Converted Wet Density (t/m ³) :	2.162*	2.150	2.145	2.130
Hilf Density Ratio (%) :	98.0	97.5	96.0	97.5
Minimum Specification :	95	95	95	95
Moisture Specification :	+ or - 2%	+ or - 2%	+ or - 2%	+ or - 2%
Site Selection :	-	-	-	-
Soil Description :	Sandy Clay	Sandy Clay	Sandy Clay	Sandy Clay
Remarks :	-			

* - denotes adjusted for oversize

 Accredited for compliance with ISO/IEC 17025 - Testing.	APPROVED SIGNATORY  Liam Mcdowall (Brisbane) - Branch Manager NATA Accreditation Number 1162 / 1169
---	--



Hilf Density Ratio Report

Client :	CCA WINSLOW	Report Number:	DL17/398 - 33
Address :	1587 IPSWICH ROAD, ROCKLEA, QLD, 4106	Report Date :	30/01/2018
Project Name :	EARTHWORKS SUPERVISION	Order Number :	33832
Project Number :	DL17/398	Test Method :	AS1289.5.8.1 & 5.7.1
Location:	EDEN'S CROSSING , FUTURE STAGES 15-20	Page 1 of 1	

Sample Number :	240617	240618	240619	240620
Test Number :	95	96	97	98
Sampling Method :	-	-	-	-
Date Sampled :	18/01/2018	18/01/2018	18/01/2018	18/01/2018
Date Tested :	18/01/2018	18/01/2018	18/01/2018	18/01/2018
Material Type :	Bulk Fill	Bulk Fill	Bulk Fill	Bulk Fill
Material Source :	On Site	On Site	On Site	On Site
Lot Number :	-	-	-	-
Sample Location :	E 484079.689 N 6939748.415 RL 79.404	E 484102.335 N 6939658.260 RL 84.137	E 484114.725 N 6939704.726 RL 81.890	E 484112.507 N 6939723.162 RL 81.198
Test Depth (mm) :	150	150	150	150
Layer Depth (mm) :	-	-	-	-
Maximum Size (mm) :	19	19	19	19
Oversize Wet (%) :	-	-	-	-
Oversize Dry (%) :	-	-	-	-
Oversize Density (t/m ³) :	-	-	-	-
Field Moisture Content (%) :	17.1	16.4	18.6	16.3
Hilf MDR Number :	240617	240618	240619	240620
Hilf MDR Method :	AS1289.5.1.1 & 5.7.1	AS1289.5.1.1 & 5.7.1	AS1289.5.1.1 & 5.7.1	AS1289.5.1.1 & 5.7.1
Compactive Effort :	Standard	Standard	Standard	Standard
Field Density Method :	AS1289.5.8.1 & 5.7.1	AS1289.5.8.1 & 5.7.1	AS1289.5.8.1 & 5.7.1	AS1289.5.8.1 & 5.7.1
Moisture Method :	AS1289.2.1.1	AS1289.2.1.1	AS1289.2.1.1	AS1289.2.1.1
Moisture Ratio (%) :	102	89.5	101	89.5
Field Wet Density (t/m ³) :	1.868	1.945	1.798	1.723
Optimum Moisture Content (%) :	16.8	18.4	18.4	18.2
Moisture Variation :	-0.4	1.9	-0.1	2.1
Peak Converted Wet Density (t/m ³) :	1.927	2.005	1.845	1.723
Hilf Density Ratio (%) :	97.0	97.0	97.5	100.0
Minimum Specification :	95	95	95	95
Moisture Specification :	+ or - 2%	+ or - 2%	+ or - 2%	+ or - 2%
Site Selection :	-	-	-	-
Soil Description :	-	-	-	-
Remarks :	-			



Accredited for compliance with ISO/IEC 17025.

APPROVED SIGNATORY

Liam A Mcdowall

Liam Mcdowall (Brisbane) - Branch Manager
NATA Accreditation Number
1162 / 1169



Hilf Density Ratio Report

Client :	CCA WINSLOW	Report Number:	DL17/398 - 34
Address :	1587 IPSWICH ROAD, ROCKLEA, QLD, 4106	Report Date :	30/01/2018
Project Name :	EARTHWORKS SUPERVISION	Order Number :	33832
Project Number :	DL17/398	Test Method :	AS1289.5.8.1 & 5.7.1
Location:	EDEN'S CROSSING , FUTURE STAGES 15-20	Page 1 of 1	

Sample Number :	240621		
Test Number :	99		
Sampling Method :	-		
Date Sampled :	18/01/2018		
Date Tested :	18/01/2018		
Material Type :	Bulk Fill		
Material Source :	On Site		
Lot Number :	-		
Sample Location :	E 484090.691 N 6939669.865 RL 83.227		
Test Depth (mm) :	150		
Layer Depth (mm) :	-		
Maximum Size (mm) :	19		
Oversize Wet (%) :	-		
Oversize Dry (%) :	-		
Oversize Density (t/m ³) :	-		
Field Moisture Content (%) :	31.1		
Hilf MDR Number :	240621		
Hilf MDR Method :	AS1289.5.1.1 & 5.7.1		
Compactive Effort :	Standard		
Field Density Method :	AS1289.5.8.1 & 5.7.1		
Moisture Method :	AS1289.2.1.1		
Moisture Ratio (%) :	93.5		
Field Wet Density (t/m ³) :	1.784		
Optimum Moisture Content (%) :	33.2		
Moisture Variation :	2.1		
Peak Converted Wet Density (t/m ³) :	1.760		
Hilf Density Ratio (%) :	101.5		
Minimum Specification :	95		
Moisture Specification :	+ or - 2%		
Site Selection :	-		
Soil Description :	-		
Remarks :	-		



Accredited for compliance with ISO/IEC 17025.

APPROVED SIGNATORY

Liam A McOwall

Liam Mcdowall (Brisbane) - Branch Manager
NATA Accreditation Number
1162 / 1169



MORRISON
GEOTECHNIC

Brisbane | Gold Coast | Maroochydore
Unit 1, 35 Limestone Street (PO Box 3063), Darra Q 4076 P (07) 3279 0900 F (07) 3279 0955
ABN: 51 009 878 899
www.morrisonge.com.au

Hilf Density Ratio Report

Client :	CCA WINSLOW	Report Number:	DL17/398 - 37
Address :	1587 IPSWICH ROAD, ROCKLEA, QLD, 4106	Report Date :	02/02/2018
Project Name :	EARTHWORKS SUPERVISION	Order Number :	36008
Project Number :	DL17/398	Test Method :	AS1289.5.8.1 & 5.7.1
Location:	EDEN'S CROSSING , FUTURE STAGES 15-20	Page 1 of 1	

Sample Number :	240713	240714	240715	240716
Test Number :	104	105	106	107
Sampling Method :	-	-	-	-
Date Sampled :	20/01/2018	20/01/2018	20/01/2018	20/01/2018
Date Tested :	20/01/2018	20/01/2018	20/01/2018	20/01/2018
Material Type :	Bulk Fill	Bulk Fill	Bulk Fill	Bulk Fill
Material Source :	On Site	On Site	On Site	On Site
Lot Number :	-	-	-	-
Sample Location :	E 484101.557 N 6939663.149 RL 84.439	E 484100.366 N 6939687.176 RL 83.084	E 484097.825 N 6939711.150 RL 81.889	E 484107.216 N 6939741.157 RL 80.663
Test Depth (mm) :	150	150	150	150
Layer Depth (mm) :	-	-	-	-
Maximum Size (mm) :	19	19	19	19
Oversize Wet (%) :	-	-	-	-
Oversize Dry (%) :	-	-	-	-
Oversize Density (t/m ³) :	-	-	-	-
Field Moisture Content (%) :	17.4	17.6	17.0	16.3
Hilf MDR Number :	240713	240714	240715	240716
Hilf MDR Method :	AS1289.5.1.1 & 5.7.1	AS1289.5.1.1 & 5.7.1	AS1289.5.1.1 & 5.7.1	AS1289.5.1.1 & 5.7.1
Compactive Effort :	Standard	Standard	Standard	Standard
Field Density Method :	AS1289.5.8.1 & 5.7.1	AS1289.5.8.1 & 5.7.1	AS1289.5.8.1 & 5.7.1	AS1289.5.8.1 & 5.7.1
Moisture Method :	AS1289.2.1.1	AS1289.2.1.1	AS1289.2.1.1	AS1289.2.1.1
Moisture Ratio (%) :	99.5	90	98	89.5
Field Wet Density (t/m ³) :	1.989	1.985	1.929	1.981
Optimum Moisture Content (%) :	17.5	19.6	17.4	18.3
Moisture Variation :	0.1	1.9	0.3	1.9
Peak Converted Wet Density (t/m ³) :	2.032	1.990	2.020	2.017
Hilf Density Ratio (%) :	98.0	100.0	95.5	98.0
Minimum Specification :	95	95	95	95
Moisture Specification :	+ or - 2%	+ or - 2%	+ or - 2%	+ or - 2%
Site Selection :	-	-	-	-
Soil Description :	-	-	-	-
Remarks :	-			



Accredited for compliance with ISO/IEC 17025.

APPROVED SIGNATORY

Liam A Mcdowall

Liam Mcdowall (Brisbane) - Branch Manager
NATA Accreditation Number
1162 / 1169

Document Code RF89-11



MORRISON
GEOTECHNIC

Brisbane | Gold Coast | Maroochydore
Unit 1, 35 Limestone Street (PO Box 3063), Darra Q 4076 P (07) 3279 0900 F (07) 3279 0955
ABN: 51 009 878 899
www.morrisonge.com.au

Hilf Density Ratio Report

Client :	CCA WINSLOW	Report Number:	DL17/398 - 39
Address :	1587 IPSWICH ROAD, ROCKLEA, QLD, 4106	Report Date :	02/02/2018
Project Name :	EARTHWORKS SUPERVISION	Order Number :	36008
Project Number :	DL17/398	Test Method :	AS1289.5.8.1 & 5.7.1
Location:	EDEN'S CROSSING , FUTURE STAGES 15-20	Page 1 of 1	

Sample Number :	240769	240770	240771	240773
Test Number :	110	111	112	113
Sampling Method :	-	-	-	-
Date Sampled :	22/01/2018	22/01/2018	22/01/2018	22/01/2018
Date Tested :	22/01/2018	22/01/2018	22/01/2018	22/01/2018
Material Type :	Bulk Fill	Bulk Fill	Bulk Fill	Bulk Fill
Material Source :	On Site	On Site	On Site	On Site
Lot Number :	-	-	-	-
Sample Location :	E 484040.961 N 6939665.243 RL 82.814	E 484049.496 N 6939686.665 RL 81.974	E 484061.450 N 6939680.185 RL 82.373	E 484084.971 N 6939676.107 RL 83.367
Test Depth (mm) :	150	150	150	150
Layer Depth (mm) :	-	-	-	-
Maximum Size (mm) :	19	19	19	19
Oversize Wet (%) :	-	-	-	-
Oversize Dry (%) :	-	-	-	-
Oversize Density (t/m ³) :	-	-	-	-
Field Moisture Content (%) :	13.6	15.3	14.3	17.0
Hilf MDR Number :	240769	240770	240771	240773
Hilf MDR Method :	AS1289.5.1.1 & 5.7.1	AS1289.5.1.1 & 5.7.1	AS1289.5.1.1 & 5.7.1	AS1289.5.1.1 & 5.7.1
Compactive Effort :	Standard	Standard	Standard	Standard
Field Density Method :	AS1289.5.8.1 & 5.7.1	AS1289.5.8.1 & 5.7.1	AS1289.5.8.1 & 5.7.1	AS1289.5.8.1 & 5.7.1
Moisture Method :	AS1289.2.1.1	AS1289.2.1.1	AS1289.2.1.1	AS1289.2.1.1
Moisture Ratio (%) :	99	97.5	96.5	98.5
Field Wet Density (t/m ³) :	2.043	1.943	1.971	1.862
Optimum Moisture Content (%) :	13.7	15.7	14.8	17.2
Moisture Variation :	0.1	0.4	0.5	0.2
Peak Converted Wet Density (t/m ³) :	2.088	1.986	2.028	1.912
Hilf Density Ratio (%) :	98.0	98.0	97.0	97.5
Minimum Specification :	95	95	95	95
Moisture Specification :	+ or - 2%	+ or - 2%	+ or - 2%	+ or - 2%
Site Selection :	-	-	-	-
Soil Description :	-	-	-	-
Remarks :	-			



Accredited for compliance with ISO/IEC 17025.

APPROVED SIGNATORY

Liam A Mcdowall

Liam Mcdowall (Brisbane) - Branch Manager
NATA Accreditation Number
1162 / 1169

Document Code RF89-11



MORRISON
GEOTECHNIC

Brisbane | Gold Coast | Maroochydore
Unit 1, 35 Limestone Street (PO Box 3063), Darra Q 4076 P (07) 3279 0900 F (07) 3279 0955
ABN: 51 009 878 899
www.morrisonge.com.au

Hilf Density Ratio Report

Client :	CCA WINSLOW	Report Number:	DL17/398 - 40
Address :	1587 IPSWICH ROAD, ROCKLEA, QLD, 4106	Report Date :	02/02/2018
Project Name :	EARTHWORKS SUPERVISION	Order Number :	36008
Project Number :	DL17/398	Test Method :	AS1289.5.8.1 & 5.7.1
Location:	EDEN'S CROSSING , FUTURE STAGES 15-20	Page 1 of 1	

Sample Number :	240774	240775	
Test Number :	114	115	
Sampling Method :	-	-	
Date Sampled :	22/01/2018	22/01/2018	
Date Tested :	22/01/2018	22/01/2018	
Material Type :	Bulk Fill	Bulk Fill	
Material Source :	On Site	On Site	
Lot Number :	-	-	
Sample Location :	E 484097.518 N 6939708.992 RL 82.229	E 484114.965 N 6939713.288 RL 82.575	
Test Depth (mm) :	150	150	
Layer Depth (mm) :	-	-	
Maximum Size (mm) :	19	19	
Oversize Wet (%) :	-	-	
Oversize Dry (%) :	-	-	
Oversize Density (t/m ³) :	-	-	
Field Moisture Content (%) :	16.4	18.0	
Hilf MDR Number :	240774	240775	
Hilf MDR Method :	AS1289.5.1.1 & 5.7.1	AS1289.5.1.1 & 5.7.1	
Compactive Effort :	Standard	Standard	
Field Density Method :	AS1289.5.8.1 & 5.7.1	AS1289.5.8.1 & 5.7.1	
Moisture Method :	AS1289.2.1.1	AS1289.2.1.1	
Moisture Ratio (%) :	100	102.5	
Field Wet Density (t/m ³) :	1.900	1.851	
Optimum Moisture Content (%) :	16.4	17.5	
Moisture Variation :	0.0	-0.5	
Peak Converted Wet Density (t/m ³) :	1.948	1.950	
Hilf Density Ratio (%) :	97.5	95.0	
Minimum Specification :	95	95	
Moisture Specification :	+ or - 2%	+ or - 2%	
Site Selection :	-	-	
Soil Description :	-	-	
Remarks :	-		



Accredited for compliance with ISO/IEC 17025.

APPROVED SIGNATORY

Liam A Mcdowall

Liam Mcdowall (Brisbane) - Branch Manager
NATA Accreditation Number
1162 / 1169

Document Code RF89-11



Hilf Density Ratio Report

Client :	CCA WINSLOW	Report Number:	DL17/398 - 42
Address :	1587 IPSWICH ROAD, ROCKLEA, QLD, 4106	Report Date :	19/02/2018
Project Name :	EARTHWORKS SUPERVISION	Order Number :	37618
Project Number :	DL17/398	Test Method :	AS1289.5.8.1 & 5.7.1
Location:	EDEN'S CROSSING , FUTURE STAGES 15-20	Page 1 of 1	

Sample Number :	241372	241373	241374	
Test Number :	118	119	120	
Sampling Method :	-	-	-	
Date Sampled :	05/02/2018	05/02/2018	05/02/2018	
Date Tested :	05/02/2018	05/02/2018	05/02/2018	
Material Type :	Bulk Fill	Bulk Fill	Bulk Fill	
Material Source :	On Site	On Site	On Site	
Lot Number :	-	-	-	
Sample Location :	E 484055.395 N 6939664.870 RL 83.126 Retest of Field Density No. 116 on the 22/01/18	E 484099.284 N 6939722.691 RL 81.154 Retest of Field Density No. 103 on the 19/01/18	E 484102.743 N 6939679.343 RL 83.961 Retest of Field Density No. 117 on the 22/01/18	
Test Depth (mm) :	150	150	150	
Layer Depth (mm) :	-	-	-	
Maximum Size (mm) :	19	19	19	
Oversize Wet (%) :	-	-	-	
Oversize Dry (%) :	-	-	-	
Oversize Density (t/m ³) :	-	-	-	
Field Moisture Content (%) :	20.8	24.0	22.3	
Hilf MDR Number :	241372	241373	241374	
Hilf MDR Method :	AS1289.5.1.1 & 5.7.1	AS1289.5.1.1 & 5.7.1	AS1289.5.1.1 & 5.7.1	
Compactive Effort :	Standard	Standard	Standard	
Field Density Method :	AS1289.5.8.1 & 5.7.1	AS1289.5.8.1 & 5.7.1	AS1289.5.8.1 & 5.7.1	
Moisture Method :	AS1289.2.1.1	AS1289.2.1.1	AS1289.2.1.1	
Moisture Ratio (%) :	99	98	110	
Field Wet Density (t/m ³) :	2.027	1.976	2.045	
Optimum Moisture Content (%) :	21.0	24.4	20.2	
Moisture Variation :	0.2	0.5	-2.0	
Peak Converted Wet Density (t/m ³) :	2.027	2.018	2.077	
Hilf Density Ratio (%) :	100.0	98.0	98.5	
Minimum Specification :	95	95	95	
Moisture Specification :	+ or - 2%	+ or - 2%	+ or - 2%	
Site Selection :	-	-	-	
Soil Description :	-	-	-	
Remarks :	-			



Accredited for compliance with ISO/IEC 17025.

APPROVED SIGNATORY

Liam A Mcdowall

Liam Mcdowall (Brisbane) - Branch Manager
NATA Accreditation Number
1162 / 1169



MORRISON
GEOTECHNIC

Brisbane | Gold Coast | Maroochydore
Unit 1, 35 Limestone Street (PO Box 3063), Darra Q 4076 P (07) 3279 0900 F (07) 3279 0955
ABN: 51 009 878 899
www.morrisonge.com.au

Hilf Density Ratio Report

Client :	CCA WINSLOW	Report Number:	DL17/398 - 43
Address :	1587 IPSWICH ROAD, ROCKLEA, QLD, 4106	Report Date :	19/02/2018
Project Name :	EARTHWORKS SUPERVISION	Order Number :	37618
Project Number :	DL17/398	Test Method :	AS1289.5.8.1 & 5.7.1
Location:	EDEN'S CROSSING , FUTURE STAGES 15-20	Page 1 of 1	

Sample Number :	241480	241481	241482	241483
Test Number :	121	122	123	124
Sampling Method :	-	-	-	-
Date Sampled :	06/02/2018	06/02/2018	06/02/2018	06/02/2018
Date Tested :	06/02/2018	06/02/2018	06/02/2018	06/02/2018
Material Type :	Bulk Fill	Bulk Fill	Bulk Fill	Bulk Fill
Material Source :	On Site	On Site	On Site	On Site
Lot Number :	-	-	-	-
Sample Location :	E 484144.525 N 6939711.400 RL 83.830	E 484127.770 N 6939687.884 RL 84.592	E 484152.870 N 6939705.726 RL 84.269	E 484136.117 N 6939660.155 RL 85.274
Test Depth (mm) :	150	150	150	150
Layer Depth (mm) :	-	-	-	-
Maximum Size (mm) :	19	19	19	19
Oversize Wet (%) :	-	-	-	-
Oversize Dry (%) :	-	-	-	-
Oversize Density (t/m ³) :	-	-	-	-
Field Moisture Content (%) :	22.8	26.9	22.5	21.9
Hilf MDR Number :	241480	241481	241482	241483
Hilf MDR Method :	AS1289.5.1.1 & 5.7.1	AS1289.5.1.1 & 5.7.1	AS1289.5.1.1 & 5.7.1	AS1289.5.1.1 & 5.7.1
Compactive Effort :	Standard	Standard	Standard	Standard
Field Density Method :	AS1289.5.8.1 & 5.7.1	AS1289.5.8.1 & 5.7.1	AS1289.5.8.1 & 5.7.1	AS1289.5.8.1 & 5.7.1
Moisture Method :	AS1289.2.1.1	AS1289.2.1.1	AS1289.2.1.1	AS1289.2.1.1
Moisture Ratio (%) :	110	107.5	93.5	99.5
Field Wet Density (t/m ³) :	1.986	1.905	1.971	2.039
Optimum Moisture Content (%) :	20.8	25.0	24.1	22.0
Moisture Variation :	-2.0	-1.8	1.5	0.1
Peak Converted Wet Density (t/m ³) :	2.041	1.962	1.916	1.998
Hilf Density Ratio (%) :	97.5	97.0	103.0	102.0
Minimum Specification :	95	95	95	95
Moisture Specification :	-	-	-	-
Site Selection :	-	-	-	-
Soil Description :	-	-	-	-
Remarks :	-			



Accredited for compliance with ISO/IEC 17025.

APPROVED SIGNATORY

Liam A Mcdowall

Liam Mcdowall (Brisbane) - Branch Manager
NATA Accreditation Number
1162 / 1169

Document Code RF89-11


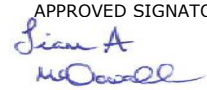


Hilf Density Ratio Report

Client :	CCA WINSLOW	Report Number:	DL17/398 - 44
Address :	1587 IPSWICH ROAD, ROCKLEA, QLD, 4106	Report Date :	19/02/2018
Project Name :	EARTHWORKS SUPERVISION	Order Number :	37618
Project Number :	DL17/398	Test Method :	AS1289.5.8.1 & 5.7.1
Location:	EDEN'S CROSSING , FUTURE STAGES 15-20	Page 1 of 1	

Sample Number :	241565	241566	241567	241568
Test Number :	125	126	127	128
Sampling Method :	-	-	-	-
Date Sampled :	07/02/2018	07/02/2018	07/02/2018	07/02/2018
Date Tested :	07/02/2018	07/02/2018	07/02/2018	07/02/2018
Material Type :	Bulk Fill	Bulk Fill	Bulk Fill	Bulk Fill
Material Source :	On Site	On Site	On Site	On Site
Lot Number :	-	-	-	-
Sample Location :	E 484070.766 N 6939745.705 RL 80.615	E 484050.747 N 6939692.243 RL 82.658	E 484103.084 N 6939728.645 RL 82.202	E 484085.407 N 6939688.985 RL 83.632
Test Depth (mm) :	150	150	150	150
Layer Depth (mm) :	-	-	-	-
Maximum Size (mm) :	19	19	19	19
Oversize Wet (%) :	-	-	8	-
Oversize Dry (%) :	-	-	-	-
Oversize Density (t/m ³) :	-	-	2.404	-
Field Moisture Content (%) :	22.0	13.8	16.6	16.0
Hilf MDR Number :	241565	241566	241567	241568
Hilf MDR Method :	AS1289.5.1.1 & 5.7.1	AS1289.5.1.1 & 5.7.1	AS1289.5.1.1 & 5.7.1	AS1289.5.1.1 & 5.7.1
Compactive Effort :	Standard	Standard	Standard	Standard
Field Density Method :	AS1289.5.8.1 & 5.7.1	AS1289.5.8.1 & 5.7.1	AS1289.5.8.1 & 5.7.1	AS1289.5.8.1 & 5.7.1
Moisture Method :	AS1289.2.1.1	AS1289.2.1.1	AS1289.2.1.1	AS1289.2.1.1
Moisture Ratio (%) :	89	86.5	87.5	86.5
Field Wet Density (t/m ³) :	2.066	2.077	2.121	2.043
Optimum Moisture Content (%) :	24.7	16.0	18.9	18.5
Moisture Variation :	2.4	2.1	2.2	2.3
Peak Converted Wet Density (t/m ³) :	2.107	2.126	2.165*	2.116
Hilf Density Ratio (%) :	98.0	97.5	98.0	96.5
Minimum Specification :	95	95	95	95
Moisture Specification :	-	-	-	-
Site Selection :	-	-	-	-
Soil Description :	-	-	-	-
Remarks :	-			

* - denotes adjusted for oversize

 Accredited for compliance with ISO/IEC 17025.	<p>APPROVED SIGNATORY</p>  Liam Mcdowall (Brisbane) - Branch Manager NATA Accreditation Number 1162 / 1169
---	---



Hilf Density Ratio Report

Client :	CCA WINSLOW	Report Number:	DL17/398 - 45
Address :	1587 IPSWICH ROAD, ROCKLEA, QLD, 4106	Report Date :	19/02/2018
Project Name :	EARTHWORKS SUPERVISION	Order Number :	37618
Project Number :	DL17/398	Test Method :	AS1289.5.8.1 & 5.7.1
Location:	EDEN'S CROSSING , FUTURE STAGES 15-20	Page 1 of 1	

Sample Number :	241569	241570	
Test Number :	129	130	
Sampling Method :	-	-	
Date Sampled :	07/02/2018	07/02/2018	
Date Tested :	07/02/2018	07/02/2018	
Material Type :	Bulk Fill	Bulk Fill	
Material Source :	On Site	On Site	
Lot Number :	-	-	
Sample Location :	E 484156.520 N 6939725.484 RL 83.981	E 484140.955 N 6939704.904 RL 84.480	
Test Depth (mm) :	150	150	
Layer Depth (mm) :	-	-	
Maximum Size (mm) :	19	19	
Oversize Wet (%) :	-	-	
Oversize Dry (%) :	-	-	
Oversize Density (t/m ³) :	-	-	
Field Moisture Content (%) :	16.1	18.2	
Hilf MDR Number :	241569	241570	
Hilf MDR Method :	AS1289.5.1.1 & 5.7.1	AS1289.5.1.1 & 5.7.1	
Compactive Effort :	Standard	Standard	
Field Density Method :	AS1289.5.8.1 & 5.7.1	AS1289.5.8.1 & 5.7.1	
Moisture Method :	AS1289.2.1.1	AS1289.2.1.1	
Moisture Ratio (%) :	90	89	
Field Wet Density (t/m ³) :	2.142	2.081	
Optimum Moisture Content (%) :	17.9	20.4	
Moisture Variation :	1.8	2.1	
Peak Converted Wet Density (t/m ³) :	2.120	2.057	
Hilf Density Ratio (%) :	101.0	101.0	
Minimum Specification :	95	95	
Moisture Specification :	-	-	
Site Selection :	-	-	
Soil Description :	-	-	
Remarks :	-		



Accredited for compliance with ISO/IEC 17025.

APPROVED SIGNATORY

Liam A Mcdowall

Liam Mcdowall (Brisbane) - Branch Manager
NATA Accreditation Number
1162 / 1169



MORRISON
GEOTECHNIC

Brisbane | Gold Coast | Maroochydore
Unit 1, 35 Limestone Street (PO Box 3063), Darra Q 4076 P (07) 3279 0900 F (07) 3279 0955
ABN: 51 009 878 899
www.morrisonge.com.au

Hilf Density Ratio Report

Client :	CCA WINSLOW	Report Number:	DL17/398 - 55
Address :	1587 IPSWICH ROAD, ROCKLEA, QLD, 4106	Report Date :	02/03/2018
Project Name :	EARTHWORKS SUPERVISION	Order Number :	37618
Project Number :	DL17/398	Test Method :	AS1289.5.8.1 & 5.7.1
Location:	EDEN'S CROSSING , FUTURE STAGES 15-20	Page 1 of 1	

Sample Number :	241924	241925	241926	241927
Test Number :	160	161	162	163
Sampling Method :	-	-	-	-
Date Sampled :	15/02/2018	15/02/2018	15/02/2018	15/02/2018
Date Tested :	15/02/2018	15/02/2018	15/02/2018	15/02/2018
Material Type :	Bulk Fill	Bulk Fill	Bulk Fill	Bulk Fill
Material Source :	On Site	On Site	On Site	On Site
Lot Number :	-	-	-	-
Sample Location :	E 484130.335 N 6939790.489 RL 80.337	E 484124.203 N 6939768.003 RL 80.223	E 484127.601 N 6939826.029 RL 80.571	E 484115.940 N 6939776.213 RL 80.083
Test Depth (mm) :	150	150	150	150
Layer Depth (mm) :	-	-	-	-
Maximum Size (mm) :	19	19	19	19
Oversize Wet (%) :	-	-	-	-
Oversize Dry (%) :	-	-	-	-
Oversize Density (t/m ³) :	-	-	-	-
Field Moisture Content (%) :	21.8	12.2	22.4	19.0
Hilf MDR Number :	241924	241925	241926	241927
Hilf MDR Method :	AS1289.5.1.1 & 5.7.1	AS1289.5.1.1 & 5.7.1	AS1289.5.1.1 & 5.7.1	AS1289.5.1.1 & 5.7.1
Compactive Effort :	Standard	Standard	Standard	Standard
Field Density Method :	AS1289.5.8.1 & 5.7.1	AS1289.5.8.1 & 5.7.1	AS1289.5.8.1 & 5.7.1	AS1289.5.8.1 & 5.7.1
Moisture Method :	AS1289.2.1.1	AS1289.2.1.1	AS1289.2.1.1	AS1289.2.1.1
Moisture Ratio (%) :	99	98	91	100
Field Wet Density (t/m ³) :	1.985	1.934	2.070	1.931
Optimum Moisture Content (%) :	22.0	12.4	24.6	19.0
Moisture Variation :	0.2	0.2	2.0	0.0
Peak Converted Wet Density (t/m ³) :	1.951	1.899	2.007	1.974
Hilf Density Ratio (%) :	101.5	102.0	103.0	98.0
Minimum Specification :	95	95	95	95
Moisture Specification :	+ or - 2%	+ or - 2%	+ or - 2%	+ or - 2%
Site Selection :	-	-	-	-
Soil Description :	-	-	-	-
Remarks :	-			



Accredited for compliance with ISO/IEC 17025 - Testing.

APPROVED SIGNATORY

Liam A Mcdowall

Liam Mcdowall (Brisbane) - Branch Manager
NATA Accreditation Number
1162 / 1169

Document Code RF89-11



Hilf Density Ratio Report

Client :	CCA WINSLOW	Report Number:	DL17/398 - 47
Address :	1587 IPSWICH ROAD, ROCKLEA, QLD, 4106	Report Date :	19/02/2018
Project Name :	EARTHWORKS SUPERVISION	Order Number :	37618
Project Number :	DL17/398	Test Method :	AS1289.5.8.1 & 5.7.1
Location:	EDEN'S CROSSING , FUTURE STAGES 15-20	Page 1 of 1	

Sample Number :	241620	241621	241622	241623
Test Number :	135	136	137	138
Sampling Method :	-	-	-	-
Date Sampled :	08/02/2018	08/02/2018	08/02/2018	08/02/2018
Date Tested :	08/02/2018	08/02/2018	08/02/2018	08/02/2018
Material Type :	Bulk Fill	Bulk Fill	Bulk Fill	Bulk Fill
Material Source :	On Site	On Site	On Site	On Site
Lot Number :	-	-	-	-
Sample Location :	E 484108.544 N 6939702.552 RL 84.080	E 484101.619 N 6939709.857 RL 83.630	E 484115.252 N 6939722.539 RL 83.319	E 484117.204 N 6939742.052 RL 82.150
Test Depth (mm) :	150	150	150	150
Layer Depth (mm) :	-	-	-	-
Maximum Size (mm) :	19	19	19	19
Oversize Wet (%) :	-	-	-	-
Oversize Dry (%) :	-	-	-	-
Oversize Density (t/m ³) :	-	-	-	-
Field Moisture Content (%) :	21.2	18.3	14.8	31.1
Hilf MDR Number :	241620	241621	241622	241623
Hilf MDR Method :	AS1289.5.1.1 & 5.7.1	AS1289.5.1.1 & 5.7.1	AS1289.5.1.1 & 5.7.1	AS1289.5.1.1 & 5.7.1
Compactive Effort :	Standard	Standard	Standard	Standard
Field Density Method :	AS1289.5.8.1 & 5.7.1	AS1289.5.8.1 & 5.7.1	AS1289.5.8.1 & 5.7.1	AS1289.5.8.1 & 5.7.1
Moisture Method :	AS1289.2.1.1	AS1289.2.1.1	AS1289.2.1.1	AS1289.2.1.1
Moisture Ratio (%) :	100.5	99.5	101	100.5
Field Wet Density (t/m ³) :	2.090	2.149	1.985	1.903
Optimum Moisture Content (%) :	21.1	18.4	14.6	31.0
Moisture Variation :	-0.1	0.0	-0.1	-0.1
Peak Converted Wet Density (t/m ³) :	2.062	2.089	1.999	1.904
Hilf Density Ratio (%) :	101.5	103.0	99.5	100.0
Minimum Specification :	95	95	95	95
Moisture Specification :	+ or - 2%	+ or - 2%	+ or - 2%	+ or - 2%
Site Selection :	-	-	-	-
Soil Description :	-	-	-	-
Remarks :	-			



Accredited for compliance with ISO/IEC 17025.

APPROVED SIGNATORY

Liam A Mcdowall

Liam Mcdowall (Brisbane) - Branch Manager
NATA Accreditation Number
1162 / 1169



Hilf Density Ratio Report

Client :	CCA WINSLOW	Report Number:	DL17/398 - 51
Address :	1587 IPSWICH ROAD, ROCKLEA, QLD, 4106	Report Date :	22/02/2018
Project Name :	EARTHWORKS SUPERVISION	Order Number :	37618
Project Number :	DL17/398	Test Method :	AS1289.5.8.1 & 5.7.1
Location:	EDEN'S CROSSING , FUTURE STAGES 15-20	Page 1 of 1	

Sample Number :	241766	241767	
Test Number :	148	149	
Sampling Method :	-	-	
Date Sampled :	13/02/2018	13/02/2018	
Date Tested :	13/02/2018	13/02/2018	
Material Type :	Bulk Fill	Bulk Fill	
Material Source :	On Site	On Site	
Lot Number :	-	-	
Sample Location :	E 484032.190 N 6939683.009 RL 82.780	E 484036.405 N 6939658.874 RL 82.746	
Test Depth (mm) :	150	150	
Layer Depth (mm) :	-	-	
Maximum Size (mm) :	19	19	
Oversize Wet (%) :	-	-	
Oversize Dry (%) :	-	-	
Oversize Density (t/m ³) :	-	-	
Field Moisture Content (%) :	20.7	22.5	
Hilf MDR Number :	241766	241767	
Hilf MDR Method :	AS1289.5.1.1 & 5.7.1	AS1289.5.1.1 & 5.7.1	
Compactive Effort :	Standard	Standard	
Field Density Method :	AS1289.5.8.1 & 5.7.1	AS1289.5.8.1 & 5.7.1	
Moisture Method :	AS1289.2.1.1	AS1289.2.1.1	
Moisture Ratio (%) :	101	100.5	
Field Wet Density (t/m ³) :	2.004	2.049	
Optimum Moisture Content (%) :	20.5	22.4	
Moisture Variation :	-0.2	-0.1	
Peak Converted Wet Density (t/m ³) :	2.027	2.061	
Hilf Density Ratio (%) :	99.0	99.5	
Minimum Specification :	95	95	
Moisture Specification :	+ or - 2%	+ or - 2%	
Site Selection :	-	-	
Soil Description :	-	-	
Remarks :	-		



Accredited for compliance with ISO/IEC 17025.

APPROVED SIGNATORY

Liam A McOwall

Liam Mcdowall (Brisbane) - Branch Manager
NATA Accreditation Number
1162 / 1169



MORRISON
GEOTECHNIC

Brisbane | Gold Coast | Maroochydore
Unit 1, 35 Limestone Street (PO Box 3063), Darra Q 4076 P (07) 3279 0900 F (07) 3279 0955
ABN: 51 009 878 899
www.morrisonge.com.au

Hilf Density Ratio Report

Client :	CCA WINSLOW	Report Number:	DL17/398 - 54
Address :	1587 IPSWICH ROAD, ROCKLEA, QLD, 4106	Report Date :	02/03/2018
Project Name :	EARTHWORKS SUPERVISION	Order Number :	37618
Project Number :	DL17/398	Test Method :	AS1289.5.8.1 & 5.7.1
Location:	EDEN'S CROSSING , FUTURE STAGES 15-20	Page 1 of 1	

Sample Number :	241920	241921	241922	241923
Test Number :	156	157	158	159
Sampling Method :	-	-	-	-
Date Sampled :	15/02/2018	15/02/2018	15/02/2018	15/02/2018
Date Tested :	15/02/2018	15/02/2018	15/02/2018	15/02/2018
Material Type :	Bulk Fill	Bulk Fill	Bulk Fill	Bulk Fill
Material Source :	On Site	On Site	On Site	On Site
Lot Number :	-	-	-	-
Sample Location :	E 484095.817 N 6939777.059 RL 78.826	E 484107.189 N 6939798.327 RL 79.329	E 484113.853 N 6939826.323 RL 79.586	E 484135.285 N 6939821.787 RL 80.754
Test Depth (mm) :	150	150	150	150
Layer Depth (mm) :	-	-	-	-
Maximum Size (mm) :	19	19	19	19
Oversize Wet (%) :	-	-	-	-
Oversize Dry (%) :	-	-	-	-
Oversize Density (t/m ³) :	-	-	-	-
Field Moisture Content (%) :	21.8	23.0	22.4	14.2
Hilf MDR Number :	241920	241921	241922	241923
Hilf MDR Method :	AS1289.5.1.1 & 5.7.1	AS1289.5.1.1 & 5.7.1	AS1289.5.1.1 & 5.7.1	AS1289.5.1.1 & 5.7.1
Compactive Effort :	Standard	Standard	Standard	Standard
Field Density Method :	AS1289.5.8.1 & 5.7.1	AS1289.5.8.1 & 5.7.1	AS1289.5.8.1 & 5.7.1	AS1289.5.8.1 & 5.7.1
Moisture Method :	AS1289.2.1.1	AS1289.2.1.1	AS1289.2.1.1	AS1289.2.1.1
Moisture Ratio (%) :	91	100	100	100.5
Field Wet Density (t/m ³) :	2.045	2.033	1.910	1.989
Optimum Moisture Content (%) :	23.9	23.0	22.4	14.1
Moisture Variation :	2.0	0.0	0.0	-0.1
Peak Converted Wet Density (t/m ³) :	1.978	2.025	1.897	1.998
Hilf Density Ratio (%) :	103.5	100.5	100.5	99.5
Minimum Specification :	95	95	95	95
Moisture Specification :	+ or - 2%	+ or - 2%	+ or - 2%	+ or - 2%
Site Selection :	-	-	-	-
Soil Description :	-	-	-	-
Remarks :	-			



Accredited for compliance with ISO/IEC 17025 - Testing.

APPROVED SIGNATORY

Liam A Mcdowall

Liam Mcdowall (Brisbane) - Branch Manager
NATA Accreditation Number
1162 / 1169

Document Code RF89-11



MORRISON
GEOTECHNIC

Brisbane | Gold Coast | Maroochydore
Unit 1, 35 Limestone Street (PO Box 3063), Darra Q 4076 P (07) 3279 0900 F (07) 3279 0955
ABN: 51 009 878 899
www.morrisonge.com.au

Hilf Density Ratio Report

Client :	CCA WINSLOW	Report Number:	DL17/398 - 53
Address :	1587 IPSWICH ROAD, ROCKLEA, QLD, 4106	Report Date :	02/03/2018
Project Name :	EARTHWORKS SUPERVISION	Order Number :	37618
Project Number :	DL17/398	Test Method :	AS1289.5.8.1 & 5.7.1
Location:	EDEN'S CROSSING , FUTURE STAGES 15-20	Page 1 of 1	

Sample Number :	241863	241864	
Test Number :	154	155	
Sampling Method :	-	-	
Date Sampled :	14/02/2018	14/02/2018	
Date Tested :	14/02/2018	14/02/2018	
Material Type :	Bulk Fill	Bulk Fill	
Material Source :	On Site	On Site	
Lot Number :	-	-	
Sample Location :	E 484112.477 N 6939796.696 RL 78.982	E 484119.137 N 6939821.305 RL 79.470	
Test Depth (mm) :	150	150	
Layer Depth (mm) :	-	-	
Maximum Size (mm) :	19	19	
Oversize Wet (%) :	-	-	
Oversize Dry (%) :	-	-	
Oversize Density (t/m ³) :	-	-	
Field Moisture Content (%) :	23.7	19.9	
Hilf MDR Number :	241863	241864	
Hilf MDR Method :	AS1289.5.1.1 & 5.7.1	AS1289.5.1.1 & 5.7.1	
Compactive Effort :	Standard	Standard	
Field Density Method :	AS1289.5.8.1 & 5.7.1	AS1289.5.8.1 & 5.7.1	
Moisture Method :	AS1289.2.1.1	AS1289.2.1.1	
Moisture Ratio (%) :	99.5	98.5	
Field Wet Density (t/m ³) :	1.984	2.125	
Optimum Moisture Content (%) :	23.8	20.2	
Moisture Variation :	0.1	0.2	
Peak Converted Wet Density (t/m ³) :	2.002	2.103	
Hilf Density Ratio (%) :	99.0	101.0	
Minimum Specification :	95	95	
Moisture Specification :	+ or - 2%	+ or - 2%	
Site Selection :	-	-	
Soil Description :	-	-	
Remarks :	-		



Accredited for compliance with ISO/IEC 17025 - Testing.

APPROVED SIGNATORY

Liam A Mcdowall

Liam Mcdowall (Brisbane) - Branch Manager
NATA Accreditation Number
1162 / 1169

Document Code RF89-11


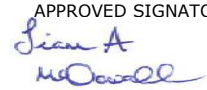


Hilf Density Ratio Report

Client :	CCA WINSLOW	Report Number:	DL17/398 - 59
Address :	1587 IPSWICH ROAD, ROCKLEA, QLD, 4106	Report Date :	08/03/2018
Project Name :	EARTHWORKS SUPERVISION	Order Number :	37618
Project Number :	DL17/398	Test Method :	AS1289.5.8.1 & 5.7.1
Location:	EDEN'S CROSSING , FUTURE STAGES 15-20	Page 1 of 1	

Sample Number :	242380	242381	242382	242383
Test Number :	176	177	178	179
Sampling Method :	-	-	-	-
Date Sampled :	01/03/2018	01/03/2018	01/03/2018	01/03/2018
Date Tested :	01/03/2018	01/03/2018	01/03/2018	01/03/2018
Material Type :	Bulk Fill	Bulk Fill	Bulk Fill	Bulk Fill
Material Source :	On Site	On Site	On Site	On Site
Lot Number :	-	-	-	-
Sample Location :	E 484156.272 N 6939753.617 RL 83.670	E 484138.775 N 6939816.052 RL 81.645	E 484131.150 N 6939793.32 RL 81.755	E 484122.814 N 6939761.151 RL 82.390
Test Depth (mm) :	150	150	150	150
Layer Depth (mm) :	150	150	150	150
Maximum Size (mm) :	19	19	19	19
Oversize Wet (%) :	-	-	13	-
Oversize Dry (%) :	-	-	-	-
Oversize Density (t/m ³) :	-	-	2.395	-
Field Moisture Content (%) :	16.0	20.3	19.8	18.1
Hilf MDR Number :	242380	242381	242382	242383
Hilf MDR Method :	AS1289.5.1.1 & 5.7.1	AS1289.5.1.1 & 5.7.1	AS1289.5.1.1 & 5.7.1	AS1289.5.1.1 & 5.7.1
Compactive Effort :	Standard	Standard	Standard	Standard
Field Density Method :	AS1289.5.8.1 & 5.7.1	AS1289.5.8.1 & 5.7.1	AS1289.5.8.1 & 5.7.1	AS1289.5.8.1 & 5.7.1
Moisture Method :	AS1289.2.1.1	AS1289.2.1.1	AS1289.2.1.1	AS1289.2.1.1
Moisture Ratio (%) :	95	97.5	96	99.5
Field Wet Density (t/m ³) :	2.135	2.033	2.171	2.083
Optimum Moisture Content (%) :	16.8	20.8	20.6	18.2
Moisture Variation :	0.8	0.5	0.8	0.1
Peak Converted Wet Density (t/m ³) :	2.137	2.005	2.093*	2.105
Hilf Density Ratio (%) :	100.0	101.5	103.5	99.0
Minimum Specification :	95	95	95	95
Moisture Specification :	+ or - 2%	+ or - 2%	+ or - 2%	+ or - 2%
Site Selection :	-	-	-	-
Soil Description :	Sandy Clay	Sandy Clay	Sandy Clay	Sandy Clay
Remarks :	-			

* - denotes adjusted for oversize

 Accredited for compliance with ISO/IEC 17025 - Testing.	APPROVED SIGNATORY  Liam Mcdowall (Brisbane) - Branch Manager NATA Accreditation Number 1162 / 1169
---	--



MORRISON
GEOTECHNIC

Brisbane | Gold Coast | Maroochydore
Unit 1, 35 Limestone Street (PO Box 3063), Darra Q 4076 P (07) 3279 0900 F (07) 3279 0955
ABN: 51 009 878 899
www.morrisonge.com.au

Hilf Density Ratio Report

Client :	CCA WINSLOW	Report Number:	DL17/398 - 63
Address :	1587 IPSWICH ROAD, ROCKLEA, QLD, 4106	Report Date :	08/03/2018
Project Name :	EARTHWORKS SUPERVISION	Order Number :	37618
Project Number :	DL17/398	Test Method :	AS1289.5.8.1 & 5.7.1
Location:	EDEN'S CROSSING , FUTURE STAGES 15-20	Page 1 of 1	

Sample Number :	242432	242433	242434	242435
Test Number :	189	190	191	192
Sampling Method :	-	-	-	-
Date Sampled :	03/03/2018	03/03/2018	03/03/2018	03/03/2018
Date Tested :	03/03/2018	03/03/2018	03/03/2018	03/03/2018
Material Type :	Bulk Fill	Bulk Fill	Bulk Fill	Bulk Fill
Material Source :	On Site	On Site	On Site	On Site
Lot Number :	-	-	-	-
Sample Location :	E 484125 N 6939880 RL 77.080	E 484120 N 6939951 RL 76.062	E 484109 N 6939928 RL 75.363	E 484115.655 N 6939851.725 RL 79.295
Test Depth (mm) :	150	150	150	150
Layer Depth (mm) :	150	150	150	150
Maximum Size (mm) :	19	19	19	19
Oversize Wet (%) :	-	-	-	-
Oversize Dry (%) :	-	-	-	-
Oversize Density (t/m ³) :	-	-	-	-
Field Moisture Content (%) :	17.7	19.2	21.9	13.0
Hilf MDR Number :	242432	242433	242434	242435
Hilf MDR Method :	AS1289.5.1.1 & 5.7.1	AS1289.5.1.1 & 5.7.1	AS1289.5.1.1 & 5.7.1	AS1289.5.1.1 & 5.7.1
Compactive Effort :	Standard	Standard	Standard	Standard
Field Density Method :	AS1289.5.8.1 & 5.7.1	AS1289.5.8.1 & 5.7.1	AS1289.5.8.1 & 5.7.1	AS1289.5.8.1 & 5.7.1
Moisture Method :	AS1289.2.1.1	AS1289.2.1.1	AS1289.2.1.1	AS1289.2.1.1
Moisture Ratio (%) :	98	91	92	88
Field Wet Density (t/m ³) :	2.057	2.011	2.031	2.045
Optimum Moisture Content (%) :	18.1	21.1	23.9	14.8
Moisture Variation :	0.3	1.8	1.8	1.8
Peak Converted Wet Density (t/m ³) :	2.112	2.029	1.978	2.047
Hilf Density Ratio (%) :	97.5	99.0	102.5	100.0
Minimum Specification :	95	95	95	95
Moisture Specification :	+ or - 2%	+ or - 2%	+ or - 2%	+ or - 2%
Site Selection :	-	-	-	-
Soil Description :	Sandy Clay	Sandy Clay	Sandy Clay	Sandy Clay
Remarks :	-			



Accredited for compliance with ISO/IEC 17025 - Testing.

APPROVED SIGNATORY

Liam A Mcdowall

Liam Mcdowall (Brisbane) - Branch Manager
NATA Accreditation Number
1162 / 1169

Document Code RF89-11


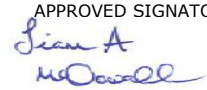


Hilf Density Ratio Report

Client :	CCA WINSLOW	Report Number:	DL17/398 - 65
Address :	1587 IPSWICH ROAD, ROCKLEA, QLD, 4106	Report Date :	14/03/2018
Project Name :	EARTHWORKS SUPERVISION	Order Number :	37618
Project Number :	DL17/398	Test Method :	AS1289.5.8.1 & 5.7.1
Location:	EDEN'S CROSSING , FUTURE STAGES 15-20	Page 1 of 1	

Sample Number :	242539	242540	242541	
Test Number :	197	198	199	
Sampling Method :	-	-	-	
Date Sampled :	12/03/2018	12/03/2018	12/03/2018	
Date Tested :	12/03/2018	12/03/2018	12/03/2018	
Material Type :	Bulk Fill	Bulk Fill	Bulk Fill	
Material Source :	On Site	On Site	On Site	
Lot Number :	-	-	-	
Sample Location :	E 484125.200 N 6939928.301 RL 77.144	E 484131.963 N 6939900.471 RL 78.505	E 484136.732 N 6939879.990 RL 79.515	
Test Depth (mm) :	150	150	150	
Layer Depth (mm) :	-	-	-	
Maximum Size (mm) :	19	19	19	
Oversize Wet (%) :	-	-	10	
Oversize Dry (%) :	-	-	-	
Oversize Density (t/m ³) :	-	-	2.552	
Field Moisture Content (%) :	25.0	28.1	19.1	
Hilf MDR Number :	242539	242540	242541	
Hilf MDR Method :	AS1289.5.1.1 & 5.7.1	AS1289.5.1.1 & 5.7.1	AS1289.5.1.1 & 5.7.1	
Compactive Effort :	Standard	Standard	Standard	
Field Density Method :	AS1289.5.8.1 & 5.7.1	AS1289.5.8.1 & 5.7.1	AS1289.5.8.1 & 5.7.1	
Moisture Method :	AS1289.2.1.1	AS1289.2.1.1	AS1289.2.1.1	
Moisture Ratio (%) :	103.5	100.5	100	
Field Wet Density (t/m ³) :	1.916	2.016	2.085	
Optimum Moisture Content (%) :	24.1	28.0	19.1	
Moisture Variation :	-0.8	-0.1	0.0	
Peak Converted Wet Density (t/m ³) :	2.009	2.026	2.061*	
Hilf Density Ratio (%) :	95.5	99.5	101.0	
Minimum Specification :	95	95	95	
Moisture Specification :	+ or - 2%	+ or - 2%	+ or - 2%	
Site Selection :	-	-	-	
Soil Description :	-	-	-	
Remarks :	-			

* - denotes adjusted for oversize

 Accredited for compliance with ISO/IEC 17025 - Testing.	<p>APPROVED SIGNATORY</p>  Liam Mcdowall (Brisbane) - Branch Manager NATA Accreditation Number 1162 / 1169
---	---



MORRISON
GEOTECHNIC

Brisbane | Gold Coast | Maroochydore
Unit 1, 35 Limestone Street (PO Box 3063), Darra Q 4076 P (07) 3279 0900 F (07) 3279 0955
ABN: 51 009 878 899
www.morrisonge.com.au

Hilf Density Ratio Report

Client :	CCA WINSLOW	Report Number:	DL17/398 - 67
Address :	1587 IPSWICH ROAD, ROCKLEA, QLD, 4106	Report Date :	15/03/2018
Project Name :	EARTHWORKS SUPERVISION	Order Number :	37618
Project Number :	DL17/398	Test Method :	AS1289.5.8.1 & 5.7.1
Location:	EDEN'S CROSSING , FUTURE STAGES 15-20	Page 1 of 1	

Sample Number :	242579	242580	242581	
Test Number :	204	205	206	
Sampling Method :	-	-	-	
Date Sampled :	13/03/2018	13/03/2018	13/03/2018	
Date Tested :	13/03/2018	13/03/2018	13/03/2018	
Material Type :	Bulk Fill	Bulk Fill	Bulk Fill	
Material Source :	On Site	On Site	On Site	
Lot Number :	-	-	-	
Sample Location :	E 484131.409 N 6939868.527 RL 80.072	E 484130.609 N 6939864.017 RL 80.280	E 484131.842 N 6939876.400 RL 79.591	
Test Depth (mm) :	150	150	150	
Layer Depth (mm) :	-	-	-	
Maximum Size (mm) :	19	19	19	
Oversize Wet (%) :	-	-	-	
Oversize Dry (%) :	-	-	-	
Oversize Density (t/m ³) :	-	-	-	
Field Moisture Content (%) :	21.3	19.1	24.0	
Hilf MDR Number :	242579	242580	242581	
Hilf MDR Method :	AS1289.5.1.1 & 5.7.1	AS1289.5.1.1 & 5.7.1	AS1289.5.1.1 & 5.7.1	
Compactive Effort :	Standard	Standard	Standard	
Field Density Method :	AS1289.5.8.1 & 5.7.1	AS1289.5.8.1 & 5.7.1	AS1289.5.8.1 & 5.7.1	
Moisture Method :	AS1289.2.1.1	AS1289.2.1.1	AS1289.2.1.1	
Moisture Ratio (%) :	101	101	108	
Field Wet Density (t/m ³) :	2.017	2.057	2.025	
Optimum Moisture Content (%) :	21.0	18.9	22.2	
Moisture Variation :	-0.2	-0.2	-1.8	
Peak Converted Wet Density (t/m ³) :	2.085	2.099	2.023	
Hilf Density Ratio (%) :	96.5	98.0	100.0	
Minimum Specification :	95	95	95	
Moisture Specification :	+ or - 2%	+ or - 2%	+ or - 2%	
Site Selection :	-	-	-	
Soil Description :	-	-	-	
Remarks :	-			



Accredited for compliance with ISO/IEC 17025 - Testing.

APPROVED SIGNATORY

Liam A Mcdowall

Liam Mcdowall (Brisbane) - Branch Manager
NATA Accreditation Number
1162 / 1169

Document Code RF89-11



Hilf Density Ratio Report

Client :	CCA WINSLOW	Report Number:	DL17/398 - 68
Address :	1587 IPSWICH ROAD, ROCKLEA, QLD, 4106	Report Date :	22/03/2018
Project Name :	EARTHWORKS SUPERVISION	Order Number :	37618
Project Number :	DL17/398	Test Method :	AS1289.5.8.1 & 5.7.1
Location:	EDEN'S CROSSING , FUTURE STAGES 15-20	Page 1 of 1	

Sample Number :	242633	242634	242635	242636
Test Number :	207	208	209	210
Sampling Method :	-	-	-	-
Date Sampled :	14/03/2018	14/03/2018	14/03/2018	14/03/2018
Date Tested :	14/03/2018	14/03/2018	14/03/2018	14/03/2018
Material Type :	Bulk Fill	Bulk Fill	Bulk Fill	Bulk Fill
Material Source :	On Site	On Site	On Site	On Site
Lot Number :	-	-	-	-
Sample Location :	E 484114.993 N 6939904.564 RL 78.350	E 484116.637 N 6939875.337 RL 79.766	E 484127.066 N 6939926.925 RL 78.291	E 484119.842 N 6939950.084 RL 76.577
Test Depth (mm) :	150	150	150	150
Layer Depth (mm) :	150	150	150	150
Maximum Size (mm) :	19	19	19	19
Oversize Wet (%) :	-	-	-	-
Oversize Dry (%) :	-	-	-	-
Oversize Density (t/m ³) :	-	-	-	-
Field Moisture Content (%) :	18.7	17.9	26.1	14.9
Hilf MDR Number :	242633	242634	242635	242636
Hilf MDR Method :	AS1289.5.1.1 & 5.7.1	AS1289.5.1.1 & 5.7.1	AS1289.5.1.1 & 5.7.1	AS1289.5.1.1 & 5.7.1
Compactive Effort :	Standard	Standard	Standard	Standard
Field Density Method :	AS1289.5.8.1 & 5.7.1	AS1289.5.8.1 & 5.7.1	AS1289.5.8.1 & 5.7.1	AS1289.5.8.1 & 5.7.1
Moisture Method :	AS1289.2.1.1	AS1289.2.1.1	AS1289.2.1.1	AS1289.2.1.1
Moisture Ratio (%) :	99.5	97.5	98.5	100
Field Wet Density (t/m ³) :	2.131	2.022	1.772	2.131
Optimum Moisture Content (%) :	18.8	18.4	26.5	14.9
Moisture Variation :	0.1	0.5	0.4	0.0
Peak Converted Wet Density (t/m ³) :	2.175	1.980	1.849	2.180
Hilf Density Ratio (%) :	98.0	102.0	96.0	98.0
Minimum Specification :	95	95	95	95
Moisture Specification :	-2% to +1%	-2% to +1%	-2% to +1%	-2% to +1%
Site Selection :	-	-	-	-
Soil Description :	GENERAL FILL	GENERAL FILL	GENERAL FILL	GENERAL FILL
Remarks :	-			



Accredited for compliance with ISO/IEC 17025 - Testing.

APPROVED SIGNATORY

Liam A Mcdowall

Liam Mcdowall (Brisbane) - Branch Manager
NATA Accreditation Number
1162 / 1169



MORRISON
GEOTECHNIC

Brisbane | Gold Coast | Maroochydore
Unit 1, 35 Limestone Street (PO Box 3063), Darra Q 4076 P (07) 3279 0900 F (07) 3279 0955
ABN: 51 009 878 899
www.morrisonge.com.au

Hilf Density Ratio Report

Client :	CCA WINSLOW	Report Number:	DL17/398 - 70
Address :	1587 IPSWICH ROAD, ROCKLEA, QLD, 4106	Report Date :	23/03/2018
Project Name :	EARTHWORKS SUPERVISION	Order Number :	37618
Project Number :	DL17/398	Test Method :	AS1289.5.8.1 & 5.7.1
Location:	EDEN'S CROSSING , FUTURE STAGES 15-20	Page 1 of 1	

Sample Number :	242683	242684	242685	242686
Test Number :	215	216	217	218
Sampling Method :	-	-	-	-
Date Sampled :	15/03/2018	15/03/2018	15/03/2018	15/03/2018
Date Tested :	15/03/2018	15/03/2018	15/03/2018	15/03/2018
Material Type :	Bulk Fill	Bulk Fill	Bulk Fill	Bulk Fill
Material Source :	On Site	On Site	On Site	On Site
Lot Number :	-	-	-	-
Sample Location :	E 484169.830 N 6939786.318 RL 84.340	E 484150.262 N 6939914.808 RL 79.984	E 484152.563 N 6939890.330 RL 80.730	E 484153.322 N 6939870.529 RL 81.170
Test Depth (mm) :	150		150	150
Layer Depth (mm) :	-	-	-	-
Maximum Size (mm) :	19	19	19	19
Oversize Wet (%) :	-	-	-	-
Oversize Dry (%) :	-	-	-	-
Oversize Density (t/m ³) :	-	-	-	-
Field Moisture Content (%) :	17.4	17.5	18.9	19.3
Hilf MDR Number :	242683	242684	242685	242686
Hilf MDR Method :	AS1289.5.1.1 & 5.7.1	AS1289.5.1.1 & 5.7.1	AS1289.5.1.1 & 5.7.1	AS1289.5.1.1 & 5.7.1
Compactive Effort :	Standard	Standard	Standard	Standard
Field Density Method :	AS1289.5.8.1 & 5.7.1	AS1289.5.8.1 & 5.7.1	AS1289.5.8.1 & 5.7.1	AS1289.5.8.1 & 5.7.1
Moisture Method :	AS1289.2.1.1	AS1289.2.1.1	AS1289.2.1.1	AS1289.2.1.1
Moisture Ratio (%) :	101.5	98.5	92	100.5
Field Wet Density (t/m ³) :	2.048	2.221	2.133	2.034
Optimum Moisture Content (%) :	17.2	17.7	20.5	19.2
Moisture Variation :	-0.2	0.2	1.6	-0.1
Peak Converted Wet Density (t/m ³) :	2.081	2.119	2.107	1.966
Hilf Density Ratio (%) :	98.5	105.0	101.0	103.5
Minimum Specification :	95	95	95	95
Moisture Specification :	+ or - 2%	+ or - 2%	+ or - 2%	+ or - 2%
Site Selection :	-	-	-	-
Soil Description :	SILTY CLAY	SANDY CLAY	SANDY CLAY	SANDY CLAY
Remarks :	-			



Accredited for compliance with ISO/IEC 17025 - Testing.

APPROVED SIGNATORY

Liam A Mcdowall

Liam Mcdowall (Brisbane) - Branch Manager
NATA Accreditation Number
1162 / 1169

Document Code RF89-11



Hilf Density Ratio Report

Client :	CCA WINSLOW	Report Number:	DL17/398 - 71
Address :	1587 IPSWICH ROAD, ROCKLEA, QLD, 4106	Report Date :	28/03/2018
Project Name :	EARTHWORKS SUPERVISION	Order Number :	37618
Project Number :	DL17/398	Test Method :	AS1289.5.8.1 & 5.7.1
Location:	EDEN'S CROSSING , FUTURE STAGES 15-20	Page 1 of 1	

Sample Number :	242872	242873	242874	
Test Number :	219	220	221	
Sampling Method :	-	-	-	
Date Sampled :	19/03/2018	19/03/2018	19/03/2018	
Date Tested :	19/03/2018	19/03/2018	19/03/2018	
Material Type :	General Fill	General Fill	General Fill	
Material Source :	On Site	On Site	On Site	
Lot Number :	-	-	-	
Sample Location :	E 484132.587 N 6939811.223 RL 82.499	E 484131.470 N 6939789.767 RL 83.300	E 484123.503 N 6939784.111 RL 83.131	
Test Depth (mm) :	150	150	150	
Layer Depth (mm) :	-	-	-	
Maximum Size (mm) :	19	19	19	
Oversize Wet (%) :	-	-	-	
Oversize Dry (%) :	-	-	-	
Oversize Density (t/m ³) :	-	-	-	
Field Moisture Content (%) :	21.5	22.4	16.6	
Hilf MDR Number :	242872	242873	242874	
Hilf MDR Method :	AS1289.5.1.1 & 5.7.1	AS1289.5.1.1 & 5.7.1	AS1289.5.1.1 & 5.7.1	
Compactive Effort :	Standard	Standard	Standard	
Field Density Method :	AS1289.5.8.1 & 5.7.1	AS1289.5.8.1 & 5.7.1	AS1289.5.8.1 & 5.7.1	
Moisture Method :	AS1289.2.1.1	AS1289.2.1.1	AS1289.2.1.1	
Moisture Ratio (%) :	101.5	100	91	
Field Wet Density (t/m ³) :	2.018	1.942	2.012	
Optimum Moisture Content (%) :	21.2	22.4	18.2	
Moisture Variation :	-0.3	0.0	1.6	
Peak Converted Wet Density (t/m ³) :	2.095	2.013	2.036	
Hilf Density Ratio (%) :	96.5	96.5	99.0	
Minimum Specification :	95	95	95	
Moisture Specification :	+ or - 2%	+ or - 2%	+ or - 2%	
Site Selection :	-	-	-	
Soil Description :	CLAY	CLAY	CLAY	
Remarks :	-			



Accredited for compliance with ISO/IEC 17025 - Testing.

APPROVED SIGNATORY

Liam A Mcdowall

Liam Mcdowall (Brisbane) - Branch Manager
NATA Accreditation Number
1162 / 1169

Brisbane Office
Job Number: DL20/027
Ref No: 16146
Author: R. Mitchell

22nd April 2020

Shadforths Civil Pty Ltd
99 Sandalwood Lane
Forest Glen 4556

ATTENTION: MR MICHAEL PRITCHARD
Email: Michael.Pritchard@shadcivil.com.au

Dear Sir,

**RE: LOT 1033
LEVEL ONE COMPLIANCE REPORT FOR
EARTHWORKS FILL CONSTRUCTION
EDENS CROSSING STAGE 21**

Earthworks filling operations were carried out on Lot 1033 at the above Development to form a working platform to support a future residential building.

Earthworks were constructed by CCA Winslow (The Client) between May 2017 and March 2018 and Shadforths Civil (The Client) between January 2020 and March 2020.

This report should be read in conjunction with Morrison Geotechnic Report "16058 – DL20/027 Shadforths – Level One Compliance Report – Eden's Crossing Stage 21" Dated 21st April 2020. The Brief from the Client for was limited to:

- Level One Inspection of the placement and compaction of fill materials in accordance with AS3798 2007 – "Guidelines on Earthworks for Commercial and Residential Developments"
- Relative Density Control Testing in accordance with AS1289 – Testing of Soils for Engineering Purposes and at frequencies required in AS3798 Table 8.
- Ipswich City Council Specifications.
- Notes on KN Group Pty Ltd Civil Drawings.

Level One Inspections and Testing was carried out on the stripped ground surfaces and during the placement and compaction of fill materials. Field and laboratory testing included proof roll testing of the stripped surface and compaction testing.

Compaction testing at the Eden's Crossing Stage 21 Development was carried out at a frequency of 1 test per 500m³ of placed and compacted fill as defined in AS3798 Table 8.1. Test locations were selected using Random Stratified methods. Compaction testing was carried out at frequencies representative of the fill volume as a mass. On this basis, compaction testing was not required on each individual Lot.

A marked-up site plan shown the location of compaction testing is attached.

Fill constructed on Lot 1033 has been observed to be placed and compacted in accordance with the Brief. The fill on Lot 1033 can be termed as "Controlled Fill" in accordance with AS 2870-2011 "Residential Slabs and Footings".

This statement does not include any topsoil, which may have been placed for use as Lot dressing or any other subsequent earthworks after March 2020.

If there are any queries concerning the above please do not hesitate to contact this office, or alternatively send to my email at mickmorrison@morrisongeo.com.au.

Yours faithfully,


A handwritten signature in grey ink, appearing to read 'Rhys Mitchell', with a long horizontal flourish extending to the right.

RHYS MITCHELL

For and on Behalf of

MORRISON GEOTECHNIC PTY LIMITED

Encl: Marked Up Site Pan

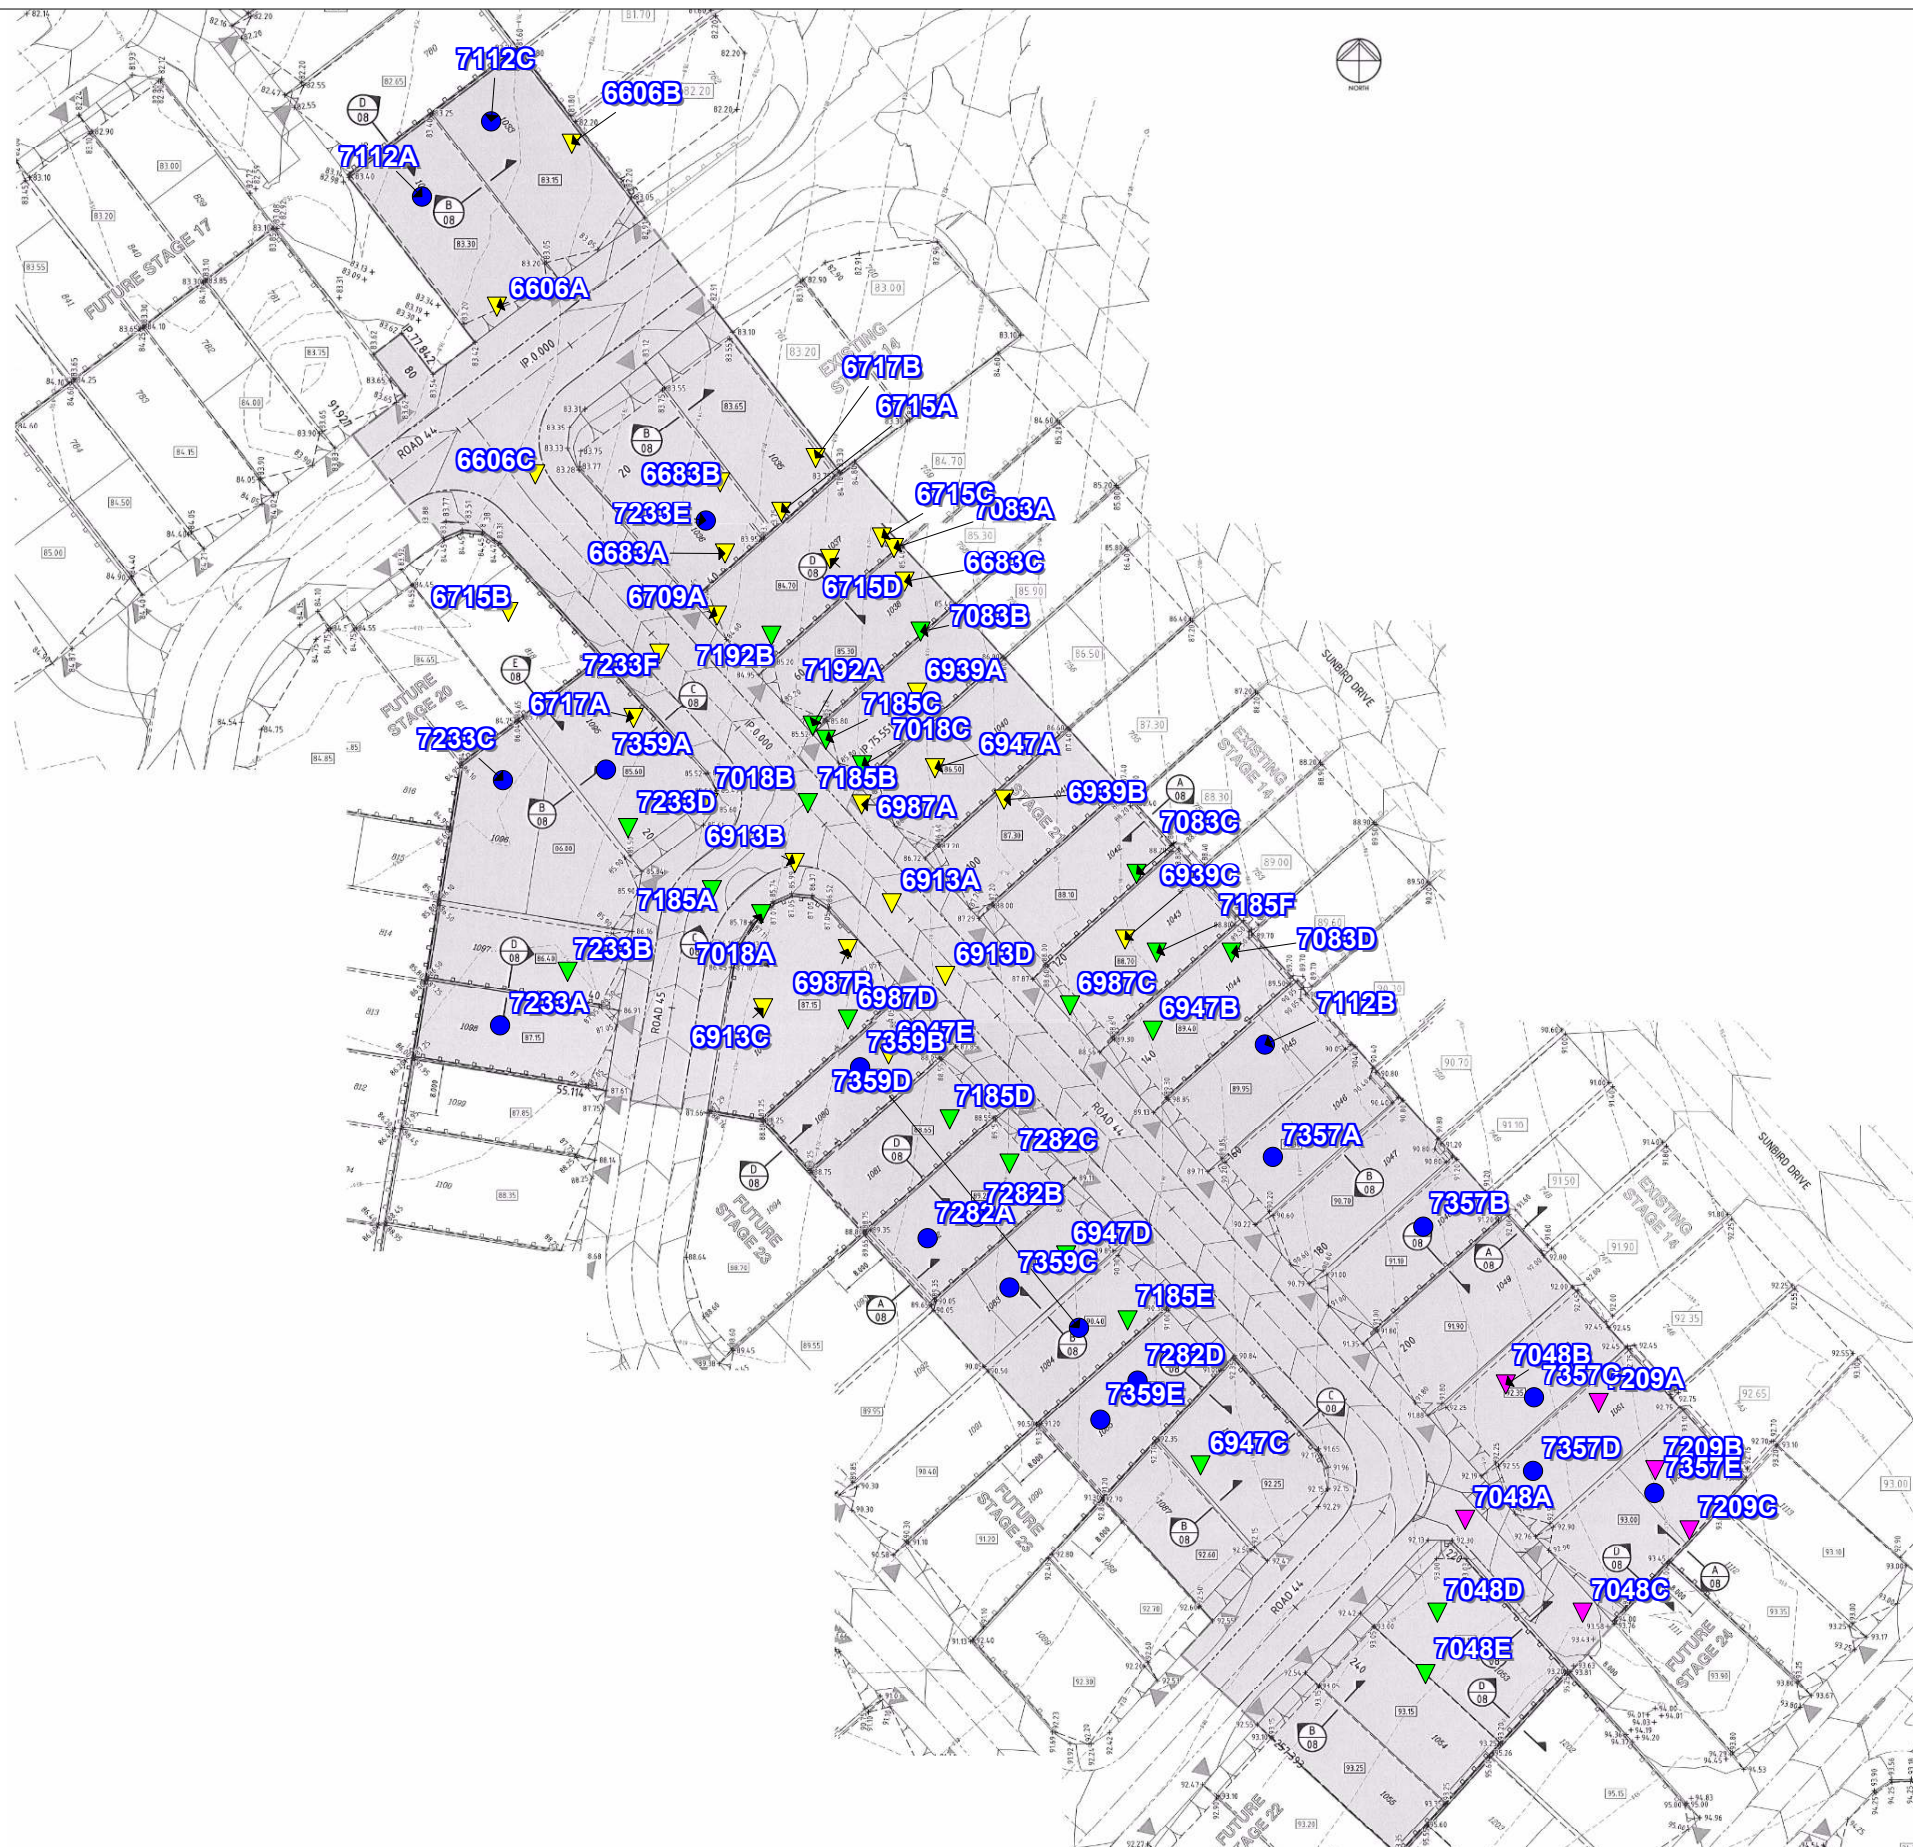

MORRISON GEOTECHNIC PTY LTD

ABN: 51 009 878 899

Unit 1/ 35 Limestone St, Darra 4076 Ph: 3279 0900
 Email: brisbanelab@morrisongeo.com.au

Engineers: M. Ballard
 D. Dragun
 Geologists: R. Howchin
 Laboratory: M. Morrison

LEGEND

- ▲ R.L 80.0 - 84.99
- ▲ R.L 85.0 - 89.99
- ▲ R.L 90.0 - 94.99
- Final Level

Map Description :	EARTHWORKS FIELD DENSITY TESTING - Level 1 Inspection		
Client :	SHADFORTHS PTY LTD		
Project :	EDENS CROSSING - STAGE 21		
Project No :	DL20/027	Drawing No :	DL20/027 - 01
		Scale :	Not to Scale



MORRISON GEOTECHNIC PTY LTD

ABN: 51 009 878 899

Unit 1/ 35 Limestone St, Darra 4076 Ph: 3279 0900
 Email: brisbanelab@morrisongeo.com.au Fax: 3279 0955

Engineers: D.Riley, J. Daly
 D.Dragun, & S.Wynne
 Geologists: L.Bexley & R.Howchin
 Laboratory: M.Morrison

LEGEND

- ▼ R.L 77.0 - 78.99
- ▼ R.L 79.0 - 80.99
- ▼ R.L 81.0 - 82.99
- ▼ R.L 83.0 - 84.99
- Final Level

Map Description :	EARTHWORKS FIELD DENSITY TESTING - Level 1 Inspection		
Client :	CCA WINSLOW		
Project :	EDENS CROSSING, FUTURE STAGES 15-20		
Project No :	DL17/398	Drawing No :	DL17/398 - 01
		Scale :	Not to Scale

Brisbane Office
Job Number: DL20/027
Ref No: 16147
Author: R. Mitchell

22nd April 2020

Shadforths Civil Pty Ltd
99 Sandalwood Lane
Forest Glen 4556

ATTENTION: MR MICHAEL PRITCHARD
Email: Michael.Pritchard@shadcivil.com.au

Dear Sir,

**RE: LOT 1034
LEVEL ONE COMPLIANCE REPORT FOR
EARTHWORKS FILL CONSTRUCTION
EDENS CROSSING STAGE 21**

Earthworks filling operations were carried out on Lot 1034 at the above Development to form a working platform to support a future residential building.

Earthworks were constructed by CCA Winslow (The Client) between May 2017 and March 2018 and Shadforths Civil (The Client) between January 2020 and March 2020.

This report should be read in conjunction with Morrison Geotechnic Report “16058 – DL20/027 Shadforths – Level One Compliance Report – Eden’s Crossing Stage 21” Dated 21st April 2020. The Brief from the Client for was limited to:

- Level One Inspection of the placement and compaction of fill materials in accordance with AS3798 2007 – “Guidelines on Earthworks for Commercial and Residential Developments”
- Relative Density Control Testing in accordance with AS1289 – Testing of Soils for Engineering Purposes and at frequencies required in AS3798 Table 8.
- Ipswich City Council Specifications.
- Notes on KN Group Pty Ltd Civil Drawings.

Level One Inspections and Testing was carried out on the stripped ground surfaces and during the placement and compaction of fill materials. Field and laboratory testing included proof roll testing of the stripped surface and compaction testing.

Compaction testing at the Eden’s Crossing Stage 21 Development was carried out at a frequency of 1 test per 500m³ of placed and compacted fill as defined in AS3798 Table 8.1. Test locations were selected using Random Stratified methods. Compaction testing was carried out at frequencies representative of the fill volume as a mass. On this basis, compaction testing was not required on each individual Lot.

A marked-up site plan shown the location of compaction testing is attached.

Fill constructed on Lot 1034 has been observed to be placed and compacted in accordance with the Brief. The fill on Lot 1034 can be termed as "Controlled Fill" in accordance with AS 2870-2011 "Residential Slabs and Footings".

This statement does not include any topsoil, which may have been placed for use as Lot dressing or any other subsequent earthworks after March 2020.

If there are any queries concerning the above please do not hesitate to contact this office, or alternatively send to my email at mickmorrison@morrisongeo.com.au.

Yours faithfully,


A handwritten signature in grey ink, appearing to read 'Rhys Mitchell', with a horizontal line extending to the right.

RHYS MITCHELL

For and on Behalf of

MORRISON GEOTECHNIC PTY LIMITED

Encl: Marked Up Site Pan

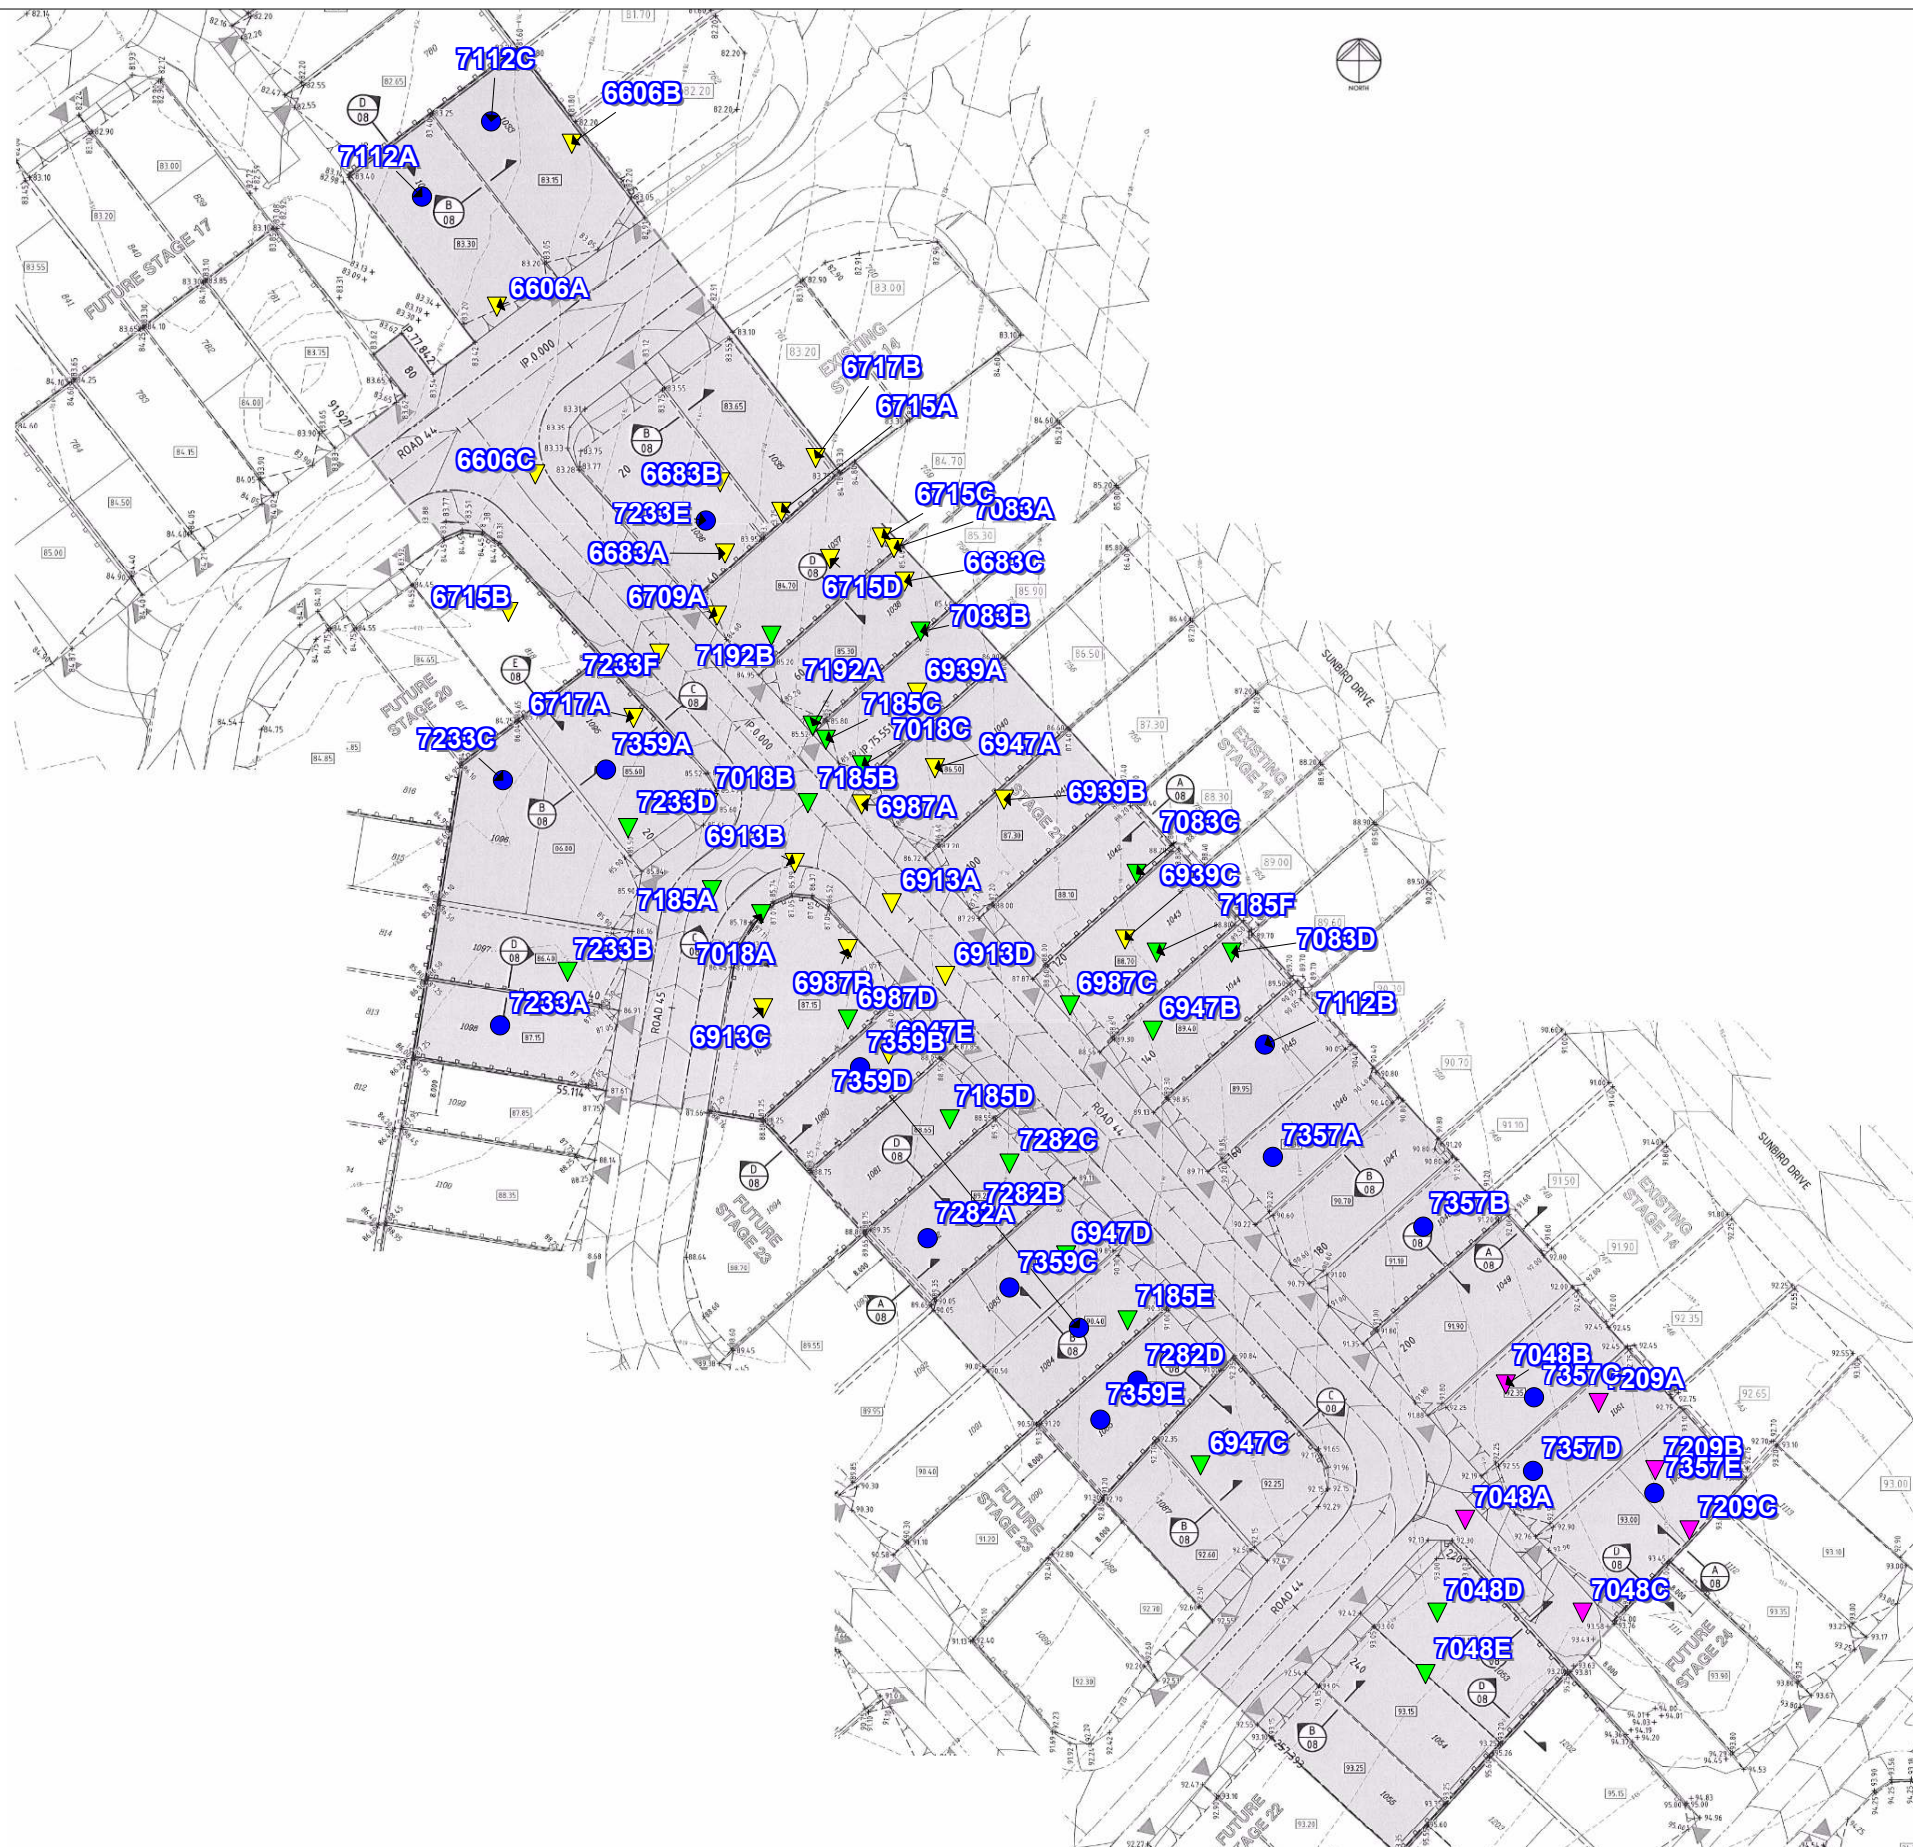

MORRISON GEOTECHNIC PTY LTD

ABN: 51 009 878 899

Unit 1/ 35 Limestone St, Darra 4076 Ph: 3279 0900
 Email: brisbanelab@morrisongeo.com.au

Engineers: M. Ballard
 D. Dragun
 Geologists: R. Howchin
 Laboratory: M. Morrison

LEGEND

- ▲ R.L 80.0 - 84.99
- ▲ R.L 85.0 - 89.99
- ▲ R.L 90.0 - 94.99
- Final Level

Map Description :	EARTHWORKS FIELD DENSITY TESTING - Level 1 Inspection		
Client :	SHADFORTHS PTY LTD		
Project :	EDENS CROSSING - STAGE 21		
Project No :	DL20/027	Drawing No :	DL20/027 - 01
		Scale :	Not to Scale



MORRISON GEOTECHNIC PTY LTD

ABN: 51 009 878 899

Unit 1/ 35 Limestone St, Darra 4076 Ph: 3279 0900
 Email: brisbanelab@morrisongeo.com.au Fax: 3279 0955

Engineers: D.Riley, J. Daly
 D.Dragun, & S.Wynne
 Geologists: L.Bexley & R.Howchin
 Laboratory: M.Morrison

LEGEND

- ▼ R.L 77.0 - 78.99
- ▼ R.L 79.0 - 80.99
- ▼ R.L 81.0 - 82.99
- ▼ R.L 83.0 - 84.99
- Final Level

Map Description :	EARTHWORKS FIELD DENSITY TESTING - Level 1 Inspection		
Client :	CCA WINSLOW		
Project :	EDENS CROSSING, FUTURE STAGES 15-20		
Project No :	DL17/398	Drawing No :	DL17/398 - 01
		Scale :	Not to Scale

Brisbane Office
Job Number: DL20/027
Ref No: 16148
Author: R. Mitchell

22nd April 2020

Shadforths Civil Pty Ltd
99 Sandalwood Lane
Forest Glen 4556

ATTENTION: MR MICHAEL PRITCHARD
Email: Michael.Pritchard@shadcivil.com.au

Dear Sir,

**RE: LOT 1035
LEVEL ONE COMPLIANCE REPORT FOR
EARTHWORKS FILL CONSTRUCTION
EDENS CROSSING STAGE 21**

Earthworks filling operations were carried out on Lot 1035 at the above Development to form a working platform to support a future residential building.

Earthworks were constructed by CCA Winslow (The Client) between May 2017 and March 2018 and Shadforths Civil (The Client) between January 2020 and March 2020.

This report should be read in conjunction with Morrison Geotechnic Report “16058 – DL20/027 Shadforths – Level One Compliance Report – Eden’s Crossing Stage 21” Dated 21st April 2020. The Brief from the Client for was limited to:

- Level One Inspection of the placement and compaction of fill materials in accordance with AS3798 2007 – “Guidelines on Earthworks for Commercial and Residential Developments”
- Relative Density Control Testing in accordance with AS1289 – Testing of Soils for Engineering Purposes and at frequencies required in AS3798 Table 8.
- Ipswich City Council Specifications.
- Notes on KN Group Pty Ltd Civil Drawings.

Level One Inspections and Testing was carried out on the stripped ground surfaces and during the placement and compaction of fill materials. Field and laboratory testing included proof roll testing of the stripped surface and compaction testing.

Compaction testing at the Eden’s Crossing Stage 21 Development was carried out at a frequency of 1 test per 500m³ of placed and compacted fill as defined in AS3798 Table 8.1. Test locations were selected using Random Stratified methods. Compaction testing was carried out at frequencies representative of the fill volume as a mass. On this basis, compaction testing was not required on each individual Lot.

A marked-up site plan shown the location of compaction testing is attached.

Fill constructed on Lot 1035 has been observed to be placed and compacted in accordance with the Brief. The fill on Lot 1035 can be termed as "Controlled Fill" in accordance with AS 2870-2011 "Residential Slabs and Footings".

This statement does not include any topsoil, which may have been placed for use as Lot dressing or any other subsequent earthworks after March 2020.

If there are any queries concerning the above please do not hesitate to contact this office, or alternatively send to my email at mickmorrison@morrisongeo.com.au.

Yours faithfully,


A handwritten signature in grey ink, appearing to read 'Rhys Mitchell', with a long horizontal flourish extending to the right.

RHYS MITCHELL

For and on Behalf of

MORRISON GEOTECHNIC PTY LIMITED

Encl: Marked Up Site Pan

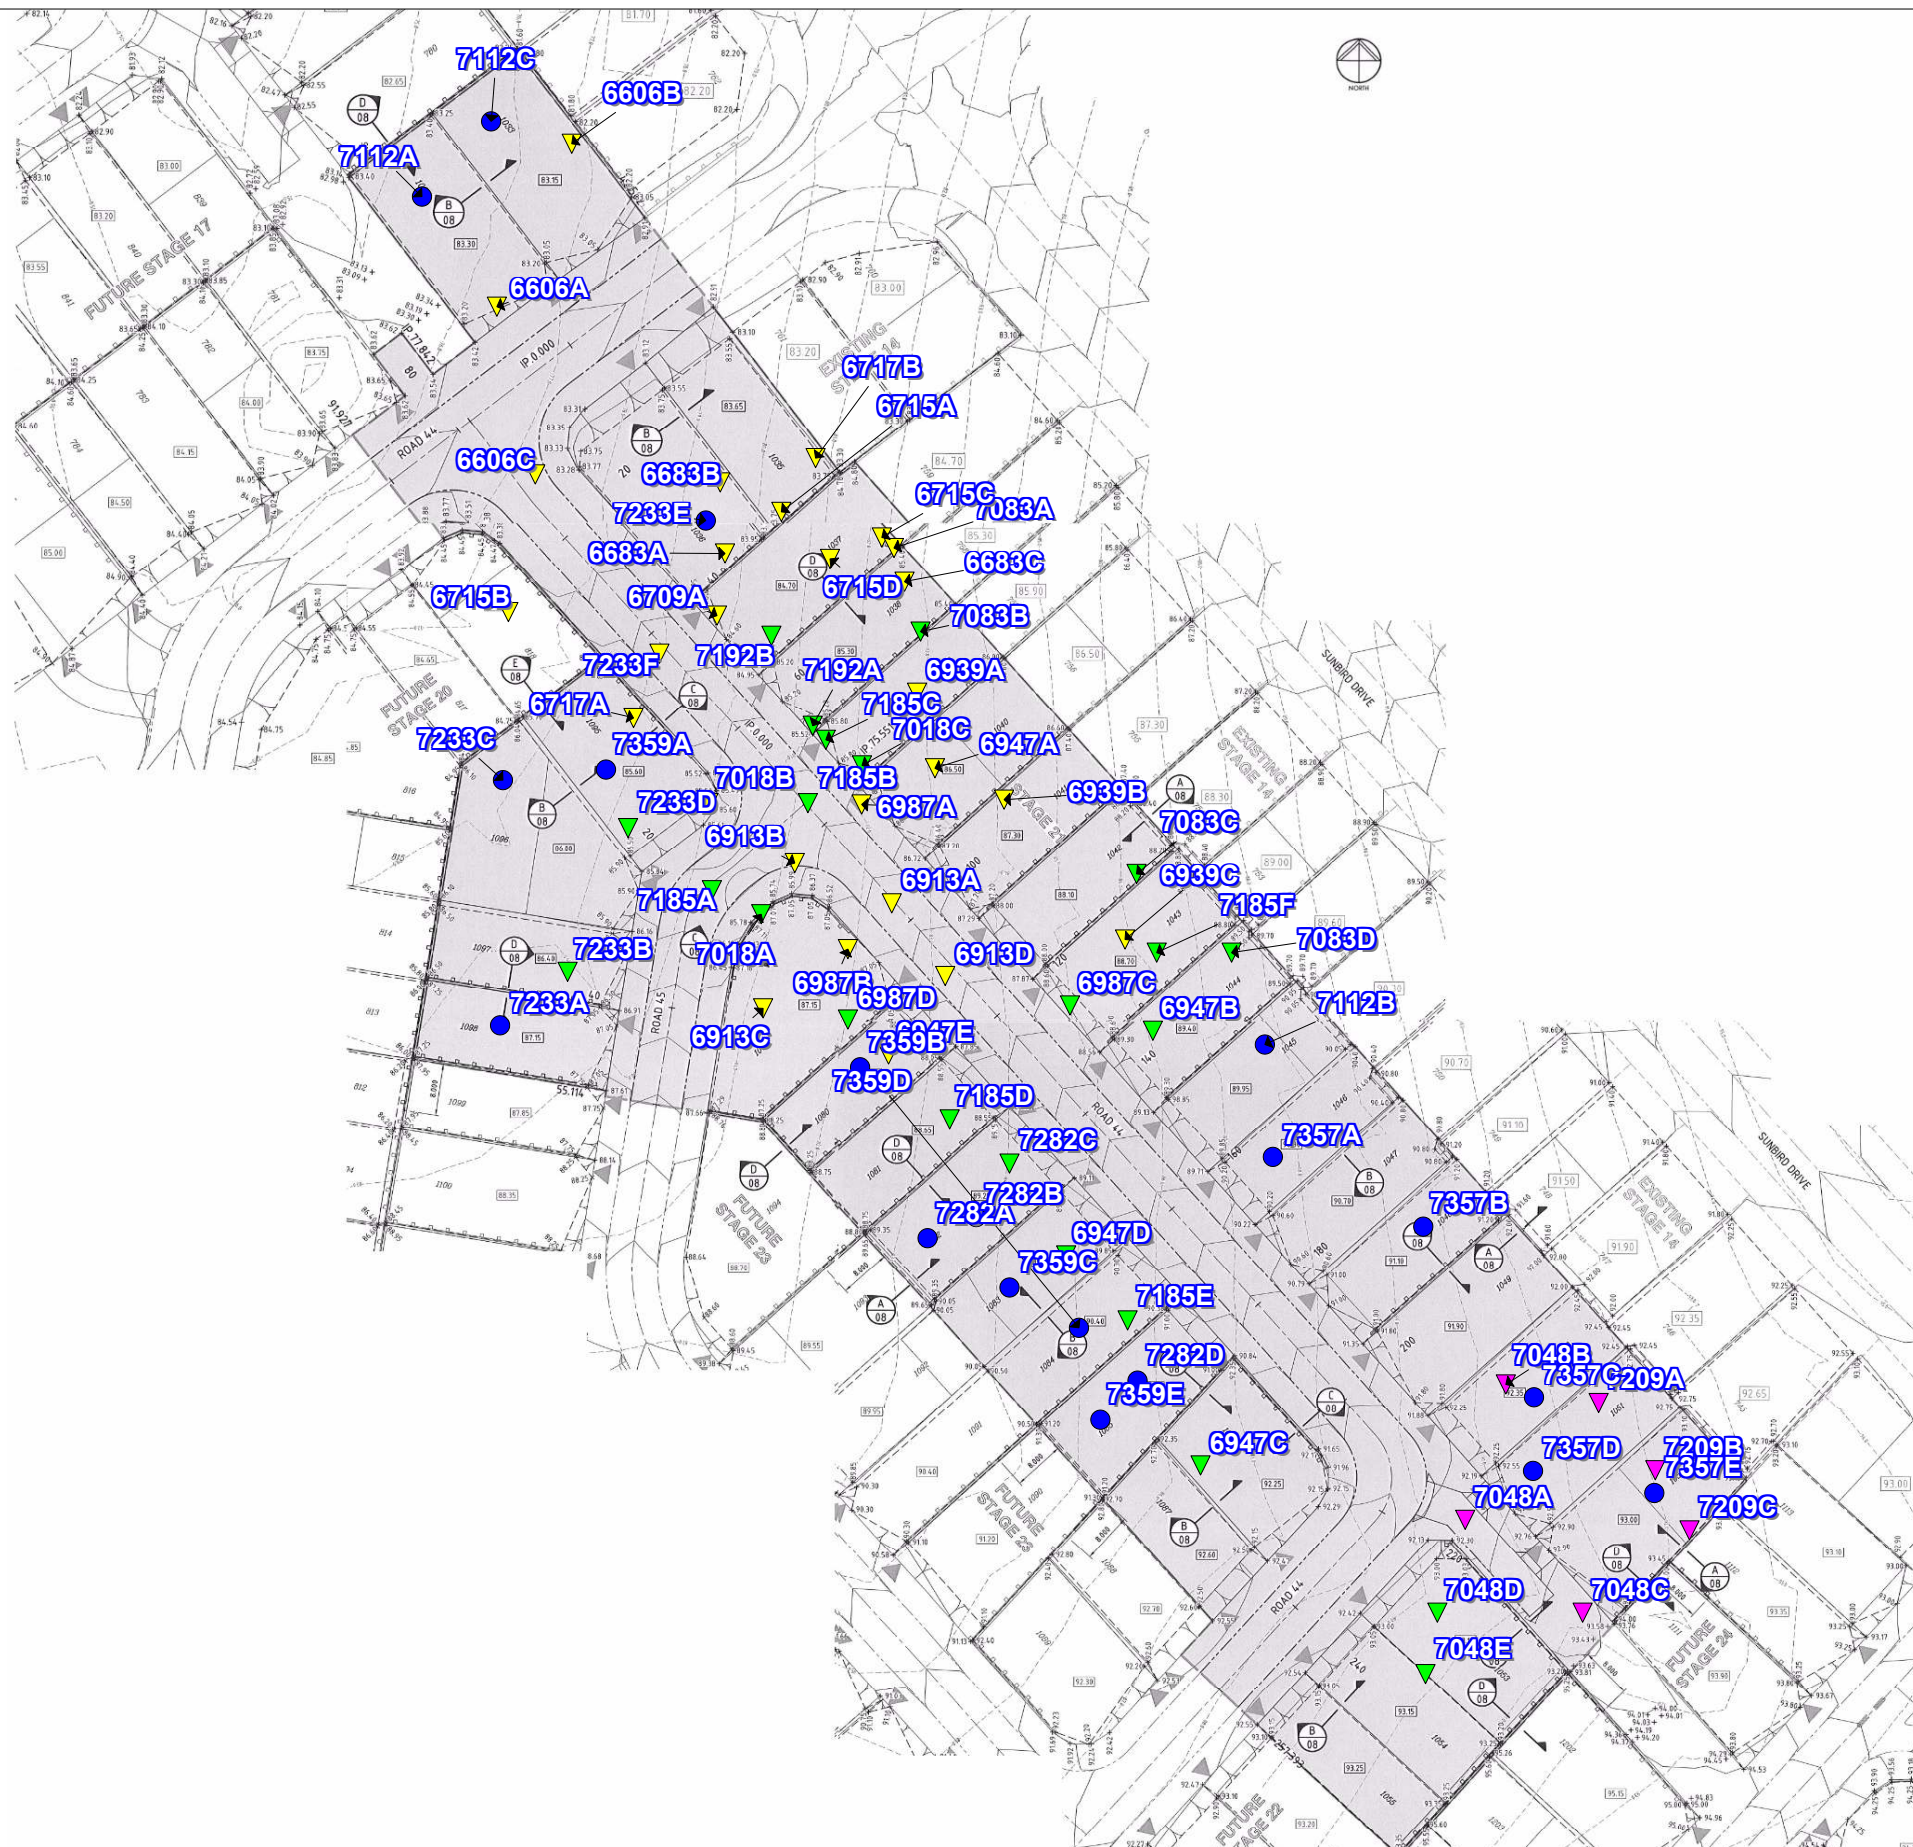

MORRISON GEOTECHNIC PTY LTD

ABN: 51 009 878 899

Unit 1/ 35 Limestone St, Darra 4076 Ph: 3279 0900
 Email: brisbanelab@morrisongeo.com.au

Engineers: M. Ballard
 D. Dragun
 Geologists: R. Howchin
 Laboratory: M. Morrison

LEGEND

- ▼ R.L 80.0 - 84.99
- ▼ R.L 85.0 - 89.99
- ▼ R.L 90.0 - 94.99
- Final Level

Map Description :	EARTHWORKS FIELD DENSITY TESTING - Level 1 Inspection		
Client :	SHADFORTHS PTY LTD		
Project :	EDENS CROSSING - STAGE 21		
Project No :	DL20/027	Drawing No :	DL20/027 - 01
		Scale :	Not to Scale



MORRISON GEOTECHNIC PTY LTD

ABN: 51 009 878 899

Unit 1/ 35 Limestone St, Darra 4076 Ph: 3279 0900
 Email: brisbanelab@morrisongeo.com.au Fax: 3279 0955

Engineers: D.Riley, J. Daly
 D.Dragun, & S.Wynne
 Geologists: L.Bexley & R.Howchin
 Laboratory: M.Morrison

LEGEND

- ▼ R.L 77.0 - 78.99
- ▼ R.L 79.0 - 80.99
- ▼ R.L 81.0 - 82.99
- ▼ R.L 83.0 - 84.99
- Final Level

Map Description :	EARTHWORKS FIELD DENSITY TESTING - Level 1 Inspection		
Client :	CCA WINSLOW		
Project :	EDENS CROSSING, FUTURE STAGES 15-20		
Project No :	DL17/398	Drawing No :	DL17/398 - 01
		Scale :	Not to Scale

Brisbane Office
Job Number: DL20/027
Ref No: 16149
Author: R. Mitchell

22nd April 2020

Shadforths Civil Pty Ltd
99 Sandalwood Lane
Forest Glen 4556

ATTENTION: MR MICHAEL PRITCHARD
Email: Michael.Pritchard@shadcivil.com.au

Dear Sir,

**RE: LOT 1036
LEVEL ONE COMPLIANCE REPORT FOR
EARTHWORKS FILL CONSTRUCTION
EDENS CROSSING STAGE 21**

Earthworks filling operations were carried out on Lot 1036 at the above Development to form a working platform to support a future residential building.

Earthworks were constructed by CCA Winslow (The Client) between May 2017 and March 2018 and Shadforths Civil (The Client) between January 2020 and March 2020.

This report should be read in conjunction with Morrison Geotechnic Report “16058 – DL20/027 Shadforths – Level One Compliance Report – Eden’s Crossing Stage 21” Dated 21st April 2020. The Brief from the Client for was limited to:

- Level One Inspection of the placement and compaction of fill materials in accordance with AS3798 2007 – “Guidelines on Earthworks for Commercial and Residential Developments”
- Relative Density Control Testing in accordance with AS1289 – Testing of Soils for Engineering Purposes and at frequencies required in AS3798 Table 8.
- Ipswich City Council Specifications.
- Notes on KN Group Pty Ltd Civil Drawings.

Level One Inspections and Testing was carried out on the stripped ground surfaces and during the placement and compaction of fill materials. Field and laboratory testing included proof roll testing of the stripped surface and compaction testing.

Compaction testing at the Eden’s Crossing Stage 21 Development was carried out at a frequency of 1 test per 500m³ of placed and compacted fill as defined in AS3798 Table 8.1. Test locations were selected using Random Stratified methods. Compaction testing was carried out at frequencies representative of the fill volume as a mass. On this basis, compaction testing was not required on each individual Lot.

A marked-up site plan shown the location of compaction testing is attached.

Fill constructed on Lot 1036 has been observed to be placed and compacted in accordance with the Brief. The fill on Lot 1036 can be termed as "Controlled Fill" in accordance with AS 2870-2011 "Residential Slabs and Footings".

This statement does not include any topsoil, which may have been placed for use as Lot dressing or any other subsequent earthworks after March 2020.

If there are any queries concerning the above please do not hesitate to contact this office, or alternatively send to my email at mickmorrison@morrisongeo.com.au.

Yours faithfully,


A handwritten signature in grey ink, appearing to read 'Rhys Mitchell', with a long horizontal flourish extending to the right.

RHYS MITCHELL

For and on Behalf of

MORRISON GEOTECHNIC PTY LIMITED

Encl: Marked Up Site Pan

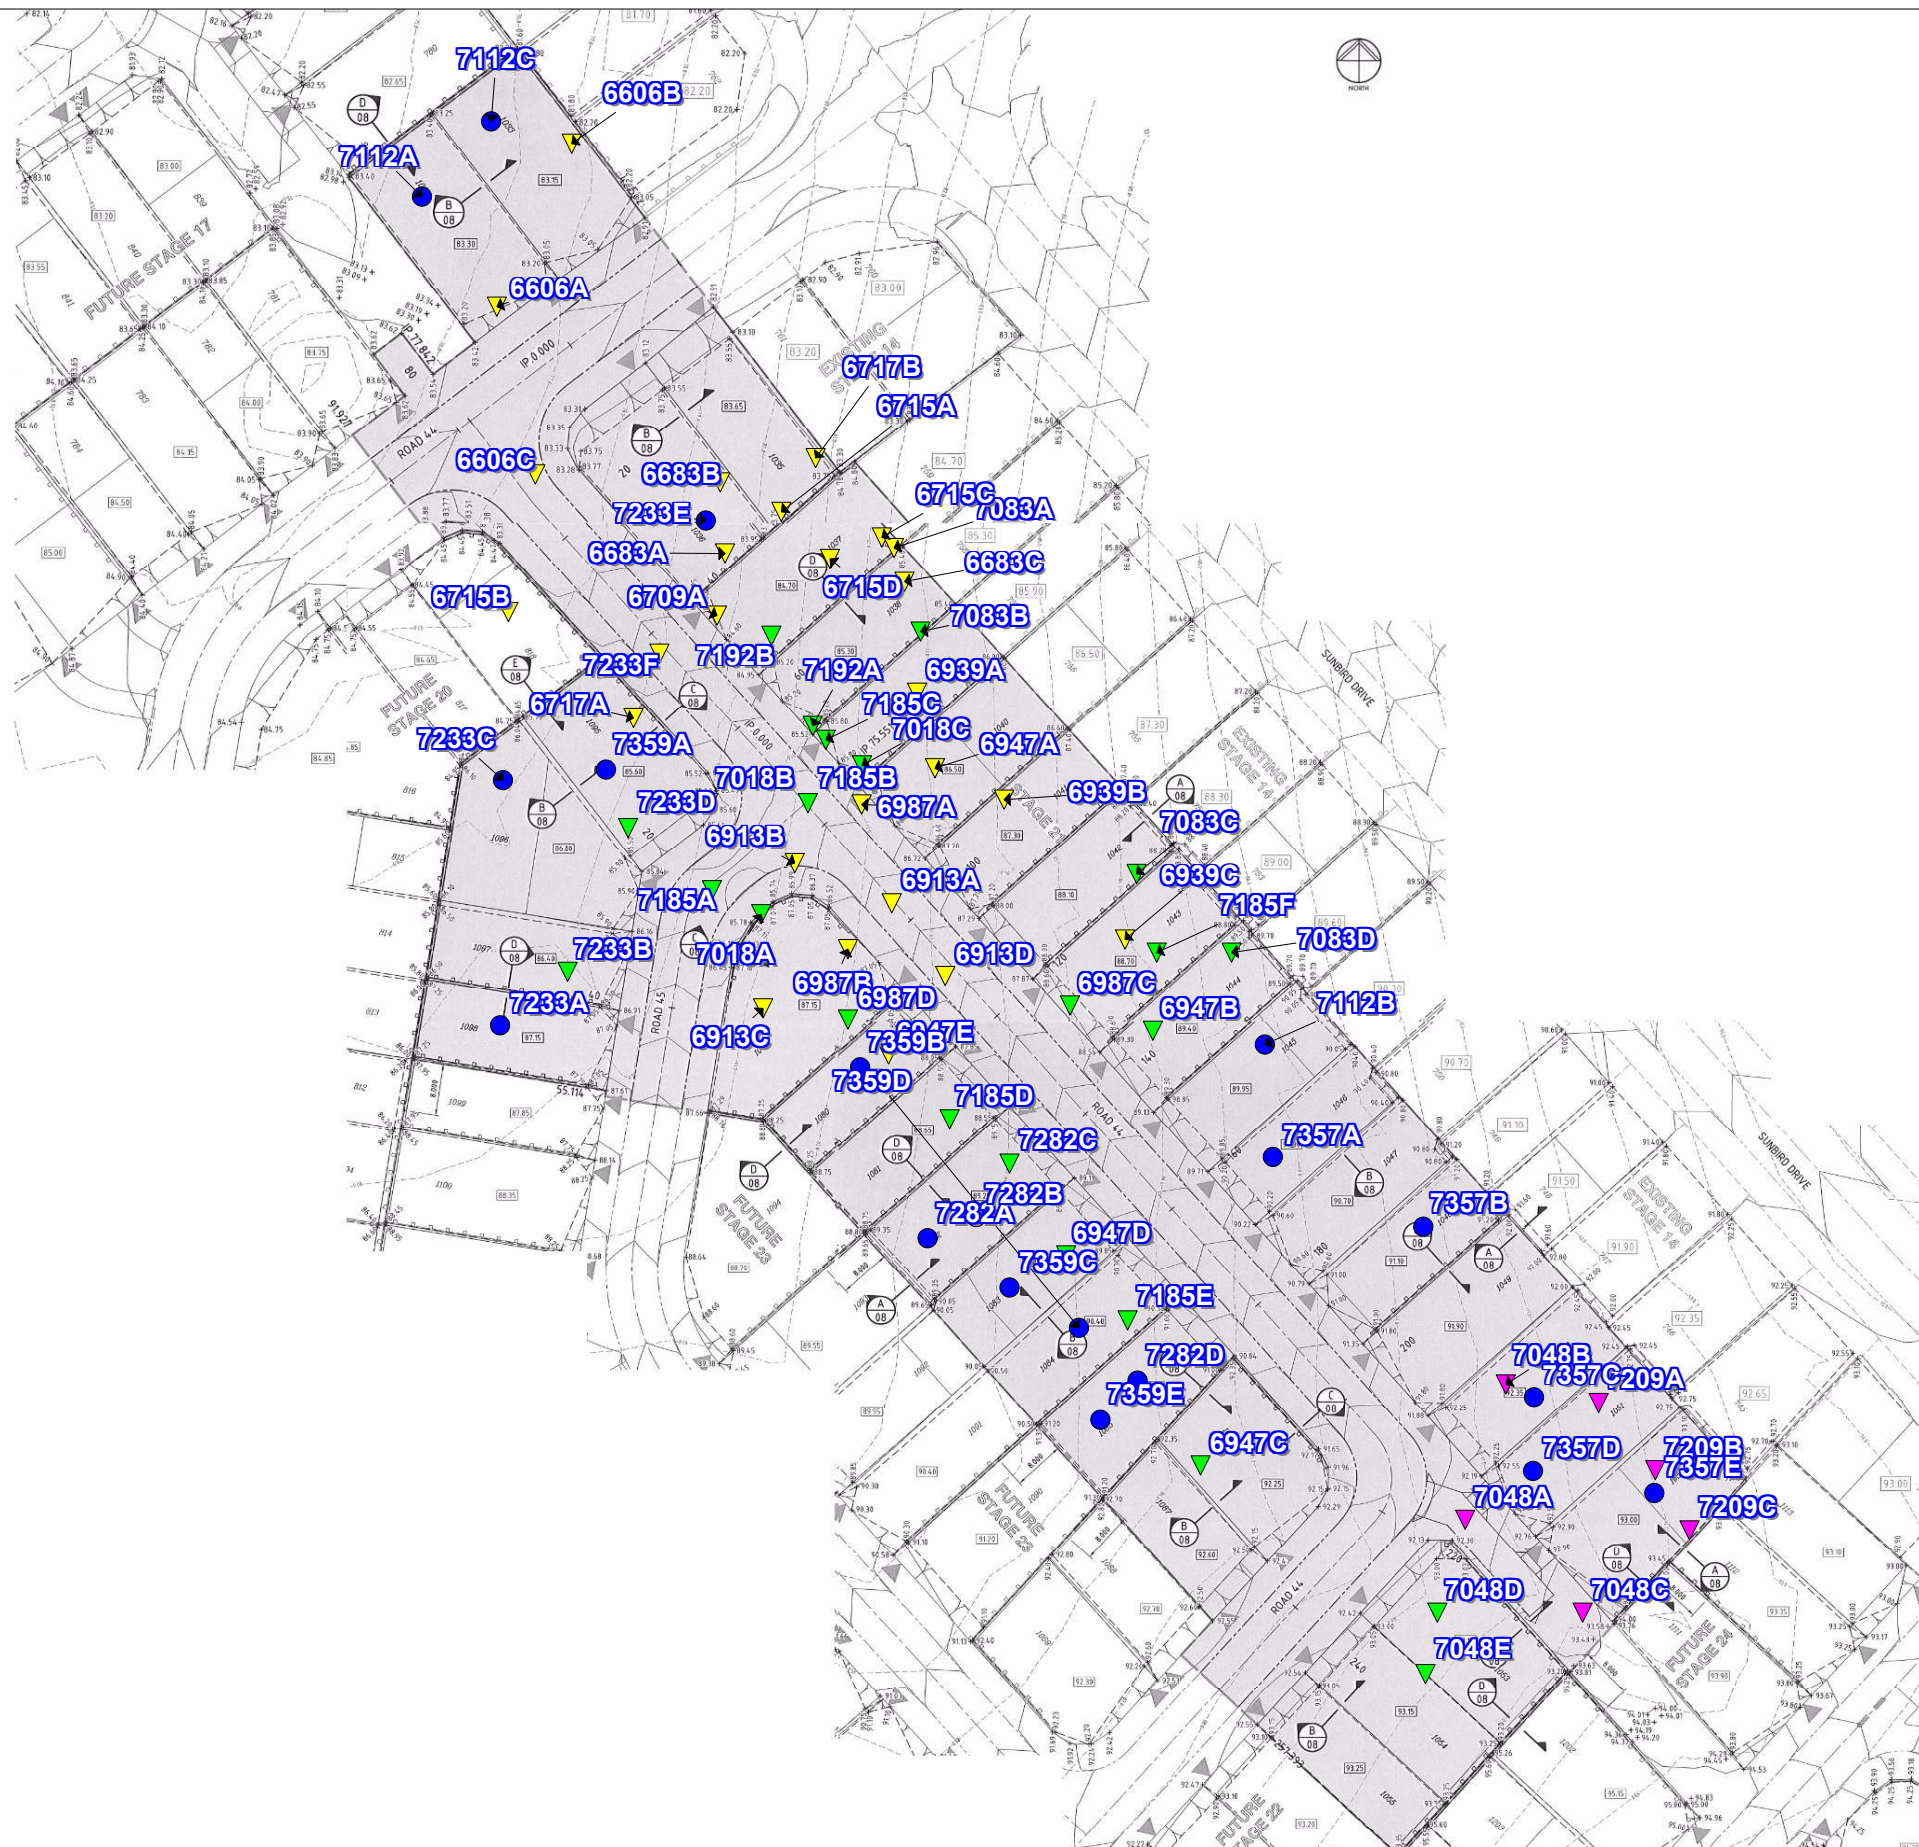

MORRISON GEOTECHNIC PTY LTD

ABN: 51 009 878 899

Unit 1/ 35 Limestone St, Darra 4076 Ph: 3279 0900
 Email: brisbanelab@morrisongeo.com.au

Engineers: M. Ballard
 D. Dragun
 Geologists: R. Howchin
 Laboratory: M. Morrison

LEGEND

- ▼ R.L 80.0 - 84.99
- ▼ R.L 85.0 - 89.99
- ▼ R.L 90.0 - 94.99
- Final Level

Map Description :	EARTHWORKS FIELD DENSITY TESTING - Level 1 Inspection		
Client :	SHADFORTHS PTY LTD		
Project :	EDENS CROSSING - STAGE 21		
Project No :	DL20/027	Drawing No :	DL20/027 - 01
		Scale :	Not to Scale



MORRISON GEOTECHNIC PTY LTD

ABN: 51 009 878 899

Unit 1/ 35 Limestone St, Darra 4076 Ph: 3279 0900
 Email: brisbanelab@morrisongeo.com.au Fax: 3279 0955

Engineers: D.Riley, J. Daly
 D.Dragun, & S.Wynne
 Geologists: L.Bexley & R.Howchin
 Laboratory: M.Morrison

LEGEND

- ▼ R.L 77.0 - 78.99
- ▼ R.L 79.0 - 80.99
- ▼ R.L 81.0 - 82.99
- ▼ R.L 83.0 - 84.99
- Final Level

Map Description :	EARTHWORKS FIELD DENSITY TESTING - Level 1 Inspection		
Client :	CCA WINSLOW		
Project :	EDENS CROSSING, FUTURE STAGES 15-20		
Project No :	DL17/398	Drawing No :	DL17/398 - 01
		Scale :	Not to Scale

Brisbane Office
Job Number: DL20/027
Ref No: 16150
Author: R. Mitchell

22nd April 2020

Shadforths Civil Pty Ltd
99 Sandalwood Lane
Forest Glen 4556

ATTENTION: MR MICHAEL PRITCHARD
Email: Michael.Pritchard@shadcivil.com.au

Dear Sir,

**RE: LOT 1037
LEVEL ONE COMPLIANCE REPORT FOR
EARTHWORKS FILL CONSTRUCTION
EDENS CROSSING STAGE 21**

Earthworks filling operations were carried out on Lot 1037 at the above Development to form a working platform to support a future residential building.

Earthworks were constructed by CCA Winslow (The Client) between May 2017 and March 2018 and Shadforths Civil (The Client) between January 2020 and March 2020.

This report should be read in conjunction with Morrison Geotechnic Report “16058 – DL20/027 Shadforths – Level One Compliance Report – Eden’s Crossing Stage 21” Dated 21st April 2020. The Brief from the Client for was limited to:

- Level One Inspection of the placement and compaction of fill materials in accordance with AS3798 2007 – “Guidelines on Earthworks for Commercial and Residential Developments”
- Relative Density Control Testing in accordance with AS1289 – Testing of Soils for Engineering Purposes and at frequencies required in AS3798 Table 8.
- Ipswich City Council Specifications.
- Notes on KN Group Pty Ltd Civil Drawings.

Level One Inspections and Testing was carried out on the stripped ground surfaces and during the placement and compaction of fill materials. Field and laboratory testing included proof roll testing of the stripped surface and compaction testing.

Compaction testing at the Eden’s Crossing Stage 21 Development was carried out at a frequency of 1 test per 500m³ of placed and compacted fill as defined in AS3798 Table 8.1. Test locations were selected using Random Stratified methods. Compaction testing was carried out at frequencies representative of the fill volume as a mass. On this basis, compaction testing was not required on each individual Lot.

A marked-up site plan shown the location of compaction testing is attached.

Fill constructed on Lot 1037 has been observed to be placed and compacted in accordance with the Brief. The fill on Lot 1037 can be termed as "Controlled Fill" in accordance with AS 2870-2011 "Residential Slabs and Footings".

This statement does not include any topsoil, which may have been placed for use as Lot dressing or any other subsequent earthworks after March 2020.

If there are any queries concerning the above please do not hesitate to contact this office, or alternatively send to my email at mickmorrison@morrisongeo.com.au.

Yours faithfully,


A handwritten signature in grey ink, appearing to read 'Rhys Mitchell', with a horizontal line extending to the right.

RHYS MITCHELL

For and on Behalf of

MORRISON GEOTECHNIC PTY LIMITED

Encl: Marked Up Site Pan

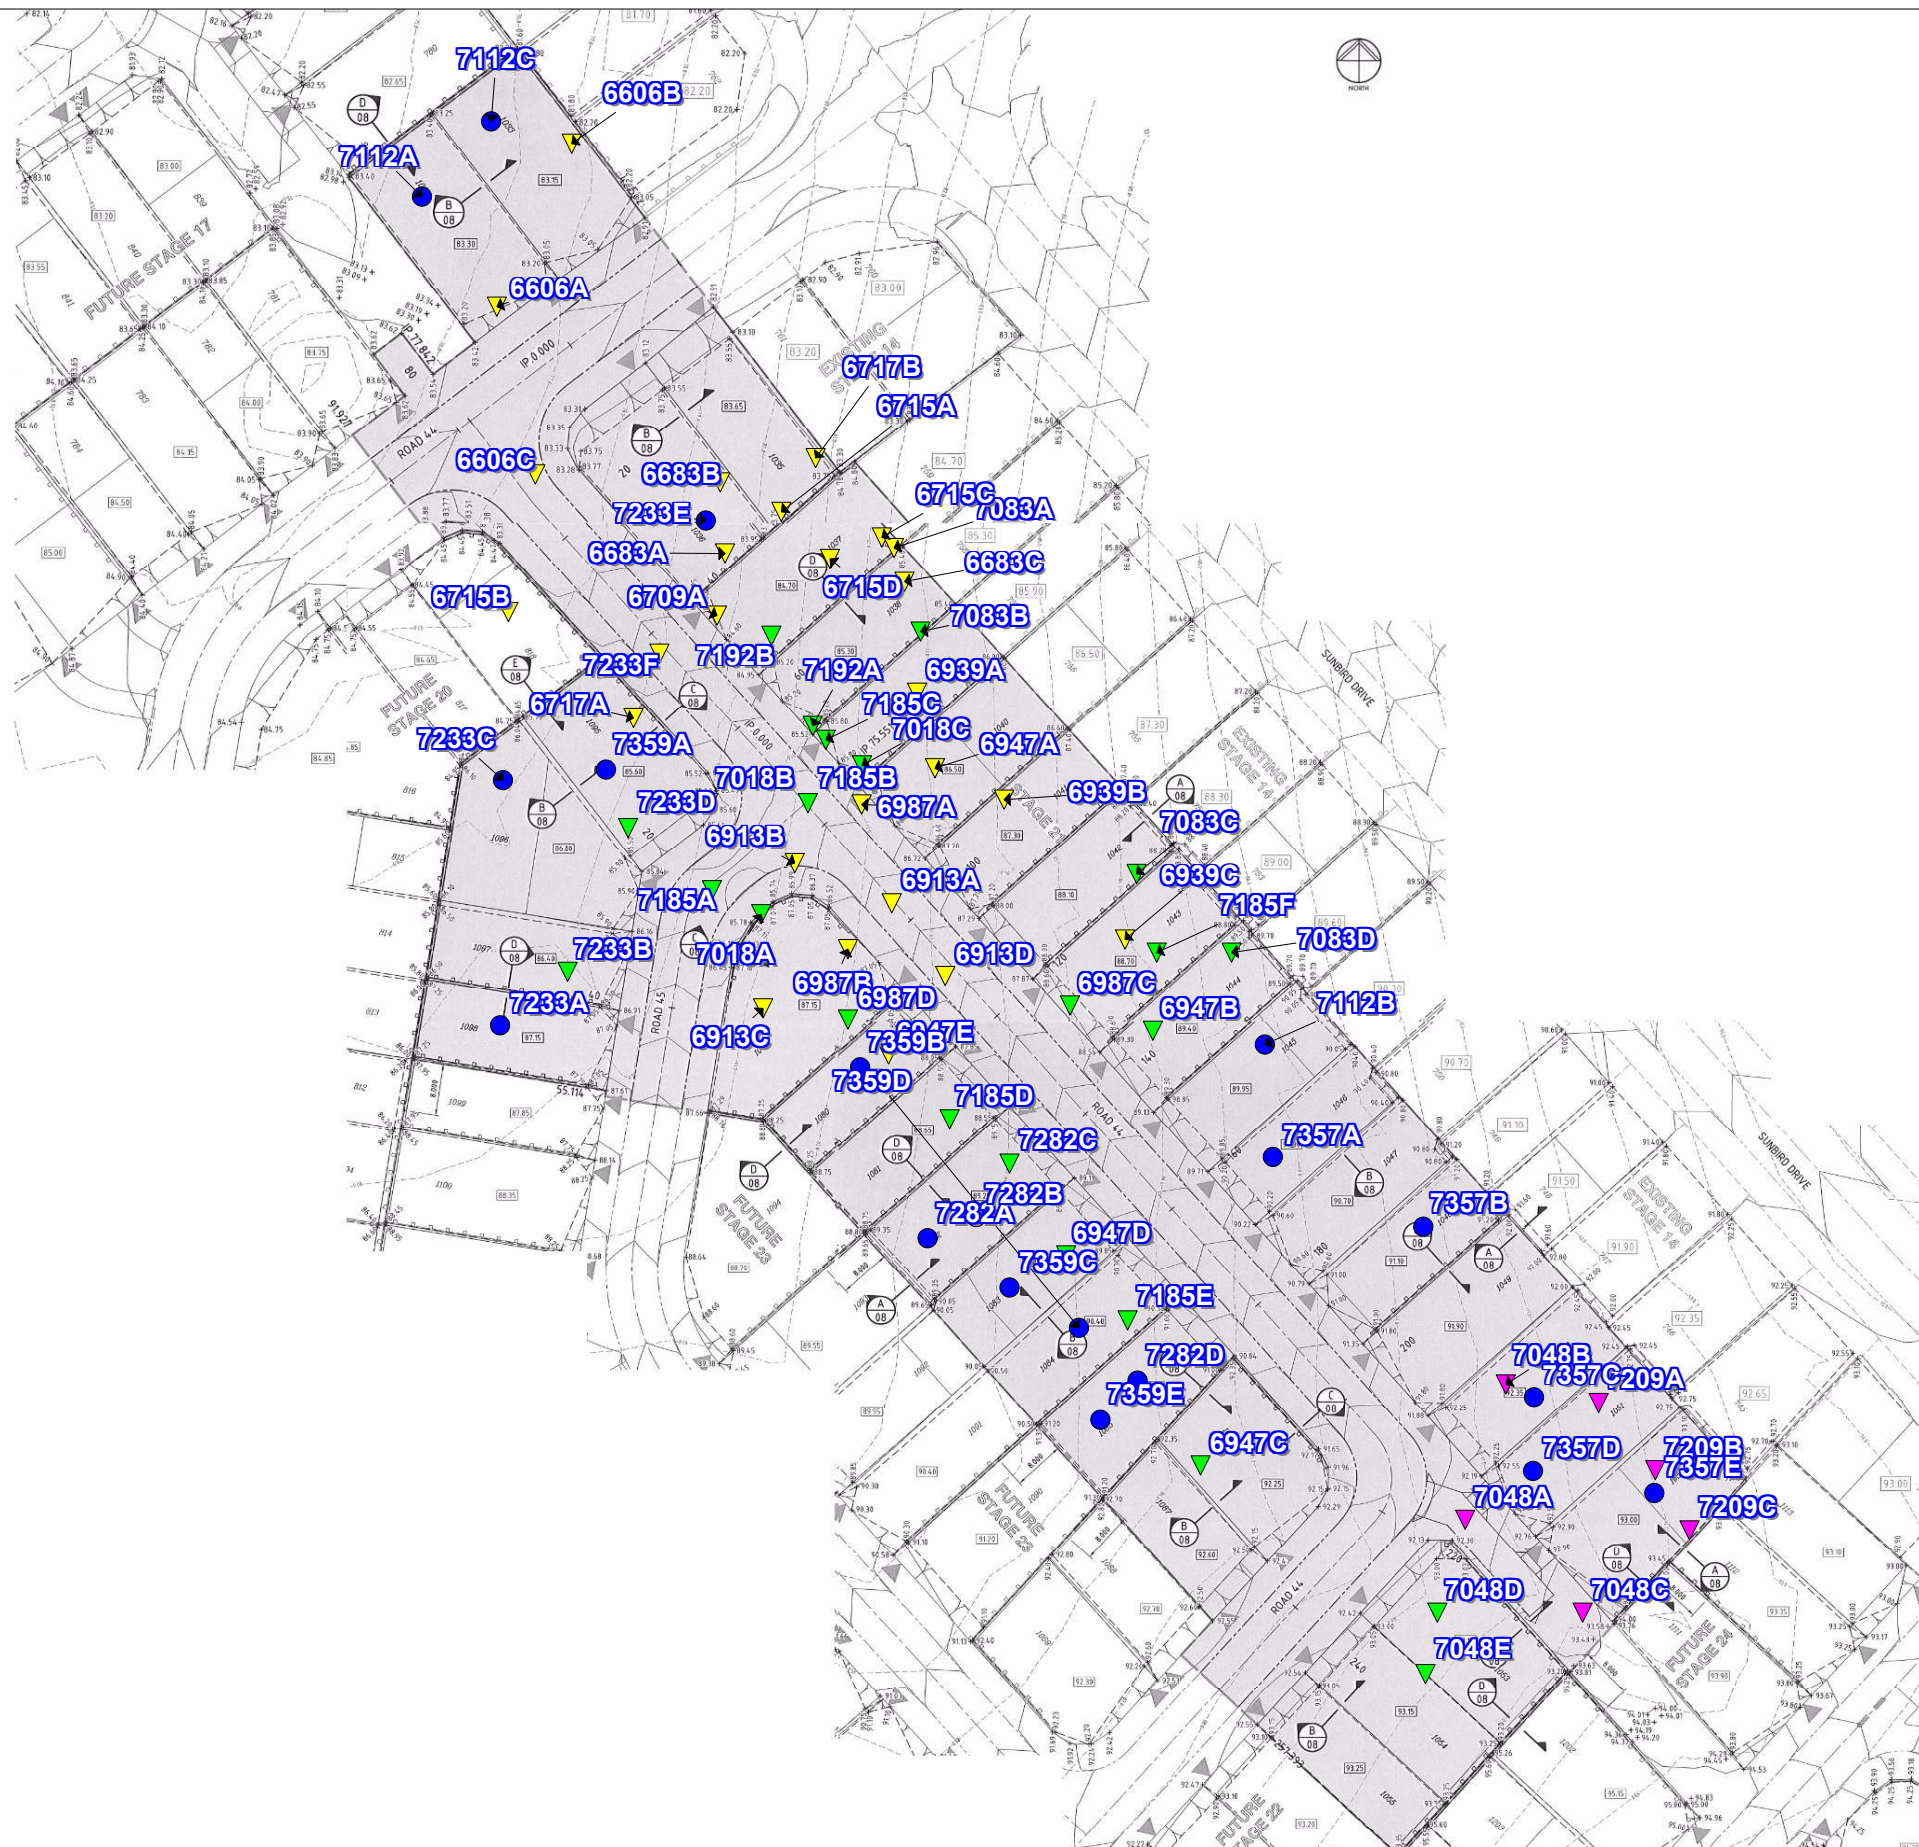

MORRISON GEOTECHNIC PTY LTD

ABN: 51 009 878 899

Unit 1/ 35 Limestone St, Darra 4076 Ph: 3279 0900
 Email: brisbanelab@morrisongeo.com.au

Engineers: M. Ballard
 D. Dragun
 Geologists: R. Howchin
 Laboratory: M. Morrison

LEGEND

- ▼ R.L 80.0 - 84.99
- ▼ R.L 85.0 - 89.99
- ▼ R.L 90.0 - 94.99
- Final Level

Map Description :	EARTHWORKS FIELD DENSITY TESTING - Level 1 Inspection		
Client :	SHADFORTHS PTY LTD		
Project :	EDENS CROSSING - STAGE 21		
Project No :	DL20/027	Drawing No :	DL20/027 - 01
		Scale :	Not to Scale



MORRISON GEOTECHNIC PTY LTD

ABN: 51 009 878 899

Unit 1/ 35 Limestone St, Darra 4076 Ph: 3279 0900
 Email: brisbanelab@morrisongeo.com.au Fax: 3279 0955

Engineers: D.Riley, J. Daly
 D.Dragun, & S.Wynne
 Geologists: L.Bexley & R.Howchin
 Laboratory: M.Morrison

LEGEND

- ▼ R.L 77.0 - 78.99
- ▼ R.L 79.0 - 80.99
- ▼ R.L 81.0 - 82.99
- ▼ R.L 83.0 - 84.99
- Final Level

Map Description :	EARTHWORKS FIELD DENSITY TESTING - Level 1 Inspection		
Client :	CCA WINSLOW		
Project :	EDENS CROSSING, FUTURE STAGES 15-20		
Project No :	DL17/398	Drawing No :	DL17/398 - 01
		Scale :	Not to Scale

Brisbane Office
Job Number: DL20/027
Ref No: 16151
Author: R. Mitchell

22nd April 2020

Shadforths Civil Pty Ltd
99 Sandalwood Lane
Forest Glen 4556

ATTENTION: MR MICHAEL PRITCHARD
Email: Michael.Pritchard@shadcivil.com.au

Dear Sir,

**RE: LOT 1038
LEVEL ONE COMPLIANCE REPORT FOR
EARTHWORKS FILL CONSTRUCTION
EDENS CROSSING STAGE 21**

Earthworks filling operations were carried out on Lot 1038 at the above Development to form a working platform to support a future residential building.

Earthworks were constructed by CCA Winslow (The Client) between May 2017 and March 2018 and Shadforths Civil (The Client) between January 2020 and March 2020.

This report should be read in conjunction with Morrison Geotechnic Report "16058 – DL20/027 Shadforths – Level One Compliance Report – Eden's Crossing Stage 21" Dated 21st April 2020. The Brief from the Client for was limited to:

- Level One Inspection of the placement and compaction of fill materials in accordance with AS3798 2007 – "Guidelines on Earthworks for Commercial and Residential Developments"
- Relative Density Control Testing in accordance with AS1289 – Testing of Soils for Engineering Purposes and at frequencies required in AS3798 Table 8.
- Ipswich City Council Specifications.
- Notes on KN Group Pty Ltd Civil Drawings.

Level One Inspections and Testing was carried out on the stripped ground surfaces and during the placement and compaction of fill materials. Field and laboratory testing included proof roll testing of the stripped surface and compaction testing.

Compaction testing at the Eden's Crossing Stage 21 Development was carried out at a frequency of 1 test per 500m³ of placed and compacted fill as defined in AS3798 Table 8.1. Test locations were selected using Random Stratified methods. Compaction testing was carried out at frequencies representative of the fill volume as a mass. On this basis, compaction testing was not required on each individual Lot.

A marked-up site plan shown the location of compaction testing is attached.

Fill constructed on Lot 1038 has been observed to be placed and compacted in accordance with the Brief. The fill on Lot 1038 can be termed as "Controlled Fill" in accordance with AS 2870-2011 "Residential Slabs and Footings".

This statement does not include any topsoil, which may have been placed for use as Lot dressing or any other subsequent earthworks after March 2020.

If there are any queries concerning the above please do not hesitate to contact this office, or alternatively send to my email at mickmorrison@morrisongeo.com.au.

Yours faithfully,


A handwritten signature in grey ink, appearing to read 'Rhys Mitchell', with a horizontal line extending to the right.

RHYS MITCHELL

For and on Behalf of

MORRISON GEOTECHNIC PTY LIMITED

Encl: Marked Up Site Pan

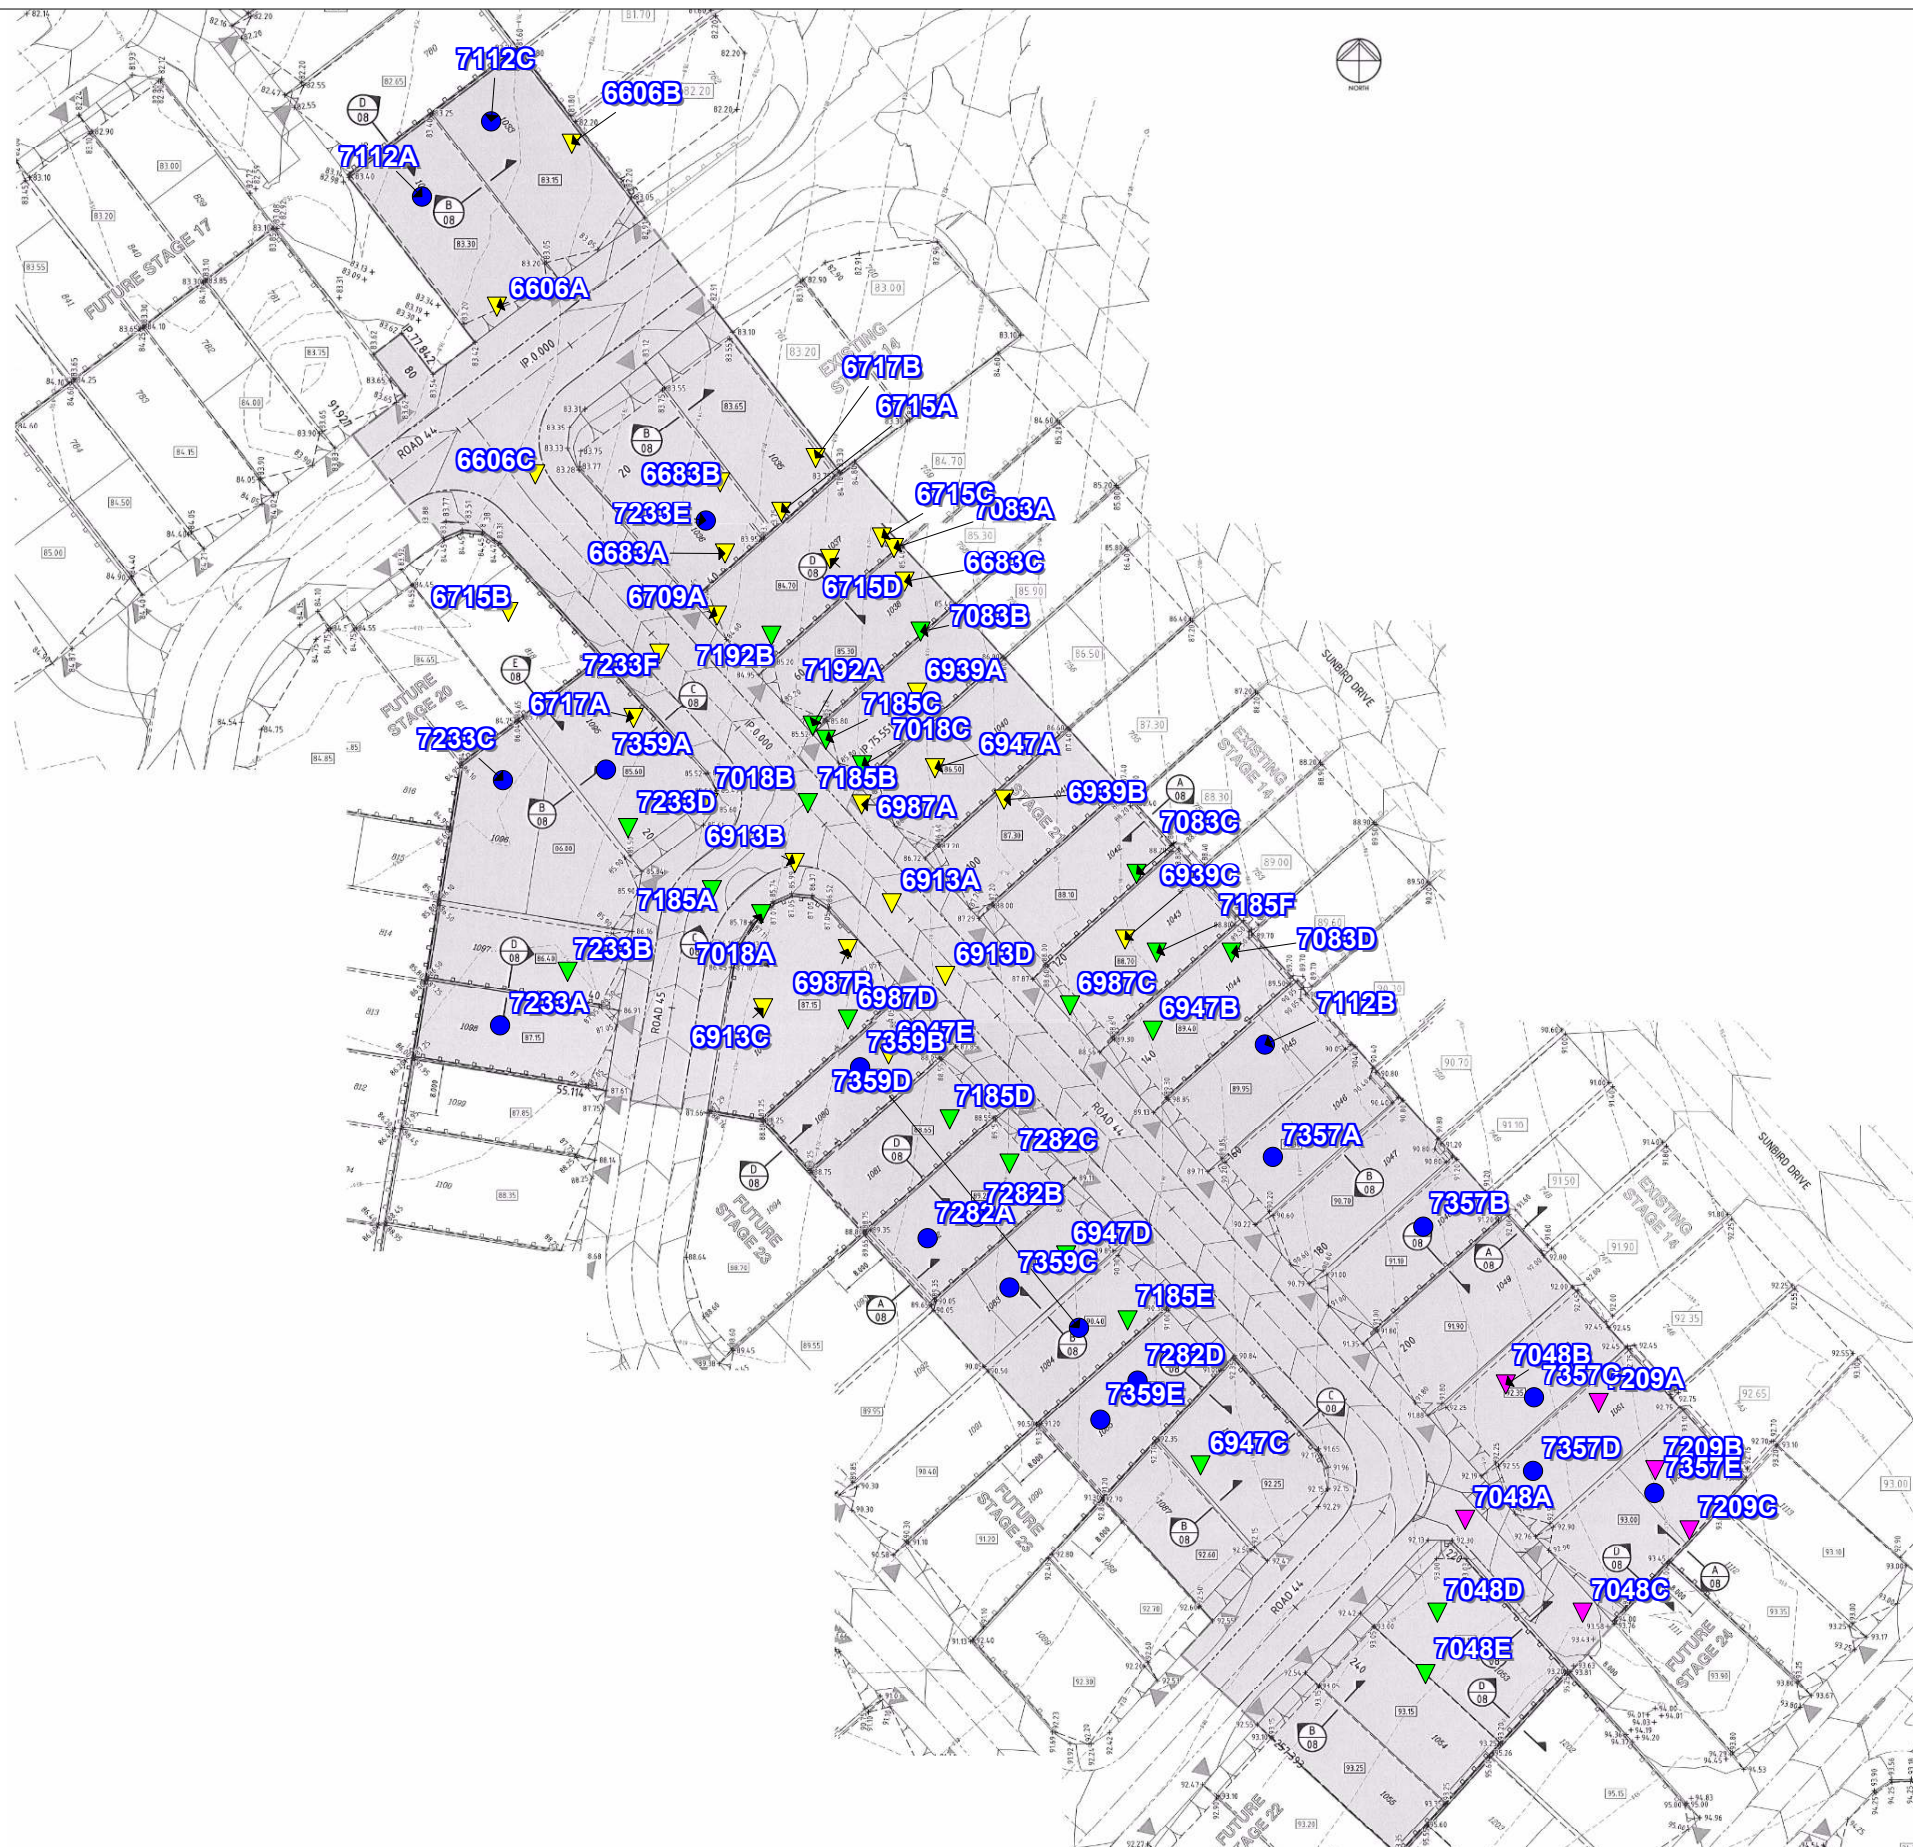

MORRISON GEOTECHNIC PTY LTD

ABN: 51 009 878 899

Unit 1/ 35 Limestone St, Darra 4076 Ph: 3279 0900
 Email: brisbanelab@morrisongeo.com.au

Engineers: M. Ballard
 D. Dragun
 Geologists: R. Howchin
 Laboratory: M. Morrison

LEGEND

- ▼ R.L 80.0 - 84.99
- ▼ R.L 85.0 - 89.99
- ▼ R.L 90.0 - 94.99
- Final Level

Map Description :	EARTHWORKS FIELD DENSITY TESTING - Level 1 Inspection		
Client :	SHADFORTHS PTY LTD		
Project :	EDENS CROSSING - STAGE 21		
Project No :	DL20/027	Drawing No :	DL20/027 - 01
		Scale :	Not to Scale



MORRISON GEOTECHNIC PTY LTD

ABN: 51 009 878 899

Unit 1/ 35 Limestone St, Darra 4076 Ph: 3279 0900
 Email: brisbanelab@morrisongeo.com.au Fax: 3279 0955

Engineers: D.Riley, J. Daly
 D.Dragun, & S.Wynne
 Geologists: L.Bexley & R.Howchin
 Laboratory: M.Morrison

LEGEND

- ▼ R.L 77.0 - 78.99
- ▼ R.L 79.0 - 80.99
- ▼ R.L 81.0 - 82.99
- ▼ R.L 83.0 - 84.99
- Final Level

Map Description :	EARTHWORKS FIELD DENSITY TESTING - Level 1 Inspection		
Client :	CCA WINSLOW		
Project :	EDENS CROSSING, FUTURE STAGES 15-20		
Project No :	DL17/398	Drawing No :	DL17/398 - 01
		Scale :	Not to Scale

Brisbane Office
Job Number: DL20/027
Ref No: 16152
Author: R. Mitchell

22nd April 2020

Shadforths Civil Pty Ltd
99 Sandalwood Lane
Forest Glen 4556

ATTENTION: MR MICHAEL PRITCHARD
Email: Michael.Pritchard@shadcivil.com.au

Dear Sir,

**RE: LOT 1039
LEVEL ONE COMPLIANCE REPORT FOR
EARTHWORKS FILL CONSTRUCTION
EDENS CROSSING STAGE 21**

Earthworks filling operations were carried out on Lot 1039 at the above Development to form a working platform to support a future residential building.

Earthworks were constructed by CCA Winslow (The Client) between May 2017 and March 2018 and Shadforths Civil (The Client) between January 2020 and March 2020.

This report should be read in conjunction with Morrison Geotechnic Report “16058 – DL20/027 Shadforths – Level One Compliance Report – Eden’s Crossing Stage 21” Dated 21st April 2020. The Brief from the Client for was limited to:

- Level One Inspection of the placement and compaction of fill materials in accordance with AS3798 2007 – “Guidelines on Earthworks for Commercial and Residential Developments”
- Relative Density Control Testing in accordance with AS1289 – Testing of Soils for Engineering Purposes and at frequencies required in AS3798 Table 8.
- Ipswich City Council Specifications.
- Notes on KN Group Pty Ltd Civil Drawings.

Level One Inspections and Testing was carried out on the stripped ground surfaces and during the placement and compaction of fill materials. Field and laboratory testing included proof roll testing of the stripped surface and compaction testing.

Compaction testing at the Eden’s Crossing Stage 21 Development was carried out at a frequency of 1 test per 500m³ of placed and compacted fill as defined in AS3798 Table 8.1. Test locations were selected using Random Stratified methods. Compaction testing was carried out at frequencies representative of the fill volume as a mass. On this basis, compaction testing was not required on each individual Lot.

A marked-up site plan shown the location of compaction testing is attached.

Fill constructed on Lot 1039 has been observed to be placed and compacted in accordance with the Brief. The fill on Lot 1039 can be termed as "Controlled Fill" in accordance with AS 2870-2011 "Residential Slabs and Footings".

This statement does not include any topsoil, which may have been placed for use as Lot dressing or any other subsequent earthworks after March 2020.

If there are any queries concerning the above please do not hesitate to contact this office, or alternatively send to my email at mickmorrison@morrisongeo.com.au.

Yours faithfully,


A handwritten signature in grey ink, appearing to read 'Rhys Mitchell', with a horizontal line extending to the right.

RHYS MITCHELL

For and on Behalf of

MORRISON GEOTECHNIC PTY LIMITED

Encl: Marked Up Site Pan

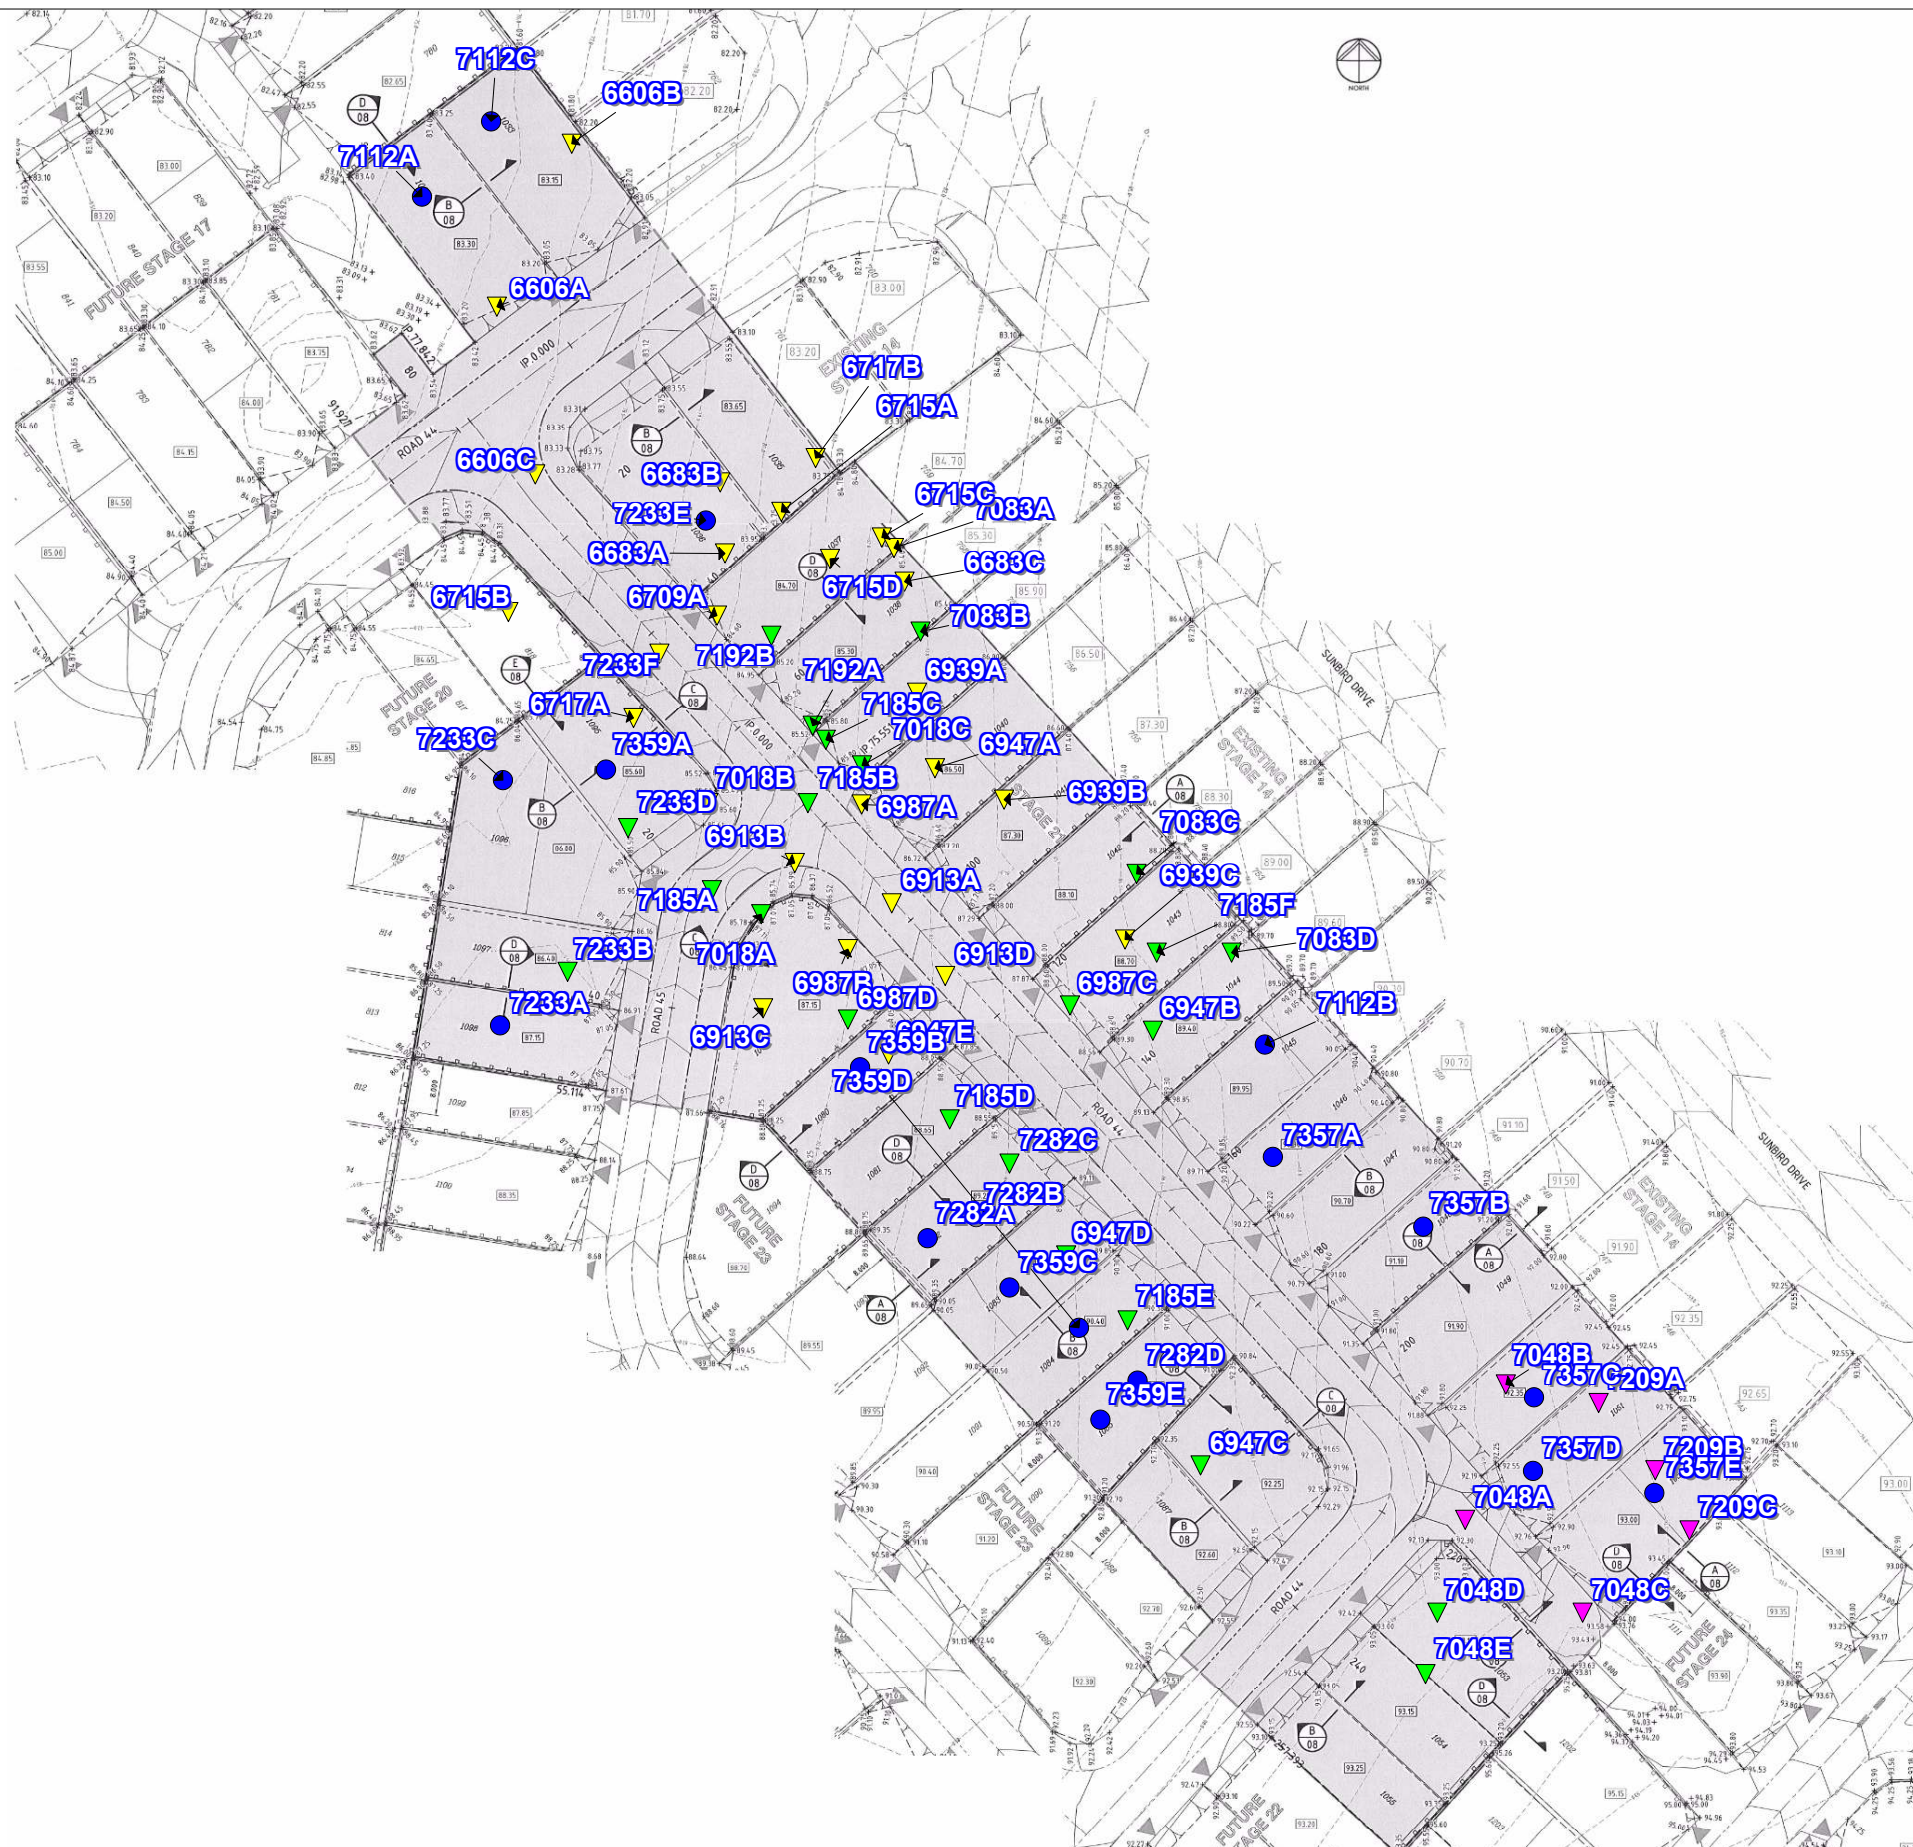

MORRISON GEOTECHNIC PTY LTD

ABN: 51 009 878 899

Unit 1/ 35 Limestone St, Darra 4076 Ph: 3279 0900
 Email: brisbanelab@morrisongeo.com.au

Engineers: M. Ballard
 D. Dragun
 Geologists: R. Howchin
 Laboratory: M. Morrison

LEGEND

- ▼ R.L 80.0 - 84.99
- ▼ R.L 85.0 - 89.99
- ▼ R.L 90.0 - 94.99
- Final Level

Map Description :	EARTHWORKS FIELD DENSITY TESTING - Level 1 Inspection		
Client :	SHADFORTHS PTY LTD		
Project :	EDENS CROSSING - STAGE 21		
Project No :	DL20/027	Drawing No :	DL20/027 - 01
		Scale :	Not to Scale



MORRISON GEOTECHNIC PTY LTD

ABN: 51 009 878 899

Unit 1/ 35 Limestone St, Darra 4076 Ph: 3279 0900
 Email: brisbanelab@morrisongeo.com.au Fax: 3279 0955

Engineers: D.Riley, J. Daly
 D.Dragun, & S.Wynne
 Geologists: L.Bexley & R.Howchin
 Laboratory: M.Morrison

LEGEND

- ▼ R.L 77.0 - 78.99
- ▼ R.L 79.0 - 80.99
- ▼ R.L 81.0 - 82.99
- ▼ R.L 83.0 - 84.99
- Final Level

Map Description :	EARTHWORKS FIELD DENSITY TESTING - Level 1 Inspection		
Client :	CCA WINSLOW		
Project :	EDENS CROSSING, FUTURE STAGES 15-20		
Project No :	DL17/398	Drawing No :	DL17/398 - 01
		Scale :	Not to Scale

Brisbane Office
Job Number: DL20/027
Ref No: 16153
Author: R. Mitchell

22nd April 2020

Shadforths Civil Pty Ltd
99 Sandalwood Lane
Forest Glen 4556

ATTENTION: MR MICHAEL PRITCHARD
Email: Michael.Pritchard@shadcivil.com.au

Dear Sir,

**RE: LOT 1040
LEVEL ONE COMPLIANCE REPORT FOR
EARTHWORKS FILL CONSTRUCTION
EDENS CROSSING STAGE 21**

Earthworks filling operations were carried out on Lot 1040 at the above Development to form a working platform to support a future residential building.

Earthworks were constructed by CCA Winslow (The Client) between May 2017 and March 2018 and Shadforths Civil (The Client) between January 2020 and March 2020.

This report should be read in conjunction with Morrison Geotechnic Report “16058 – DL20/027 Shadforths – Level One Compliance Report – Eden’s Crossing Stage 21” Dated 21st April 2020. The Brief from the Client for was limited to:

- Level One Inspection of the placement and compaction of fill materials in accordance with AS3798 2007 – “Guidelines on Earthworks for Commercial and Residential Developments”
- Relative Density Control Testing in accordance with AS1289 – Testing of Soils for Engineering Purposes and at frequencies required in AS3798 Table 8.
- Ipswich City Council Specifications.
- Notes on KN Group Pty Ltd Civil Drawings.

Level One Inspections and Testing was carried out on the stripped ground surfaces and during the placement and compaction of fill materials. Field and laboratory testing included proof roll testing of the stripped surface and compaction testing.

Compaction testing at the Eden’s Crossing Stage 21 Development was carried out at a frequency of 1 test per 500m³ of placed and compacted fill as defined in AS3798 Table 8.1. Test locations were selected using Random Stratified methods. Compaction testing was carried out at frequencies representative of the fill volume as a mass. On this basis, compaction testing was not required on each individual Lot.

A marked-up site plan shown the location of compaction testing is attached.

Fill constructed on Lot 1040 has been observed to be placed and compacted in accordance with the Brief. The fill on Lot 1040 can be termed as "Controlled Fill" in accordance with AS 2870-2011 "Residential Slabs and Footings".

This statement does not include any topsoil, which may have been placed for use as Lot dressing or any other subsequent earthworks after March 2020.

If there are any queries concerning the above please do not hesitate to contact this office, or alternatively send to my email at mickmorrison@morrisongeo.com.au.

Yours faithfully,


A handwritten signature in grey ink, appearing to read 'Rhys Mitchell', with a horizontal line extending to the right.

RHYS MITCHELL

For and on Behalf of

MORRISON GEOTECHNIC PTY LIMITED

Encl: Marked Up Site Pan

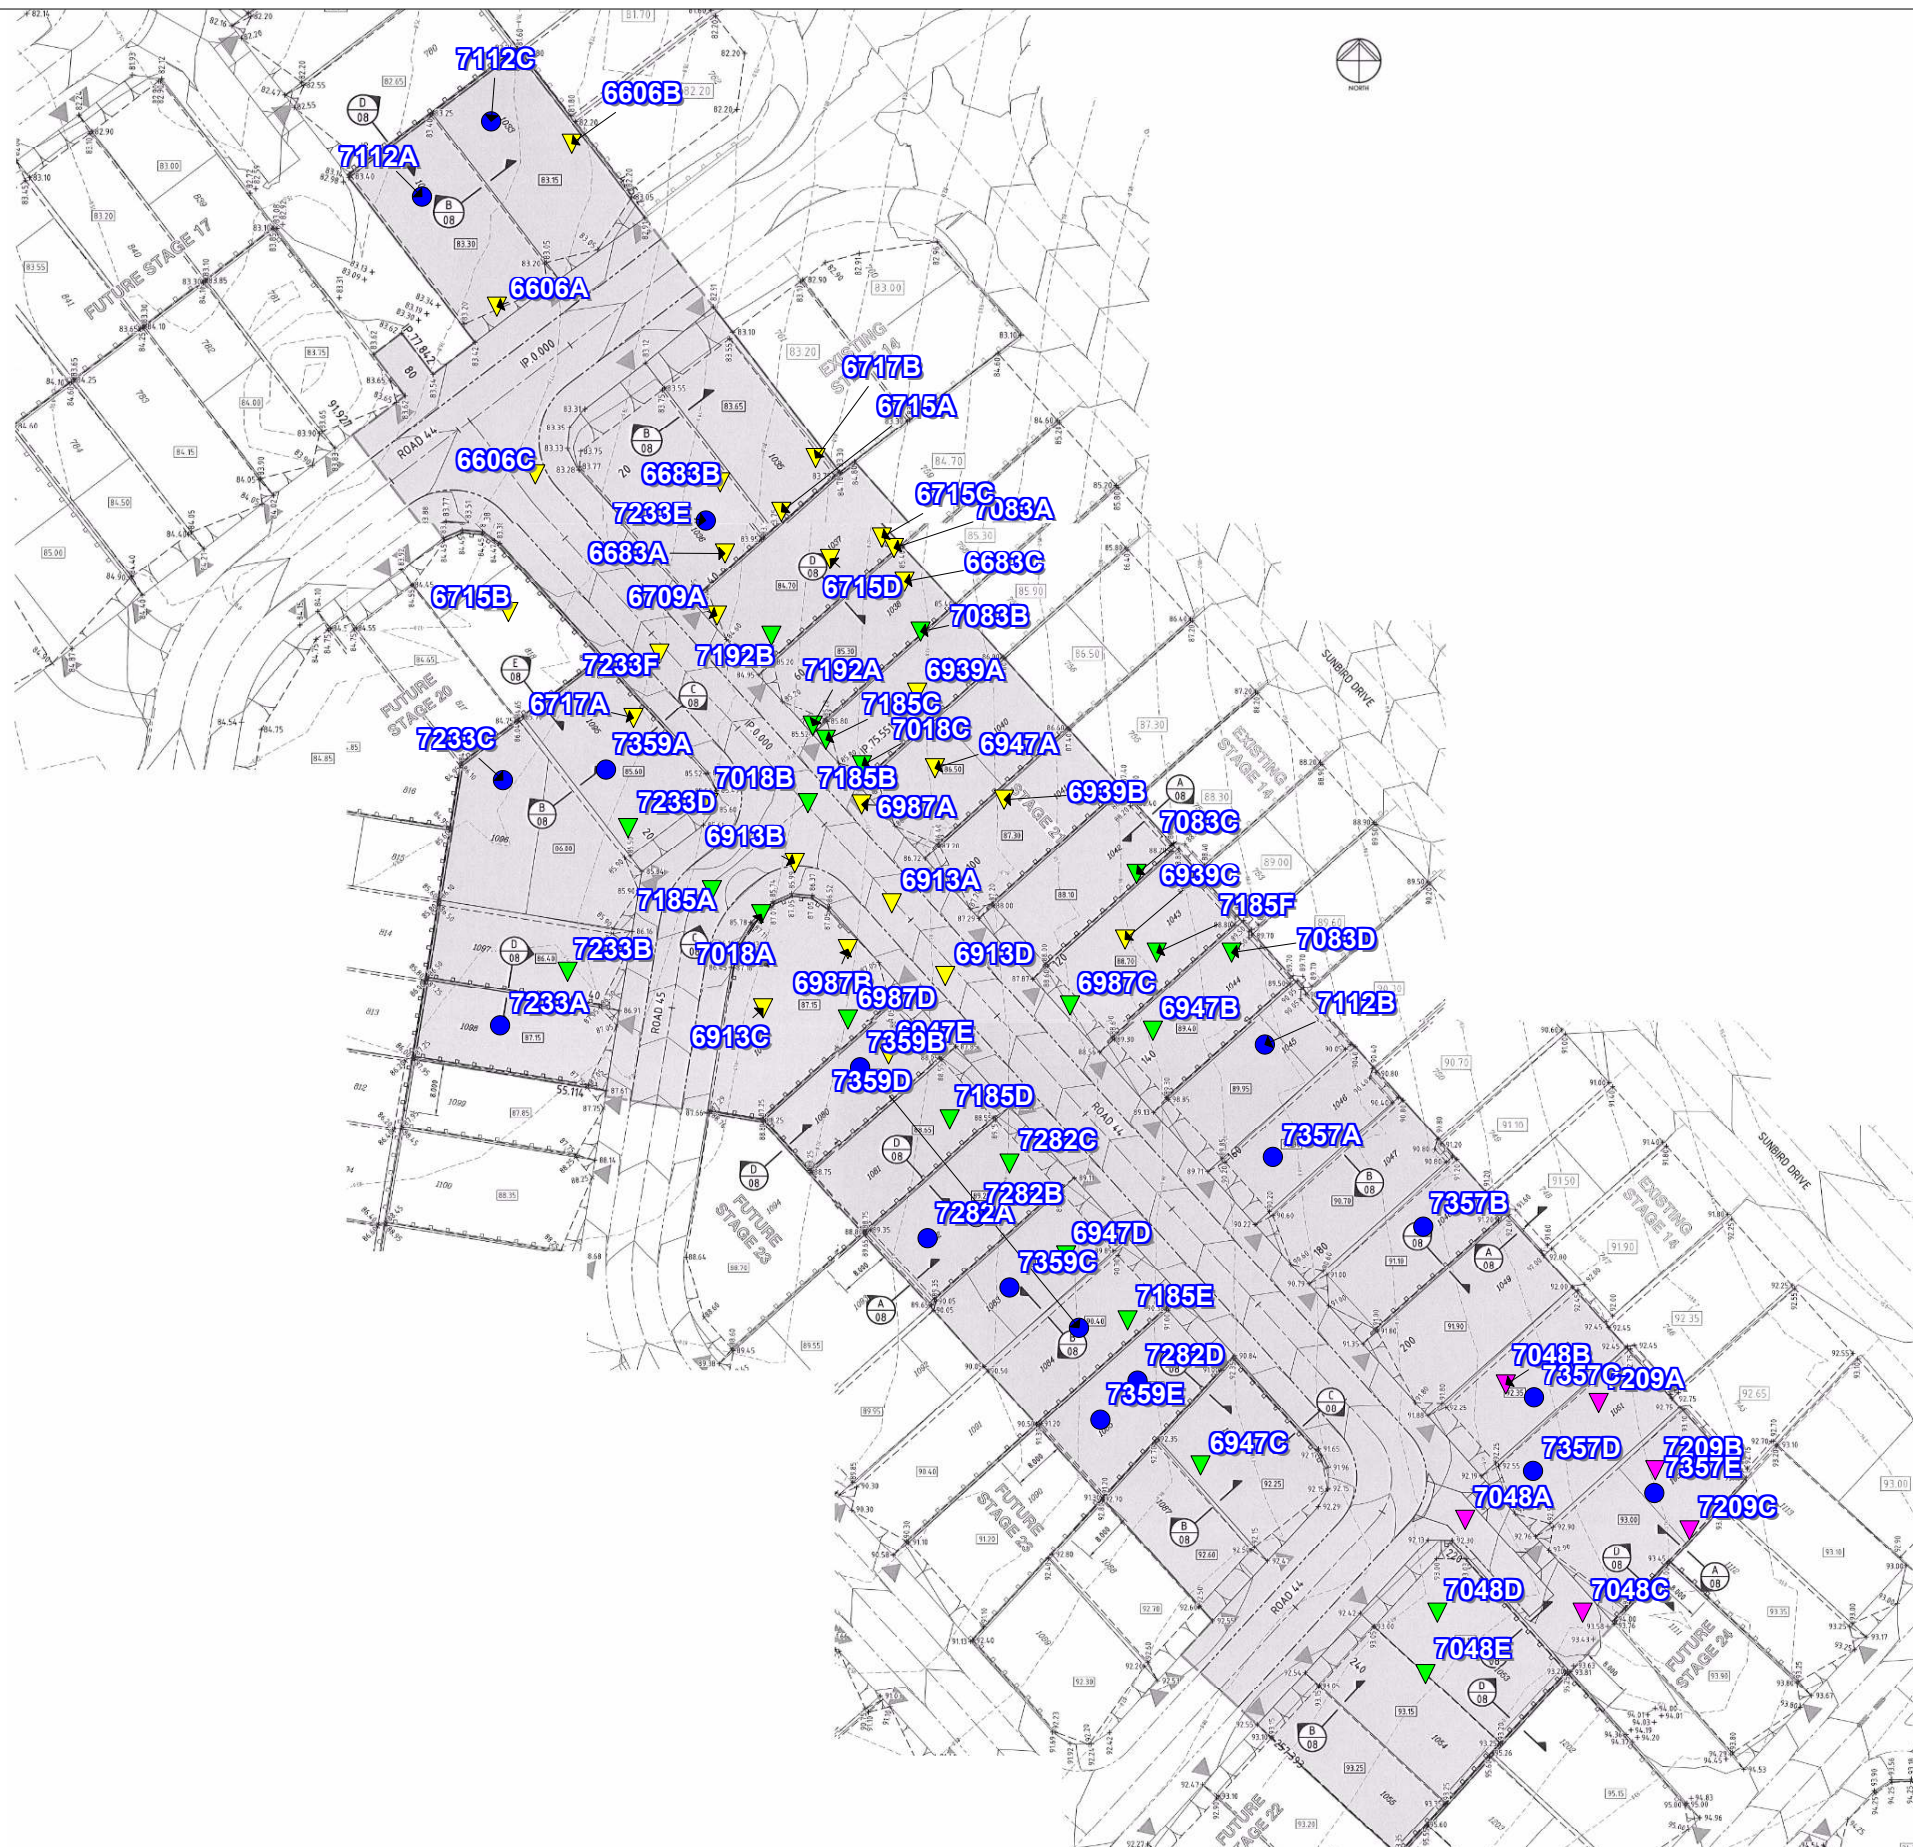

MORRISON GEOTECHNIC PTY LTD

ABN: 51 009 878 899

Unit 1/ 35 Limestone St, Darra 4076 Ph: 3279 0900
 Email: brisbanelab@morrisongeo.com.au

Engineers: M. Ballard
 D. Dragun
 Geologists: R. Howchin
 Laboratory: M. Morrison

LEGEND

- ▼ R.L 80.0 - 84.99
- ▼ R.L 85.0 - 89.99
- ▼ R.L 90.0 - 94.99
- Final Level

Map Description :	EARTHWORKS FIELD DENSITY TESTING - Level 1 Inspection		
Client :	SHADFORTHS PTY LTD		
Project :	EDENS CROSSING - STAGE 21		
Project No :	DL20/027	Drawing No :	DL20/027 - 01
		Scale :	Not to Scale



MORRISON GEOTECHNIC PTY LTD

ABN: 51 009 878 899

Unit 1/ 35 Limestone St, Darra 4076 Ph: 3279 0900
 Email: brisbanelab@morrisongeo.com.au Fax: 3279 0955

Engineers: D.Riley, J. Daly
 D.Dragun, & S.Wynne
 Geologists: L.Bexley & R.Howchin
 Laboratory: M.Morrison

LEGEND

- ▼ R.L 77.0 - 78.99
- ▼ R.L 79.0 - 80.99
- ▼ R.L 81.0 - 82.99
- ▼ R.L 83.0 - 84.99
- Final Level

Map Description :	EARTHWORKS FIELD DENSITY TESTING - Level 1 Inspection		
Client :	CCA WINSLOW		
Project :	EDENS CROSSING, FUTURE STAGES 15-20		
Project No :	DL17/398	Drawing No :	DL17/398 - 01
		Scale :	Not to Scale

Brisbane Office
Job Number: DL20/027
Ref No: 16154
Author: R. Mitchell

22nd April 2020

Shadforths Civil Pty Ltd
99 Sandalwood Lane
Forest Glen 4556

ATTENTION: MR MICHAEL PRITCHARD
Email: Michael.Pritchard@shadcivil.com.au

Dear Sir,

**RE: LOT 1041
LEVEL ONE COMPLIANCE REPORT FOR
EARTHWORKS FILL CONSTRUCTION
EDENS CROSSING STAGE 21**

Earthworks filling operations were carried out on Lot 1041 at the above Development to form a working platform to support a future residential building.

Earthworks were constructed by CCA Winslow (The Client) between May 2017 and March 2018 and Shadforths Civil (The Client) between January 2020 and March 2020.

This report should be read in conjunction with Morrison Geotechnic Report “16058 – DL20/027 Shadforths – Level One Compliance Report – Eden’s Crossing Stage 21” Dated 21st April 2020. The Brief from the Client for was limited to:

- Level One Inspection of the placement and compaction of fill materials in accordance with AS3798 2007 – “Guidelines on Earthworks for Commercial and Residential Developments”
- Relative Density Control Testing in accordance with AS1289 – Testing of Soils for Engineering Purposes and at frequencies required in AS3798 Table 8.
- Ipswich City Council Specifications.
- Notes on KN Group Pty Ltd Civil Drawings.

Level One Inspections and Testing was carried out on the stripped ground surfaces and during the placement and compaction of fill materials. Field and laboratory testing included proof roll testing of the stripped surface and compaction testing.

Compaction testing at the Eden’s Crossing Stage 21 Development was carried out at a frequency of 1 test per 500m³ of placed and compacted fill as defined in AS3798 Table 8.1. Test locations were selected using Random Stratified methods. Compaction testing was carried out at frequencies representative of the fill volume as a mass. On this basis, compaction testing was not required on each individual Lot.

A marked-up site plan shown the location of compaction testing is attached.

Fill constructed on Lot 1041 has been observed to be placed and compacted in accordance with the Brief. The fill on Lot 1041 can be termed as "Controlled Fill" in accordance with AS 2870-2011 "Residential Slabs and Footings".

This statement does not include any topsoil, which may have been placed for use as Lot dressing or any other subsequent earthworks after March 2020.

If there are any queries concerning the above please do not hesitate to contact this office, or alternatively send to my email at mickmorrison@morrisongeo.com.au.

Yours faithfully,


A handwritten signature in grey ink, appearing to read 'Rhys Mitchell', with a horizontal line extending to the right.

RHYS MITCHELL

For and on Behalf of

MORRISON GEOTECHNIC PTY LIMITED

Encl: Marked Up Site Pan

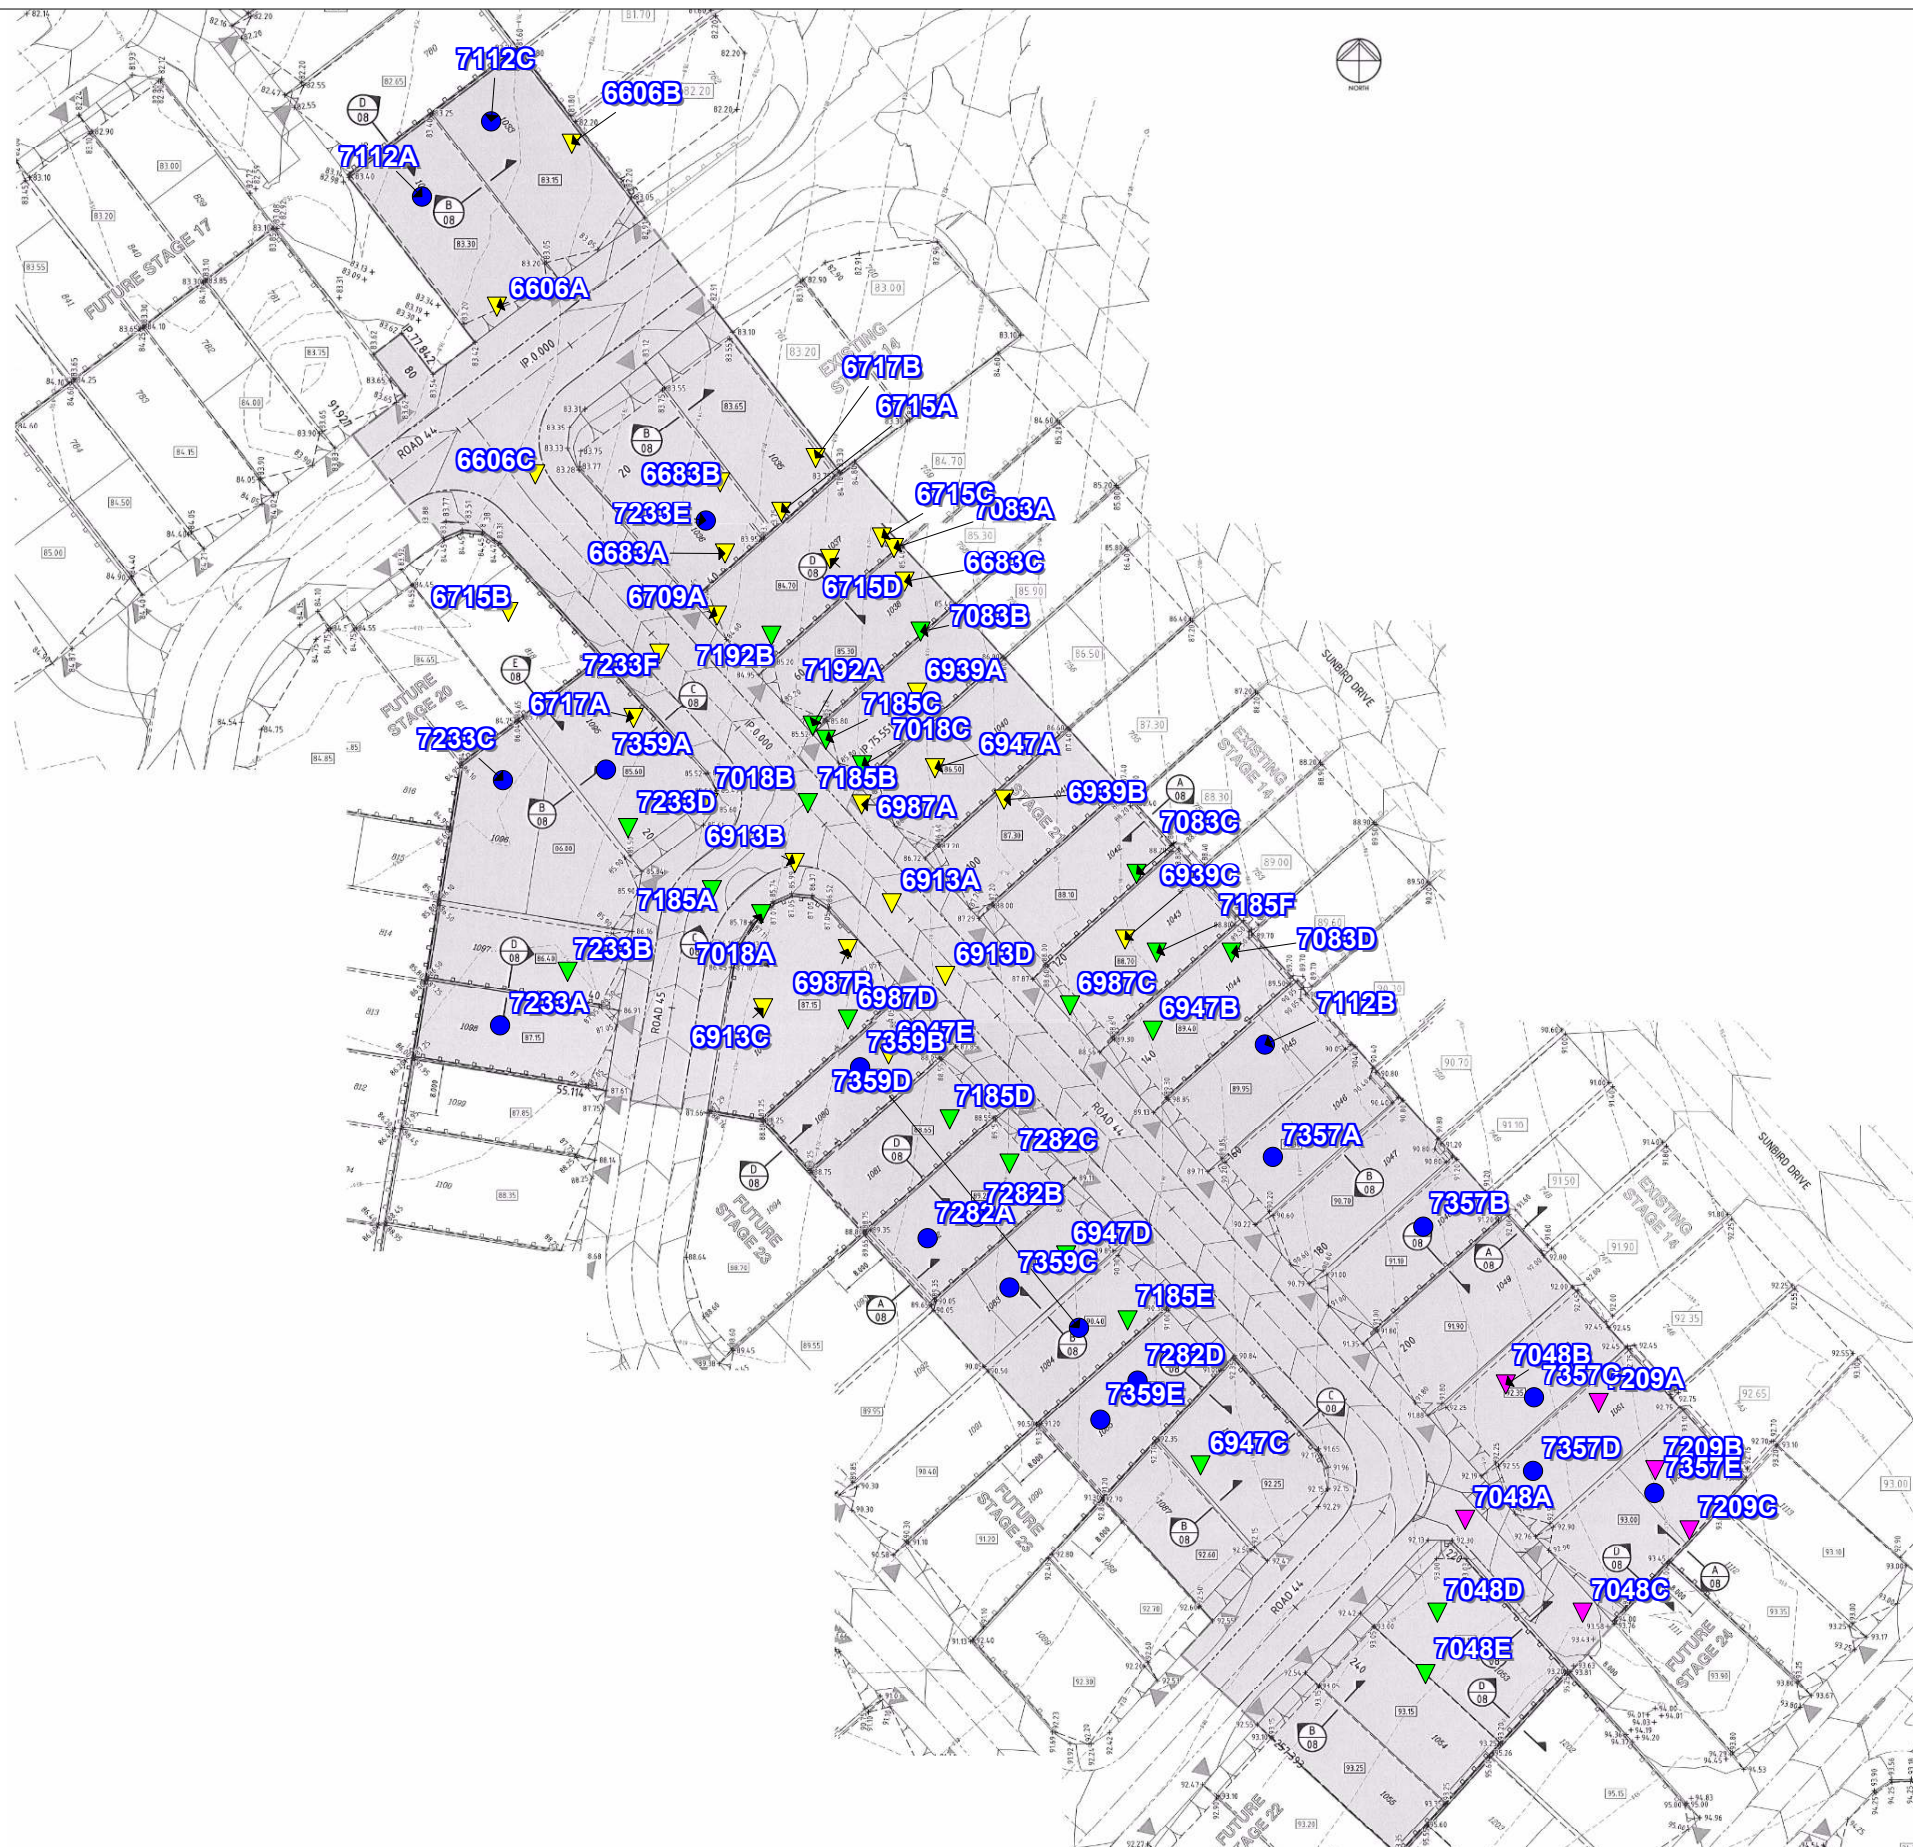

MORRISON GEOTECHNIC PTY LTD

ABN: 51 009 878 899

Unit 1/ 35 Limestone St, Darra 4076 Ph: 3279 0900
 Email: brisbanelab@morrisongeo.com.au

Engineers: M. Ballard
 D. Dragun
 Geologists: R. Howchin
 Laboratory: M. Morrison

LEGEND

- ▼ R.L 80.0 - 84.99
- ▼ R.L 85.0 - 89.99
- ▼ R.L 90.0 - 94.99
- Final Level

Map Description :	EARTHWORKS FIELD DENSITY TESTING - Level 1 Inspection		
Client :	SHADFORTHS PTY LTD		
Project :	EDENS CROSSING - STAGE 21		
Project No :	DL20/027	Drawing No :	DL20/027 - 01
		Scale :	Not to Scale



MORRISON GEOTECHNIC PTY LTD

ABN: 51 009 878 899

Unit 1/ 35 Limestone St, Darra 4076 Ph: 3279 0900
 Email: brisbanelab@morrisongeo.com.au Fax: 3279 0955

Engineers: D.Riley, J. Daly
 D.Dragun, & S.Wynne
 Geologists: L.Bexley & R.Howchin
 Laboratory: M.Morrison

LEGEND

- ▼ R.L 77.0 - 78.99
- ▼ R.L 79.0 - 80.99
- ▼ R.L 81.0 - 82.99
- ▼ R.L 83.0 - 84.99
- Final Level

Map Description :	EARTHWORKS FIELD DENSITY TESTING - Level 1 Inspection		
Client :	CCA WINSLOW		
Project :	EDENS CROSSING, FUTURE STAGES 15-20		
Project No :	DL17/398	Drawing No :	DL17/398 - 01
		Scale :	Not to Scale

Brisbane Office
Job Number: DL20/027
Ref No: 16155
Author: R. Mitchell

22nd April 2020

Shadforths Civil Pty Ltd
99 Sandalwood Lane
Forest Glen 4556

ATTENTION: MR MICHAEL PRITCHARD
Email: Michael.Pritchard@shadcivil.com.au

Dear Sir,

**RE: LOT 1042
LEVEL ONE COMPLIANCE REPORT FOR
EARTHWORKS FILL CONSTRUCTION
EDENS CROSSING STAGE 21**

Earthworks filling operations were carried out on Lot 1042 at the above Development to form a working platform to support a future residential building.

Earthworks were constructed by CCA Winslow (The Client) between May 2017 and March 2018 and Shadforths Civil (The Client) between January 2020 and March 2020.

This report should be read in conjunction with Morrison Geotechnic Report “16058 – DL20/027 Shadforths – Level One Compliance Report – Eden’s Crossing Stage 21” Dated 21st April 2020. The Brief from the Client for was limited to:

- Level One Inspection of the placement and compaction of fill materials in accordance with AS3798 2007 – “Guidelines on Earthworks for Commercial and Residential Developments”
- Relative Density Control Testing in accordance with AS1289 – Testing of Soils for Engineering Purposes and at frequencies required in AS3798 Table 8.
- Ipswich City Council Specifications.
- Notes on KN Group Pty Ltd Civil Drawings.

Level One Inspections and Testing was carried out on the stripped ground surfaces and during the placement and compaction of fill materials. Field and laboratory testing included proof roll testing of the stripped surface and compaction testing.

Compaction testing at the Eden’s Crossing Stage 21 Development was carried out at a frequency of 1 test per 500m³ of placed and compacted fill as defined in AS3798 Table 8.1. Test locations were selected using Random Stratified methods. Compaction testing was carried out at frequencies representative of the fill volume as a mass. On this basis, compaction testing was not required on each individual Lot.

A marked-up site plan shown the location of compaction testing is attached.

Fill constructed on Lot 1042 has been observed to be placed and compacted in accordance with the Brief. The fill on Lot 1042 can be termed as "Controlled Fill" in accordance with AS 2870-2011 "Residential Slabs and Footings".

This statement does not include any topsoil, which may have been placed for use as Lot dressing or any other subsequent earthworks after March 2020.

If there are any queries concerning the above please do not hesitate to contact this office, or alternatively send to my email at mickmorrison@morrisongeo.com.au.

Yours faithfully,


A handwritten signature in grey ink, appearing to read 'Rhys Mitchell', with a horizontal line extending to the right.

RHYS MITCHELL

For and on Behalf of

MORRISON GEOTECHNIC PTY LIMITED

Encl: Marked Up Site Pan

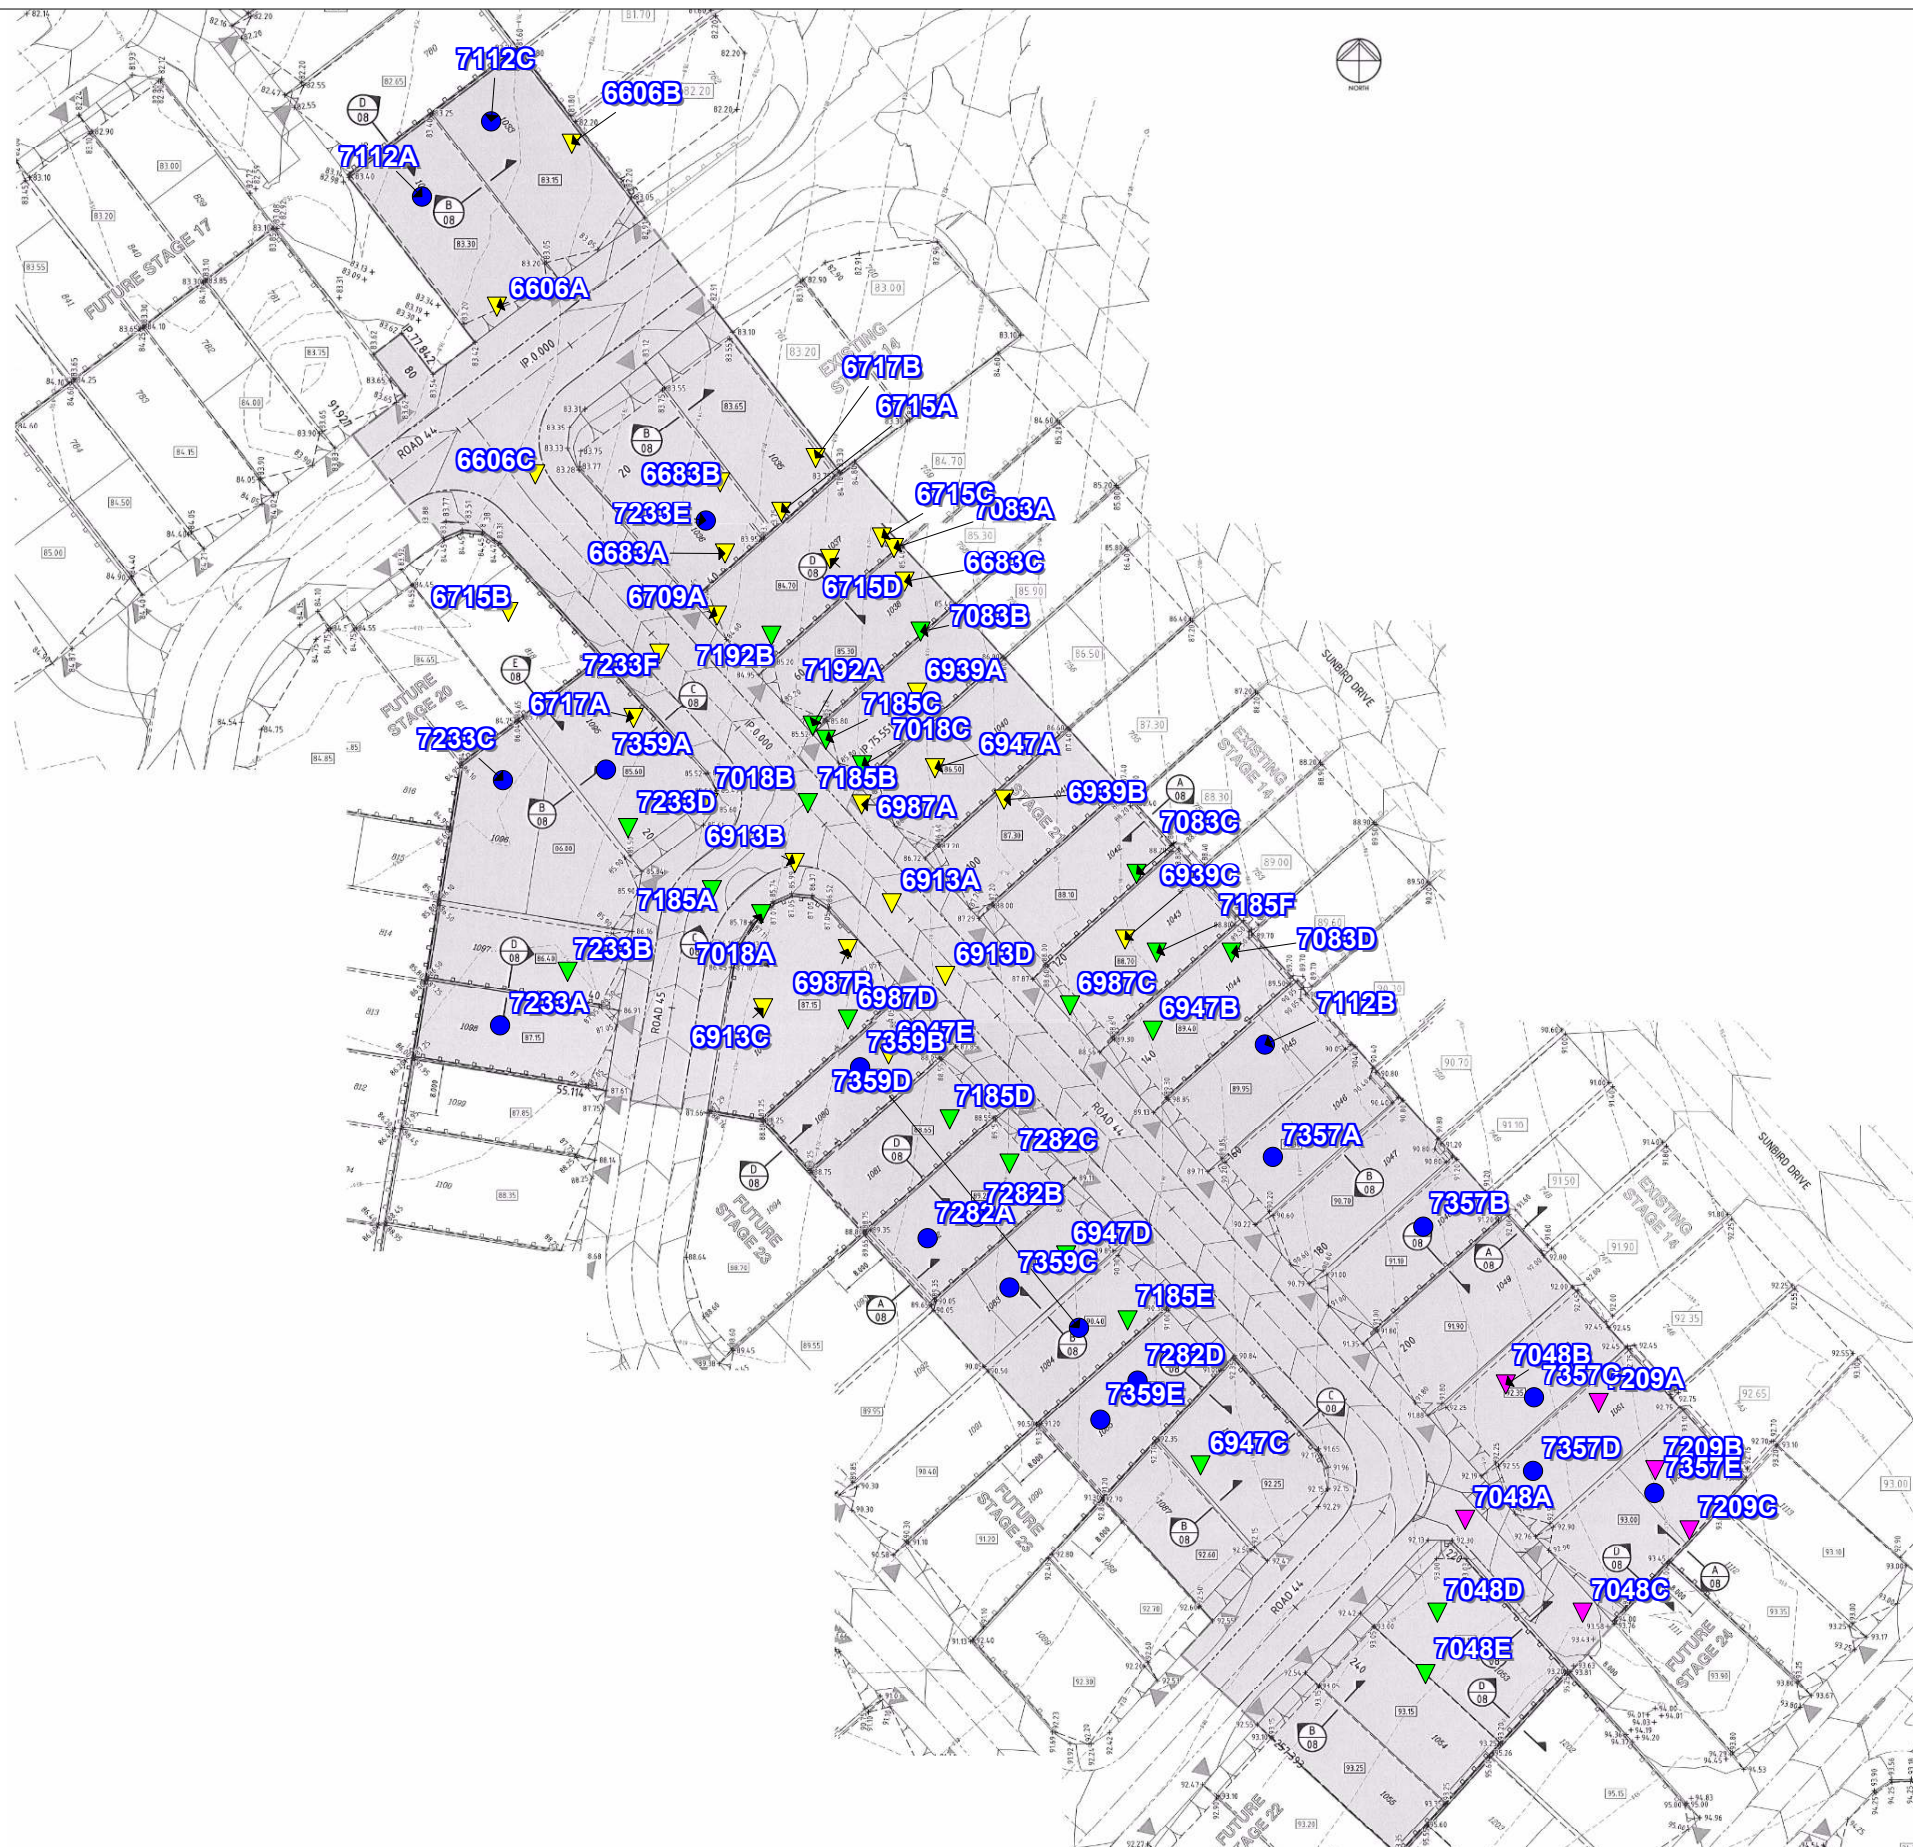

MORRISON GEOTECHNIC PTY LTD

ABN: 51 009 878 899

Unit 1/ 35 Limestone St, Darra 4076 Ph: 3279 0900
 Email: brisbanelab@morrisongeo.com.au

Engineers: M. Ballard
 D. Dragun
 Geologists: R. Howchin
 Laboratory: M. Morrison

LEGEND

- ▲ R.L 80.0 - 84.99
- ▲ R.L 85.0 - 89.99
- ▲ R.L 90.0 - 94.99
- Final Level

Map Description :	EARTHWORKS FIELD DENSITY TESTING - Level 1 Inspection		
Client :	SHADFORTHS PTY LTD		
Project :	EDENS CROSSING - STAGE 21		
Project No :	DL20/027	Drawing No :	DL20/027 - 01
Scale :	Not to Scale		



MORRISON GEOTECHNIC PTY LTD

ABN: 51 009 878 899

Unit 1/ 35 Limestone St, Darra 4076 Ph: 3279 0900
 Email: brisbanelab@morrisongeo.com.au Fax: 3279 0955

Engineers: D.Riley, J. Daly
 D.Dragun, & S.Wynne
 Geologists: L.Bexley & R.Howchin
 Laboratory: M.Morrison

LEGEND

- ▼ R.L 77.0 - 78.99
- ▼ R.L 79.0 - 80.99
- ▼ R.L 81.0 - 82.99
- ▼ R.L 83.0 - 84.99
- Final Level

Map Description :	EARTHWORKS FIELD DENSITY TESTING - Level 1 Inspection		
Client :	CCA WINSLOW		
Project :	EDENS CROSSING, FUTURE STAGES 15-20		
Project No :	DL17/398	Drawing No :	DL17/398 - 01
		Scale :	Not to Scale

Brisbane Office
Job Number: DL20/027
Ref No: 16156
Author: R. Mitchell

22nd April 2020

Shadforths Civil Pty Ltd
99 Sandalwood Lane
Forest Glen 4556

ATTENTION: MR MICHAEL PRITCHARD
Email: Michael.Pritchard@shadcivil.com.au

Dear Sir,

**RE: LOT 1043
LEVEL ONE COMPLIANCE REPORT FOR
EARTHWORKS FILL CONSTRUCTION
EDENS CROSSING STAGE 21**

Earthworks filling operations were carried out on Lot 1043 at the above Development to form a working platform to support a future residential building.

Earthworks were constructed by CCA Winslow (The Client) between May 2017 and March 2018 and Shadforths Civil (The Client) between January 2020 and March 2020.

This report should be read in conjunction with Morrison Geotechnic Report “16058 – DL20/027 Shadforths – Level One Compliance Report – Eden’s Crossing Stage 21” Dated 21st April 2020. The Brief from the Client for was limited to:

- Level One Inspection of the placement and compaction of fill materials in accordance with AS3798 2007 – “Guidelines on Earthworks for Commercial and Residential Developments”
- Relative Density Control Testing in accordance with AS1289 – Testing of Soils for Engineering Purposes and at frequencies required in AS3798 Table 8.
- Ipswich City Council Specifications.
- Notes on KN Group Pty Ltd Civil Drawings.

Level One Inspections and Testing was carried out on the stripped ground surfaces and during the placement and compaction of fill materials. Field and laboratory testing included proof roll testing of the stripped surface and compaction testing.

Compaction testing at the Eden’s Crossing Stage 21 Development was carried out at a frequency of 1 test per 500m³ of placed and compacted fill as defined in AS3798 Table 8.1. Test locations were selected using Random Stratified methods. Compaction testing was carried out at frequencies representative of the fill volume as a mass. On this basis, compaction testing was not required on each individual Lot.

A marked-up site plan shown the location of compaction testing is attached.

Fill constructed on Lot 1043 has been observed to be placed and compacted in accordance with the Brief. The fill on Lot 1043 can be termed as "Controlled Fill" in accordance with AS 2870-2011 "Residential Slabs and Footings".

This statement does not include any topsoil, which may have been placed for use as Lot dressing or any other subsequent earthworks after March 2020.

If there are any queries concerning the above please do not hesitate to contact this office, or alternatively send to my email at mickmorrison@morrisongeo.com.au.

Yours faithfully,


A handwritten signature in grey ink, appearing to read 'Rhys Mitchell', with a horizontal line extending to the right.

RHYS MITCHELL

For and on Behalf of

MORRISON GEOTECHNIC PTY LIMITED

Encl: Marked Up Site Pan

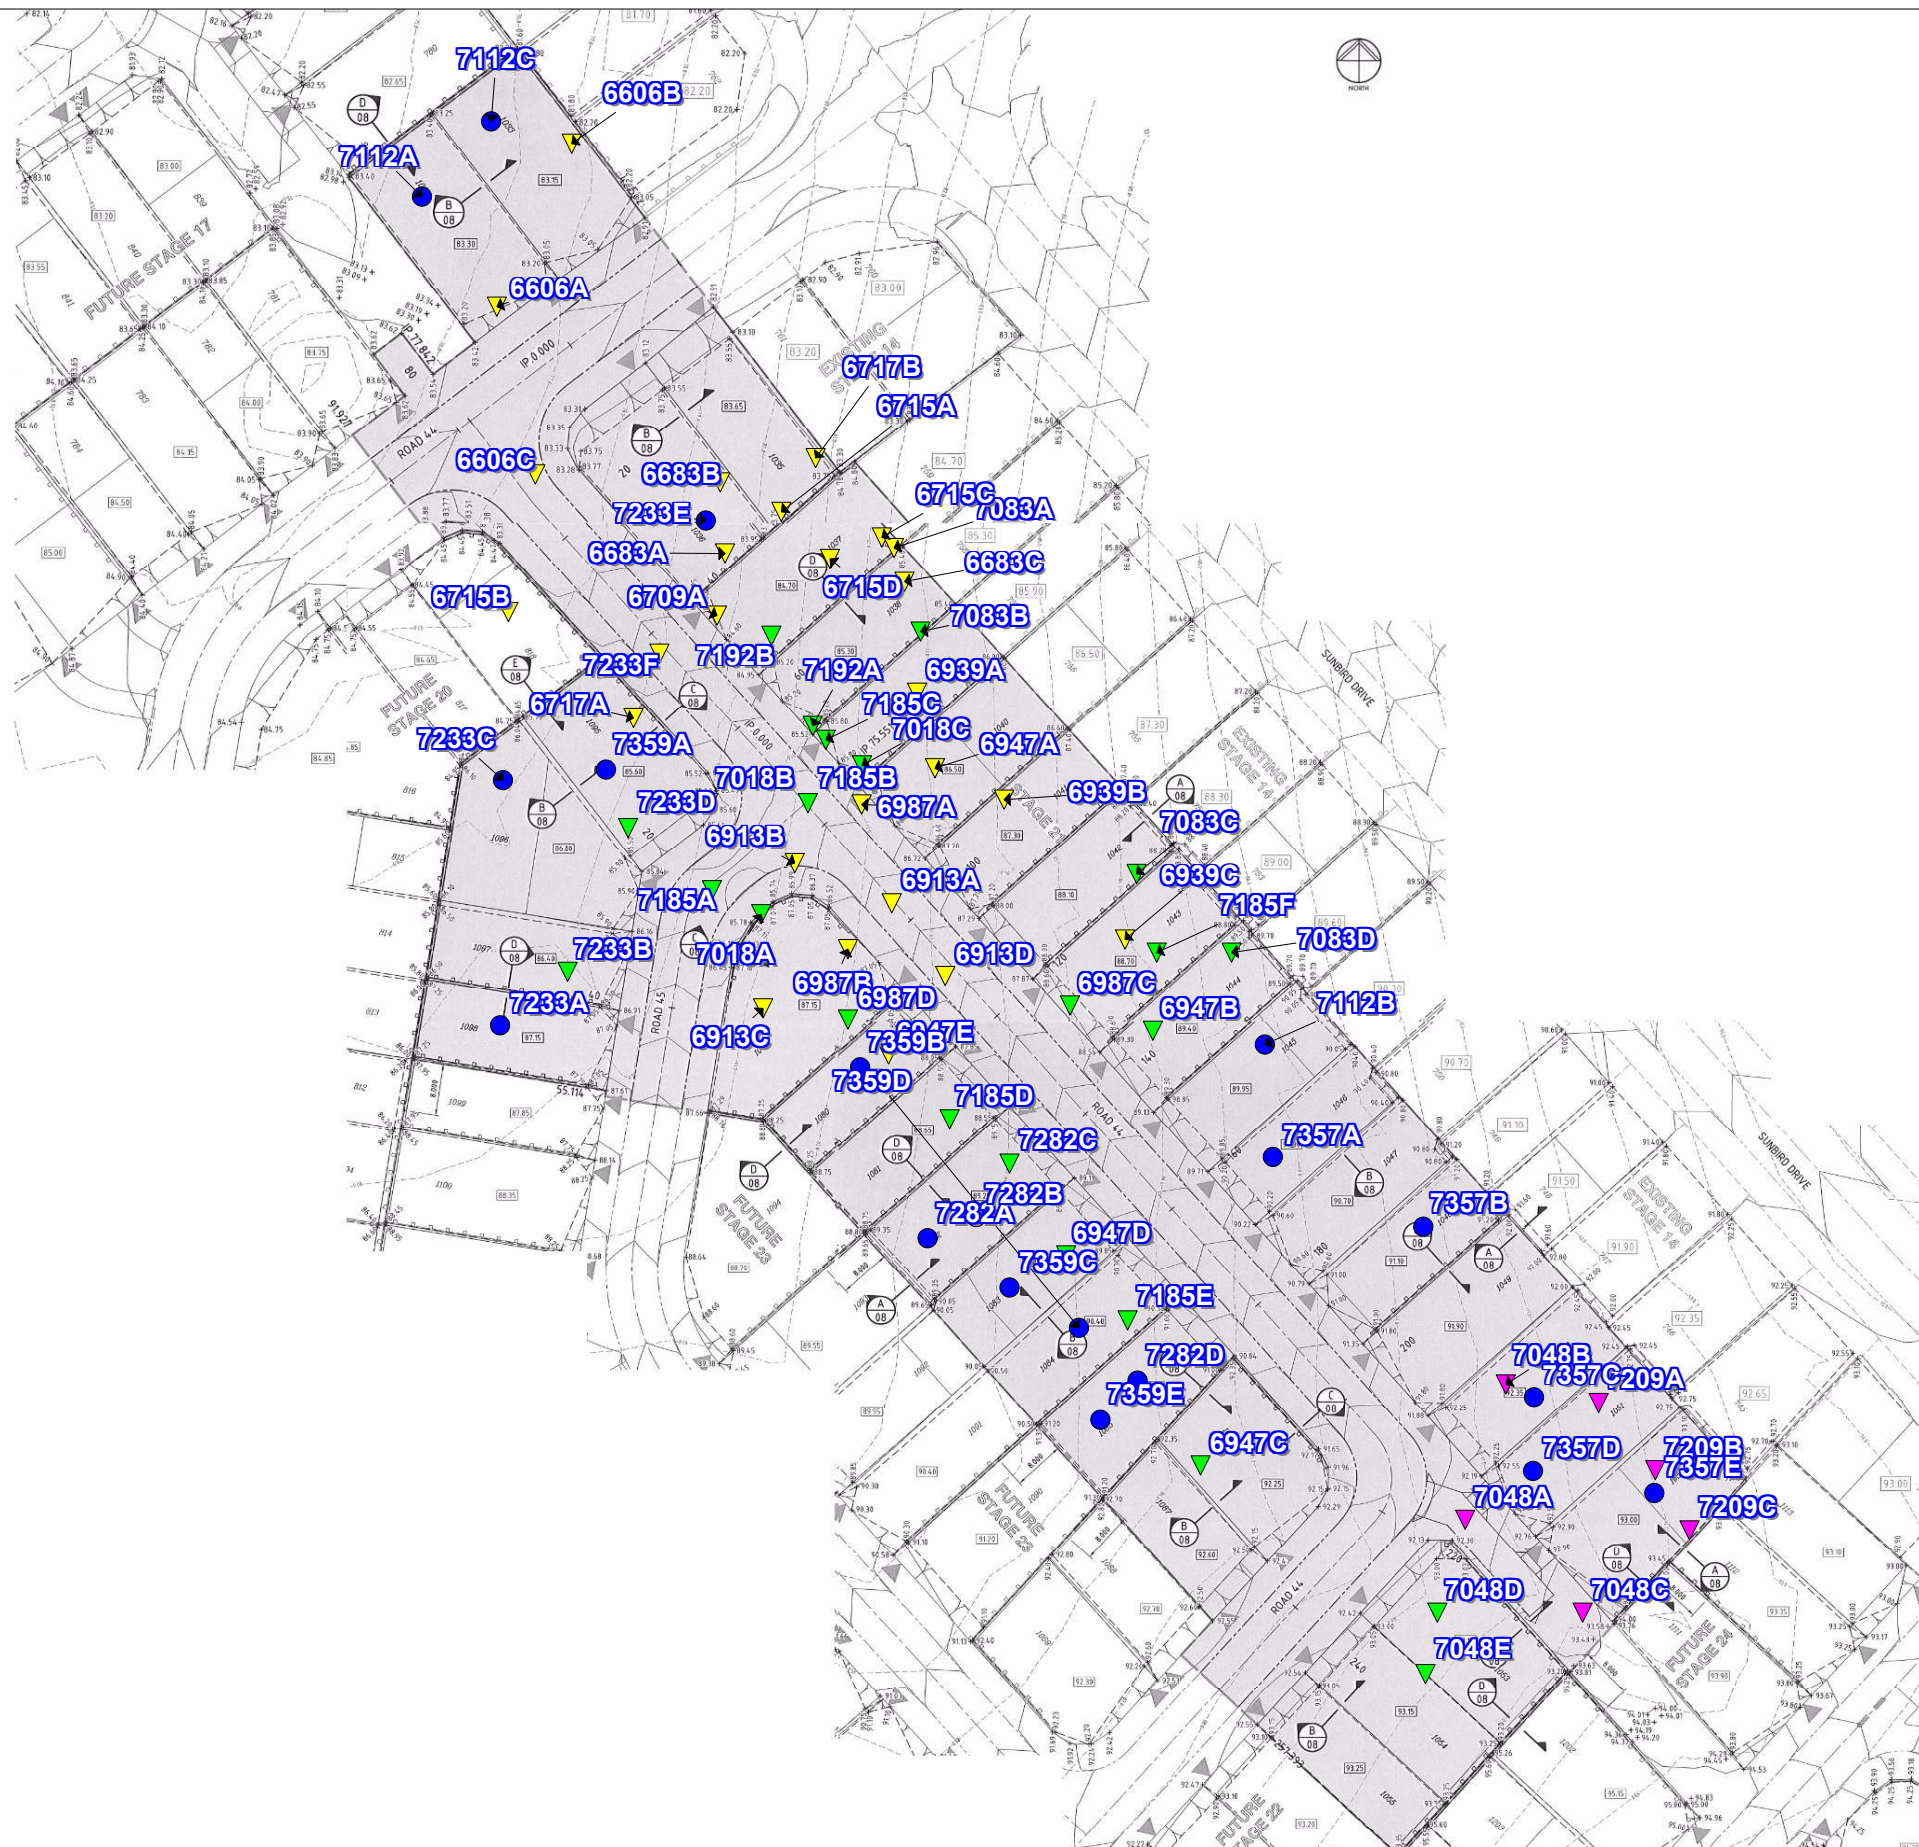

MORRISON GEOTECHNIC PTY LTD

ABN: 51 009 878 899

Unit 1/ 35 Limestone St, Darra 4076 Ph: 3279 0900
 Email: brisbanelab@morrisongeo.com.au

Engineers: M. Ballard
 D. Dragun
 Geologists: R. Howchin
 Laboratory: M. Morrison

LEGEND

- ▼ R.L 80.0 - 84.99
- ▼ R.L 85.0 - 89.99
- ▼ R.L 90.0 - 94.99
- Final Level

Map Description :	EARTHWORKS FIELD DENSITY TESTING - Level 1 Inspection		
Client :	SHADFORTHS PTY LTD		
Project :	EDENS CROSSING - STAGE 21		
Project No :	DL20/027	Drawing No :	DL20/027 - 01
		Scale :	Not to Scale



MORRISON GEOTECHNIC PTY LTD

ABN: 51 009 878 899

Unit 1/ 35 Limestone St, Darra 4076 Ph: 3279 0900
 Email: brisbanelab@morrisongeo.com.au Fax: 3279 0955

Engineers: D.Riley, J. Daly
 D.Dragun, & S.Wynne
 Geologists: L.Bexley & R.Howchin
 Laboratory: M.Morrison

LEGEND

- ▼ R.L 77.0 - 78.99
- ▼ R.L 79.0 - 80.99
- ▼ R.L 81.0 - 82.99
- ▼ R.L 83.0 - 84.99
- Final Level

Map Description :	EARTHWORKS FIELD DENSITY TESTING - Level 1 Inspection		
Client :	CCA WINSLOW		
Project :	EDENS CROSSING, FUTURE STAGES 15-20		
Project No :	DL17/398	Drawing No :	DL17/398 - 01
		Scale :	Not to Scale

Brisbane Office
Job Number: DL20/027
Ref No: 16157
Author: R. Mitchell

22nd April 2020

Shadforths Civil Pty Ltd
99 Sandalwood Lane
Forest Glen 4556

ATTENTION: MR MICHAEL PRITCHARD
Email: Michael.Pritchard@shadcivil.com.au

Dear Sir,

**RE: LOT 1044
LEVEL ONE COMPLIANCE REPORT FOR
EARTHWORKS FILL CONSTRUCTION
EDENS CROSSING STAGE 21**

Earthworks filling operations were carried out on Lot 1044 at the above Development to form a working platform to support a future residential building.

Earthworks were constructed by CCA Winslow (The Client) between May 2017 and March 2018 and Shadforths Civil (The Client) between January 2020 and March 2020.

This report should be read in conjunction with Morrison Geotechnic Report “16058 – DL20/027 Shadforths – Level One Compliance Report – Eden’s Crossing Stage 21” Dated 21st April 2020. The Brief from the Client for was limited to:

- Level One Inspection of the placement and compaction of fill materials in accordance with AS3798 2007 – “Guidelines on Earthworks for Commercial and Residential Developments”
- Relative Density Control Testing in accordance with AS1289 – Testing of Soils for Engineering Purposes and at frequencies required in AS3798 Table 8.
- Ipswich City Council Specifications.
- Notes on KN Group Pty Ltd Civil Drawings.

Level One Inspections and Testing was carried out on the stripped ground surfaces and during the placement and compaction of fill materials. Field and laboratory testing included proof roll testing of the stripped surface and compaction testing.

Compaction testing at the Eden’s Crossing Stage 21 Development was carried out at a frequency of 1 test per 500m³ of placed and compacted fill as defined in AS3798 Table 8.1. Test locations were selected using Random Stratified methods. Compaction testing was carried out at frequencies representative of the fill volume as a mass. On this basis, compaction testing was not required on each individual Lot.

A marked-up site plan shown the location of compaction testing is attached.

Fill constructed on Lot 1044 has been observed to be placed and compacted in accordance with the Brief. The fill on Lot 1044 can be termed as "Controlled Fill" in accordance with AS 2870-2011 "Residential Slabs and Footings".

This statement does not include any topsoil, which may have been placed for use as Lot dressing or any other subsequent earthworks after March 2020.

If there are any queries concerning the above please do not hesitate to contact this office, or alternatively send to my email at mickmorrison@morrisongeo.com.au.

Yours faithfully,


A handwritten signature in grey ink, appearing to read 'Rhys Mitchell', with a horizontal line extending to the right.

RHYS MITCHELL

For and on Behalf of

MORRISON GEOTECHNIC PTY LIMITED

Encl: Marked Up Site Pan

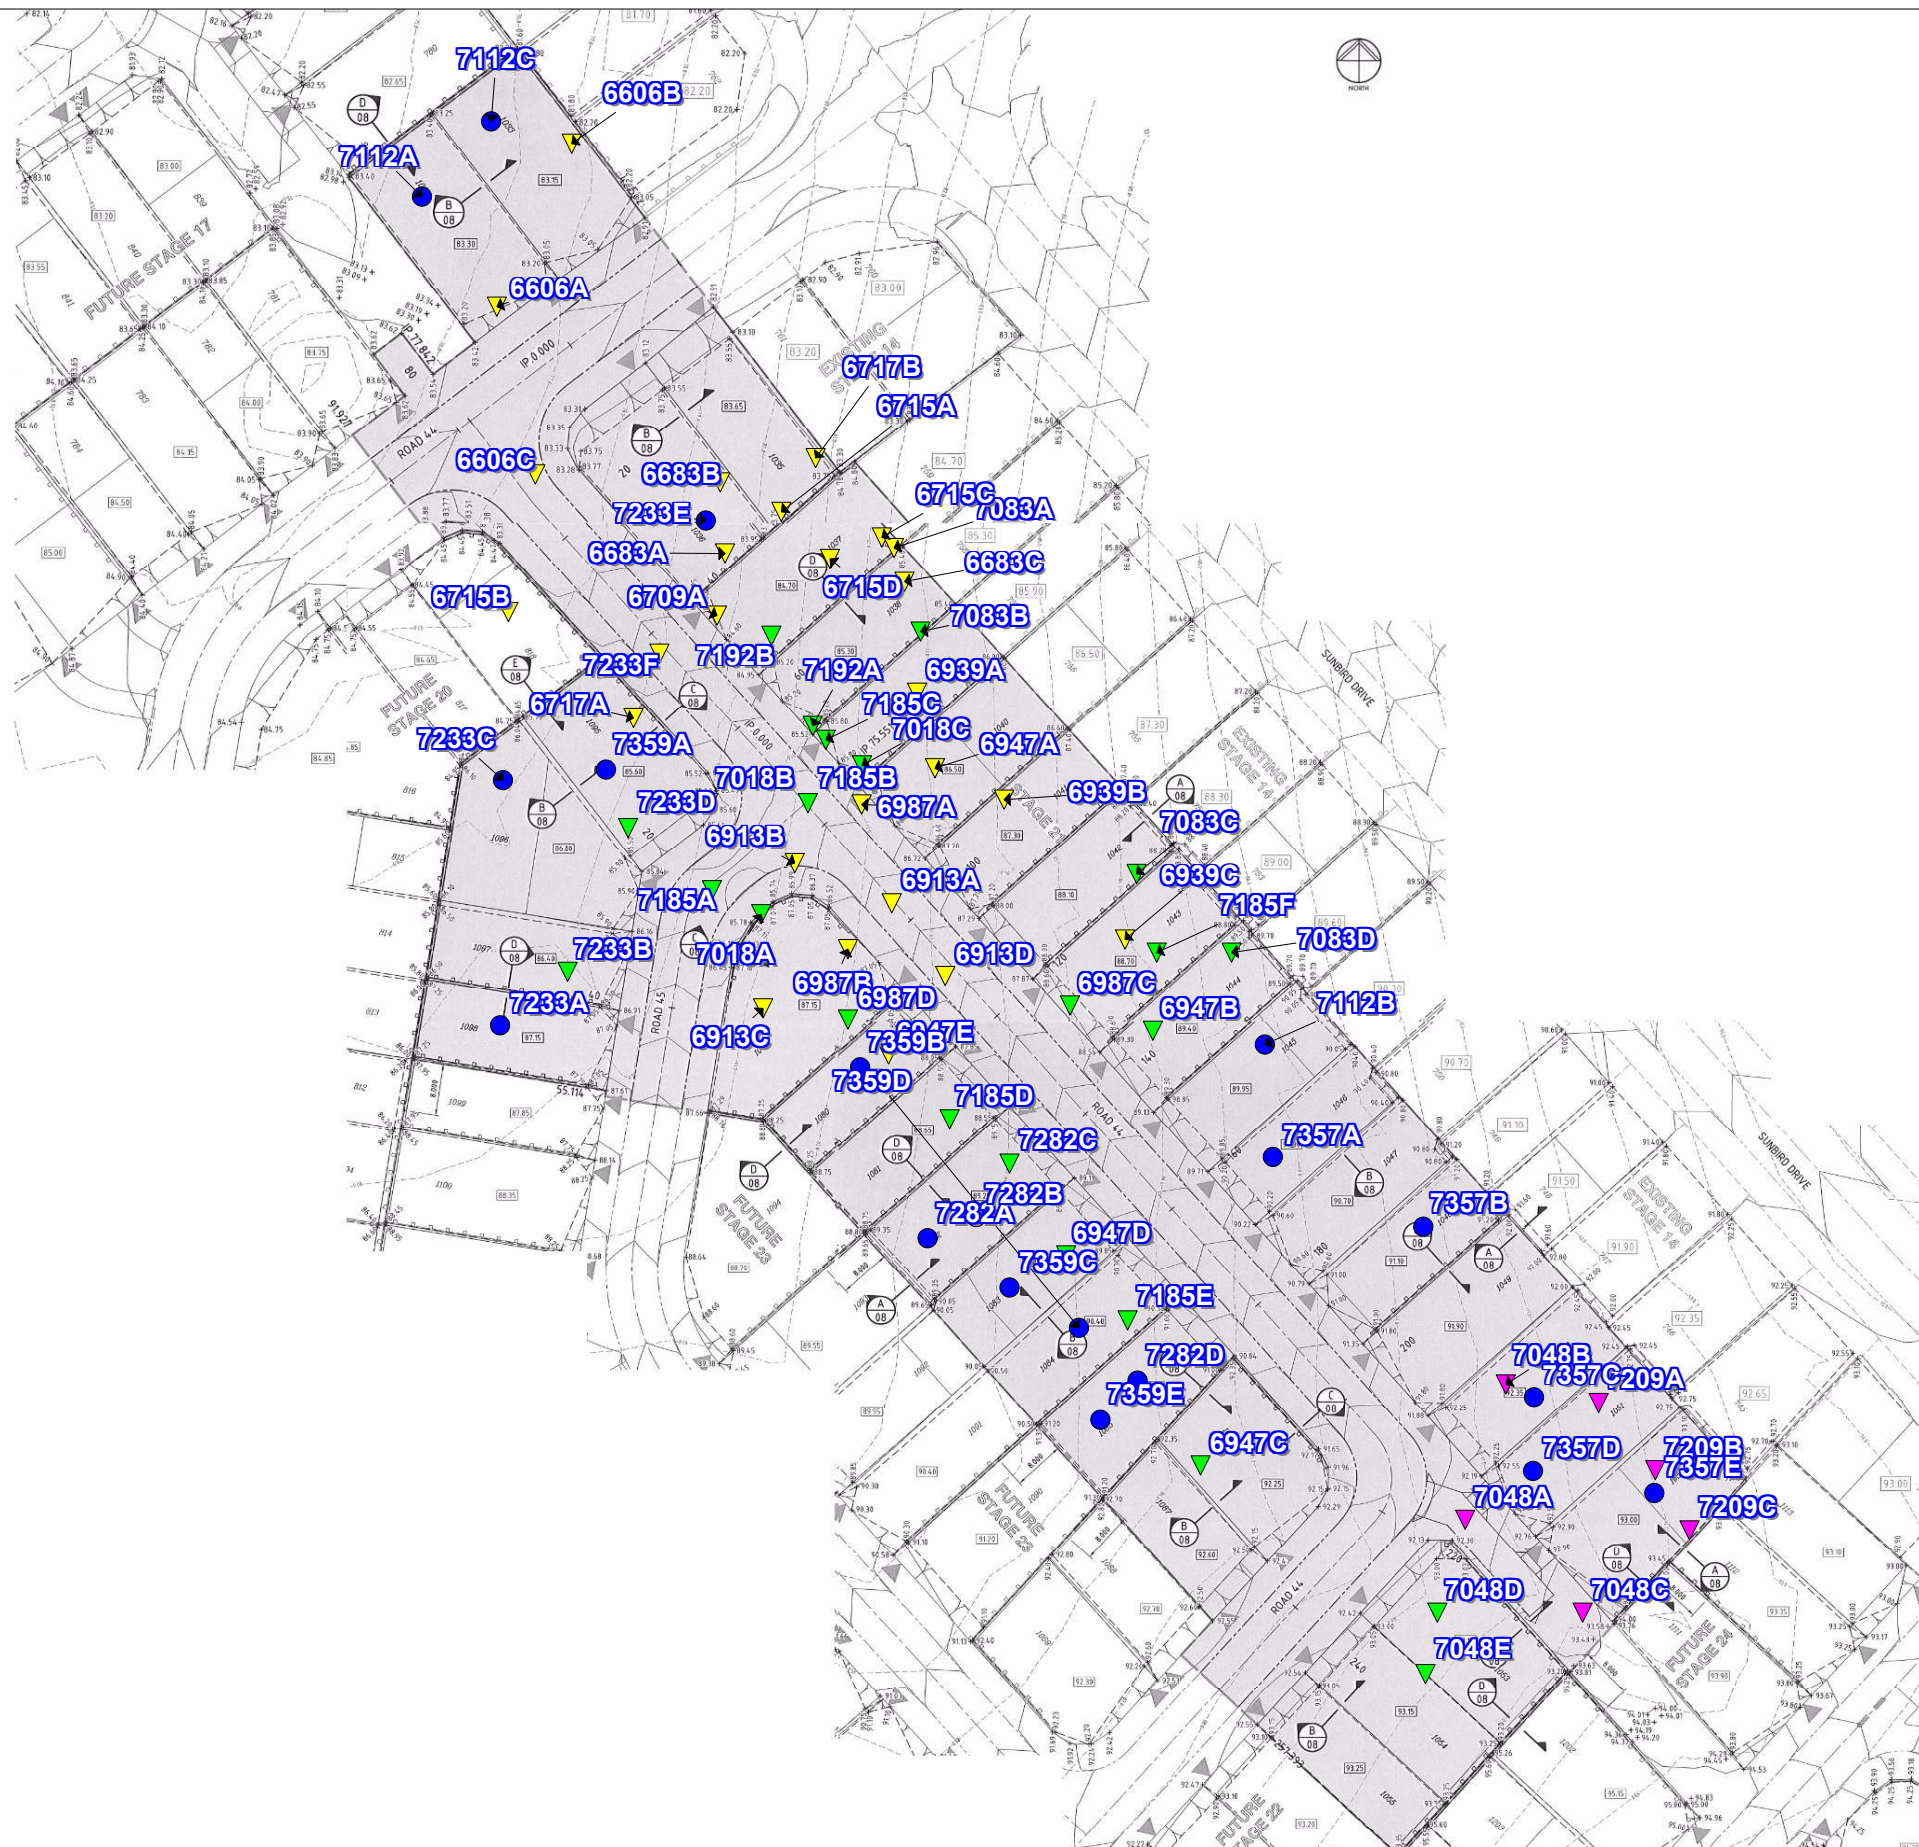

MORRISON GEOTECHNIC PTY LTD

ABN: 51 009 878 899

Unit 1/ 35 Limestone St, Darra 4076 Ph: 3279 0900
 Email: brisbanelab@morrisongeo.com.au

Engineers: M. Ballard
 D. Dragun
 Geologists: R. Howchin
 Laboratory: M. Morrison

LEGEND

- ▼ R.L 80.0 - 84.99
- ▼ R.L 85.0 - 89.99
- ▼ R.L 90.0 - 94.99
- Final Level

Map Description :	EARTHWORKS FIELD DENSITY TESTING - Level 1 Inspection		
Client :	SHADFORTHS PTY LTD		
Project :	EDENS CROSSING - STAGE 21		
Project No :	DL20/027	Drawing No :	DL20/027 - 01
		Scale :	Not to Scale



MORRISON GEOTECHNIC PTY LTD

ABN: 51 009 878 899

Unit 1/ 35 Limestone St, Darra 4076 Ph: 3279 0900
 Email: brisbanelab@morrisongeo.com.au Fax: 3279 0955

Engineers: D.Riley, J. Daly
 D.Dragun, & S.Wynne
 Geologists: L.Bexley & R.Howchin
 Laboratory: M.Morrison

LEGEND

- ▼ R.L 77.0 - 78.99
- ▼ R.L 79.0 - 80.99
- ▼ R.L 81.0 - 82.99
- ▼ R.L 83.0 - 84.99
- ▼ R.L 85.0 - 86.99
- Final Level

Map Description :	EARTHWORKS FIELD DENSITY TESTING - Level 1 Inspection		
Client :	CCA WINSLOW		
Project :	EDENS CROSSING, FUTURE STAGES 15-20		
Project No :	DL17/398	Drawing No :	DL17/398 - 01
		Scale :	Not to Scale

Brisbane Office
Job Number: DL20/027
Ref No: 16158
Author: R. Mitchell

22nd April 2020

Shadforths Civil Pty Ltd
99 Sandalwood Lane
Forest Glen 4556

ATTENTION: MR MICHAEL PRITCHARD
Email: Michael.Pritchard@shadcivil.com.au

Dear Sir,

**RE: LOT 1045
LEVEL ONE COMPLIANCE REPORT FOR
EARTHWORKS FILL CONSTRUCTION
EDENS CROSSING STAGE 21**

Earthworks filling operations were carried out on Lot 1045 at the above Development to form a working platform to support a future residential building.

Earthworks were constructed by CCA Winslow (The Client) between May 2017 and March 2018 and Shadforths Civil (The Client) between January 2020 and March 2020.

This report should be read in conjunction with Morrison Geotechnic Report "16058 – DL20/027 Shadforths – Level One Compliance Report – Eden's Crossing Stage 21" Dated 21st April 2020. The Brief from the Client for was limited to:

- Level One Inspection of the placement and compaction of fill materials in accordance with AS3798 2007 – "Guidelines on Earthworks for Commercial and Residential Developments"
- Relative Density Control Testing in accordance with AS1289 – Testing of Soils for Engineering Purposes and at frequencies required in AS3798 Table 8.
- Ipswich City Council Specifications.
- Notes on KN Group Pty Ltd Civil Drawings.

Level One Inspections and Testing was carried out on the stripped ground surfaces and during the placement and compaction of fill materials. Field and laboratory testing included proof roll testing of the stripped surface and compaction testing.

Compaction testing at the Eden's Crossing Stage 21 Development was carried out at a frequency of 1 test per 500m³ of placed and compacted fill as defined in AS3798 Table 8.1. Test locations were selected using Random Stratified methods. Compaction testing was carried out at frequencies representative of the fill volume as a mass. On this basis, compaction testing was not required on each individual Lot.

A marked-up site plan shown the location of compaction testing is attached.

Fill constructed on Lot 1045 has been observed to be placed and compacted in accordance with the Brief. The fill on Lot 1045 can be termed as "Controlled Fill" in accordance with AS 2870-2011 "Residential Slabs and Footings".

This statement does not include any topsoil, which may have been placed for use as Lot dressing or any other subsequent earthworks after March 2020.

If there are any queries concerning the above please do not hesitate to contact this office, or alternatively send to my email at mickmorrison@morrisongeo.com.au.

Yours faithfully,




RHYS MITCHELL

For and on Behalf of

MORRISON GEOTECHNIC PTY LIMITED

Encl: Marked Up Site Pan

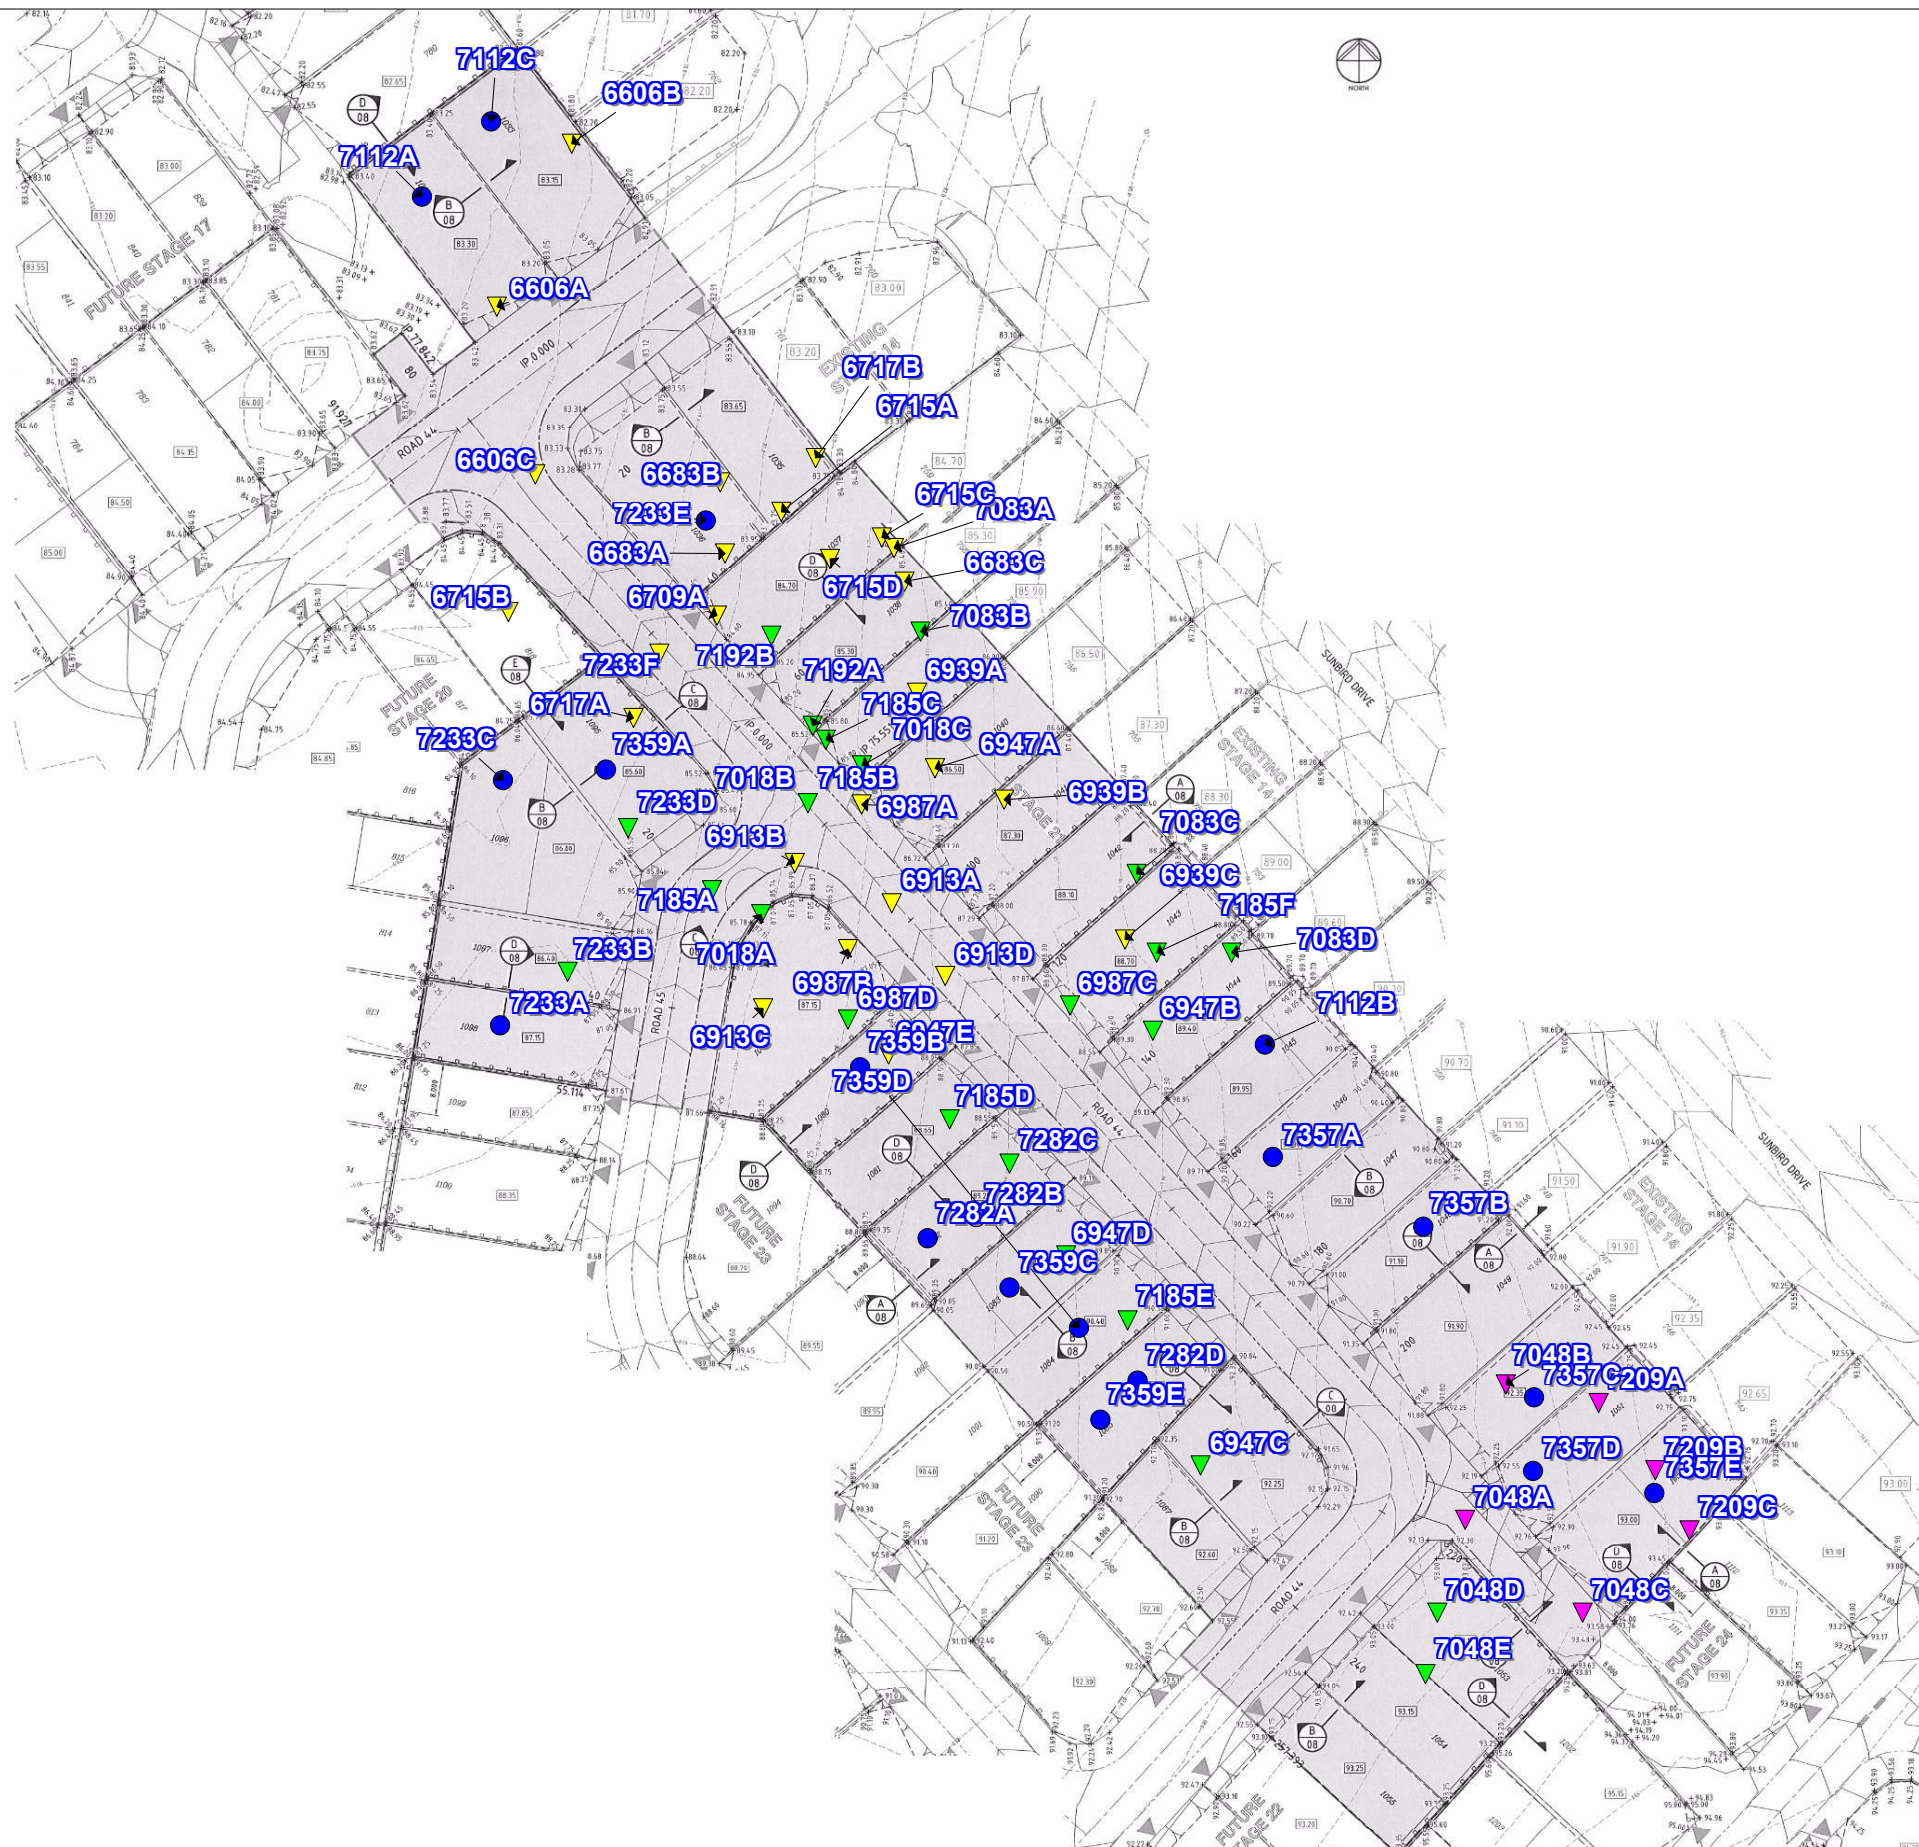

MORRISON GEOTECHNIC PTY LTD

ABN: 51 009 878 899

Unit 1/ 35 Limestone St, Darra 4076 Ph: 3279 0900
 Email: brisbanelab@morrisongeo.com.au

Engineers: M. Ballard
 D. Dragun
 Geologists: R. Howchin
 Laboratory: M. Morrison

LEGEND

- ▼ R.L 80.0 - 84.99
- ▼ R.L 85.0 - 89.99
- ▼ R.L 90.0 - 94.99
- Final Level

Map Description :	EARTHWORKS FIELD DENSITY TESTING - Level 1 Inspection		
Client :	SHADFORTHS PTY LTD		
Project :	EDENS CROSSING - STAGE 21		
Project No :	DL20/027	Drawing No :	DL20/027 - 01
		Scale :	Not to Scale



MORRISON GEOTECHNIC PTY LTD

ABN: 51 009 878 899

Unit 1/ 35 Limestone St, Darra 4076 Ph: 3279 0900
 Email: brisbanelab@morrisongeo.com.au Fax: 3279 0955

Engineers: D.Riley, J. Daly
 D.Dragun, & S.Wynne
 Geologists: L.Bexley & R.Howchin
 Laboratory: M.Morrison

LEGEND

- ▼ R.L 77.0 - 78.99
- ▼ R.L 79.0 - 80.99
- ▼ R.L 81.0 - 82.99
- ▼ R.L 83.0 - 84.99
- Final Level

Map Description :	EARTHWORKS FIELD DENSITY TESTING - Level 1 Inspection		
Client :	CCA WINSLOW		
Project :	EDENS CROSSING, FUTURE STAGES 15-20		
Project No :	DL17/398	Drawing No :	DL17/398 - 01
		Scale :	Not to Scale

Brisbane Office
Job Number: DL20/027
Ref No: 16159
Author: R. Mitchell

22nd April 2020

Shadforths Civil Pty Ltd
99 Sandalwood Lane
Forest Glen 4556

ATTENTION: MR MICHAEL PRITCHARD
Email: Michael.Pritchard@shadcivil.com.au

Dear Sir,

**RE: LOT 1046
LEVEL ONE COMPLIANCE REPORT FOR
EARTHWORKS FILL CONSTRUCTION
EDENS CROSSING STAGE 21**

Earthworks filling operations were carried out on Lot 1046 at the above Development to form a working platform to support a future residential building.

Earthworks were constructed by CCA Winslow (The Client) between May 2017 and March 2018 and Shadforths Civil (The Client) between January 2020 and March 2020.

This report should be read in conjunction with Morrison Geotechnic Report “16058 – DL20/027 Shadforths – Level One Compliance Report – Eden’s Crossing Stage 21” Dated 21st April 2020. The Brief from the Client for was limited to:

- Level One Inspection of the placement and compaction of fill materials in accordance with AS3798 2007 – “Guidelines on Earthworks for Commercial and Residential Developments”
- Relative Density Control Testing in accordance with AS1289 – Testing of Soils for Engineering Purposes and at frequencies required in AS3798 Table 8.
- Ipswich City Council Specifications.
- Notes on KN Group Pty Ltd Civil Drawings.

Level One Inspections and Testing was carried out on the stripped ground surfaces and during the placement and compaction of fill materials. Field and laboratory testing included proof roll testing of the stripped surface and compaction testing.

Compaction testing at the Eden’s Crossing Stage 21 Development was carried out at a frequency of 1 test per 500m³ of placed and compacted fill as defined in AS3798 Table 8.1. Test locations were selected using Random Stratified methods. Compaction testing was carried out at frequencies representative of the fill volume as a mass. On this basis, compaction testing was not required on each individual Lot.

A marked-up site plan shown the location of compaction testing is attached.

Fill constructed on Lot 1046 has been observed to be placed and compacted in accordance with the Brief. The fill on Lot 1046 can be termed as "Controlled Fill" in accordance with AS 2870-2011 "Residential Slabs and Footings".

This statement does not include any topsoil, which may have been placed for use as Lot dressing or any other subsequent earthworks after March 2020.

If there are any queries concerning the above please do not hesitate to contact this office, or alternatively send to my email at mickmorrison@morrisongeo.com.au.

Yours faithfully,


A handwritten signature in grey ink, appearing to read 'Rhys Mitchell', with a horizontal line extending to the right.

RHYS MITCHELL

For and on Behalf of

MORRISON GEOTECHNIC PTY LIMITED

Encl: Marked Up Site Pan

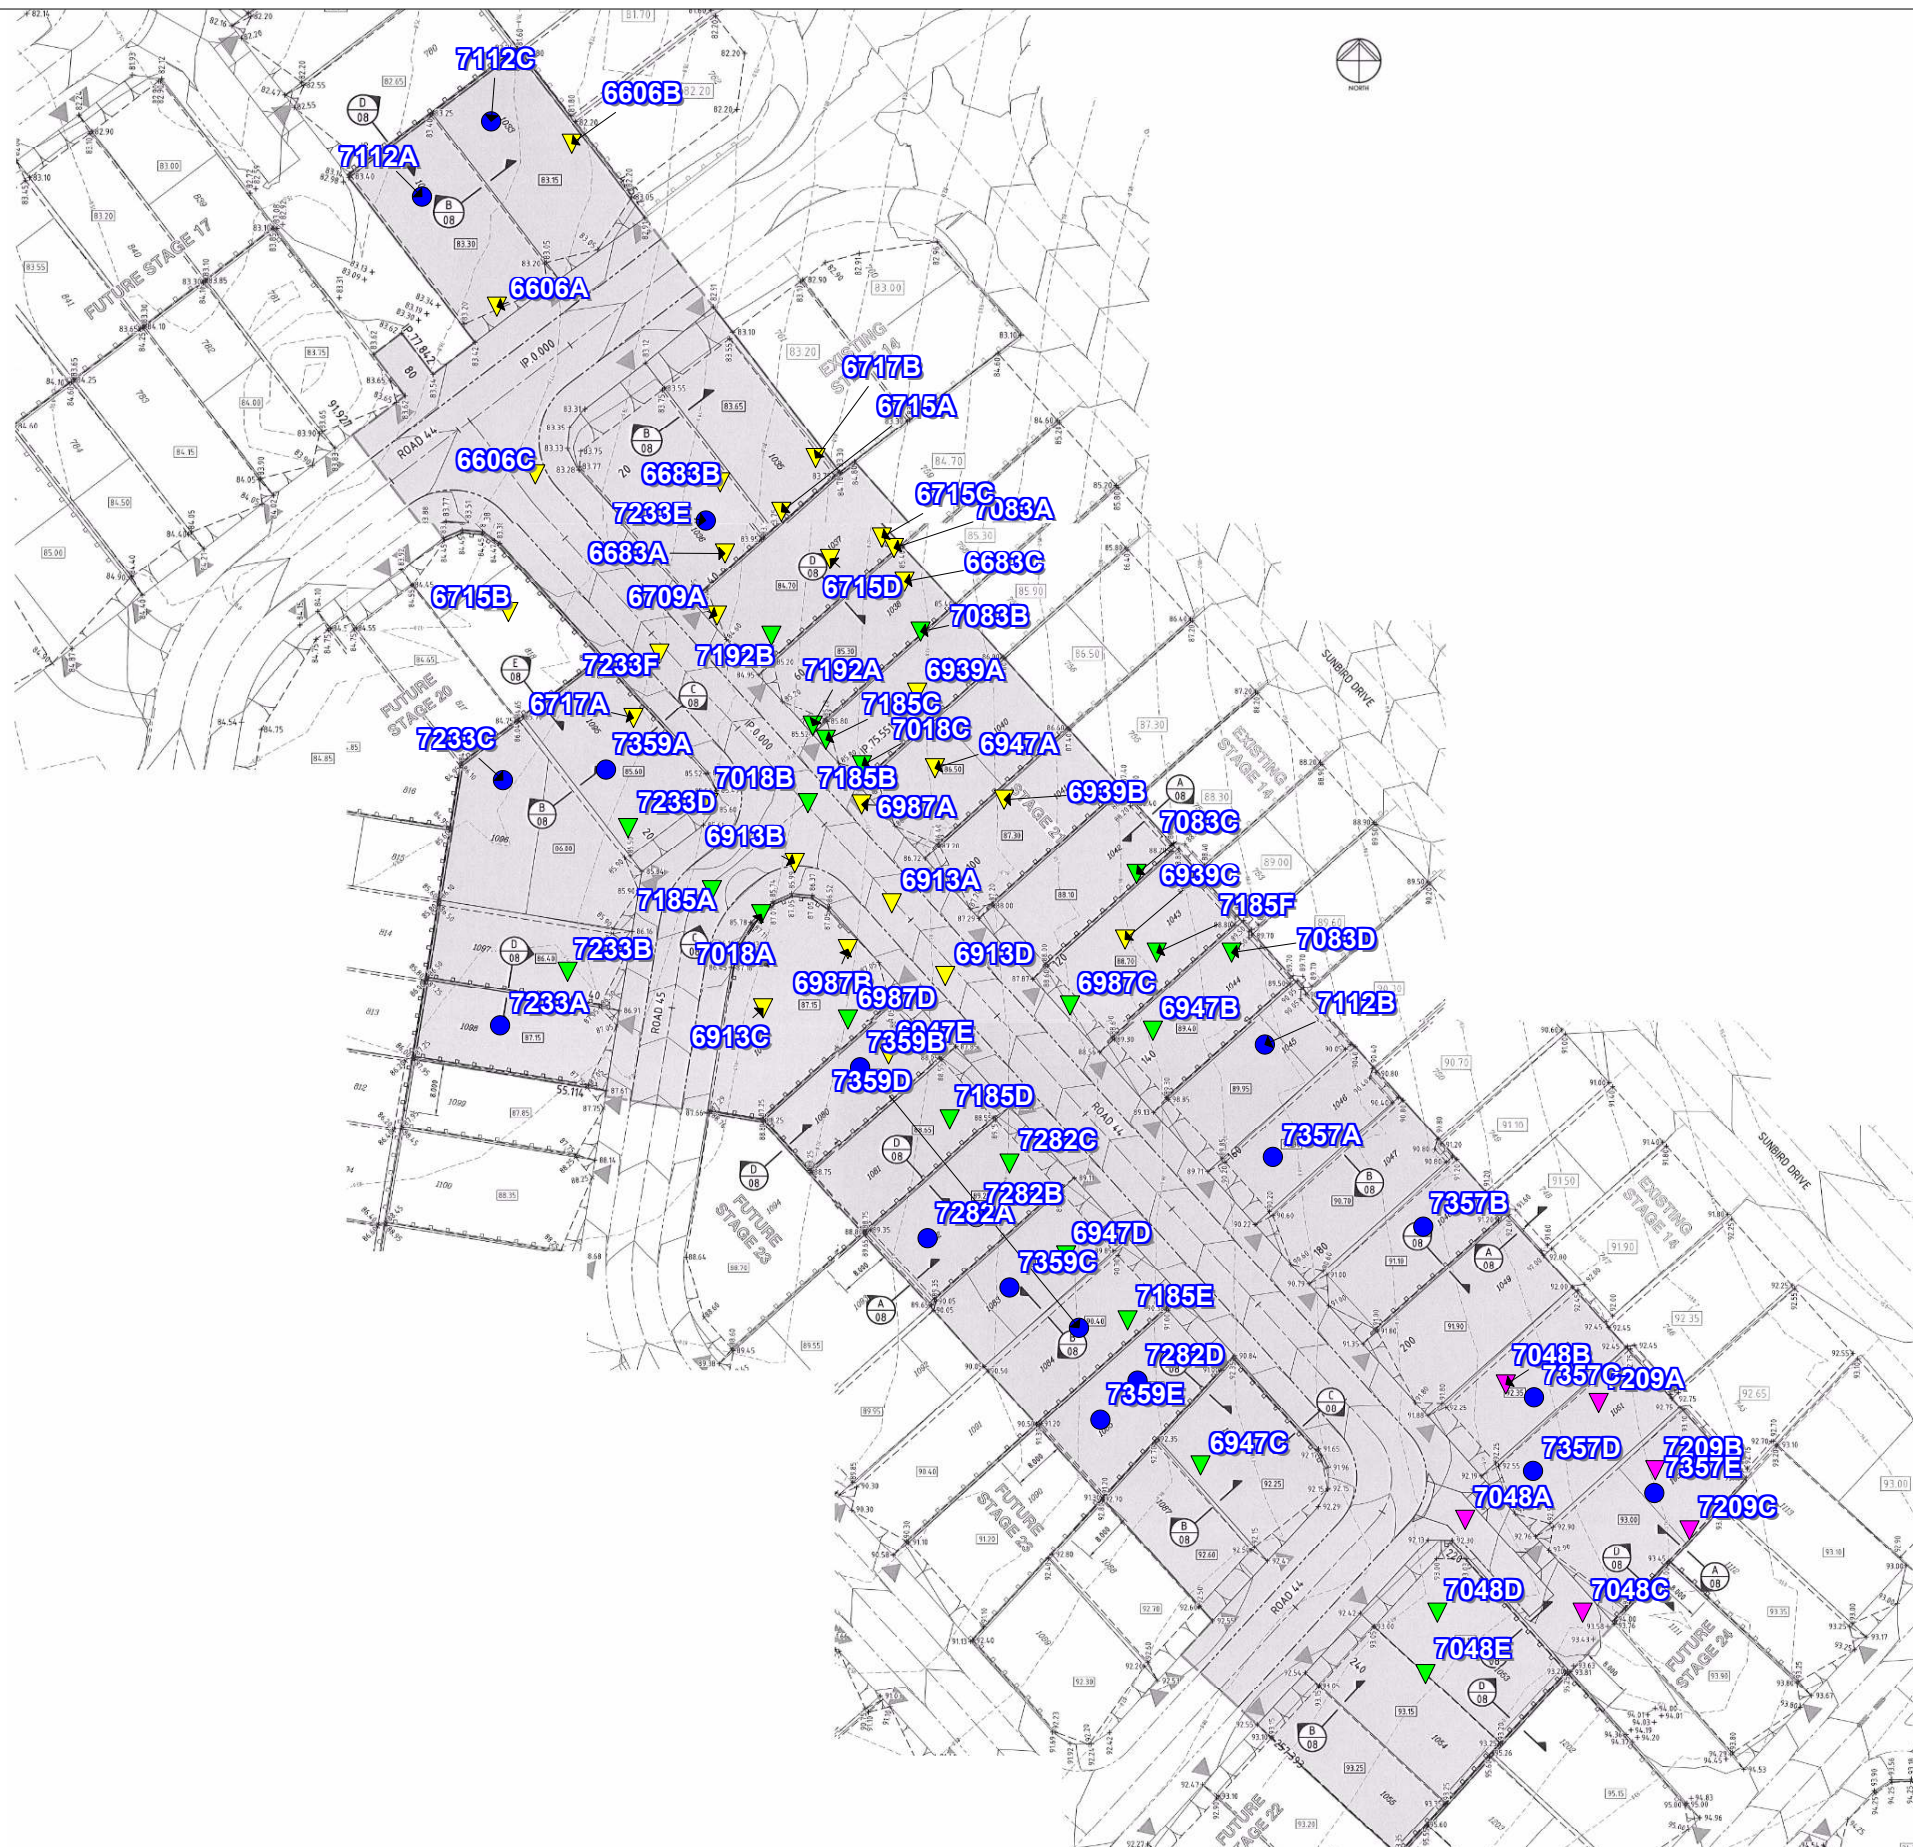

MORRISON GEOTECHNIC PTY LTD

ABN: 51 009 878 899

Unit 1/ 35 Limestone St, Darra 4076 Ph: 3279 0900
 Email: brisbanelab@morrisongeo.com.au

Engineers: M. Ballard
 D. Dragun
 Geologists: R. Howchin
 Laboratory: M. Morrison

LEGEND

- ▼ R.L 80.0 - 84.99
- ▼ R.L 85.0 - 89.99
- ▼ R.L 90.0 - 94.99
- Final Level

Map Description :	EARTHWORKS FIELD DENSITY TESTING - Level 1 Inspection		
Client :	SHADFORTHS PTY LTD		
Project :	EDENS CROSSING - STAGE 21		
Project No :	DL20/027	Drawing No :	DL20/027 - 01
		Scale :	Not to Scale



MORRISON GEOTECHNIC PTY LTD

ABN: 51 009 878 899

Unit 1/ 35 Limestone St, Darra 4076 Ph: 3279 0900
 Email: brisbanelab@morrisongeo.com.au Fax: 3279 0955

Engineers: D.Riley, J. Daly
 D.Dragun, & S.Wynne
 Geologists: L.Bexley & R.Howchin
 Laboratory: M.Morrison

LEGEND

- ▼ R.L 77.0 - 78.99
- ▼ R.L 79.0 - 80.99
- ▼ R.L 81.0 - 82.99
- ▼ R.L 83.0 - 84.99
- Final Level

Map Description :	EARTHWORKS FIELD DENSITY TESTING - Level 1 Inspection		
Client :	CCA WINSLOW		
Project :	EDENS CROSSING, FUTURE STAGES 15-20		
Project No :	DL17/398	Drawing No :	DL17/398 - 01
		Scale :	Not to Scale

Brisbane Office
Job Number: DL20/027
Ref No: 16160
Author: R. Mitchell

22nd April 2020

Shadforths Civil Pty Ltd
99 Sandalwood Lane
Forest Glen 4556

ATTENTION: MR MICHAEL PRITCHARD
Email: Michael.Pritchard@shadcivil.com.au

Dear Sir,

**RE: LOT 1047
LEVEL ONE COMPLIANCE REPORT FOR
EARTHWORKS FILL CONSTRUCTION
EDENS CROSSING STAGE 21**

Earthworks filling operations were carried out on Lot 1047 at the above Development to form a working platform to support a future residential building.

Earthworks were constructed by CCA Winslow (The Client) between May 2017 and March 2018 and Shadforths Civil (The Client) between January 2020 and March 2020.

This report should be read in conjunction with Morrison Geotechnic Report “16058 – DL20/027 Shadforths – Level One Compliance Report – Eden’s Crossing Stage 21” Dated 21st April 2020. The Brief from the Client for was limited to:

- Level One Inspection of the placement and compaction of fill materials in accordance with AS3798 2007 – “Guidelines on Earthworks for Commercial and Residential Developments”
- Relative Density Control Testing in accordance with AS1289 – Testing of Soils for Engineering Purposes and at frequencies required in AS3798 Table 8.
- Ipswich City Council Specifications.
- Notes on KN Group Pty Ltd Civil Drawings.

Level One Inspections and Testing was carried out on the stripped ground surfaces and during the placement and compaction of fill materials. Field and laboratory testing included proof roll testing of the stripped surface and compaction testing.

Compaction testing at the Eden’s Crossing Stage 21 Development was carried out at a frequency of 1 test per 500m³ of placed and compacted fill as defined in AS3798 Table 8.1. Test locations were selected using Random Stratified methods. Compaction testing was carried out at frequencies representative of the fill volume as a mass. On this basis, compaction testing was not required on each individual Lot.

A marked-up site plan shown the location of compaction testing is attached.

Fill constructed on Lot 1047 has been observed to be placed and compacted in accordance with the Brief. The fill on Lot 1047 can be termed as "Controlled Fill" in accordance with AS 2870-2011 "Residential Slabs and Footings".

This statement does not include any topsoil, which may have been placed for use as Lot dressing or any other subsequent earthworks after March 2020.

If there are any queries concerning the above please do not hesitate to contact this office, or alternatively send to my email at mickmorrison@morrisongeo.com.au.

Yours faithfully,


A handwritten signature in grey ink, appearing to read 'Rhys Mitchell', with a long horizontal flourish extending to the right.

RHYS MITCHELL

For and on Behalf of

MORRISON GEOTECHNIC PTY LIMITED

Encl: Marked Up Site Pan

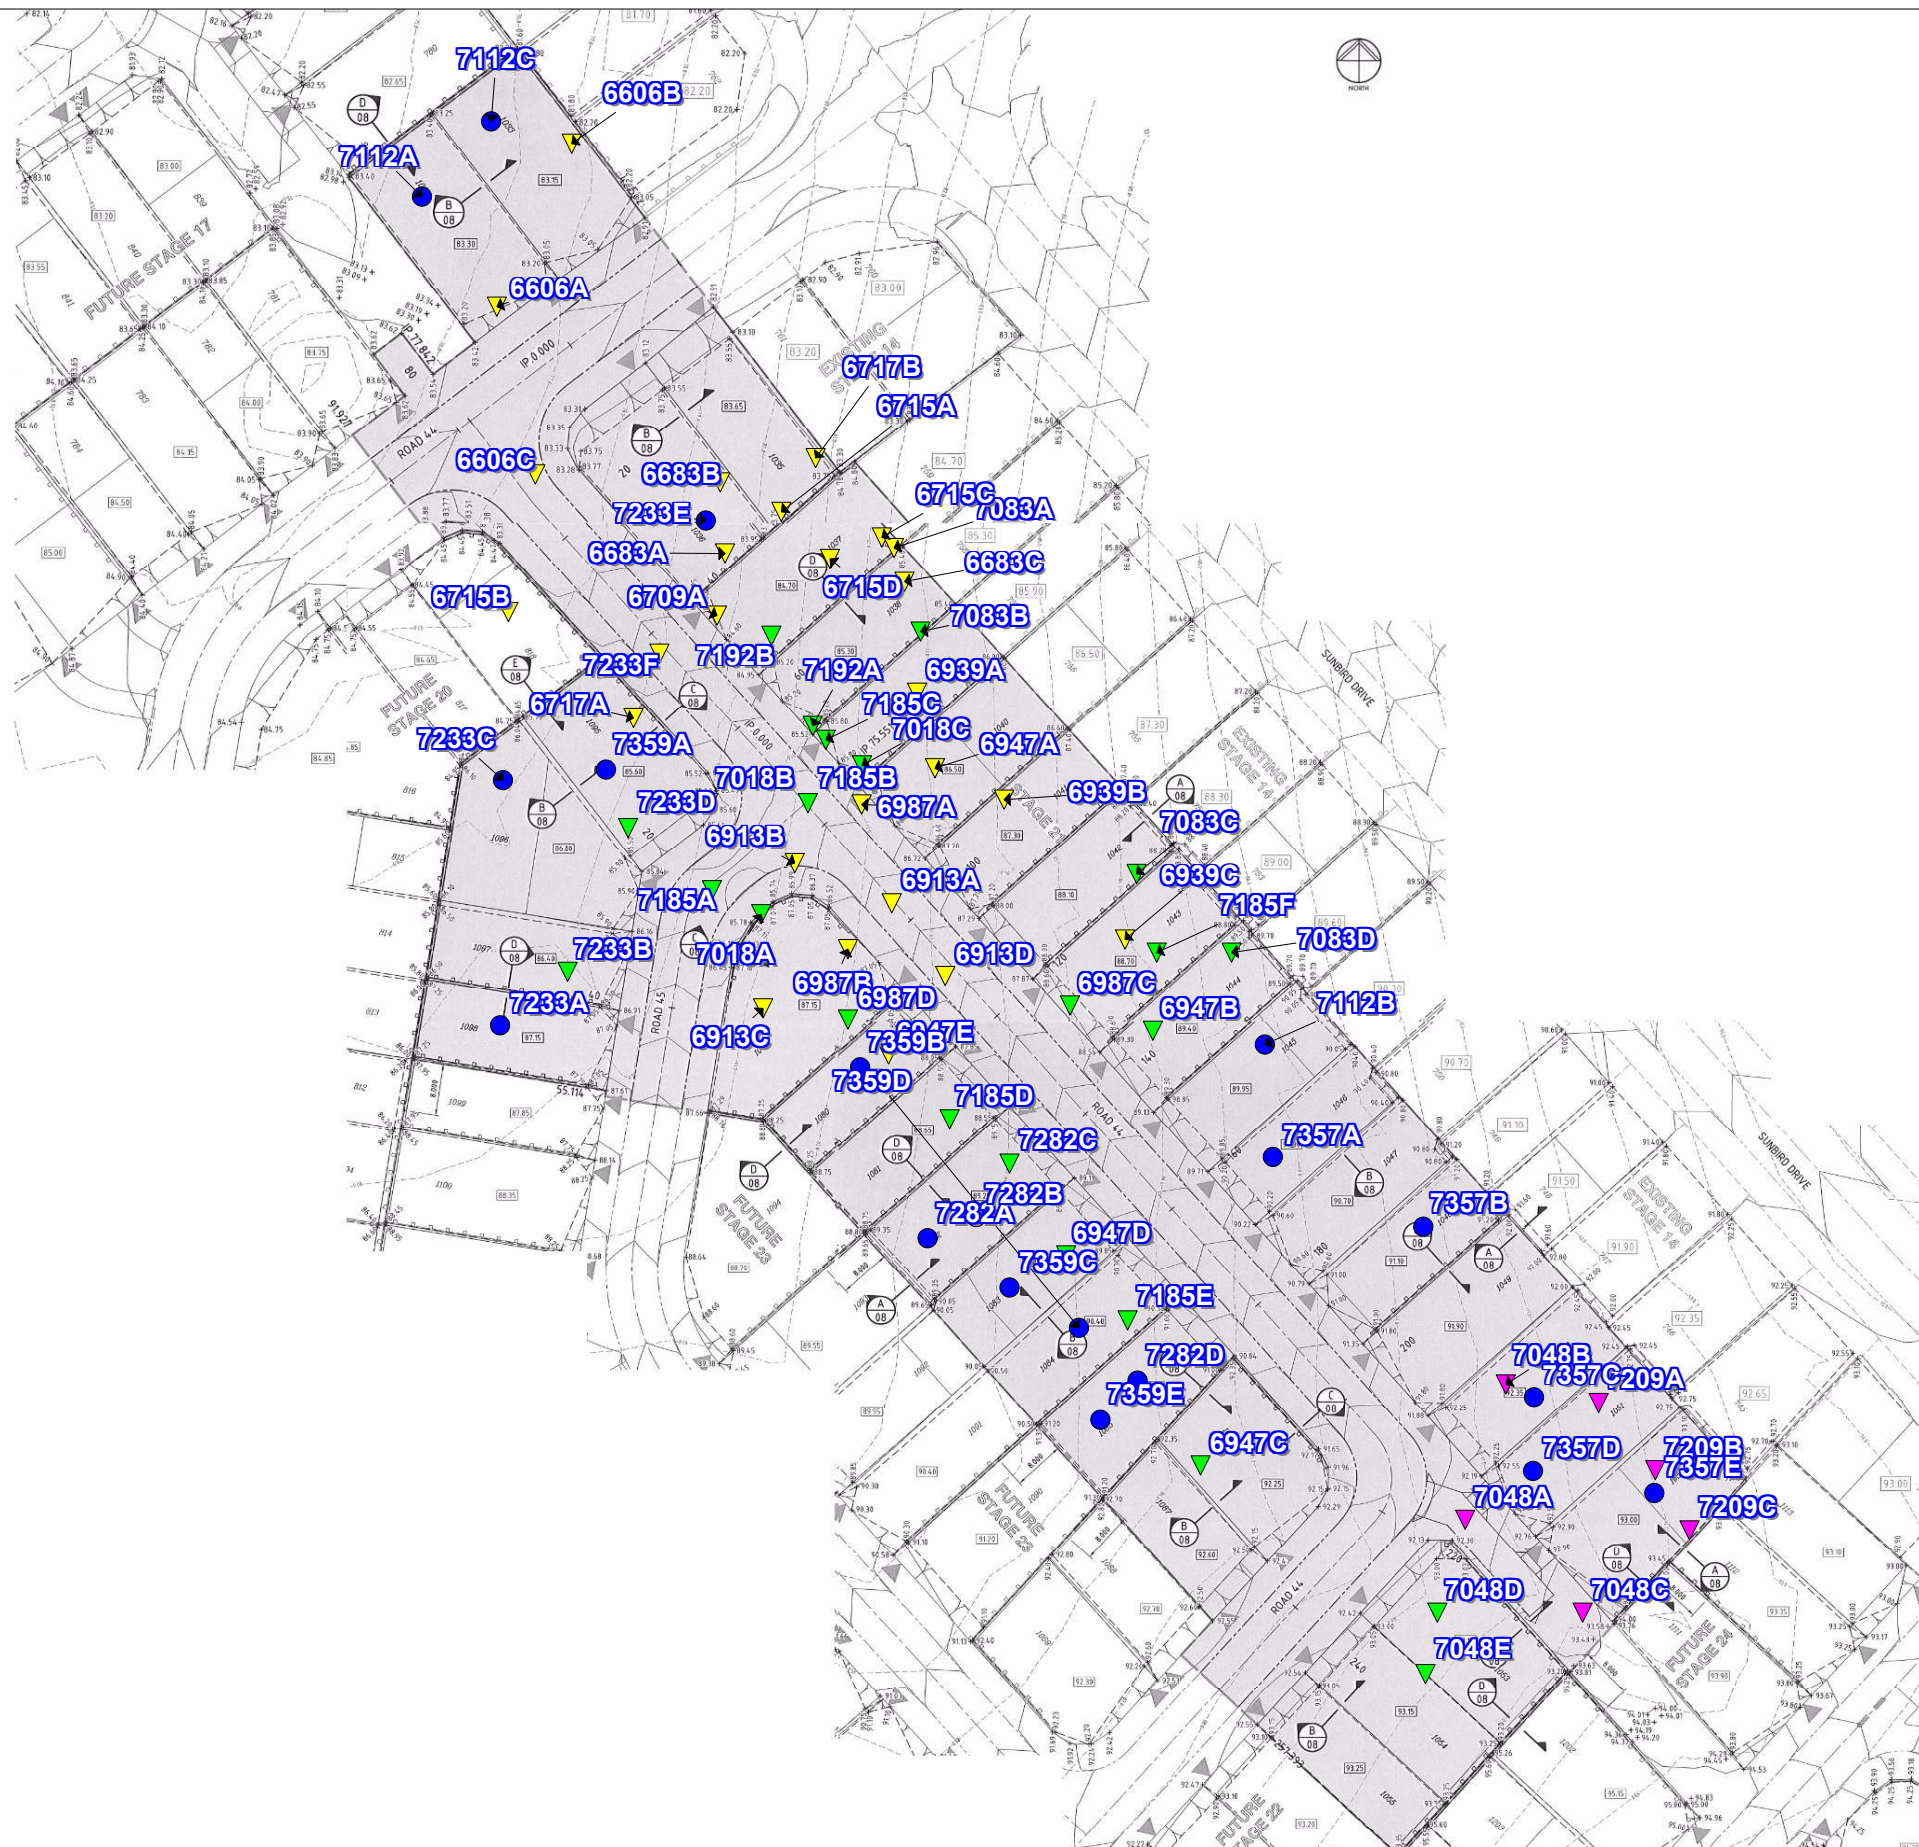

MORRISON GEOTECHNIC PTY LTD

ABN: 51 009 878 899

Unit 1/ 35 Limestone St, Darra 4076 Ph: 3279 0900
 Email: brisbanelab@morrisongeo.com.au

Engineers: M. Ballard
 D. Dragun
 Geologists: R. Howchin
 Laboratory: M. Morrison

LEGEND

- ▲ R.L 80.0 - 84.99
- ▲ R.L 85.0 - 89.99
- ▲ R.L 90.0 - 94.99
- Final Level

Map Description :	EARTHWORKS FIELD DENSITY TESTING - Level 1 Inspection		
Client :	SHADFORTHS PTY LTD		
Project :	EDENS CROSSING - STAGE 21		
Project No :	DL20/027	Drawing No :	DL20/027 - 01
Scale :	Not to Scale		



MORRISON GEOTECHNIC PTY LTD

ABN: 51 009 878 899

Unit 1/ 35 Limestone St, Darra 4076 Ph: 3279 0900
 Email: brisbanelab@morrisongeo.com.au Fax: 3279 0955

Engineers: D.Riley, J. Daly
 D.Dragun, & S.Wynne
 Geologists: L.Bexley & R.Howchin
 Laboratory: M.Morrison

LEGEND

- ▼ R.L 77.0 - 78.99
- ▼ R.L 79.0 - 80.99
- ▼ R.L 81.0 - 82.99
- ▼ R.L 83.0 - 84.99
- Final Level

Map Description :	EARTHWORKS FIELD DENSITY TESTING - Level 1 Inspection		
Client :	CCA WINSLOW		
Project :	EDENS CROSSING, FUTURE STAGES 15-20		
Project No :	DL17/398	Drawing No :	DL17/398 - 01
		Scale :	Not to Scale

Brisbane Office
Job Number: DL20/027
Ref No: 16161
Author: R. Mitchell

22nd April 2020

Shadforths Civil Pty Ltd
99 Sandalwood Lane
Forest Glen 4556

ATTENTION: MR MICHAEL PRITCHARD
Email: Michael.Pritchard@shadcivil.com.au

Dear Sir,

**RE: LOT 1048
LEVEL ONE COMPLIANCE REPORT FOR
EARTHWORKS FILL CONSTRUCTION
EDENS CROSSING STAGE 21**

Earthworks filling operations were carried out on Lot 1048 at the above Development to form a working platform to support a future residential building.

Earthworks were constructed by CCA Winslow (The Client) between May 2017 and March 2018 and Shadforths Civil (The Client) between January 2020 and March 2020.

This report should be read in conjunction with Morrison Geotechnic Report “16058 – DL20/027 Shadforths – Level One Compliance Report – Eden’s Crossing Stage 21” Dated 21st April 2020. The Brief from the Client for was limited to:

- Level One Inspection of the placement and compaction of fill materials in accordance with AS3798 2007 – “Guidelines on Earthworks for Commercial and Residential Developments”
- Relative Density Control Testing in accordance with AS1289 – Testing of Soils for Engineering Purposes and at frequencies required in AS3798 Table 8.
- Ipswich City Council Specifications.
- Notes on KN Group Pty Ltd Civil Drawings.

Level One Inspections and Testing was carried out on the stripped ground surfaces and during the placement and compaction of fill materials. Field and laboratory testing included proof roll testing of the stripped surface and compaction testing.

Compaction testing at the Eden’s Crossing Stage 21 Development was carried out at a frequency of 1 test per 500m³ of placed and compacted fill as defined in AS3798 Table 8.1. Test locations were selected using Random Stratified methods. Compaction testing was carried out at frequencies representative of the fill volume as a mass. On this basis, compaction testing was not required on each individual Lot.

A marked-up site plan shown the location of compaction testing is attached.

Fill constructed on Lot 1048 has been observed to be placed and compacted in accordance with the Brief. The fill on Lot 1048 can be termed as "Controlled Fill" in accordance with AS 2870-2011 "Residential Slabs and Footings".

This statement does not include any topsoil, which may have been placed for use as Lot dressing or any other subsequent earthworks after March 2020.

If there are any queries concerning the above please do not hesitate to contact this office, or alternatively send to my email at mickmorrison@morrisongeo.com.au.

Yours faithfully,


A handwritten signature in grey ink, appearing to read 'Rhys Mitchell', with a horizontal line extending to the right.

RHYS MITCHELL

For and on Behalf of

MORRISON GEOTECHNIC PTY LIMITED

Encl: Marked Up Site Pan

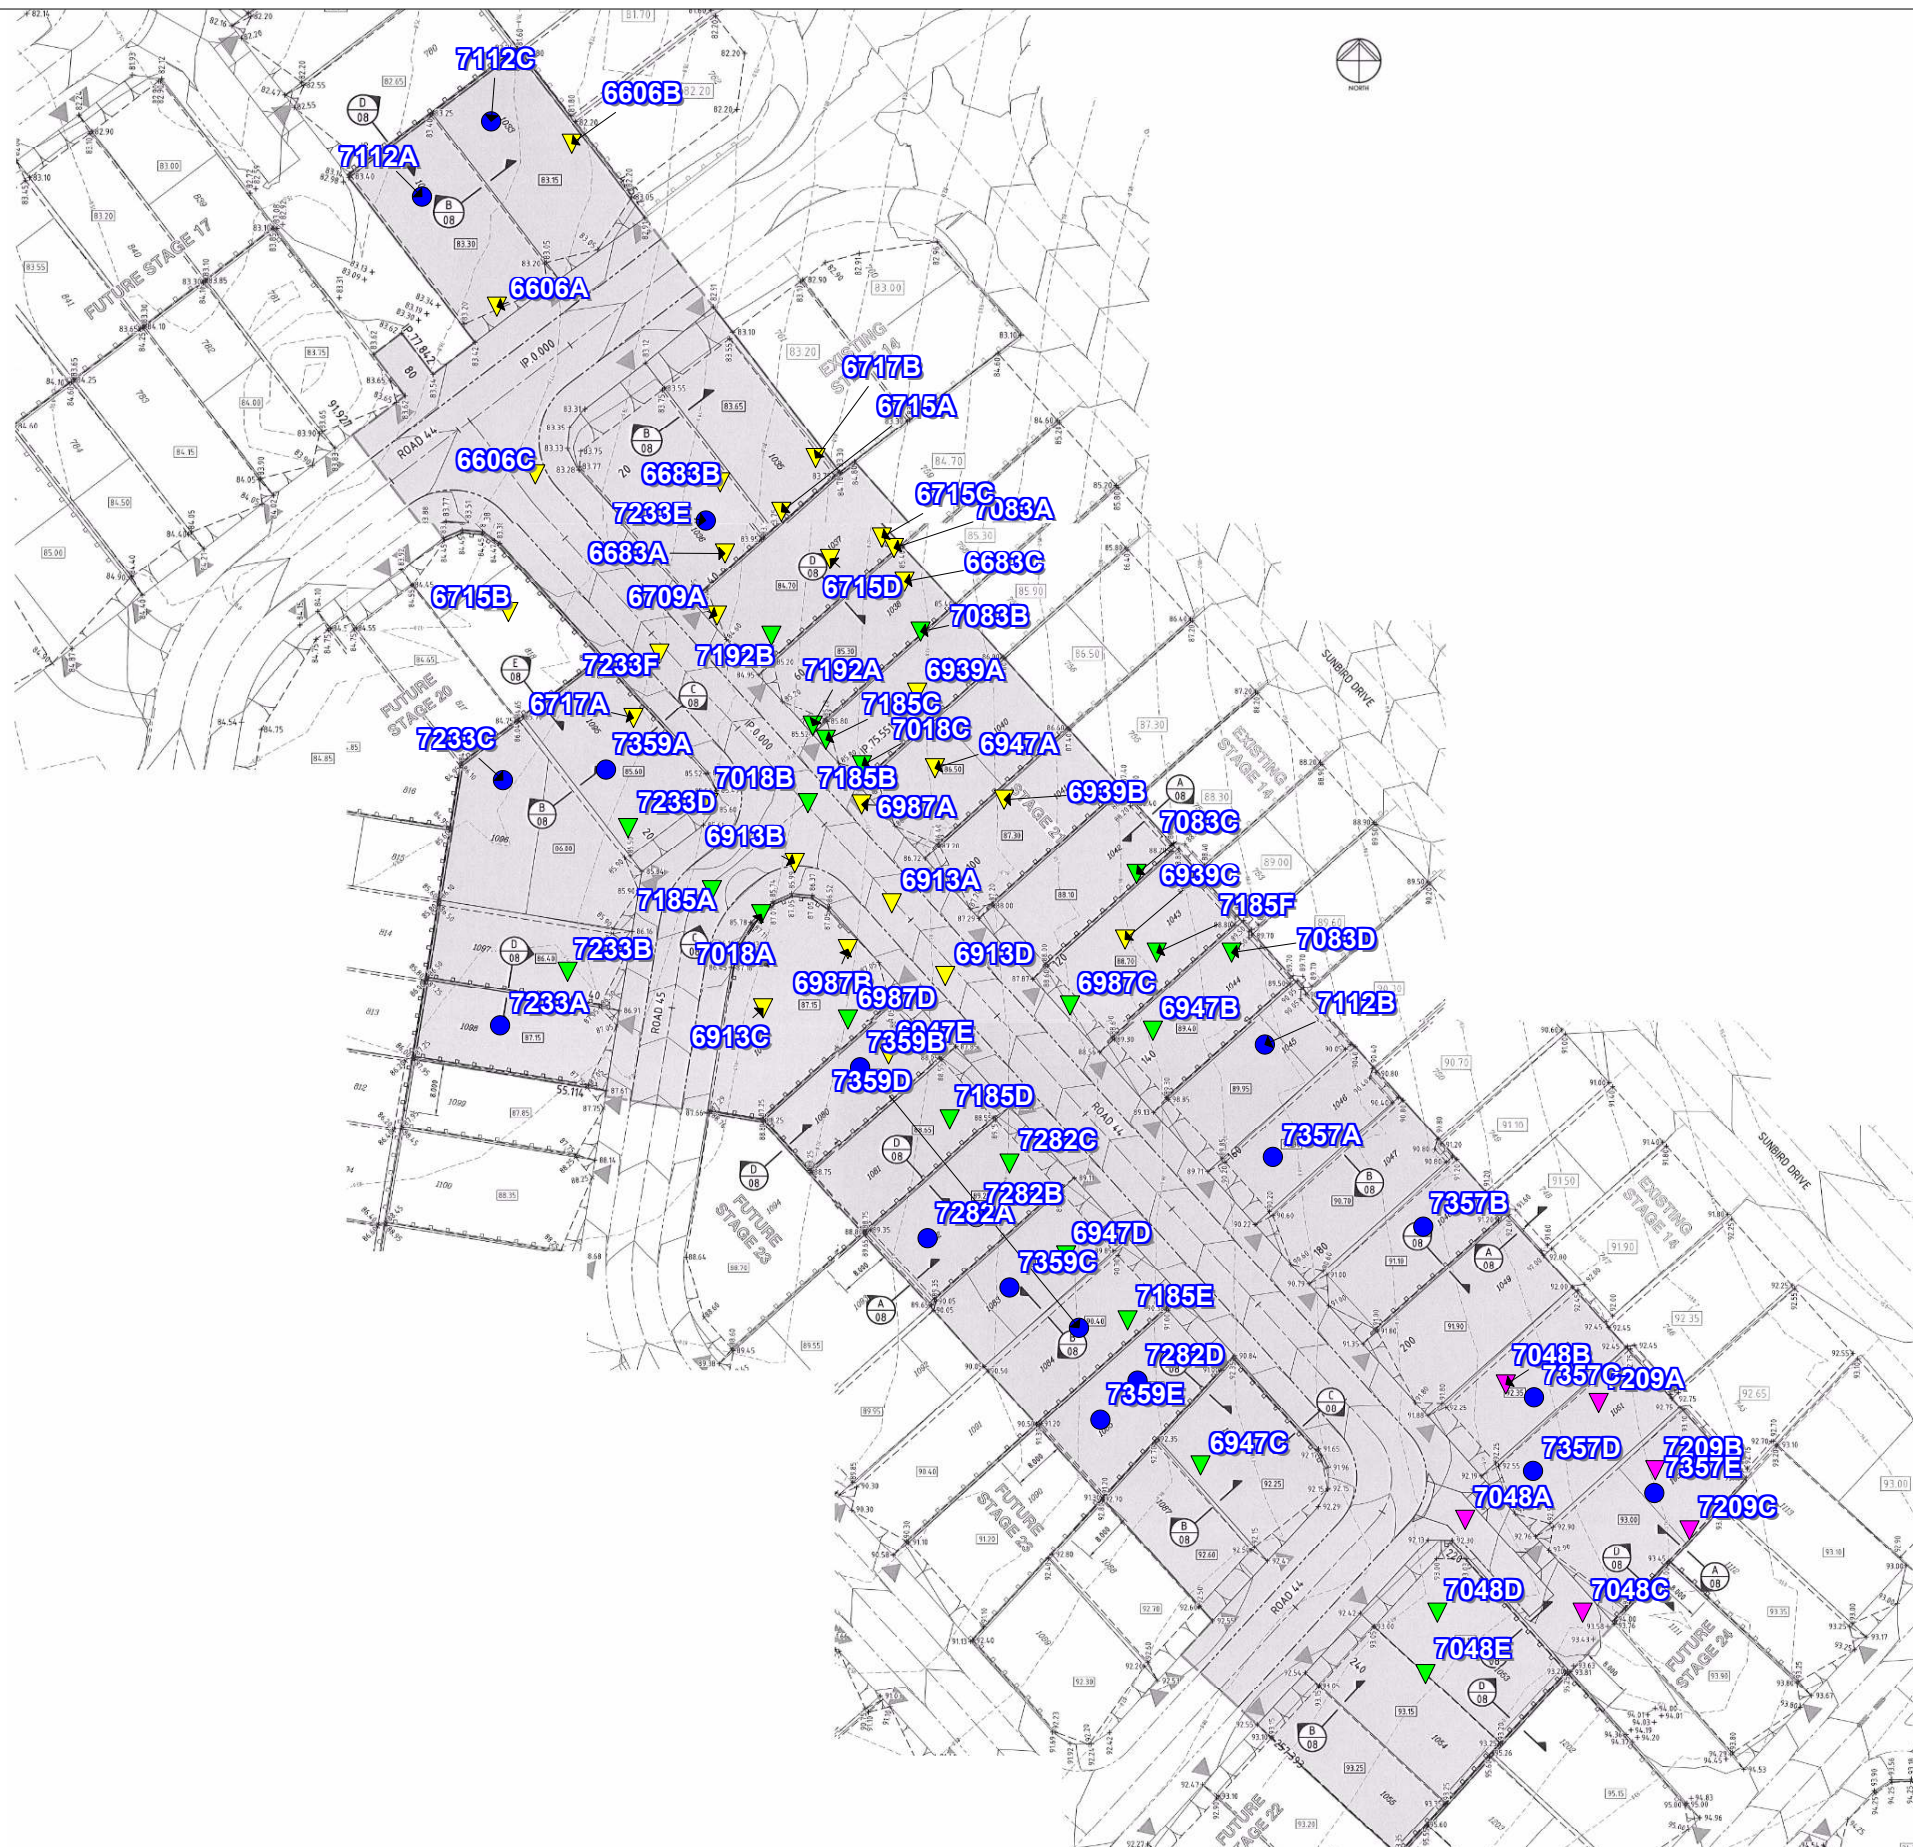

MORRISON GEOTECHNIC PTY LTD

ABN: 51 009 878 899

Unit 1/ 35 Limestone St, Darra 4076 Ph: 3279 0900
 Email: brisbanelab@morrisongeo.com.au

Engineers: M. Ballard
 D. Dragun
 Geologists: R. Howchin
 Laboratory: M. Morrison

LEGEND

- ▼ R.L 80.0 - 84.99
- ▼ R.L 85.0 - 89.99
- ▼ R.L 90.0 - 94.99
- Final Level

Map Description :	EARTHWORKS FIELD DENSITY TESTING - Level 1 Inspection		
Client :	SHADFORTHS PTY LTD		
Project :	EDENS CROSSING - STAGE 21		
Project No :	DL20/027	Drawing No :	DL20/027 - 01
		Scale :	Not to Scale



MORRISON GEOTECHNIC PTY LTD

ABN: 51 009 878 899

Unit 1/ 35 Limestone St, Darra 4076 Ph: 3279 0900
 Email: brisbanelab@morrisongeo.com.au Fax: 3279 0955

Engineers: D.Riley, J. Daly
 D.Dragun, & S.Wynne
 Geologists: L.Bexley & R.Howchin
 Laboratory: M.Morrison

LEGEND

- ▼ R.L 77.0 - 78.99
- ▼ R.L 79.0 - 80.99
- ▼ R.L 81.0 - 82.99
- ▼ R.L 83.0 - 84.99
- Final Level

Map Description :	EARTHWORKS FIELD DENSITY TESTING - Level 1 Inspection		
Client :	CCA WINSLOW		
Project :	EDENS CROSSING, FUTURE STAGES 15-20		
Project No :	DL17/398	Drawing No :	DL17/398 - 01
		Scale :	Not to Scale

Brisbane Office
Job Number: DL20/027
Ref No: 16162
Author: R. Mitchell

22nd April 2020

Shadforths Civil Pty Ltd
99 Sandalwood Lane
Forest Glen 4556

ATTENTION: MR MICHAEL PRITCHARD
Email: Michael.Pritchard@shadcivil.com.au

Dear Sir,

**RE: LOT 1049
LEVEL ONE COMPLIANCE REPORT FOR
EARTHWORKS FILL CONSTRUCTION
EDENS CROSSING STAGE 21**

Earthworks filling operations were carried out on Lot 1049 at the above Development to form a working platform to support a future residential building.

Earthworks were constructed by CCA Winslow (The Client) between May 2017 and March 2018 and Shadforths Civil (The Client) between January 2020 and March 2020.

This report should be read in conjunction with Morrison Geotechnic Report “16058 – DL20/027 Shadforths – Level One Compliance Report – Eden’s Crossing Stage 21” Dated 21st April 2020. The Brief from the Client for was limited to:

- Level One Inspection of the placement and compaction of fill materials in accordance with AS3798 2007 – “Guidelines on Earthworks for Commercial and Residential Developments”
- Relative Density Control Testing in accordance with AS1289 – Testing of Soils for Engineering Purposes and at frequencies required in AS3798 Table 8.
- Ipswich City Council Specifications.
- Notes on KN Group Pty Ltd Civil Drawings.

Level One Inspections and Testing was carried out on the stripped ground surfaces and during the placement and compaction of fill materials. Field and laboratory testing included proof roll testing of the stripped surface and compaction testing.

Compaction testing at the Eden’s Crossing Stage 21 Development was carried out at a frequency of 1 test per 500m³ of placed and compacted fill as defined in AS3798 Table 8.1. Test locations were selected using Random Stratified methods. Compaction testing was carried out at frequencies representative of the fill volume as a mass. On this basis, compaction testing was not required on each individual Lot.

A marked-up site plan shown the location of compaction testing is attached.

Fill constructed on Lot 1049 has been observed to be placed and compacted in accordance with the Brief. The fill on Lot 1049 can be termed as "Controlled Fill" in accordance with AS 2870-2011 "Residential Slabs and Footings".

This statement does not include any topsoil, which may have been placed for use as Lot dressing or any other subsequent earthworks after March 2020.

If there are any queries concerning the above please do not hesitate to contact this office, or alternatively send to my email at mickmorrison@morrisongeo.com.au.

Yours faithfully,


A handwritten signature in grey ink, appearing to read 'Rhys Mitchell', with a long horizontal flourish extending to the right.

RHYS MITCHELL

For and on Behalf of

MORRISON GEOTECHNIC PTY LIMITED

Encl: Marked Up Site Pan

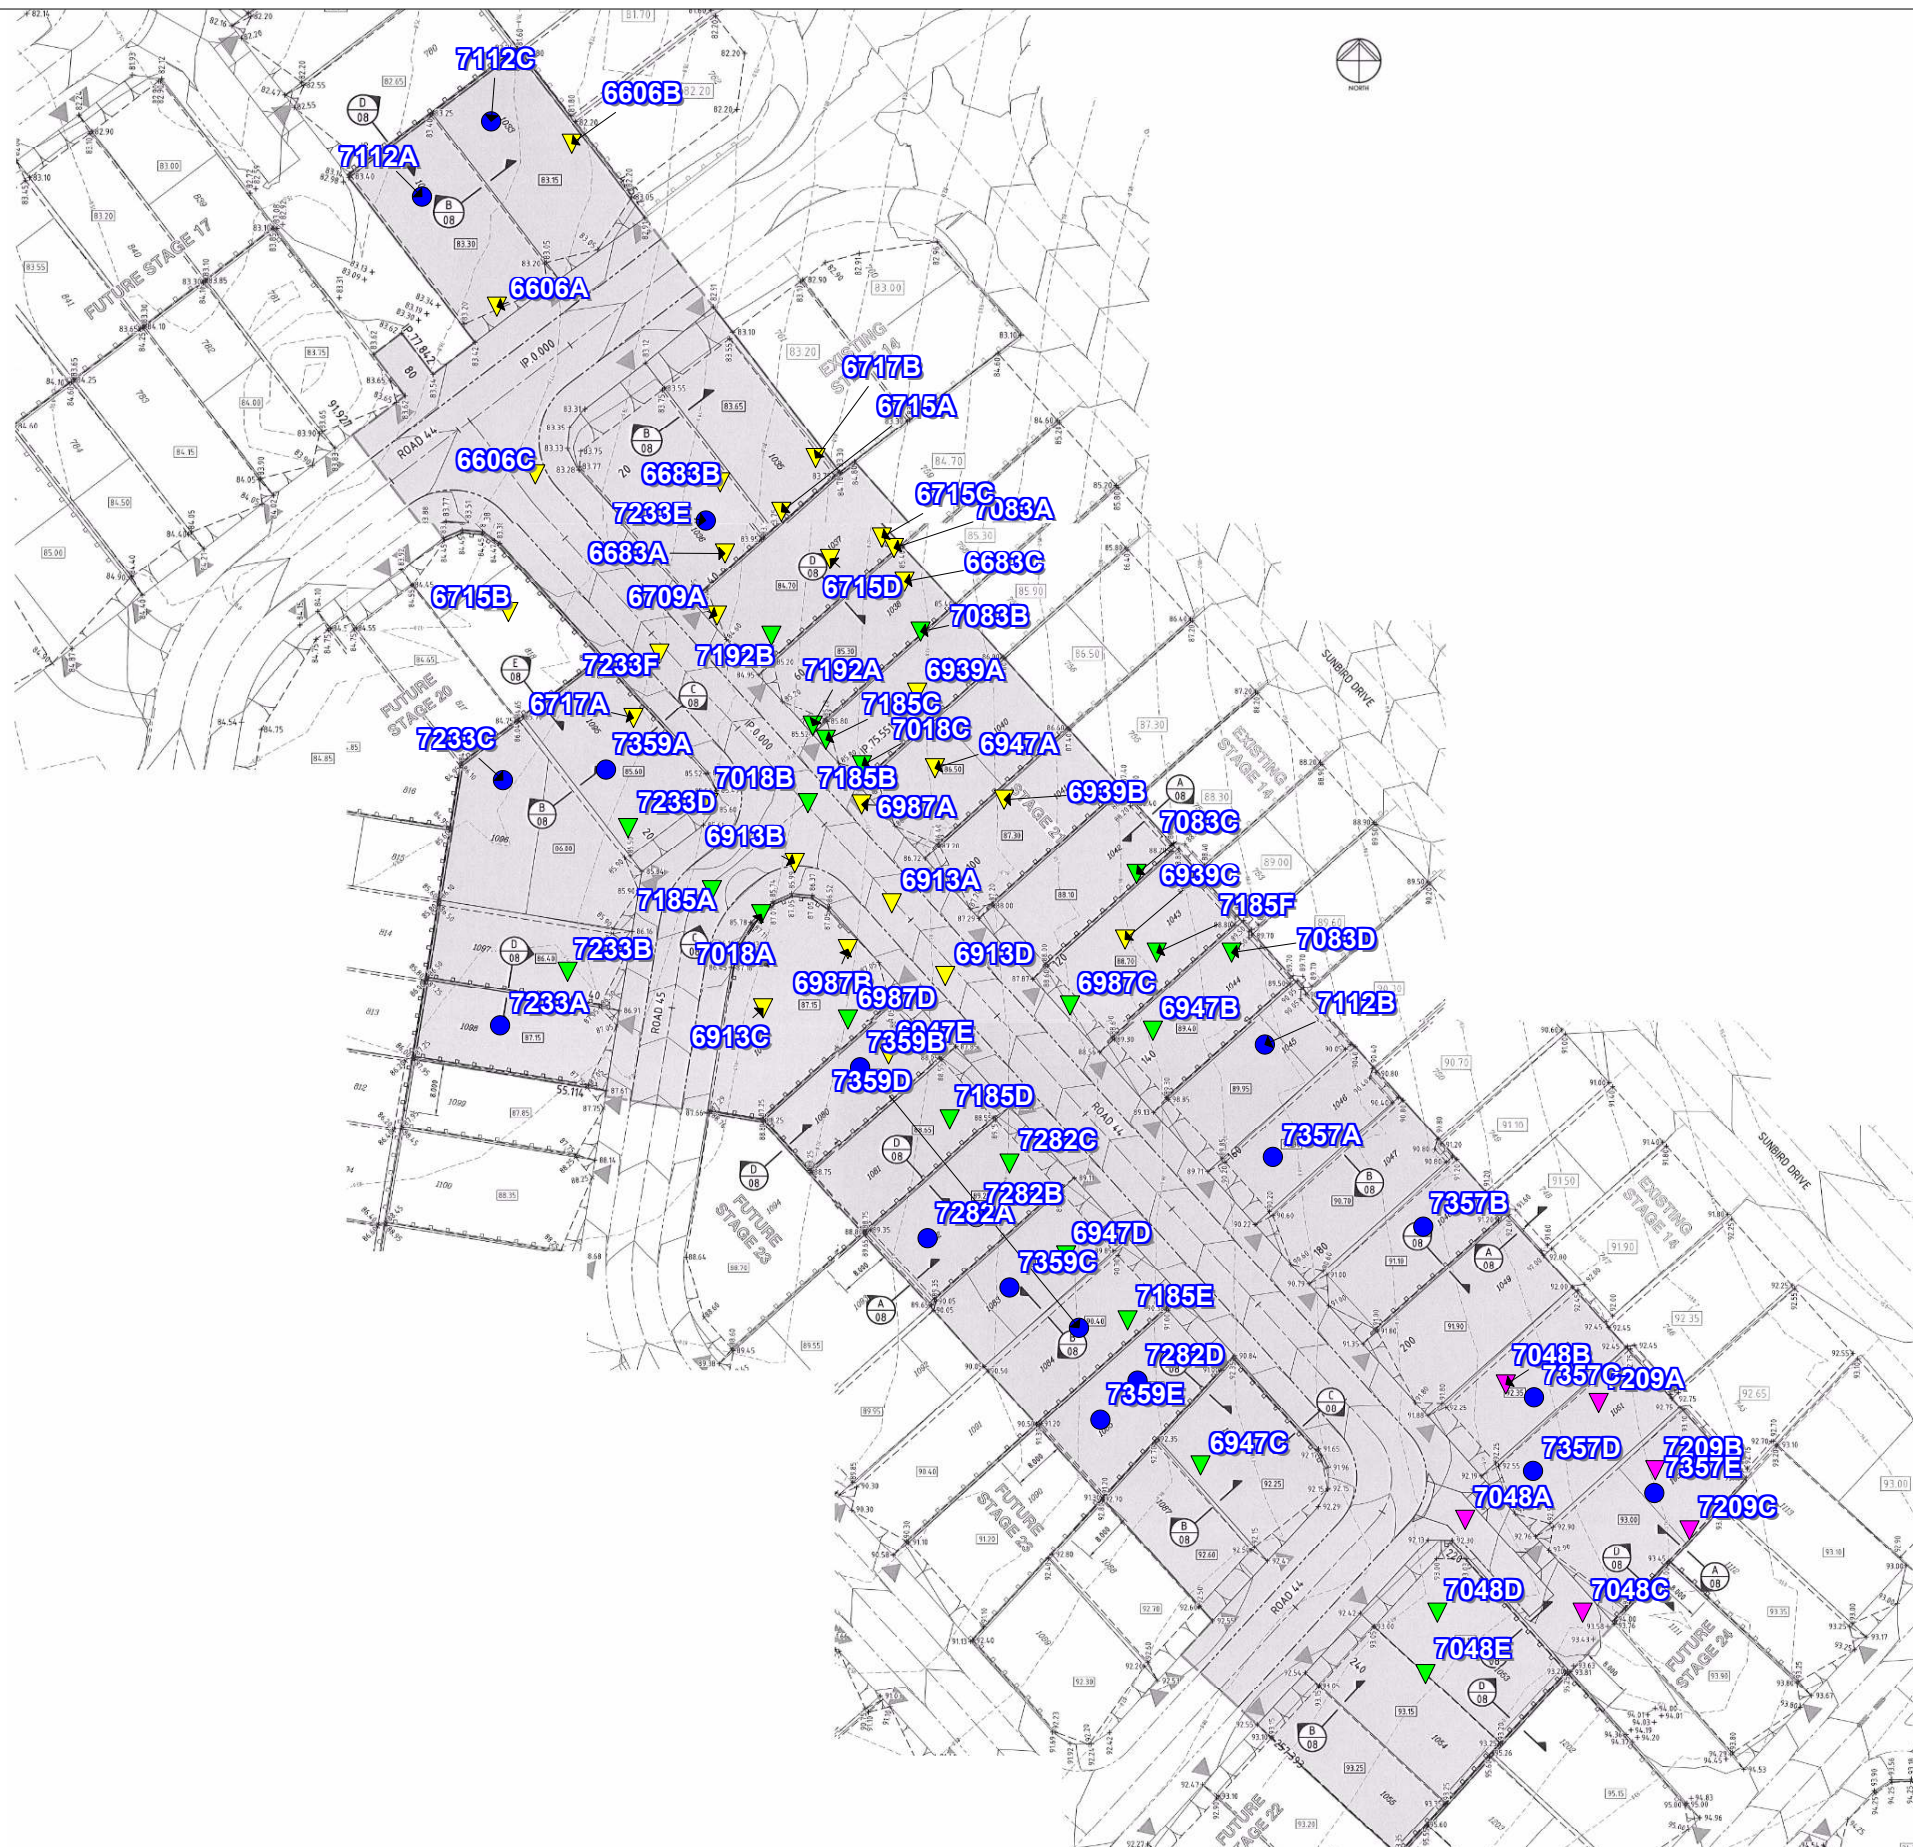

MORRISON GEOTECHNIC PTY LTD

ABN: 51 009 878 899

Unit 1/ 35 Limestone St, Darra 4076 Ph: 3279 0900
 Email: brisbanelab@morrisongeo.com.au

Engineers: M. Ballard
 D. Dragun
 Geologists: R. Howchin
 Laboratory: M. Morrison

LEGEND

- ▲ R.L 80.0 - 84.99
- ▲ R.L 85.0 - 89.99
- ▲ R.L 90.0 - 94.99
- Final Level

Map Description :	EARTHWORKS FIELD DENSITY TESTING - Level 1 Inspection		
Client :	SHADFORTHS PTY LTD		
Project :	EDENS CROSSING - STAGE 21		
Project No :	DL20/027	Drawing No :	DL20/027 - 01
		Scale :	Not to Scale



MORRISON GEOTECHNIC PTY LTD

ABN: 51 009 878 899

Unit 1/ 35 Limestone St, Darra 4076 Ph: 3279 0900
 Email: brisbanelab@morrisongeo.com.au Fax: 3279 0955

Engineers: D.Riley, J. Daly
 D.Dragun, & S.Wynne
 Geologists: L.Bexley & R.Howchin
 Laboratory: M.Morrison

LEGEND

- ▼ R.L 77.0 - 78.99
- ▼ R.L 79.0 - 80.99
- ▼ R.L 81.0 - 82.99
- ▼ R.L 83.0 - 84.99
- ▼ R.L 85.0 - 86.99
- Final Level

Map Description :	EARTHWORKS FIELD DENSITY TESTING - Level 1 Inspection		
Client :	CCA WINSLOW		
Project :	EDENS CROSSING, FUTURE STAGES 15-20		
Project No :	DL17/398	Drawing No :	DL17/398 - 01
		Scale :	Not to Scale

Brisbane Office
Job Number: DL20/027
Ref No: 16163
Author: R. Mitchell

22nd April 2020

Shadforths Civil Pty Ltd
99 Sandalwood Lane
Forest Glen 4556

ATTENTION: MR MICHAEL PRITCHARD
Email: Michael.Pritchard@shadcivil.com.au

Dear Sir,

**RE: LOT 1050
LEVEL ONE COMPLIANCE REPORT FOR
EARTHWORKS FILL CONSTRUCTION
EDENS CROSSING STAGE 21**

Earthworks filling operations were carried out on Lot 1050 at the above Development to form a working platform to support a future residential building.

Earthworks were constructed by CCA Winslow (The Client) between May 2017 and March 2018 and Shadforths Civil (The Client) between January 2020 and March 2020.

This report should be read in conjunction with Morrison Geotechnic Report "16058 – DL20/027 Shadforths – Level One Compliance Report – Eden's Crossing Stage 21" Dated 21st April 2020. The Brief from the Client for was limited to:

- Level One Inspection of the placement and compaction of fill materials in accordance with AS3798 2007 – "Guidelines on Earthworks for Commercial and Residential Developments"
- Relative Density Control Testing in accordance with AS1289 – Testing of Soils for Engineering Purposes and at frequencies required in AS3798 Table 8.
- Ipswich City Council Specifications.
- Notes on KN Group Pty Ltd Civil Drawings.

Level One Inspections and Testing was carried out on the stripped ground surfaces and during the placement and compaction of fill materials. Field and laboratory testing included proof roll testing of the stripped surface and compaction testing.

Compaction testing at the Eden's Crossing Stage 21 Development was carried out at a frequency of 1 test per 500m³ of placed and compacted fill as defined in AS3798 Table 8.1. Test locations were selected using Random Stratified methods. Compaction testing was carried out at frequencies representative of the fill volume as a mass. On this basis, compaction testing was not required on each individual Lot.

A marked-up site plan shown the location of compaction testing is attached.

Fill constructed on Lot 1050 has been observed to be placed and compacted in accordance with the Brief. The fill on Lot 1050 can be termed as "Controlled Fill" in accordance with AS 2870-2011 "Residential Slabs and Footings".

This statement does not include any topsoil, which may have been placed for use as Lot dressing or any other subsequent earthworks after March 2020.

If there are any queries concerning the above please do not hesitate to contact this office, or alternatively send to my email at mickmorrison@morrisongeo.com.au.

Yours faithfully,


A handwritten signature in grey ink, appearing to read 'Rhys Mitchell', with a long horizontal flourish extending to the right.

RHYS MITCHELL

For and on Behalf of

MORRISON GEOTECHNIC PTY LIMITED

Encl: Marked Up Site Pan

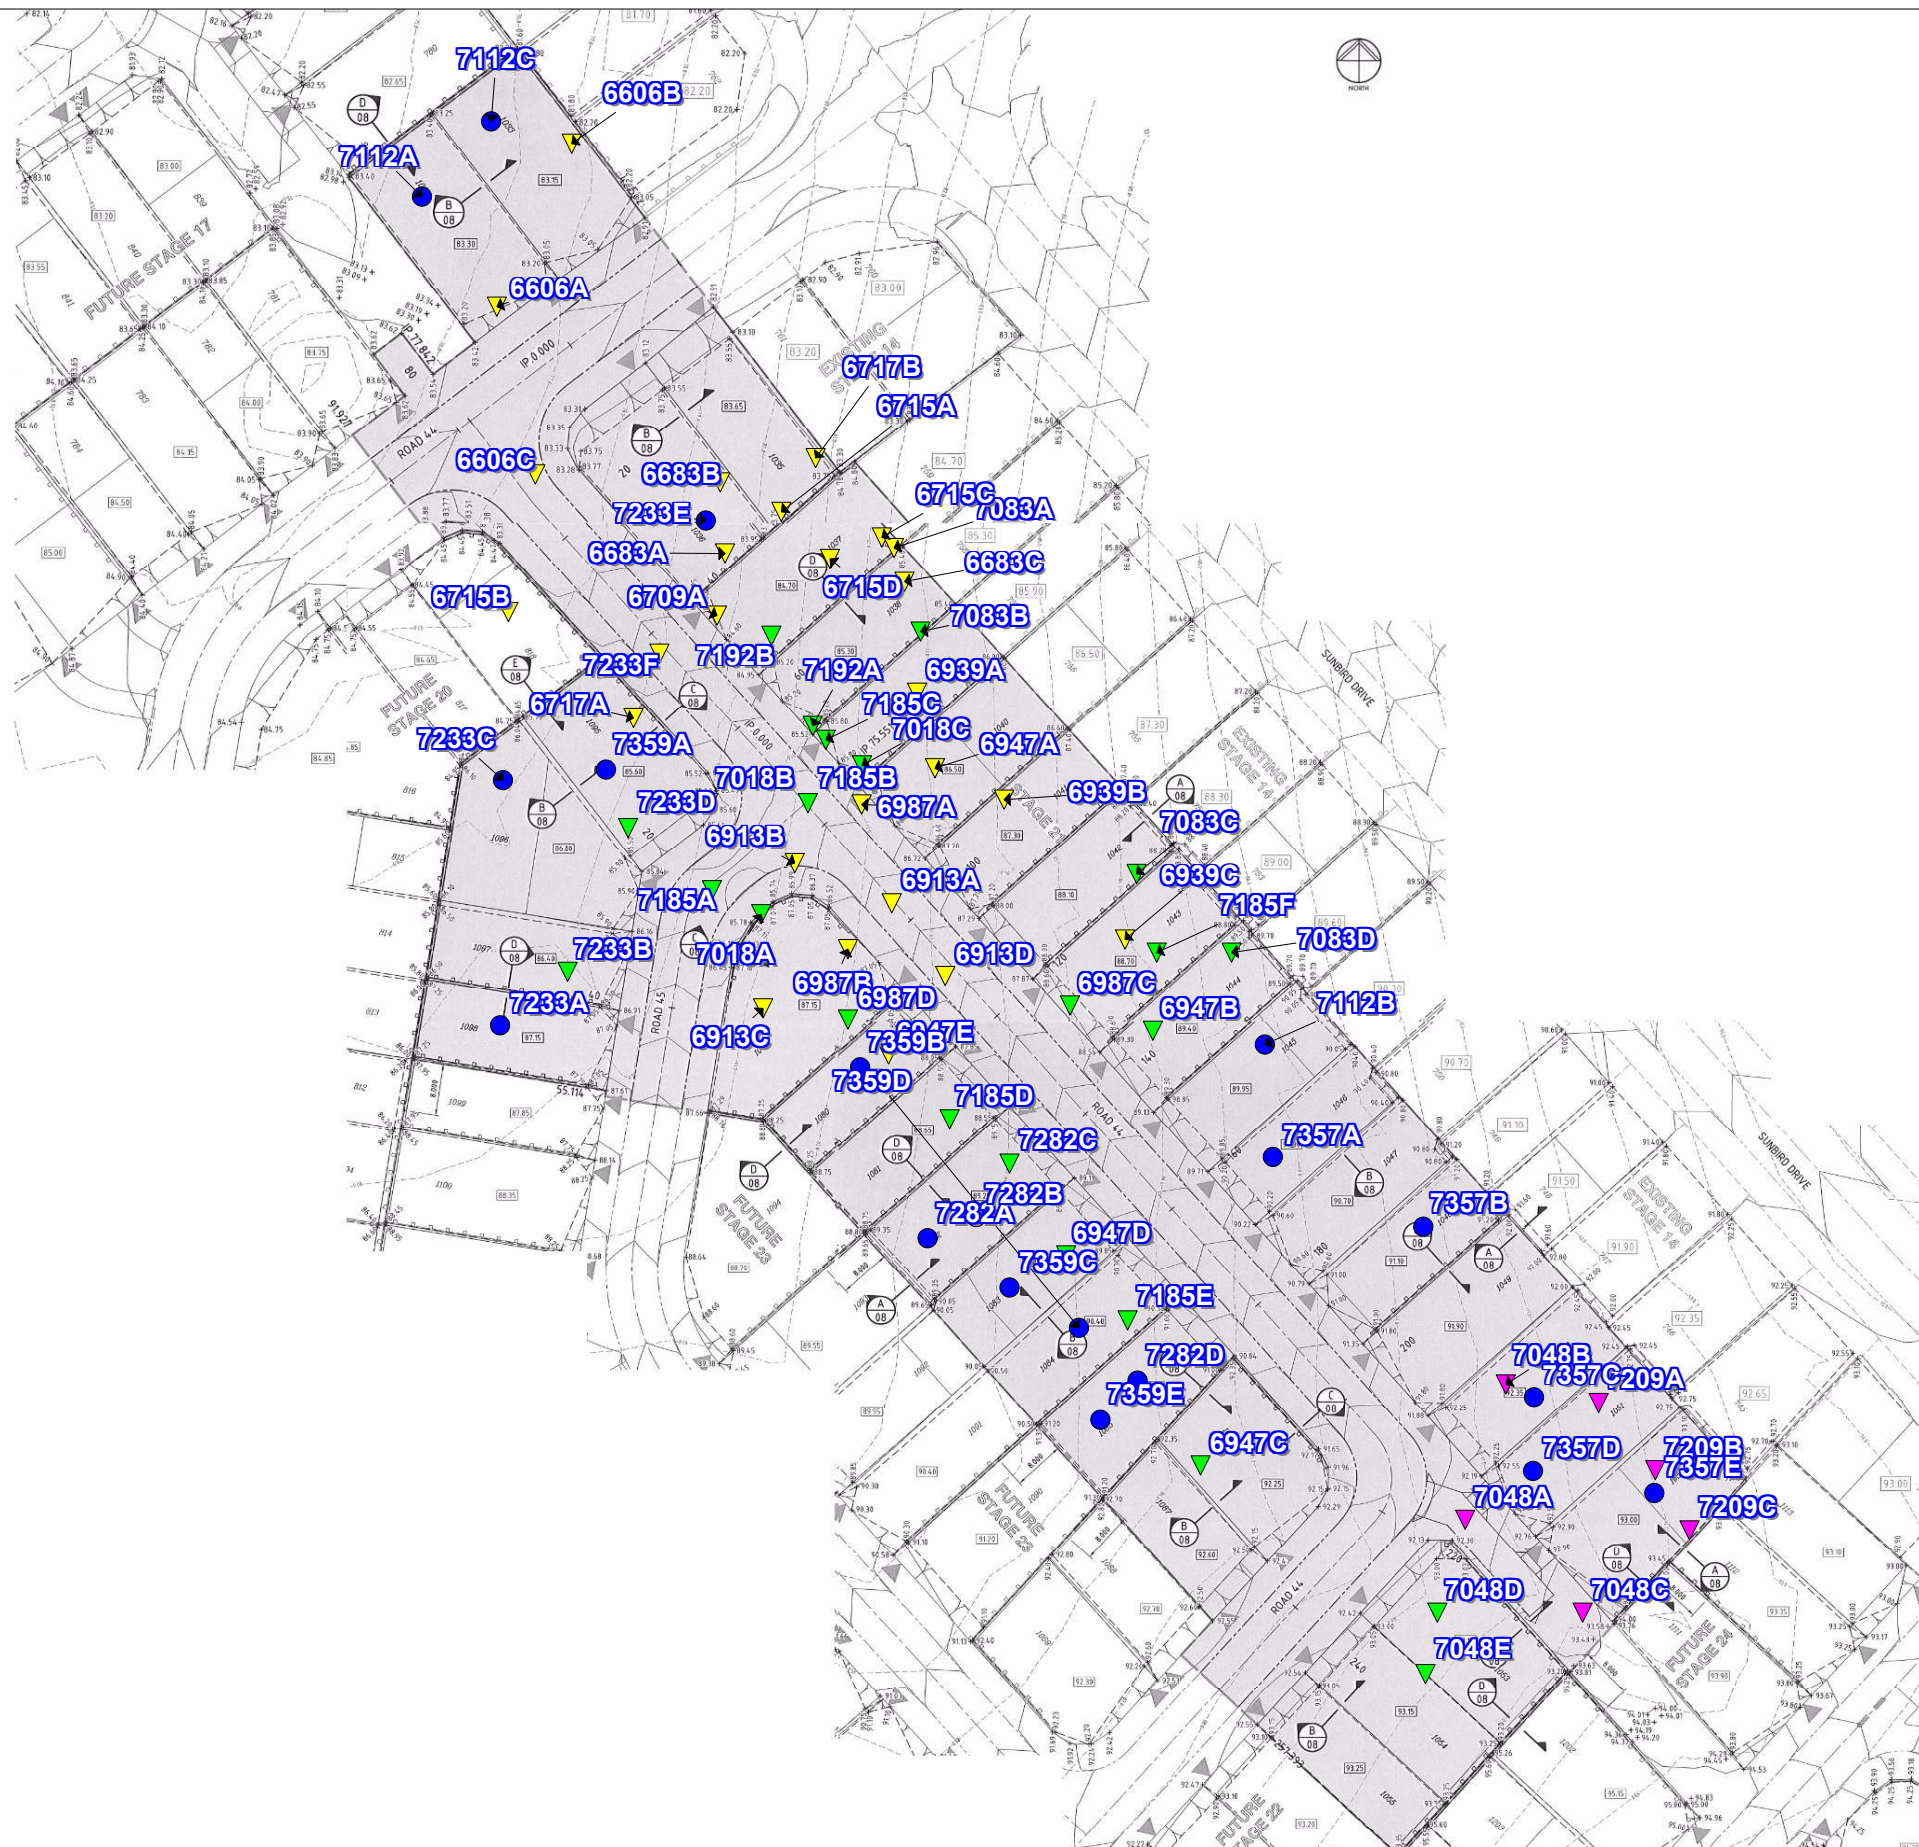

MORRISON GEOTECHNIC PTY LTD

ABN: 51 009 878 899

Unit 1/ 35 Limestone St, Darra 4076 Ph: 3279 0900
 Email: brisbanelab@morrisongeo.com.au

Engineers: M. Ballard
 D. Dragun
 Geologists: R. Howchin
 Laboratory: M. Morrison

LEGEND

- ▼ R.L 80.0 - 84.99
- ▼ R.L 85.0 - 89.99
- ▼ R.L 90.0 - 94.99
- Final Level

Map Description :	EARTHWORKS FIELD DENSITY TESTING - Level 1 Inspection		
Client :	SHADFORTHS PTY LTD		
Project :	EDENS CROSSING - STAGE 21		
Project No :	DL20/027	Drawing No :	DL20/027 - 01
		Scale :	Not to Scale



MORRISON GEOTECHNIC PTY LTD

ABN: 51 009 878 899

Unit 1/ 35 Limestone St, Darra 4076 Ph: 3279 0900
 Email: brisbanelab@morrisongeo.com.au Fax: 3279 0955

Engineers: D.Riley, J. Daly
 D.Dragun, & S.Wynne
 Geologists: L.Bexley & R.Howchin
 Laboratory: M.Morrison

LEGEND

- ▼ R.L 77.0 - 78.99
- ▼ R.L 79.0 - 80.99
- ▼ R.L 81.0 - 82.99
- ▼ R.L 83.0 - 84.99
- Final Level

Map Description :	EARTHWORKS FIELD DENSITY TESTING - Level 1 Inspection		
Client :	CCA WINSLOW		
Project :	EDENS CROSSING, FUTURE STAGES 15-20		
Project No :	DL17/398	Drawing No :	DL17/398 - 01
		Scale :	Not to Scale

Brisbane Office
Job Number: DL20/027
Ref No: 16164
Author: R. Mitchell

22nd April 2020

Shadforths Civil Pty Ltd
99 Sandalwood Lane
Forest Glen 4556

ATTENTION: MR MICHAEL PRITCHARD
Email: Michael.Pritchard@shadcivil.com.au

Dear Sir,

**RE: LOT 1051
LEVEL ONE COMPLIANCE REPORT FOR
EARTHWORKS FILL CONSTRUCTION
EDENS CROSSING STAGE 21**

Earthworks filling operations were carried out on Lot 1051 at the above Development to form a working platform to support a future residential building.

Earthworks were constructed by CCA Winslow (The Client) between May 2017 and March 2018 and Shadforths Civil (The Client) between January 2020 and March 2020.

This report should be read in conjunction with Morrison Geotechnic Report “16058 – DL20/027 Shadforths – Level One Compliance Report – Eden’s Crossing Stage 21” Dated 21st April 2020. The Brief from the Client for was limited to:

- Level One Inspection of the placement and compaction of fill materials in accordance with AS3798 2007 – “Guidelines on Earthworks for Commercial and Residential Developments”
- Relative Density Control Testing in accordance with AS1289 – Testing of Soils for Engineering Purposes and at frequencies required in AS3798 Table 8.
- Ipswich City Council Specifications.
- Notes on KN Group Pty Ltd Civil Drawings.

Level One Inspections and Testing was carried out on the stripped ground surfaces and during the placement and compaction of fill materials. Field and laboratory testing included proof roll testing of the stripped surface and compaction testing.

Compaction testing at the Eden’s Crossing Stage 21 Development was carried out at a frequency of 1 test per 500m³ of placed and compacted fill as defined in AS3798 Table 8.1. Test locations were selected using Random Stratified methods. Compaction testing was carried out at frequencies representative of the fill volume as a mass. On this basis, compaction testing was not required on each individual Lot.

A marked-up site plan shown the location of compaction testing is attached.

Fill constructed on Lot 1051 has been observed to be placed and compacted in accordance with the Brief. The fill on Lot 1051 can be termed as "Controlled Fill" in accordance with AS 2870-2011 "Residential Slabs and Footings".

This statement does not include any topsoil, which may have been placed for use as Lot dressing or any other subsequent earthworks after March 2020.

If there are any queries concerning the above please do not hesitate to contact this office, or alternatively send to my email at mickmorrison@morrisongeo.com.au.

Yours faithfully,


A handwritten signature in grey ink, appearing to read 'Rhys Mitchell', with a horizontal line extending to the right.

RHYS MITCHELL

For and on Behalf of

MORRISON GEOTECHNIC PTY LIMITED

Encl: Marked Up Site Pan

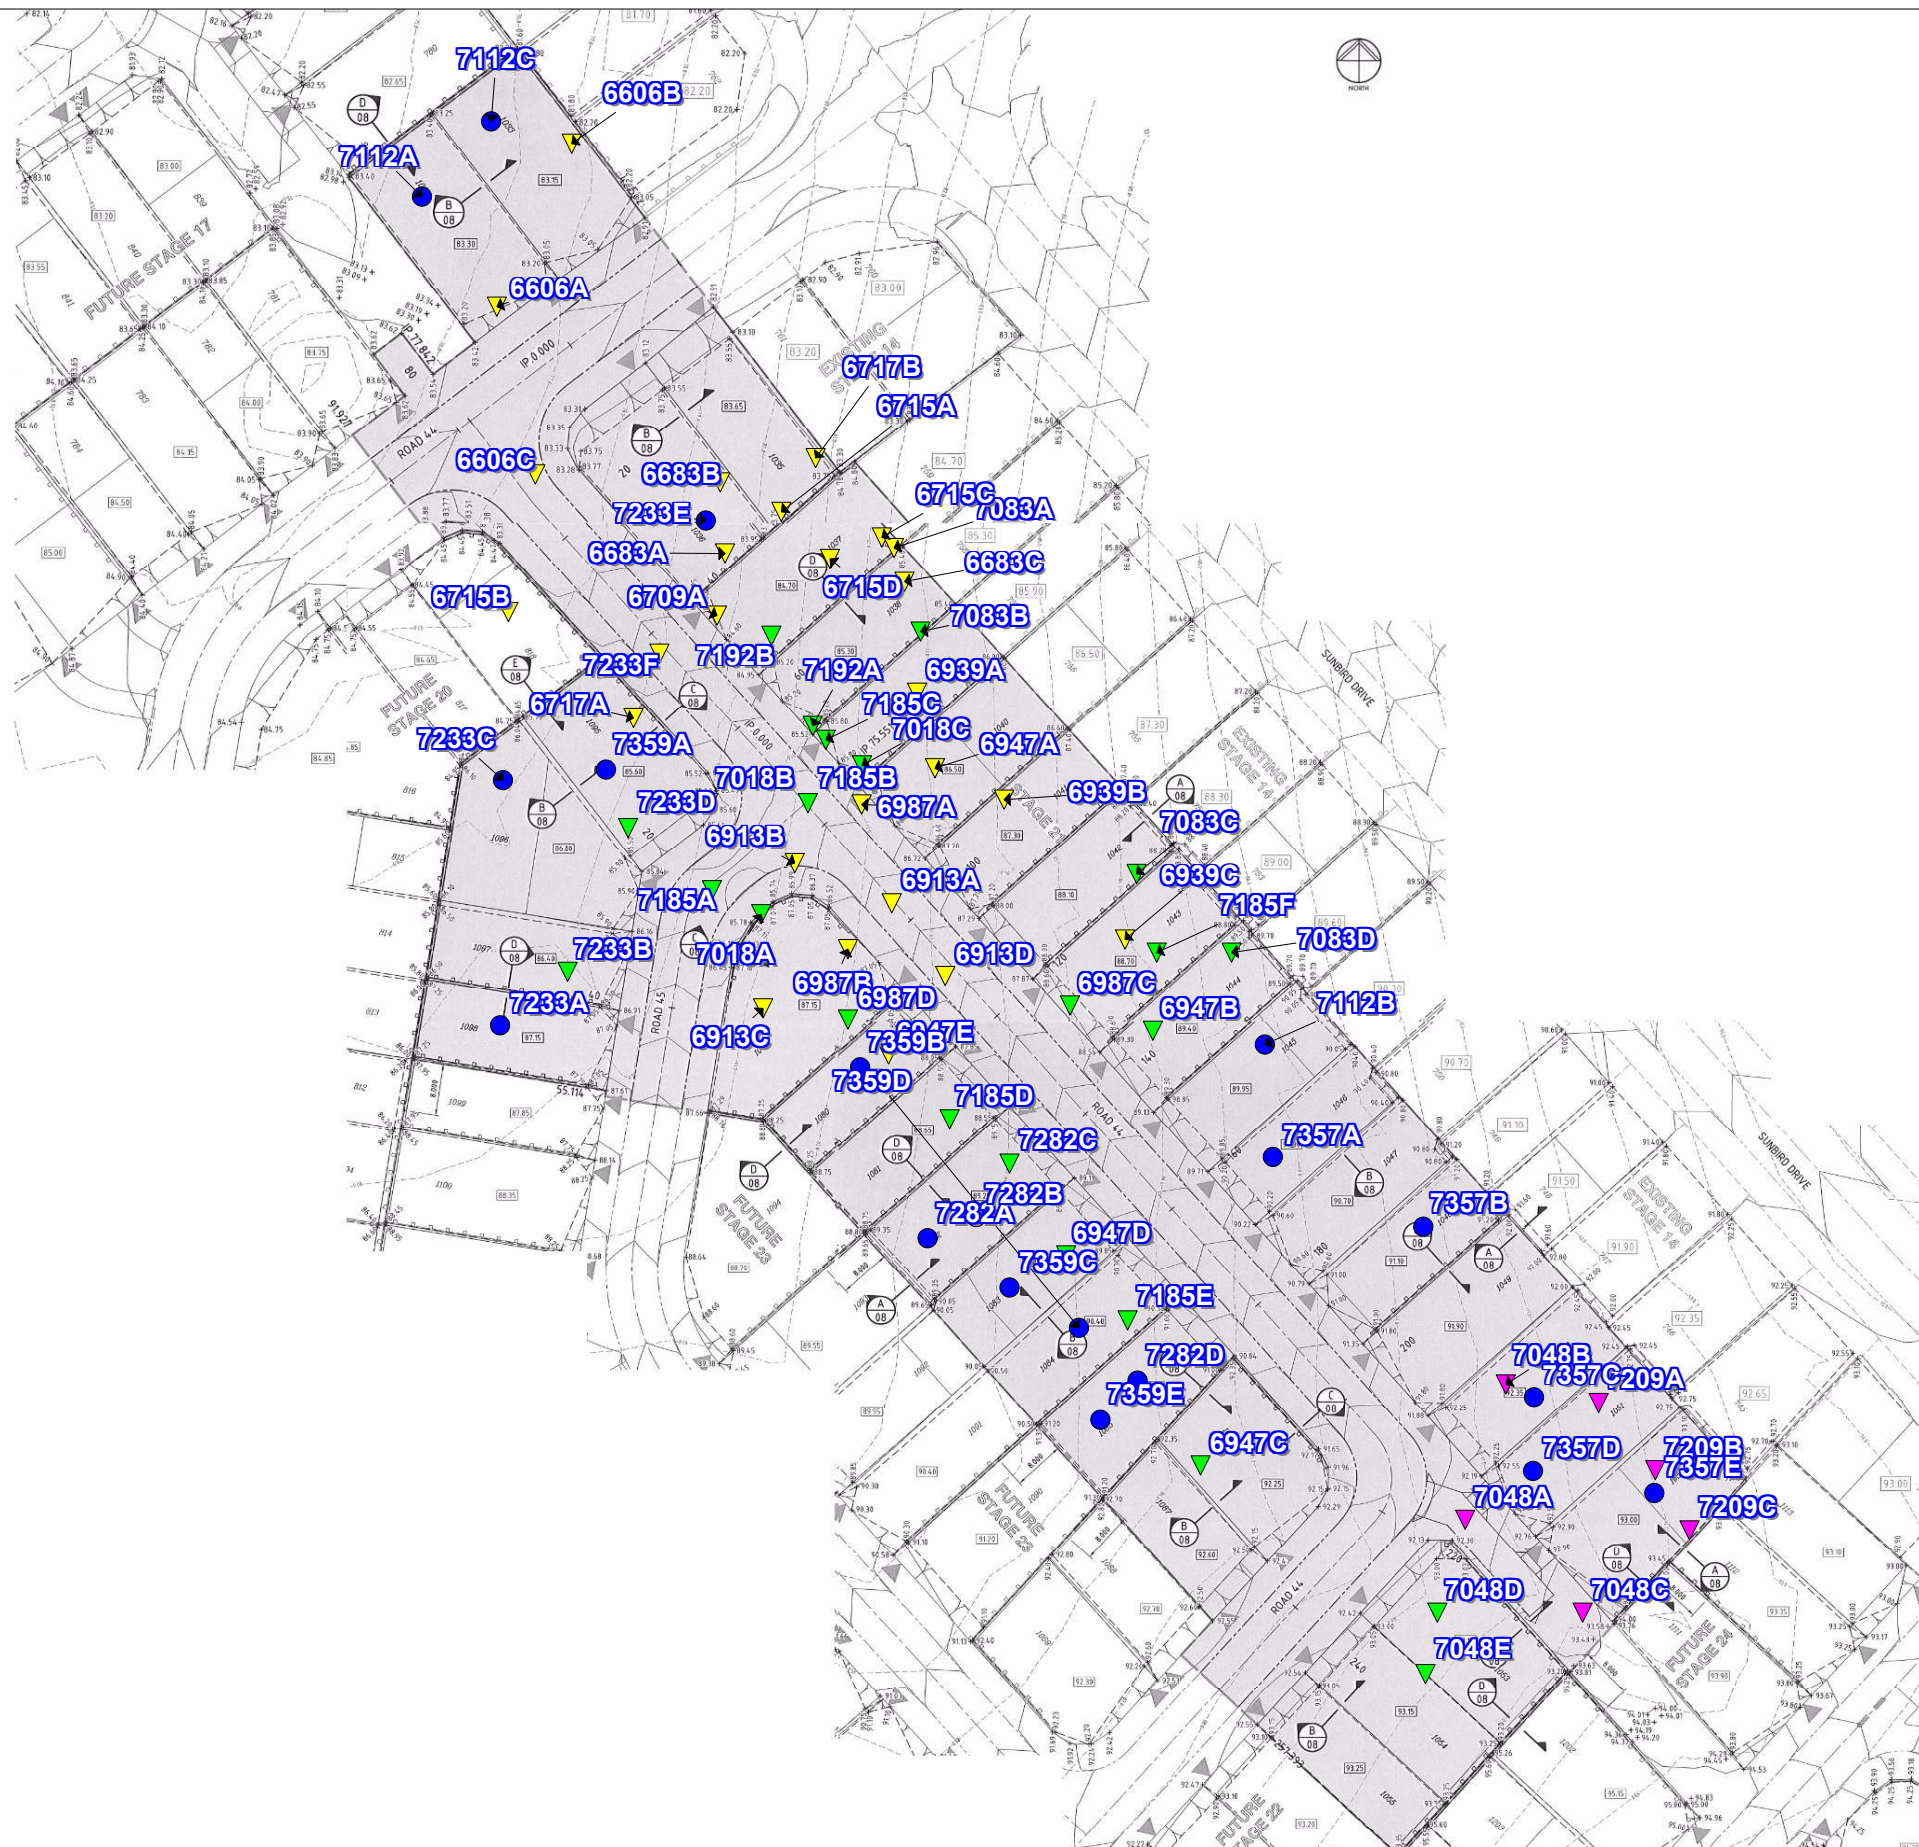

MORRISON GEOTECHNIC PTY LTD

ABN: 51 009 878 899

Unit 1/ 35 Limestone St, Darra 4076 Ph: 3279 0900
 Email: brisbanelab@morrisongeo.com.au

Engineers: M. Ballard
 D. Dragun
 Geologists: R. Howchin
 Laboratory: M. Morrison

LEGEND

- ▲ R.L 80.0 - 84.99
- ▲ R.L 85.0 - 89.99
- ▲ R.L 90.0 - 94.99
- Final Level

Map Description :	EARTHWORKS FIELD DENSITY TESTING - Level 1 Inspection		
Client :	SHADFORTHS PTY LTD		
Project :	EDENS CROSSING - STAGE 21		
Project No :	DL20/027	Drawing No :	DL20/027 - 01
		Scale :	Not to Scale



MORRISON GEOTECHNIC PTY LTD

ABN: 51 009 878 899

Unit 1/ 35 Limestone St, Darra 4076 Ph: 3279 0900
 Email: brisbanelab@morrisongeo.com.au Fax: 3279 0955

Engineers: D.Riley, J. Daly
 D.Dragun, & S.Wynne
 Geologists: L.Bexley & R.Howchin
 Laboratory: M.Morrison

LEGEND

- ▼ R.L 77.0 - 78.99
- ▼ R.L 79.0 - 80.99
- ▼ R.L 81.0 - 82.99
- ▼ R.L 83.0 - 84.99
- Final Level

Map Description :	EARTHWORKS FIELD DENSITY TESTING - Level 1 Inspection		
Client :	CCA WINSLOW		
Project :	EDENS CROSSING, FUTURE STAGES 15-20		
Project No :	DL17/398	Drawing No :	DL17/398 - 01
		Scale :	Not to Scale

Brisbane Office
Job Number: DL20/027
Ref No: 16165
Author: R. Mitchell

22nd April 2020

Shadforths Civil Pty Ltd
99 Sandalwood Lane
Forest Glen 4556

ATTENTION: MR MICHAEL PRITCHARD
Email: Michael.Pritchard@shadcivil.com.au

Dear Sir,

**RE: LOT 1052
LEVEL ONE COMPLIANCE REPORT FOR
EARTHWORKS FILL CONSTRUCTION
EDENS CROSSING STAGE 21**

Earthworks filling operations were carried out on Lot 1052 at the above Development to form a working platform to support a future residential building.

Earthworks were constructed by CCA Winslow (The Client) between May 2017 and March 2018 and Shadforths Civil (The Client) between January 2020 and March 2020.

This report should be read in conjunction with Morrison Geotechnic Report “16058 – DL20/027 Shadforths – Level One Compliance Report – Eden’s Crossing Stage 21” Dated 21st April 2020. The Brief from the Client for was limited to:

- Level One Inspection of the placement and compaction of fill materials in accordance with AS3798 2007 – “Guidelines on Earthworks for Commercial and Residential Developments”
- Relative Density Control Testing in accordance with AS1289 – Testing of Soils for Engineering Purposes and at frequencies required in AS3798 Table 8.
- Ipswich City Council Specifications.
- Notes on KN Group Pty Ltd Civil Drawings.

Level One Inspections and Testing was carried out on the stripped ground surfaces and during the placement and compaction of fill materials. Field and laboratory testing included proof roll testing of the stripped surface and compaction testing.

Compaction testing at the Eden’s Crossing Stage 21 Development was carried out at a frequency of 1 test per 500m³ of placed and compacted fill as defined in AS3798 Table 8.1. Test locations were selected using Random Stratified methods. Compaction testing was carried out at frequencies representative of the fill volume as a mass. On this basis, compaction testing was not required on each individual Lot.

A marked-up site plan shown the location of compaction testing is attached.

Fill constructed on Lot 1052 has been observed to be placed and compacted in accordance with the Brief. The fill on Lot 1052 can be termed as "Controlled Fill" in accordance with AS 2870-2011 "Residential Slabs and Footings".

This statement does not include any topsoil, which may have been placed for use as Lot dressing or any other subsequent earthworks after March 2020.

If there are any queries concerning the above please do not hesitate to contact this office, or alternatively send to my email at mickmorrison@morrisongeo.com.au.

Yours faithfully,


A handwritten signature in grey ink, appearing to read 'Rhys Mitchell', with a horizontal line extending to the right.

RHYS MITCHELL

For and on Behalf of

MORRISON GEOTECHNIC PTY LIMITED

Encl: Marked Up Site Pan

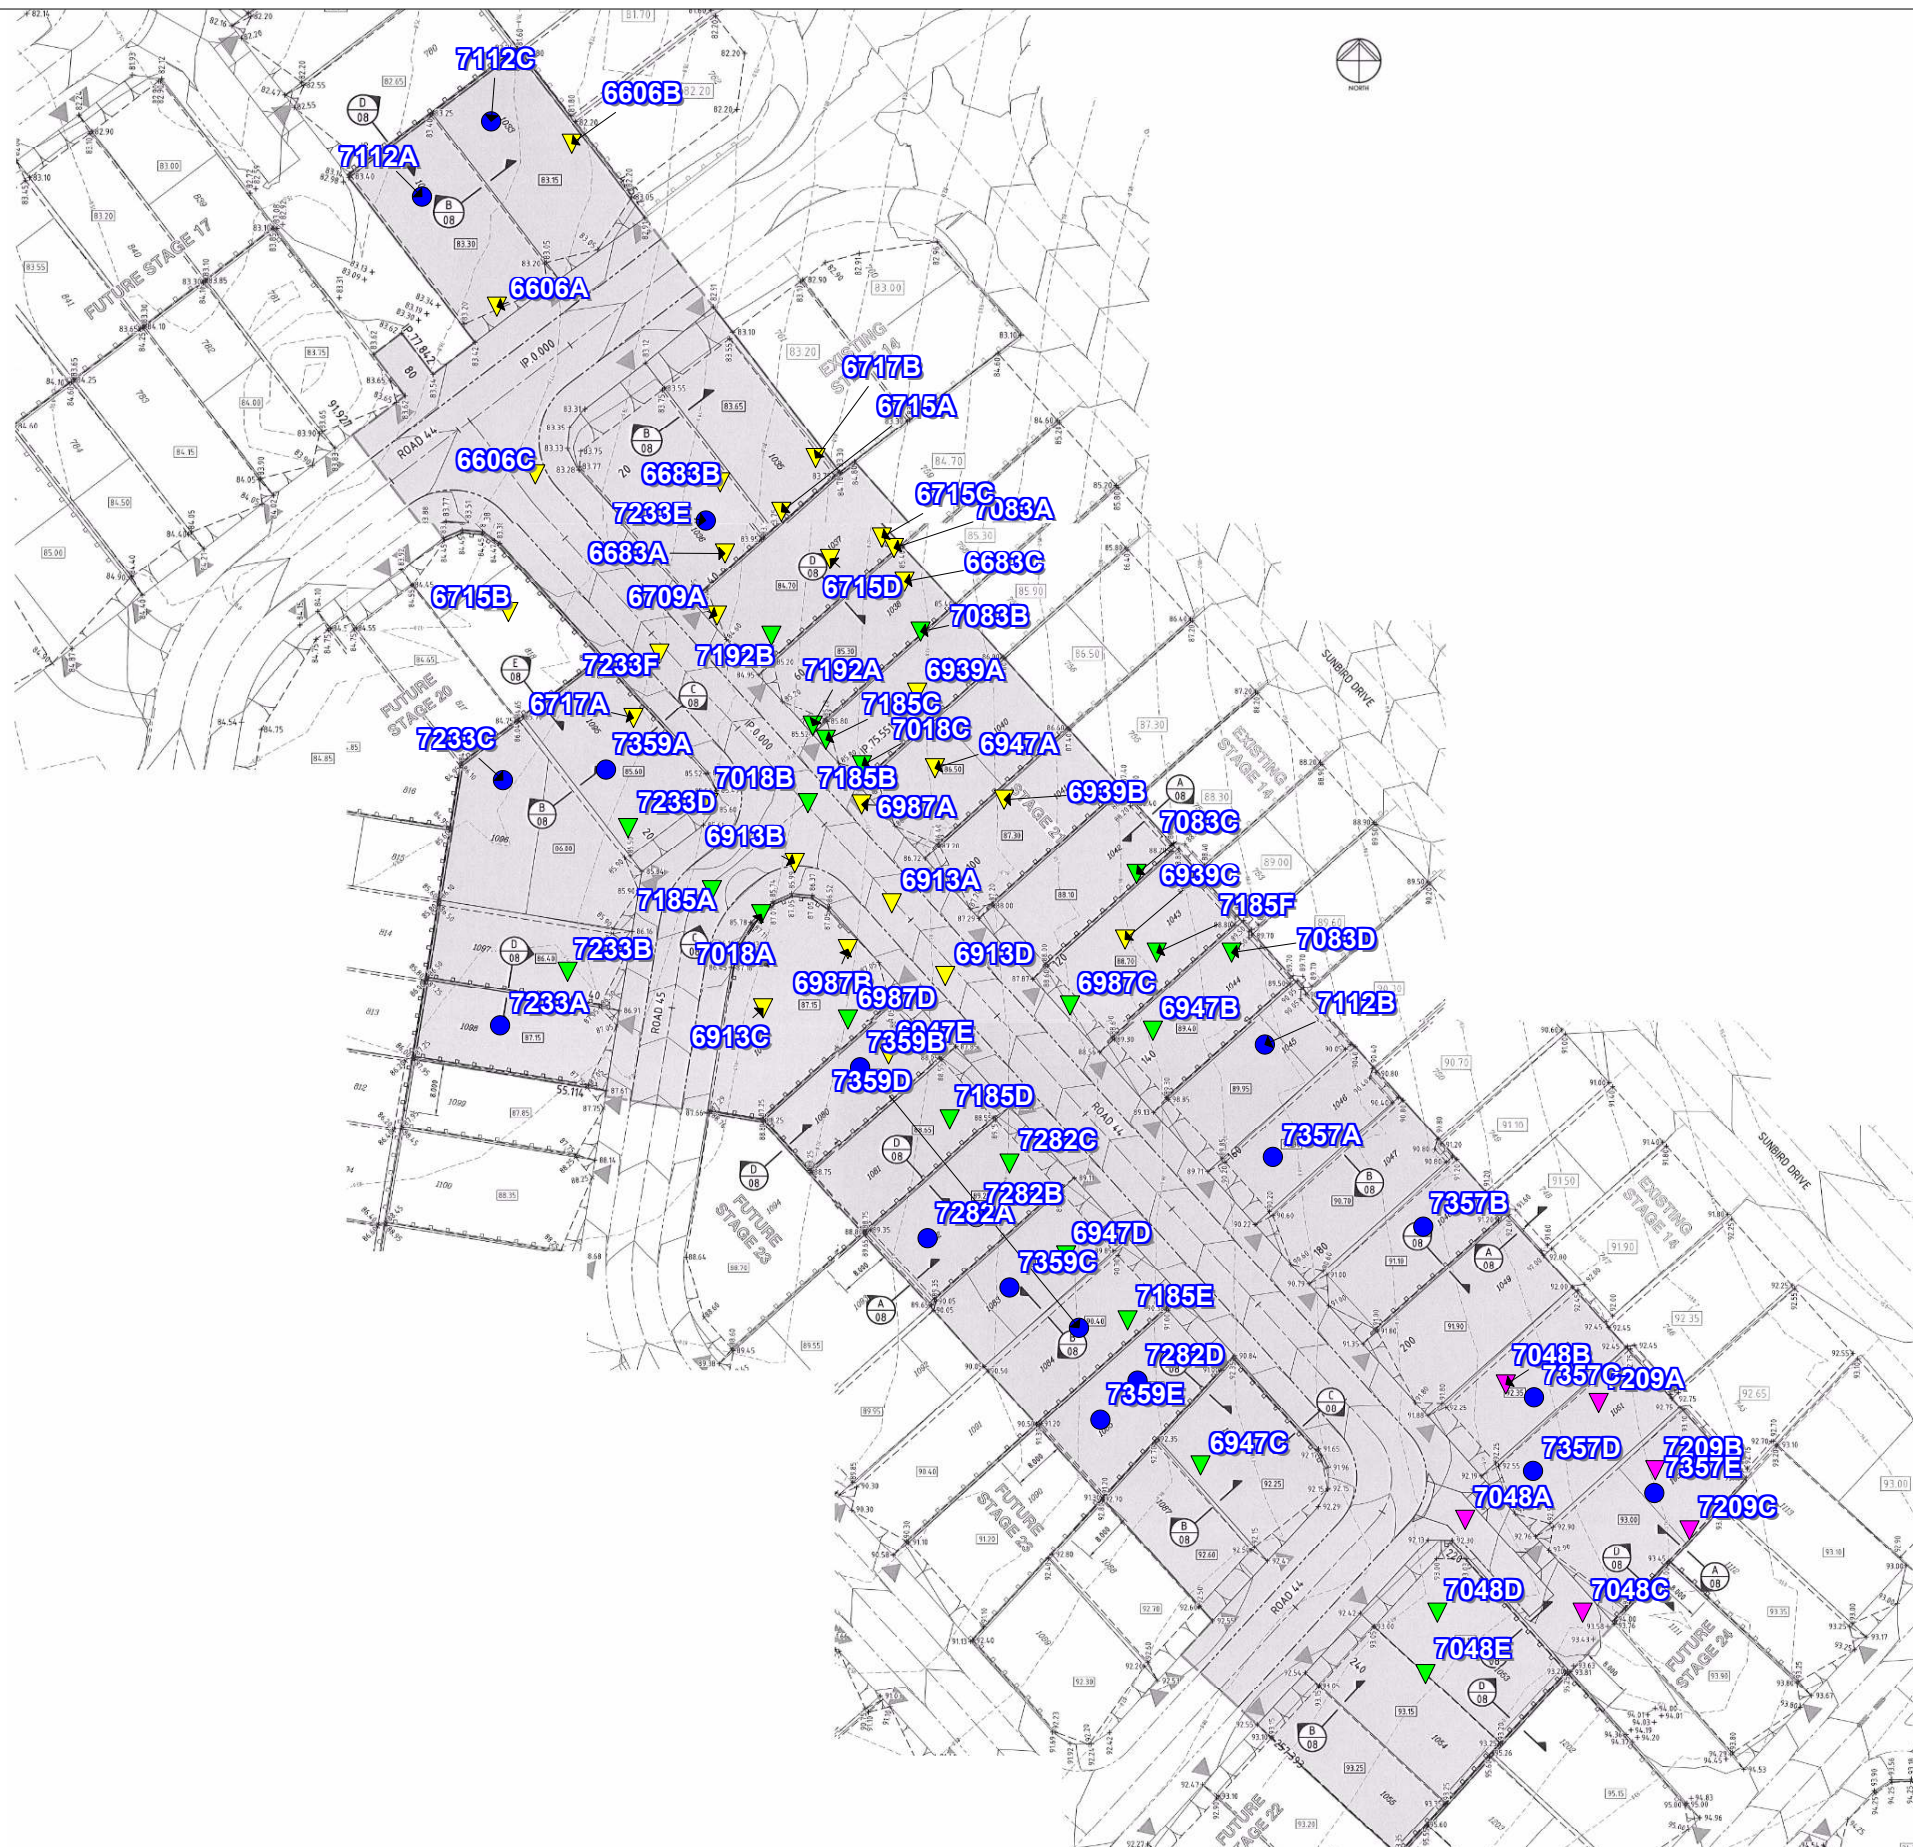

MORRISON GEOTECHNIC PTY LTD

ABN: 51 009 878 899

Unit 1/ 35 Limestone St, Darra 4076 Ph: 3279 0900
 Email: brisbanelab@morrisongeo.com.au

Engineers: M. Ballard
 D. Dragun
 Geologists: R. Howchin
 Laboratory: M. Morrison

LEGEND

- ▲ R.L 80.0 - 84.99
- ▲ R.L 85.0 - 89.99
- ▲ R.L 90.0 - 94.99
- Final Level

Map Description :	EARTHWORKS FIELD DENSITY TESTING - Level 1 Inspection		
Client :	SHADFORTHS PTY LTD		
Project :	EDENS CROSSING - STAGE 21		
Project No :	DL20/027	Drawing No :	DL20/027 - 01
Scale :	Not to Scale		



MORRISON GEOTECHNIC PTY LTD

ABN: 51 009 878 899

Unit 1/ 35 Limestone St, Darra 4076 Ph: 3279 0900
 Email: brisbanelab@morrisongeo.com.au Fax: 3279 0955

Engineers: D.Riley, J. Daly
 D.Dragun, & S.Wynne
 Geologists: L.Bexley & R.Howchin
 Laboratory: M.Morrison

LEGEND

- ▼ R.L 77.0 - 78.99
- ▼ R.L 79.0 - 80.99
- ▼ R.L 81.0 - 82.99
- ▼ R.L 83.0 - 84.99
- Final Level

Map Description :	EARTHWORKS FIELD DENSITY TESTING - Level 1 Inspection		
Client :	CCA WINSLOW		
Project :	EDENS CROSSING, FUTURE STAGES 15-20		
Project No :	DL17/398	Drawing No :	DL17/398 - 01
		Scale :	Not to Scale

Brisbane Office
Job Number: DL20/027
Ref No: 16166
Author: R. Mitchell

22nd April 2020

Shadforths Civil Pty Ltd
99 Sandalwood Lane
Forest Glen 4556

ATTENTION: MR MICHAEL PRITCHARD
Email: Michael.Pritchard@shadcivil.com.au

Dear Sir,

**RE: LOT 1053
LEVEL ONE COMPLIANCE REPORT FOR
EARTHWORKS FILL CONSTRUCTION
EDENS CROSSING STAGE 21**

Earthworks filling operations were carried out on Lot 1053 at the above Development to form a working platform to support a future residential building.

Earthworks were constructed by CCA Winslow (The Client) between May 2017 and March 2018 and Shadforths Civil (The Client) between January 2020 and March 2020.

This report should be read in conjunction with Morrison Geotechnic Report "16058 – DL20/027 Shadforths – Level One Compliance Report – Eden's Crossing Stage 21" Dated 21st April 2020. The Brief from the Client for was limited to:

- Level One Inspection of the placement and compaction of fill materials in accordance with AS3798 2007 – "Guidelines on Earthworks for Commercial and Residential Developments"
- Relative Density Control Testing in accordance with AS1289 – Testing of Soils for Engineering Purposes and at frequencies required in AS3798 Table 8.
- Ipswich City Council Specifications.
- Notes on KN Group Pty Ltd Civil Drawings.

Level One Inspections and Testing was carried out on the stripped ground surfaces and during the placement and compaction of fill materials. Field and laboratory testing included proof roll testing of the stripped surface and compaction testing.

Compaction testing at the Eden's Crossing Stage 21 Development was carried out at a frequency of 1 test per 500m³ of placed and compacted fill as defined in AS3798 Table 8.1. Test locations were selected using Random Stratified methods. Compaction testing was carried out at frequencies representative of the fill volume as a mass. On this basis, compaction testing was not required on each individual Lot.

A marked-up site plan shown the location of compaction testing is attached.

Fill constructed on Lot 1053 has been observed to be placed and compacted in accordance with the Brief. The fill on Lot 1053 can be termed as "Controlled Fill" in accordance with AS 2870-2011 "Residential Slabs and Footings".

This statement does not include any topsoil, which may have been placed for use as Lot dressing or any other subsequent earthworks after March 2020.

If there are any queries concerning the above please do not hesitate to contact this office, or alternatively send to my email at mickmorrison@morrisongeo.com.au.

Yours faithfully,


A handwritten signature in grey ink, appearing to read 'Rhys Mitchell', with a horizontal line extending to the right.

RHYS MITCHELL

For and on Behalf of

MORRISON GEOTECHNIC PTY LIMITED

Encl: Marked Up Site Pan

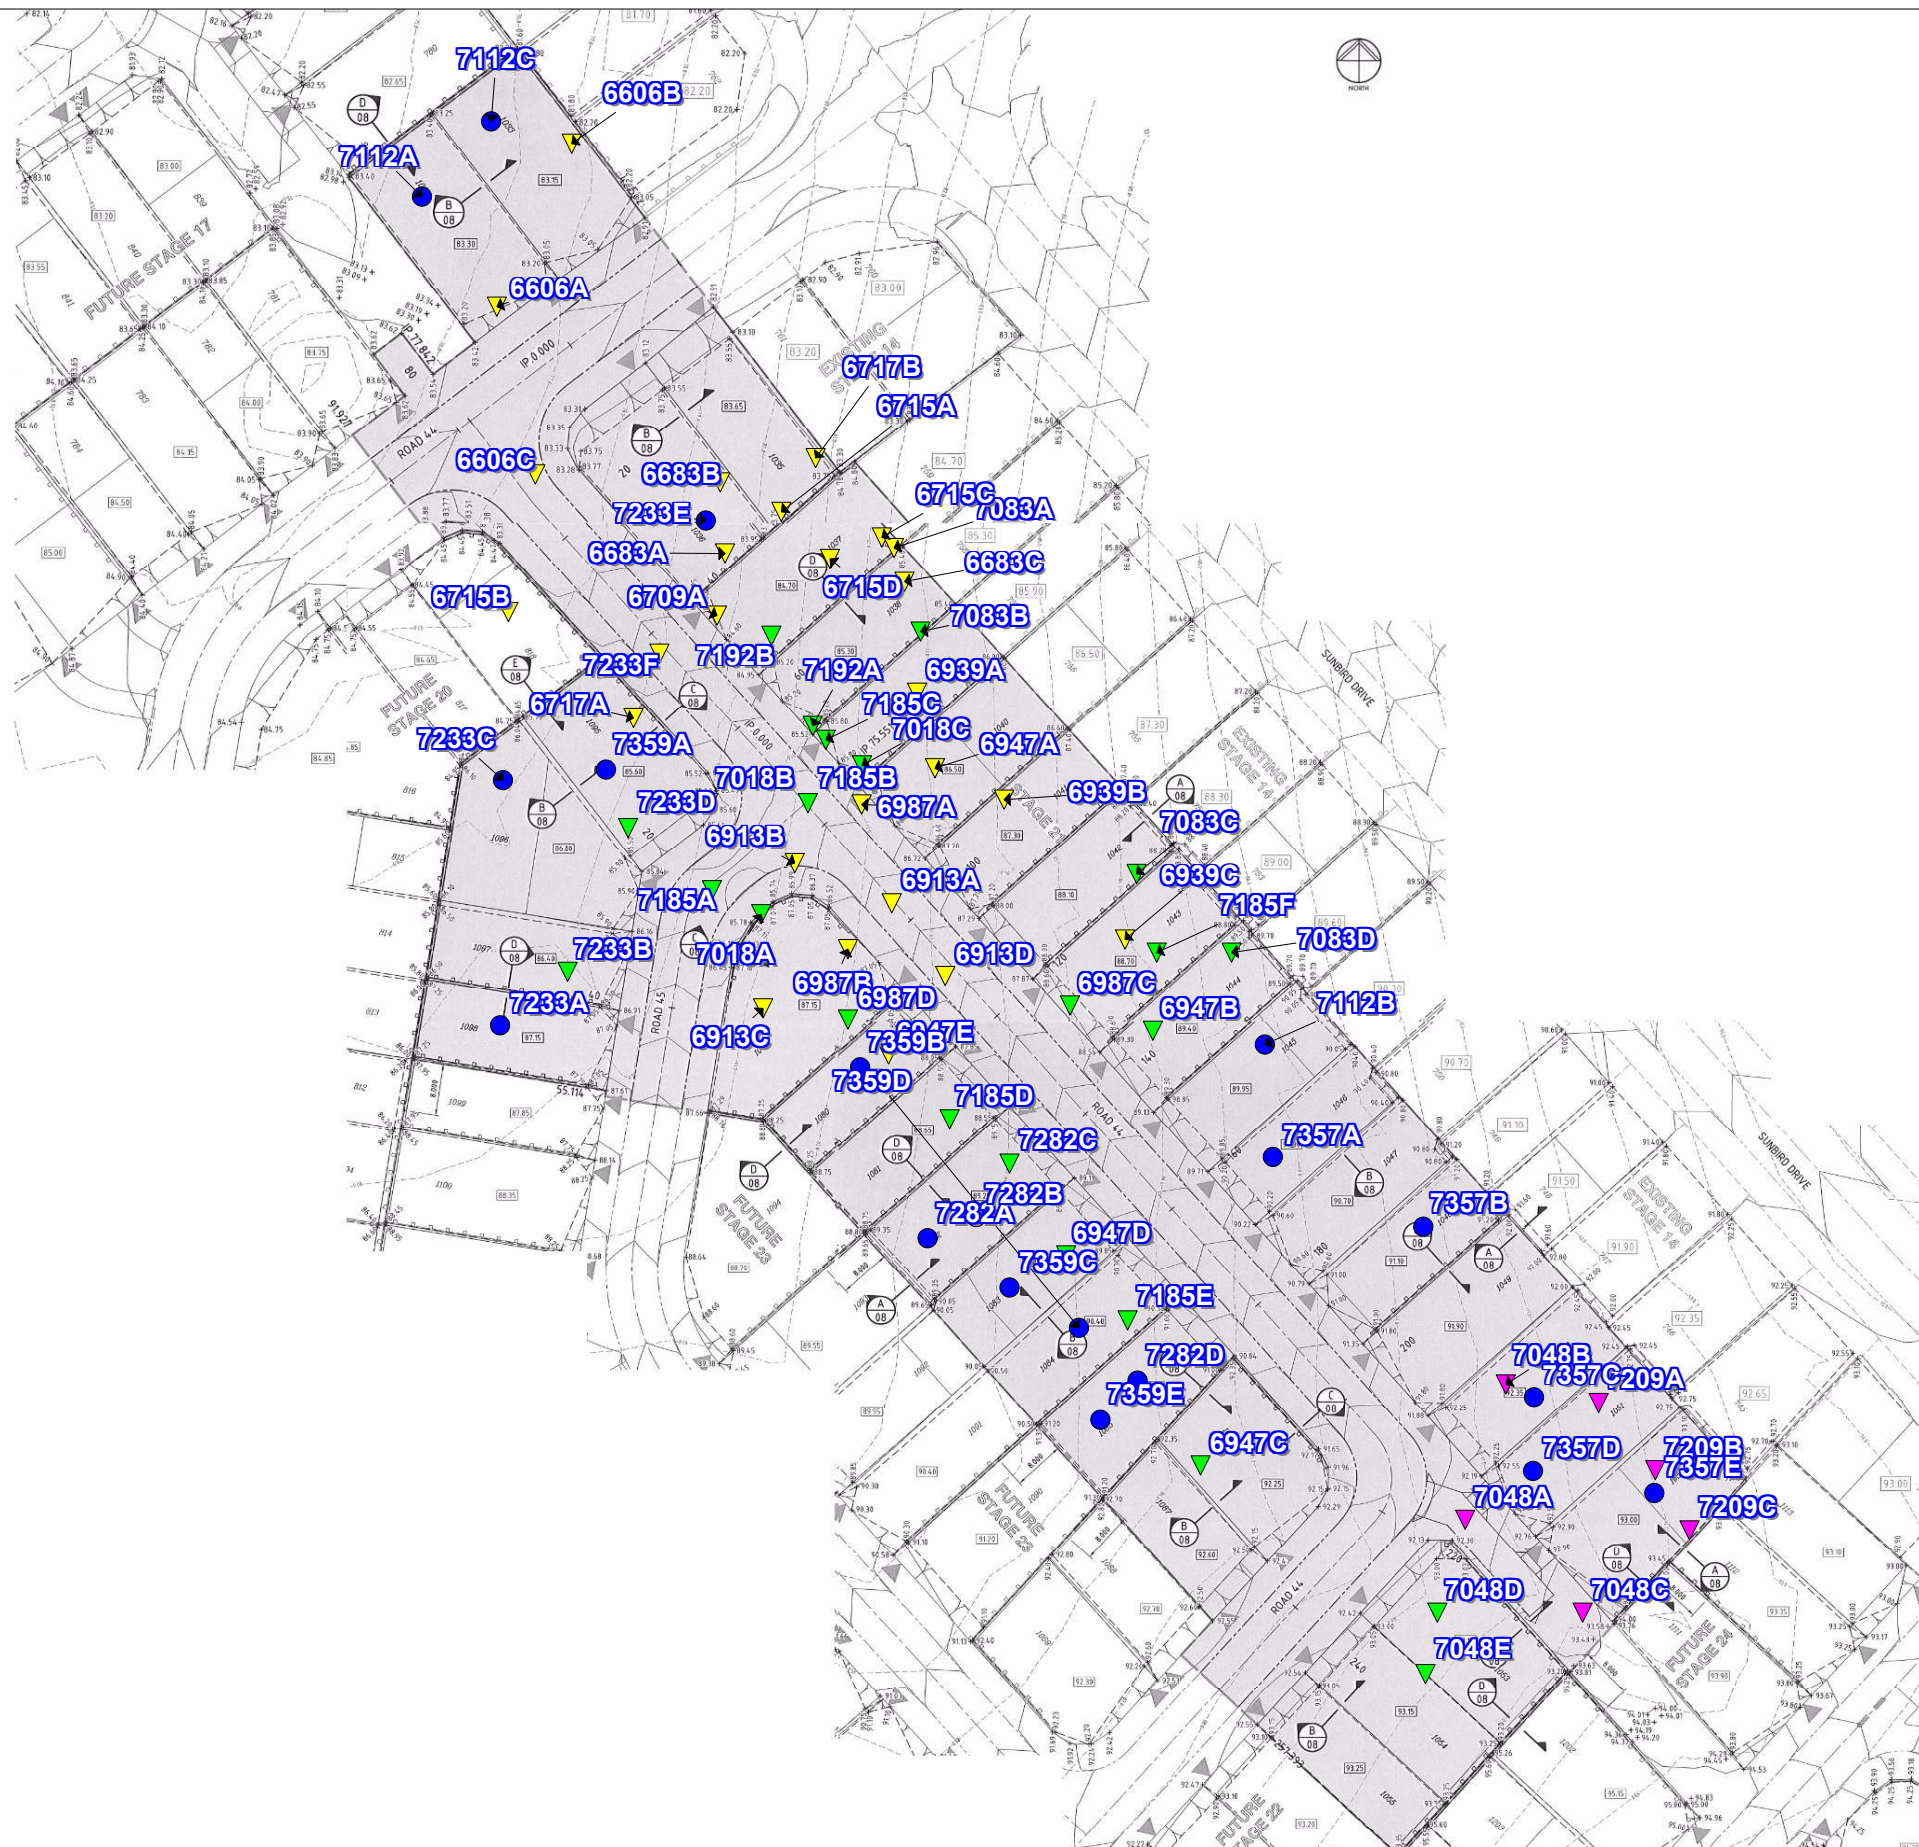

MORRISON GEOTECHNIC PTY LTD

ABN: 51 009 878 899

Unit 1/ 35 Limestone St, Darra 4076 Ph: 3279 0900
 Email: brisbanelab@morrisongeo.com.au

Engineers: M. Ballard
 D. Dragun
 Geologists: R. Howchin
 Laboratory: M. Morrison

LEGEND

- ▲ R.L 80.0 - 84.99
- ▲ R.L 85.0 - 89.99
- ▲ R.L 90.0 - 94.99
- Final Level

Map Description :	EARTHWORKS FIELD DENSITY TESTING - Level 1 Inspection		
Client :	SHADFORTHS PTY LTD		
Project :	EDENS CROSSING - STAGE 21		
Project No :	DL20/027	Drawing No :	DL20/027 - 01
		Scale :	Not to Scale



MORRISON GEOTECHNIC PTY LTD

ABN: 51 009 878 899

Unit 1/ 35 Limestone St, Darra 4076 Ph: 3279 0900
 Email: brisbanelab@morrisongeo.com.au Fax: 3279 0955

Engineers: D.Riley, J. Daly
 D.Dragun, & S.Wynne
 Geologists: L.Bexley & R.Howchin
 Laboratory: M.Morrison

LEGEND

- ▼ R.L 77.0 - 78.99
- ▼ R.L 79.0 - 80.99
- ▼ R.L 81.0 - 82.99
- ▼ R.L 83.0 - 84.99
- Final Level

Map Description :	EARTHWORKS FIELD DENSITY TESTING - Level 1 Inspection		
Client :	CCA WINSLOW		
Project :	EDENS CROSSING, FUTURE STAGES 15-20		
Project No :	DL17/398	Drawing No :	DL17/398 - 01
		Scale :	Not to Scale

Brisbane Office
Job Number: DL20/027
Ref No: 16167
Author: R. Mitchell

22nd April 2020

Shadforths Civil Pty Ltd
99 Sandalwood Lane
Forest Glen 4556

ATTENTION: MR MICHAEL PRITCHARD
Email: Michael.Pritchard@shadcivil.com.au

Dear Sir,

**RE: LOT 1054
LEVEL ONE COMPLIANCE REPORT FOR
EARTHWORKS FILL CONSTRUCTION
EDENS CROSSING STAGE 21**

Earthworks filling operations were carried out on Lot 1054 at the above Development to form a working platform to support a future residential building.

Earthworks were constructed by CCA Winslow (The Client) between May 2017 and March 2018 and Shadforths Civil (The Client) between January 2020 and March 2020.

This report should be read in conjunction with Morrison Geotechnic Report "16058 – DL20/027 Shadforths – Level One Compliance Report – Eden's Crossing Stage 21" Dated 21st April 2020. The Brief from the Client for was limited to:

- Level One Inspection of the placement and compaction of fill materials in accordance with AS3798 2007 – "Guidelines on Earthworks for Commercial and Residential Developments"
- Relative Density Control Testing in accordance with AS1289 – Testing of Soils for Engineering Purposes and at frequencies required in AS3798 Table 8.
- Ipswich City Council Specifications.
- Notes on KN Group Pty Ltd Civil Drawings.

Level One Inspections and Testing was carried out on the stripped ground surfaces and during the placement and compaction of fill materials. Field and laboratory testing included proof roll testing of the stripped surface and compaction testing.

Compaction testing at the Eden's Crossing Stage 21 Development was carried out at a frequency of 1 test per 500m³ of placed and compacted fill as defined in AS3798 Table 8.1. Test locations were selected using Random Stratified methods. Compaction testing was carried out at frequencies representative of the fill volume as a mass. On this basis, compaction testing was not required on each individual Lot.

A marked-up site plan shown the location of compaction testing is attached.

Fill constructed on Lot 1054 has been observed to be placed and compacted in accordance with the Brief. The fill on Lot 1054 can be termed as "Controlled Fill" in accordance with AS 2870-2011 "Residential Slabs and Footings".

This statement does not include any topsoil, which may have been placed for use as Lot dressing or any other subsequent earthworks after March 2020.

If there are any queries concerning the above please do not hesitate to contact this office, or alternatively send to my email at mickmorrison@morrisongeo.com.au.

Yours faithfully,


A handwritten signature in grey ink, appearing to read 'Rhys Mitchell', with a horizontal line extending to the right.

RHYS MITCHELL

For and on Behalf of

MORRISON GEOTECHNIC PTY LIMITED

Encl: Marked Up Site Pan

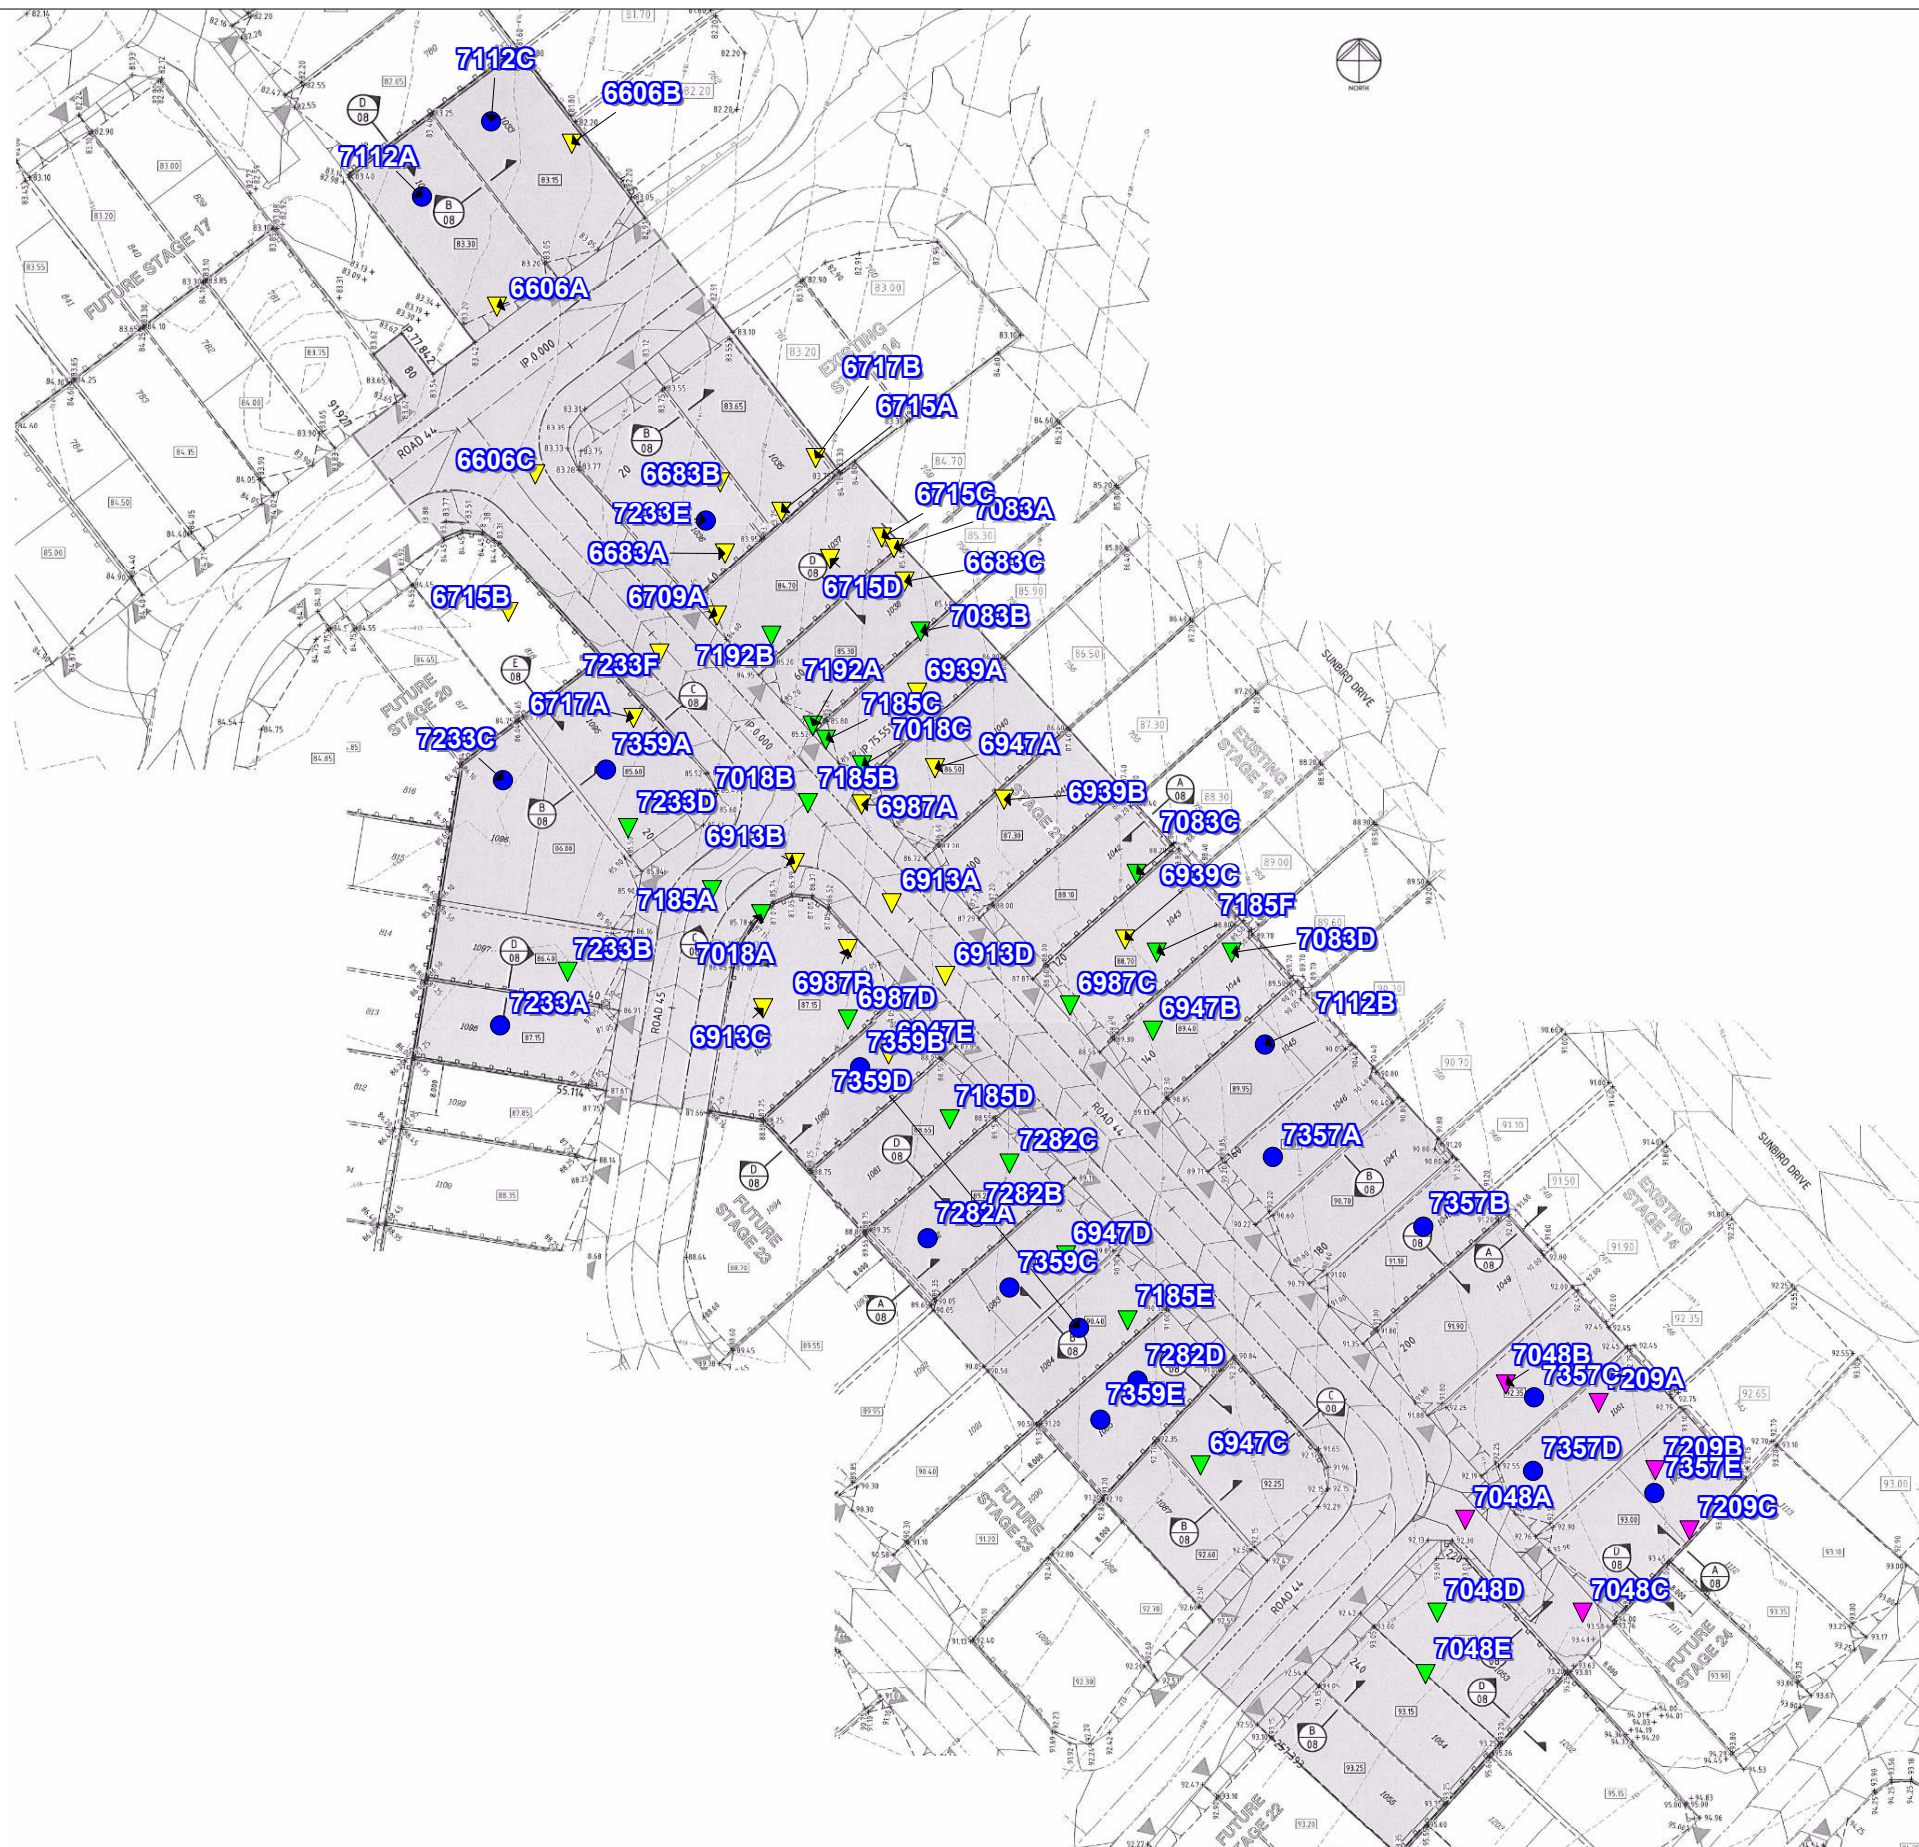

MORRISON GEOTECHNIC PTY LTD

ABN: 51 009 878 899

Unit 1/ 35 Limestone St, Darra 4076 Ph: 3279 0900
 Email: brisbanelab@morrisongeo.com.au

Engineers: M. Ballard
 D. Dragun
 Geologists: R. Howchin
 Laboratory: M. Morrison

LEGEND

- ▼ R.L 80.0 - 84.99
- ▼ R.L 85.0 - 89.99
- ▼ R.L 90.0 - 94.99
- Final Level

Map Description :	EARTHWORKS FIELD DENSITY TESTING - Level 1 Inspection		
Client :	SHADFORTHS PTY LTD		
Project :	EDENS CROSSING - STAGE 21		
Project No :	DL20/027	Drawing No :	DL20/027 - 01
		Scale :	Not to Scale



MORRISON GEOTECHNIC PTY LTD

ABN: 51 009 878 899

Unit 1/ 35 Limestone St, Darra 4076 Ph: 3279 0900
 Email: brisbanelab@morrisongeo.com.au Fax: 3279 0955

Engineers: D.Riley, J. Daly
 D.Dragun, & S.Wynne
 Geologists: L.Bexley & R.Howchin
 Laboratory: M.Morrison

LEGEND

- ▼ R.L 77.0 - 78.99
- ▼ R.L 79.0 - 80.99
- ▼ R.L 81.0 - 82.99
- ▼ R.L 83.0 - 84.99
- ▼ R.L 85.0 - 86.99
- Final Level

Map Description :	EARTHWORKS FIELD DENSITY TESTING - Level 1 Inspection		
Client :	CCA WINSLOW		
Project :	EDENS CROSSING, FUTURE STAGES 15-20		
Project No :	DL17/398	Drawing No :	DL17/398 - 01
		Scale :	Not to Scale

Brisbane Office
Job Number: DL20/027
Ref No: 16168
Author: R. Mitchell

22nd April 2020

Shadforths Civil Pty Ltd
99 Sandalwood Lane
Forest Glen 4556

ATTENTION: MR MICHAEL PRITCHARD
Email: Michael.Pritchard@shadcivil.com.au

Dear Sir,

**RE: LOT 1055
LEVEL ONE COMPLIANCE REPORT FOR
EARTHWORKS FILL CONSTRUCTION
EDENS CROSSING STAGE 21**

Earthworks filling operations were carried out on Lot 1055 at the above Development to form a working platform to support a future residential building.

Earthworks were constructed by CCA Winslow (The Client) between May 2017 and March 2018 and Shadforths Civil (The Client) between January 2020 and March 2020.

This report should be read in conjunction with Morrison Geotechnic Report “16058 – DL20/027 Shadforths – Level One Compliance Report – Eden’s Crossing Stage 21” Dated 21st April 2020. The Brief from the Client for was limited to:

- Level One Inspection of the placement and compaction of fill materials in accordance with AS3798 2007 – “Guidelines on Earthworks for Commercial and Residential Developments”
- Relative Density Control Testing in accordance with AS1289 – Testing of Soils for Engineering Purposes and at frequencies required in AS3798 Table 8.
- Ipswich City Council Specifications.
- Notes on KN Group Pty Ltd Civil Drawings.

Level One Inspections and Testing was carried out on the stripped ground surfaces and during the placement and compaction of fill materials. Field and laboratory testing included proof roll testing of the stripped surface and compaction testing.

Compaction testing at the Eden’s Crossing Stage 21 Development was carried out at a frequency of 1 test per 500m³ of placed and compacted fill as defined in AS3798 Table 8.1. Test locations were selected using Random Stratified methods. Compaction testing was carried out at frequencies representative of the fill volume as a mass. On this basis, compaction testing was not required on each individual Lot.

A marked-up site plan shown the location of compaction testing is attached.

Fill constructed on Lot 1055 has been observed to be placed and compacted in accordance with the Brief. The fill on Lot 1055 can be termed as "Controlled Fill" in accordance with AS 2870-2011 "Residential Slabs and Footings".

This statement does not include any topsoil, which may have been placed for use as Lot dressing or any other subsequent earthworks after March 2020.

If there are any queries concerning the above please do not hesitate to contact this office, or alternatively send to my email at mickmorrison@morrisongeo.com.au.

Yours faithfully,


A handwritten signature in grey ink, appearing to read 'Rhys Mitchell', with a horizontal line extending to the right.

RHYS MITCHELL

For and on Behalf of

MORRISON GEOTECHNIC PTY LIMITED

Encl: Marked Up Site Pan

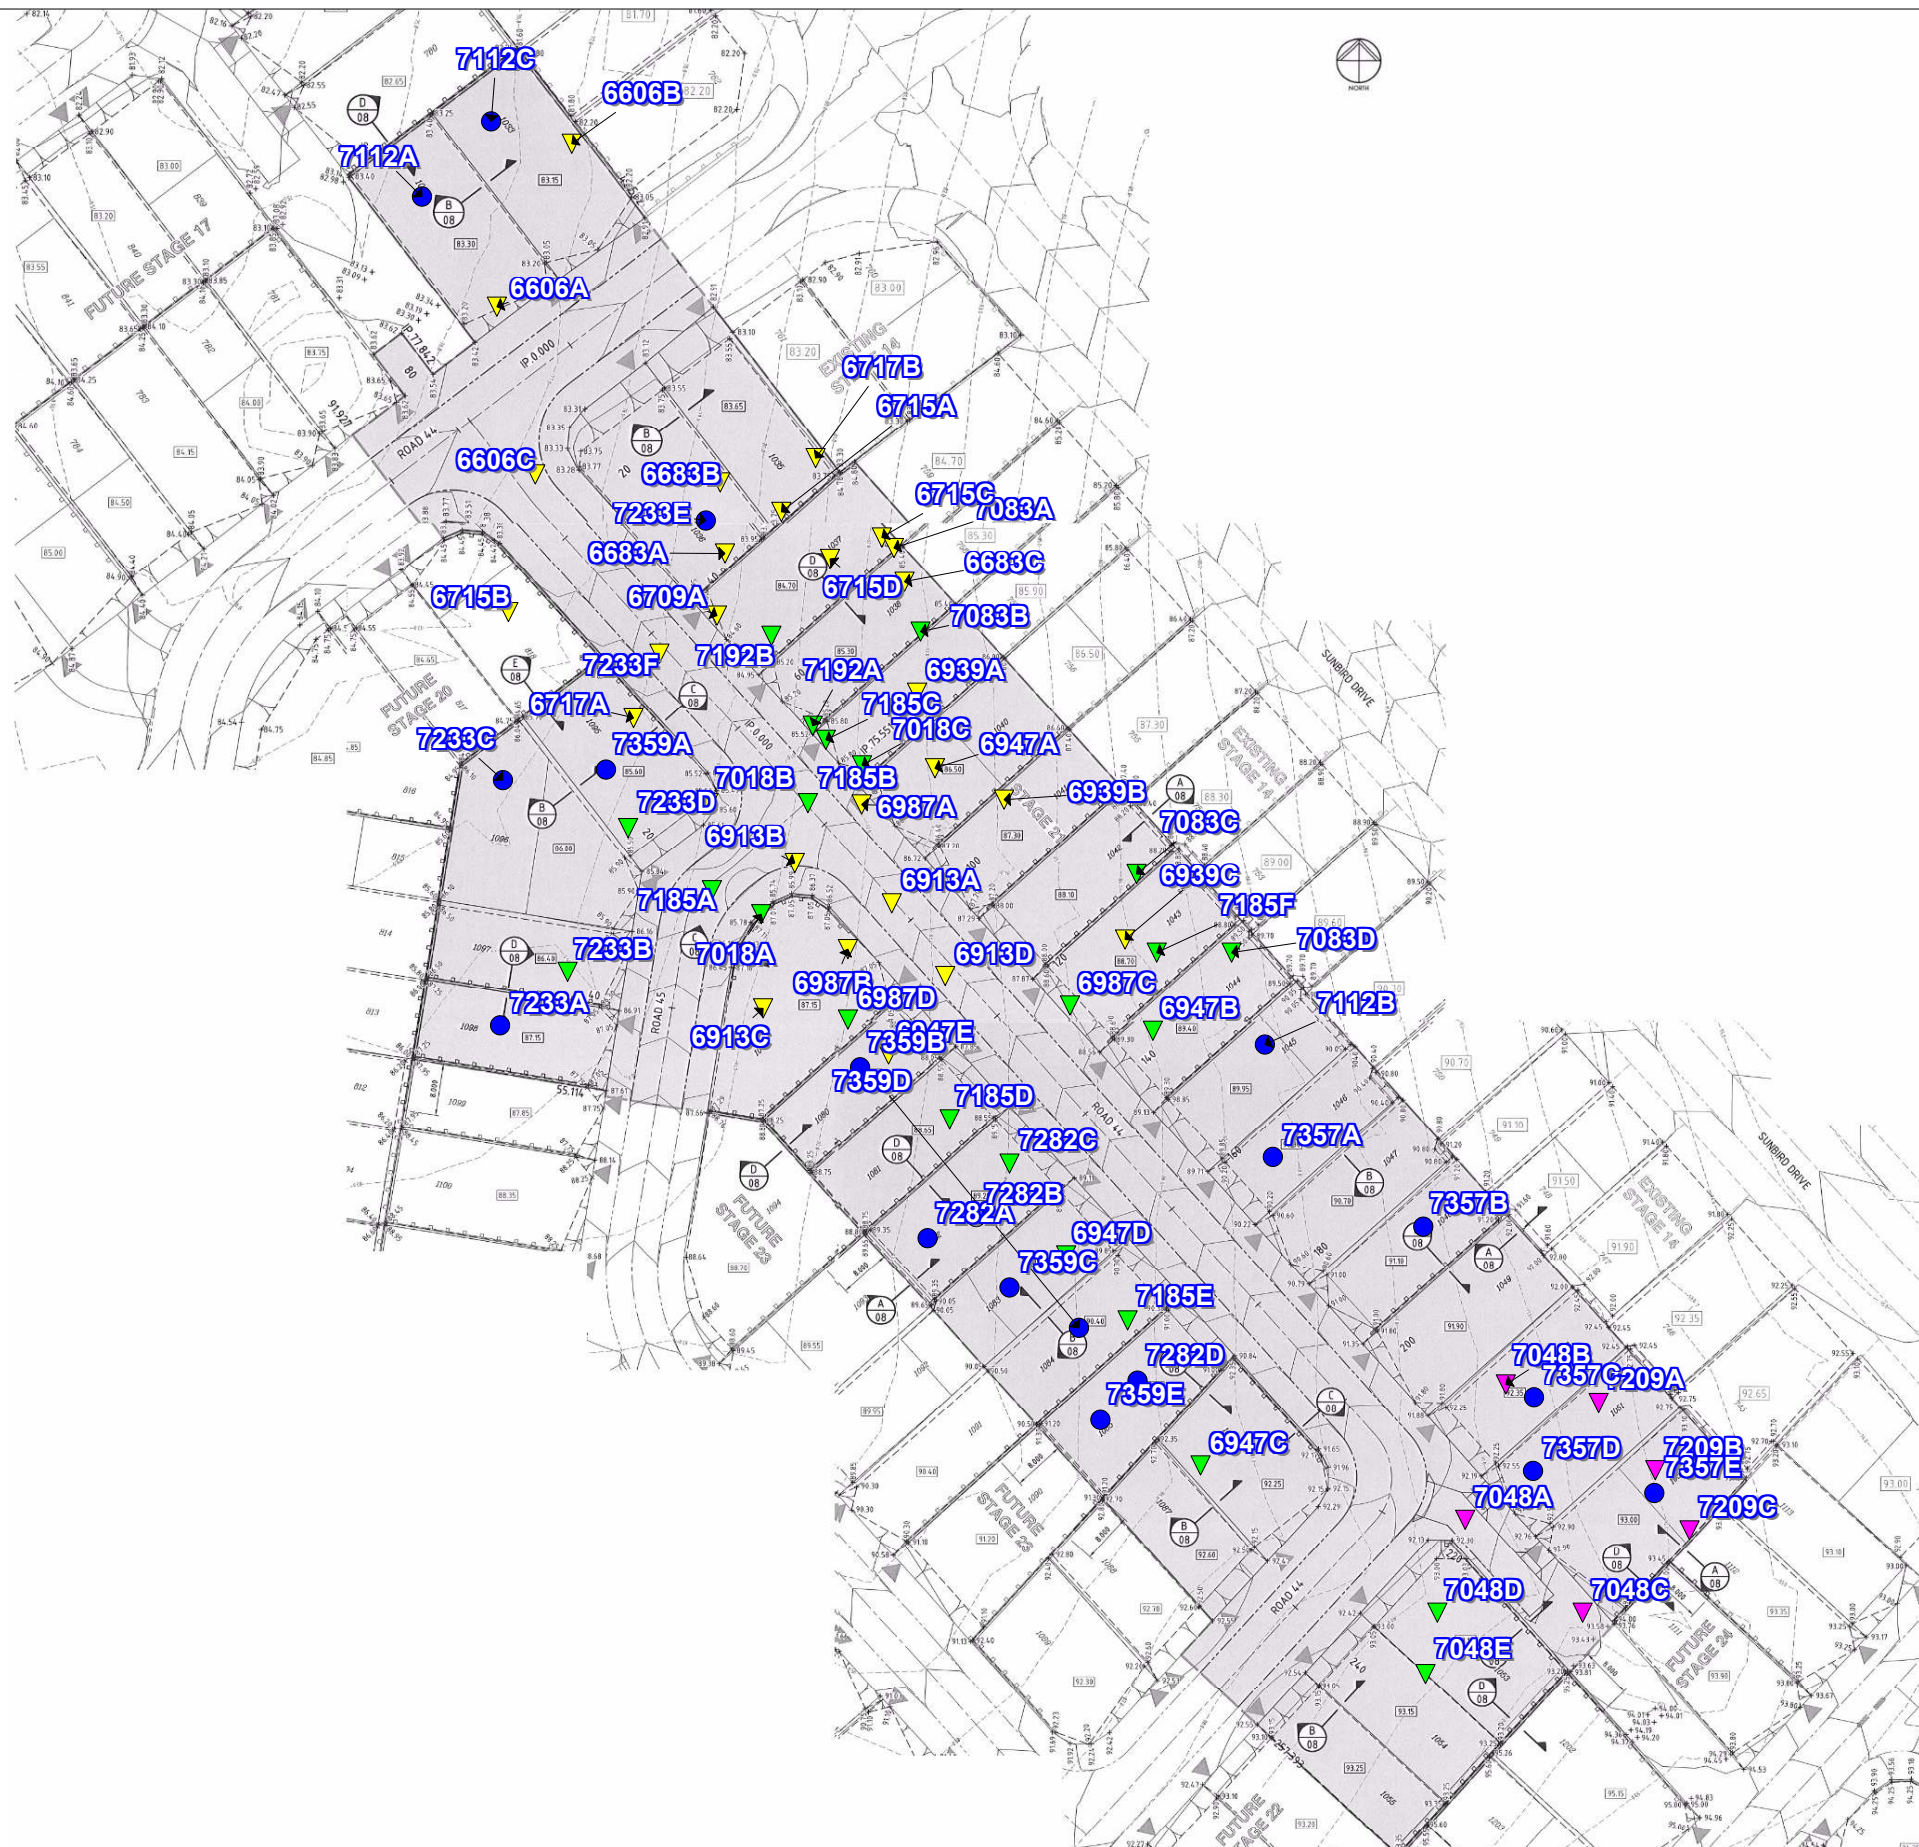

MORRISON GEOTECHNIC PTY LTD

ABN: 51 009 878 899

Unit 1/ 35 Limestone St, Darra 4076 Ph: 3279 0900
 Email: brisbanelab@morrisongeo.com.au

Engineers: M. Ballard
 D. Dragun
 Geologists: R. Howchin
 Laboratory: M. Morrison

LEGEND

- ▲ R.L 80.0 - 84.99
- ▲ R.L 85.0 - 89.99
- ▲ R.L 90.0 - 94.99
- Final Level

Map Description :	EARTHWORKS FIELD DENSITY TESTING - Level 1 Inspection		
Client :	SHADFORTHS PTY LTD		
Project :	EDENS CROSSING - STAGE 21		
Project No :	DL20/027	Drawing No :	DL20/027 - 01
Scale :	Not to Scale		



MORRISON GEOTECHNIC PTY LTD

ABN: 51 009 878 899

Unit 1/ 35 Limestone St, Darra 4076 Ph: 3279 0900
 Email: brisbanelab@morrisongeo.com.au Fax: 3279 0955

Engineers: D.Riley, J. Daly
 D.Dragun, & S.Wynne
 Geologists: L.Bexley & R.Howchin
 Laboratory: M.Morrison

LEGEND

- ▼ R.L 77.0 - 78.99
- ▼ R.L 79.0 - 80.99
- ▼ R.L 81.0 - 82.99
- ▼ R.L 83.0 - 84.99
- Final Level

Map Description :	EARTHWORKS FIELD DENSITY TESTING - Level 1 Inspection		
Client :	CCA WINSLOW		
Project :	EDENS CROSSING, FUTURE STAGES 15-20		
Project No :	DL17/398	Drawing No :	DL17/398 - 01
		Scale :	Not to Scale

Brisbane Office
Job Number: DL20/027
Ref No: 16169
Author: R. Mitchell

22nd April 2020

Shadforths Civil Pty Ltd
99 Sandalwood Lane
Forest Glen 4556

ATTENTION: MR MICHAEL PRITCHARD
Email: Michael.Pritchard@shadcivil.com.au

Dear Sir,

**RE: LOT 1079
LEVEL ONE COMPLIANCE REPORT FOR
EARTHWORKS FILL CONSTRUCTION
EDENS CROSSING STAGE 21**

Earthworks filling operations were carried out on Lot 1079 at the above Development to form a working platform to support a future residential building.

Earthworks were constructed by CCA Winslow (The Client) between May 2017 and March 2018 and Shadforths Civil (The Client) between January 2020 and March 2020.

This report should be read in conjunction with Morrison Geotechnic Report “16058 – DL20/027 Shadforths – Level One Compliance Report – Eden’s Crossing Stage 21” Dated 21st April 2020. The Brief from the Client for was limited to:

- Level One Inspection of the placement and compaction of fill materials in accordance with AS3798 2007 – “Guidelines on Earthworks for Commercial and Residential Developments”
- Relative Density Control Testing in accordance with AS1289 – Testing of Soils for Engineering Purposes and at frequencies required in AS3798 Table 8.
- Ipswich City Council Specifications.
- Notes on KN Group Pty Ltd Civil Drawings.

Level One Inspections and Testing was carried out on the stripped ground surfaces and during the placement and compaction of fill materials. Field and laboratory testing included proof roll testing of the stripped surface and compaction testing.

Compaction testing at the Eden’s Crossing Stage 21 Development was carried out at a frequency of 1 test per 500m³ of placed and compacted fill as defined in AS3798 Table 8.1. Test locations were selected using Random Stratified methods. Compaction testing was carried out at frequencies representative of the fill volume as a mass. On this basis, compaction testing was not required on each individual Lot.

A marked-up site plan shown the location of compaction testing is attached.

Fill constructed on Lot 1079 has been observed to be placed and compacted in accordance with the Brief. The fill on Lot 1079 can be termed as "Controlled Fill" in accordance with AS 2870-2011 "Residential Slabs and Footings".

This statement does not include any topsoil, which may have been placed for use as Lot dressing or any other subsequent earthworks after March 2020.

If there are any queries concerning the above please do not hesitate to contact this office, or alternatively send to my email at mickmorrison@morrisongeo.com.au.

Yours faithfully,


A handwritten signature in grey ink, appearing to read 'Rhys Mitchell', with a horizontal line extending to the right.

RHYS MITCHELL

For and on Behalf of

MORRISON GEOTECHNIC PTY LIMITED

Encl: Marked Up Site Pan

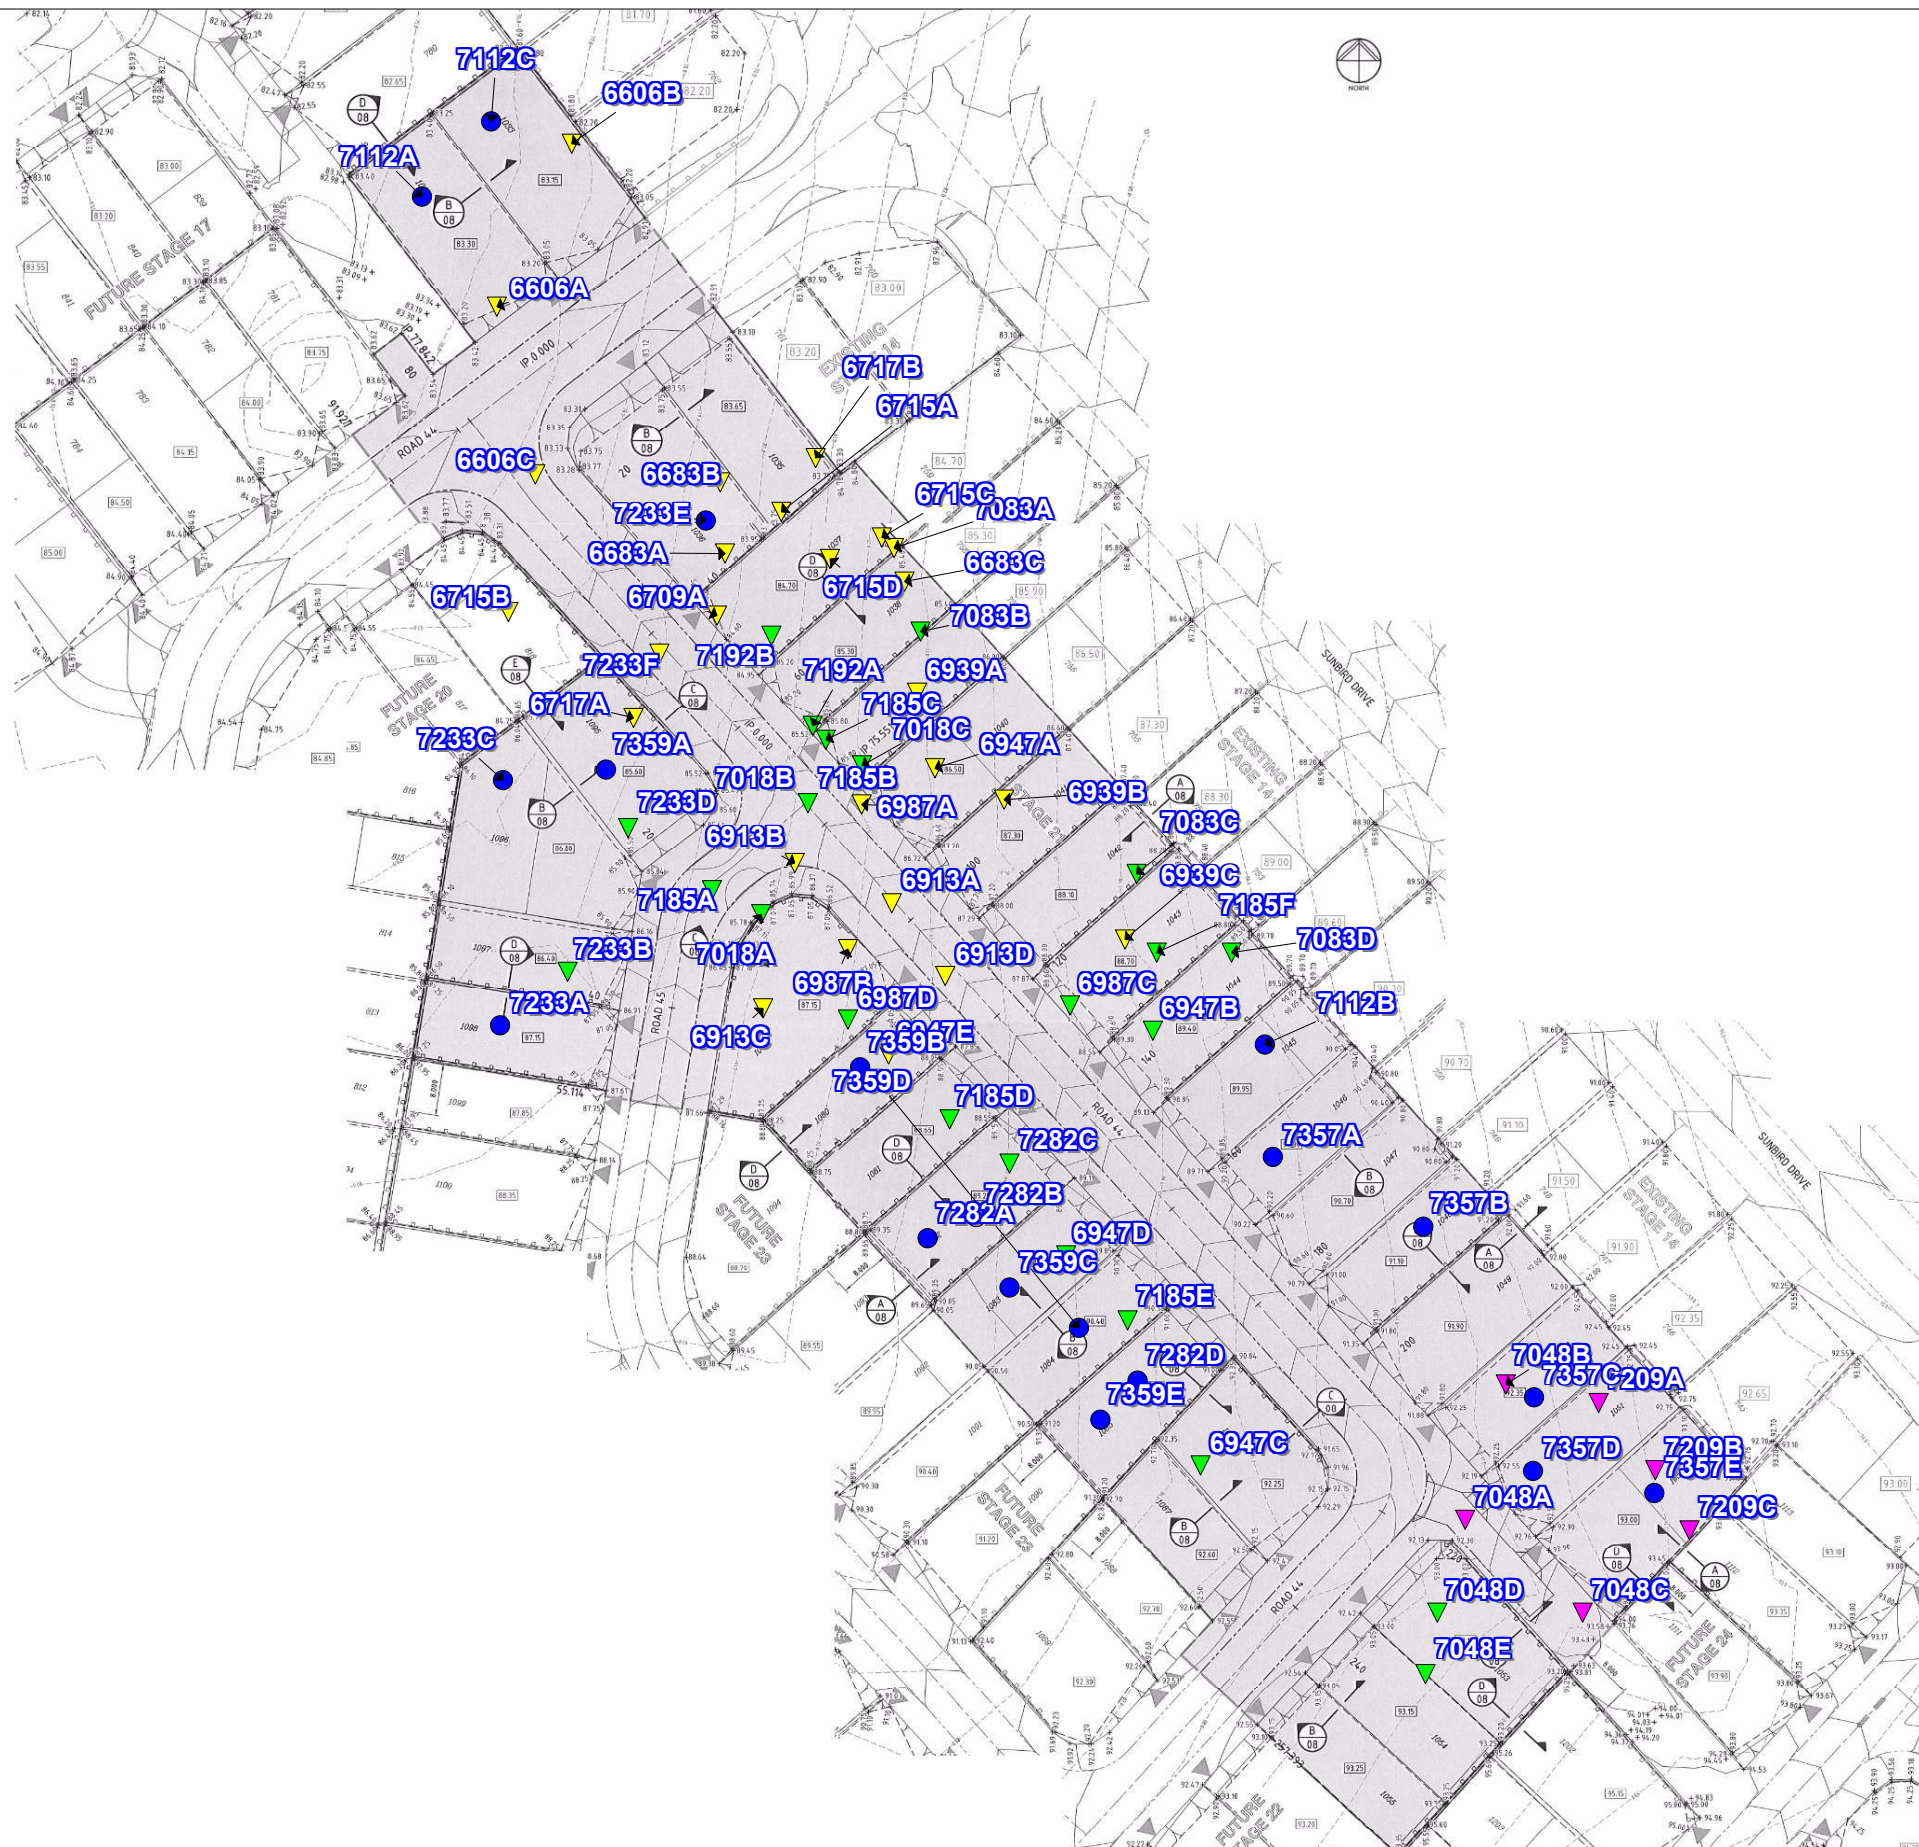

MORRISON GEOTECHNIC PTY LTD

ABN: 51 009 878 899

Unit 1/ 35 Limestone St, Darra 4076 Ph: 3279 0900
 Email: brisbanelab@morrisongeo.com.au

Engineers: M. Ballard
 D. Dragun
 Geologists: R. Howchin
 Laboratory: M. Morrison

LEGEND

- ▲ R.L 80.0 - 84.99
- ▲ R.L 85.0 - 89.99
- ▲ R.L 90.0 - 94.99
- Final Level

Map Description :	EARTHWORKS FIELD DENSITY TESTING - Level 1 Inspection		
Client :	SHADFORTHS PTY LTD		
Project :	EDENS CROSSING - STAGE 21		
Project No :	DL20/027	Drawing No :	DL20/027 - 01
		Scale :	Not to Scale



MORRISON GEOTECHNIC PTY LTD

ABN: 51 009 878 899

Unit 1/ 35 Limestone St, Darra 4076 Ph: 3279 0900
 Email: brisbanelab@morrisongeo.com.au Fax: 3279 0955

Engineers: D.Riley, J. Daly
 D.Dragun, & S.Wynne
 Geologists: L.Bexley & R.Howchin
 Laboratory: M.Morrison

LEGEND

- ▼ R.L 77.0 - 78.99
- ▼ R.L 79.0 - 80.99
- ▼ R.L 81.0 - 82.99
- ▼ R.L 83.0 - 84.99
- ▼ R.L 85.0 - 86.99
- Final Level

Map Description :	EARTHWORKS FIELD DENSITY TESTING - Level 1 Inspection		
Client :	CCA WINSLOW		
Project :	EDENS CROSSING, FUTURE STAGES 15-20		
Project No :	DL17/398	Drawing No :	DL17/398 - 01
		Scale :	Not to Scale

Brisbane Office
Job Number: DL20/027
Ref No: 16170
Author: R. Mitchell

22nd April 2020

Shadforths Civil Pty Ltd
99 Sandalwood Lane
Forest Glen 4556

ATTENTION: MR MICHAEL PRITCHARD
Email: Michael.Pritchard@shadcivil.com.au

Dear Sir,

**RE: LOT 1080
LEVEL ONE COMPLIANCE REPORT FOR
EARTHWORKS FILL CONSTRUCTION
EDENS CROSSING STAGE 21**

Earthworks filling operations were carried out on Lot 1080 at the above Development to form a working platform to support a future residential building.

Earthworks were constructed by CCA Winslow (The Client) between May 2017 and March 2018 and Shadforths Civil (The Client) between January 2020 and March 2020.

This report should be read in conjunction with Morrison Geotechnic Report “16058 – DL20/027 Shadforths – Level One Compliance Report – Eden’s Crossing Stage 21” Dated 21st April 2020. The Brief from the Client for was limited to:

- Level One Inspection of the placement and compaction of fill materials in accordance with AS3798 2007 – “Guidelines on Earthworks for Commercial and Residential Developments”
- Relative Density Control Testing in accordance with AS1289 – Testing of Soils for Engineering Purposes and at frequencies required in AS3798 Table 8.
- Ipswich City Council Specifications.
- Notes on KN Group Pty Ltd Civil Drawings.

Level One Inspections and Testing was carried out on the stripped ground surfaces and during the placement and compaction of fill materials. Field and laboratory testing included proof roll testing of the stripped surface and compaction testing.

Compaction testing at the Eden’s Crossing Stage 21 Development was carried out at a frequency of 1 test per 500m³ of placed and compacted fill as defined in AS3798 Table 8.1. Test locations were selected using Random Stratified methods. Compaction testing was carried out at frequencies representative of the fill volume as a mass. On this basis, compaction testing was not required on each individual Lot.

A marked-up site plan shown the location of compaction testing is attached.

Fill constructed on Lot 1080 has been observed to be placed and compacted in accordance with the Brief. The fill on Lot 1080 can be termed as "Controlled Fill" in accordance with AS 2870-2011 "Residential Slabs and Footings".

This statement does not include any topsoil, which may have been placed for use as Lot dressing or any other subsequent earthworks after March 2020.

If there are any queries concerning the above please do not hesitate to contact this office, or alternatively send to my email at mickmorrison@morrisongeo.com.au.

Yours faithfully,


A handwritten signature in grey ink, appearing to read 'Rhys Mitchell', with a horizontal line extending to the right.

RHYS MITCHELL

For and on Behalf of

MORRISON GEOTECHNIC PTY LIMITED

Encl: Marked Up Site Pan

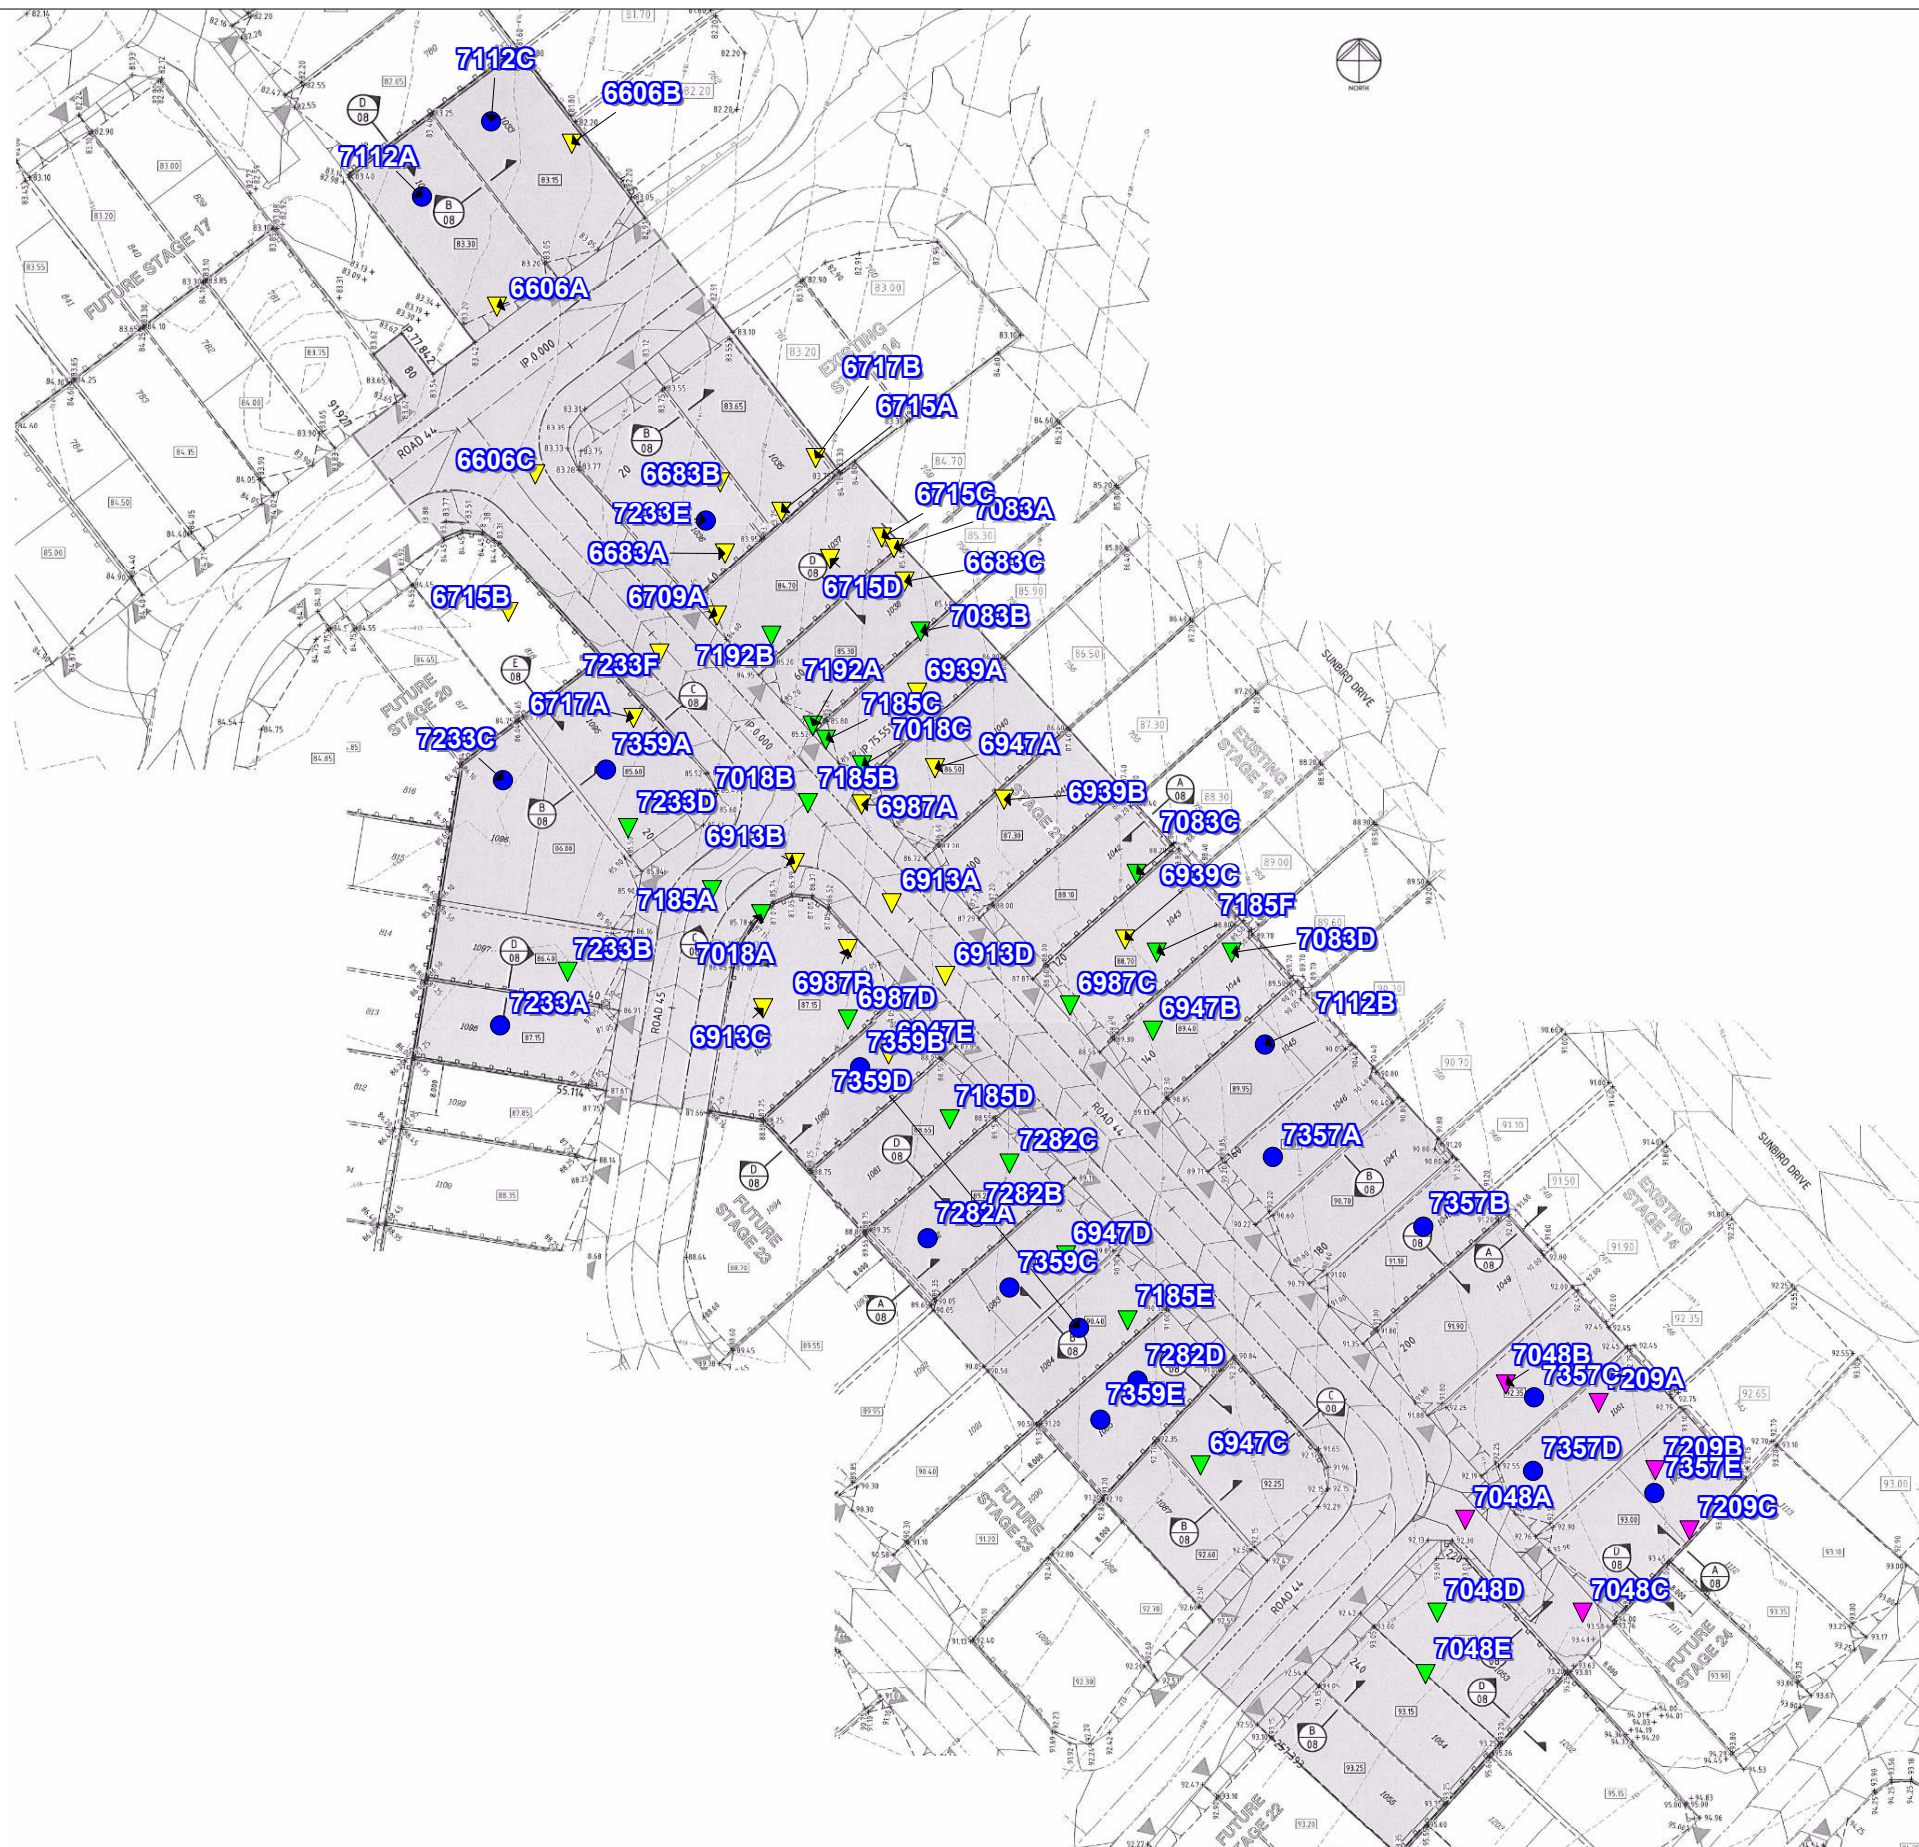

MORRISON GEOTECHNIC PTY LTD

ABN: 51 009 878 899

Unit 1/ 35 Limestone St, Darra 4076 Ph: 3279 0900
 Email: brisbanelab@morrisongeo.com.au

Engineers: M. Ballard
 D. Dragun
 Geologists: R. Howchin
 Laboratory: M. Morrison

LEGEND

- ▼ R.L 80.0 - 84.99
- ▼ R.L 85.0 - 89.99
- ▼ R.L 90.0 - 94.99
- Final Level

Map Description :	EARTHWORKS FIELD DENSITY TESTING - Level 1 Inspection		
Client :	SHADFORTHS PTY LTD		
Project :	EDENS CROSSING - STAGE 21		
Project No :	DL20/027	Drawing No :	DL20/027 - 01
		Scale :	Not to Scale



MORRISON GEOTECHNIC PTY LTD

ABN: 51 009 878 899

Unit 1/ 35 Limestone St, Darra 4076 Ph: 3279 0900
 Email: brisbanelab@morrisongeo.com.au Fax: 3279 0955

Engineers: D.Riley, J. Daly
 D.Dragun, & S.Wynne
 Geologists: L.Bexley & R.Howchin
 Laboratory: M.Morrison

LEGEND

- ▼ R.L 77.0 - 78.99
- ▼ R.L 79.0 - 80.99
- ▼ R.L 81.0 - 82.99
- ▼ R.L 83.0 - 84.99
- Final Level

Map Description :	EARTHWORKS FIELD DENSITY TESTING - Level 1 Inspection		
Client :	CCA WINSLOW		
Project :	EDENS CROSSING, FUTURE STAGES 15-20		
Project No :	DL17/398	Drawing No :	DL17/398 - 01
		Scale :	Not to Scale

Brisbane Office
Job Number: DL20/027
Ref No: 16171
Author: R. Mitchell

22nd April 2020

Shadforths Civil Pty Ltd
99 Sandalwood Lane
Forest Glen 4556

ATTENTION: MR MICHAEL PRITCHARD
Email: Michael.Pritchard@shadcivil.com.au

Dear Sir,

**RE: LOT 1081
LEVEL ONE COMPLIANCE REPORT FOR
EARTHWORKS FILL CONSTRUCTION
EDENS CROSSING STAGE 21**

Earthworks filling operations were carried out on Lot 1081 at the above Development to form a working platform to support a future residential building.

Earthworks were constructed by CCA Winslow (The Client) between May 2017 and March 2018 and Shadforths Civil (The Client) between January 2020 and March 2020.

This report should be read in conjunction with Morrison Geotechnic Report "16058 – DL20/027 Shadforths – Level One Compliance Report – Eden's Crossing Stage 21" Dated 21st April 2020. The Brief from the Client for was limited to:

- Level One Inspection of the placement and compaction of fill materials in accordance with AS3798 2007 – "Guidelines on Earthworks for Commercial and Residential Developments"
- Relative Density Control Testing in accordance with AS1289 – Testing of Soils for Engineering Purposes and at frequencies required in AS3798 Table 8.
- Ipswich City Council Specifications.
- Notes on KN Group Pty Ltd Civil Drawings.

Level One Inspections and Testing was carried out on the stripped ground surfaces and during the placement and compaction of fill materials. Field and laboratory testing included proof roll testing of the stripped surface and compaction testing.

Compaction testing at the Eden's Crossing Stage 21 Development was carried out at a frequency of 1 test per 500m³ of placed and compacted fill as defined in AS3798 Table 8.1. Test locations were selected using Random Stratified methods. Compaction testing was carried out at frequencies representative of the fill volume as a mass. On this basis, compaction testing was not required on each individual Lot.

A marked-up site plan shown the location of compaction testing is attached.

Fill constructed on Lot 1081 has been observed to be placed and compacted in accordance with the Brief. The fill on Lot 1081 can be termed as "Controlled Fill" in accordance with AS 2870-2011 "Residential Slabs and Footings".

This statement does not include any topsoil, which may have been placed for use as Lot dressing or any other subsequent earthworks after March 2020.

If there are any queries concerning the above please do not hesitate to contact this office, or alternatively send to my email at mickmorrison@morrisongeo.com.au.

Yours faithfully,


A handwritten signature in grey ink, appearing to read 'Rhys Mitchell', with a horizontal line extending to the right.

RHYS MITCHELL

For and on Behalf of

MORRISON GEOTECHNIC PTY LIMITED

Encl: Marked Up Site Pan

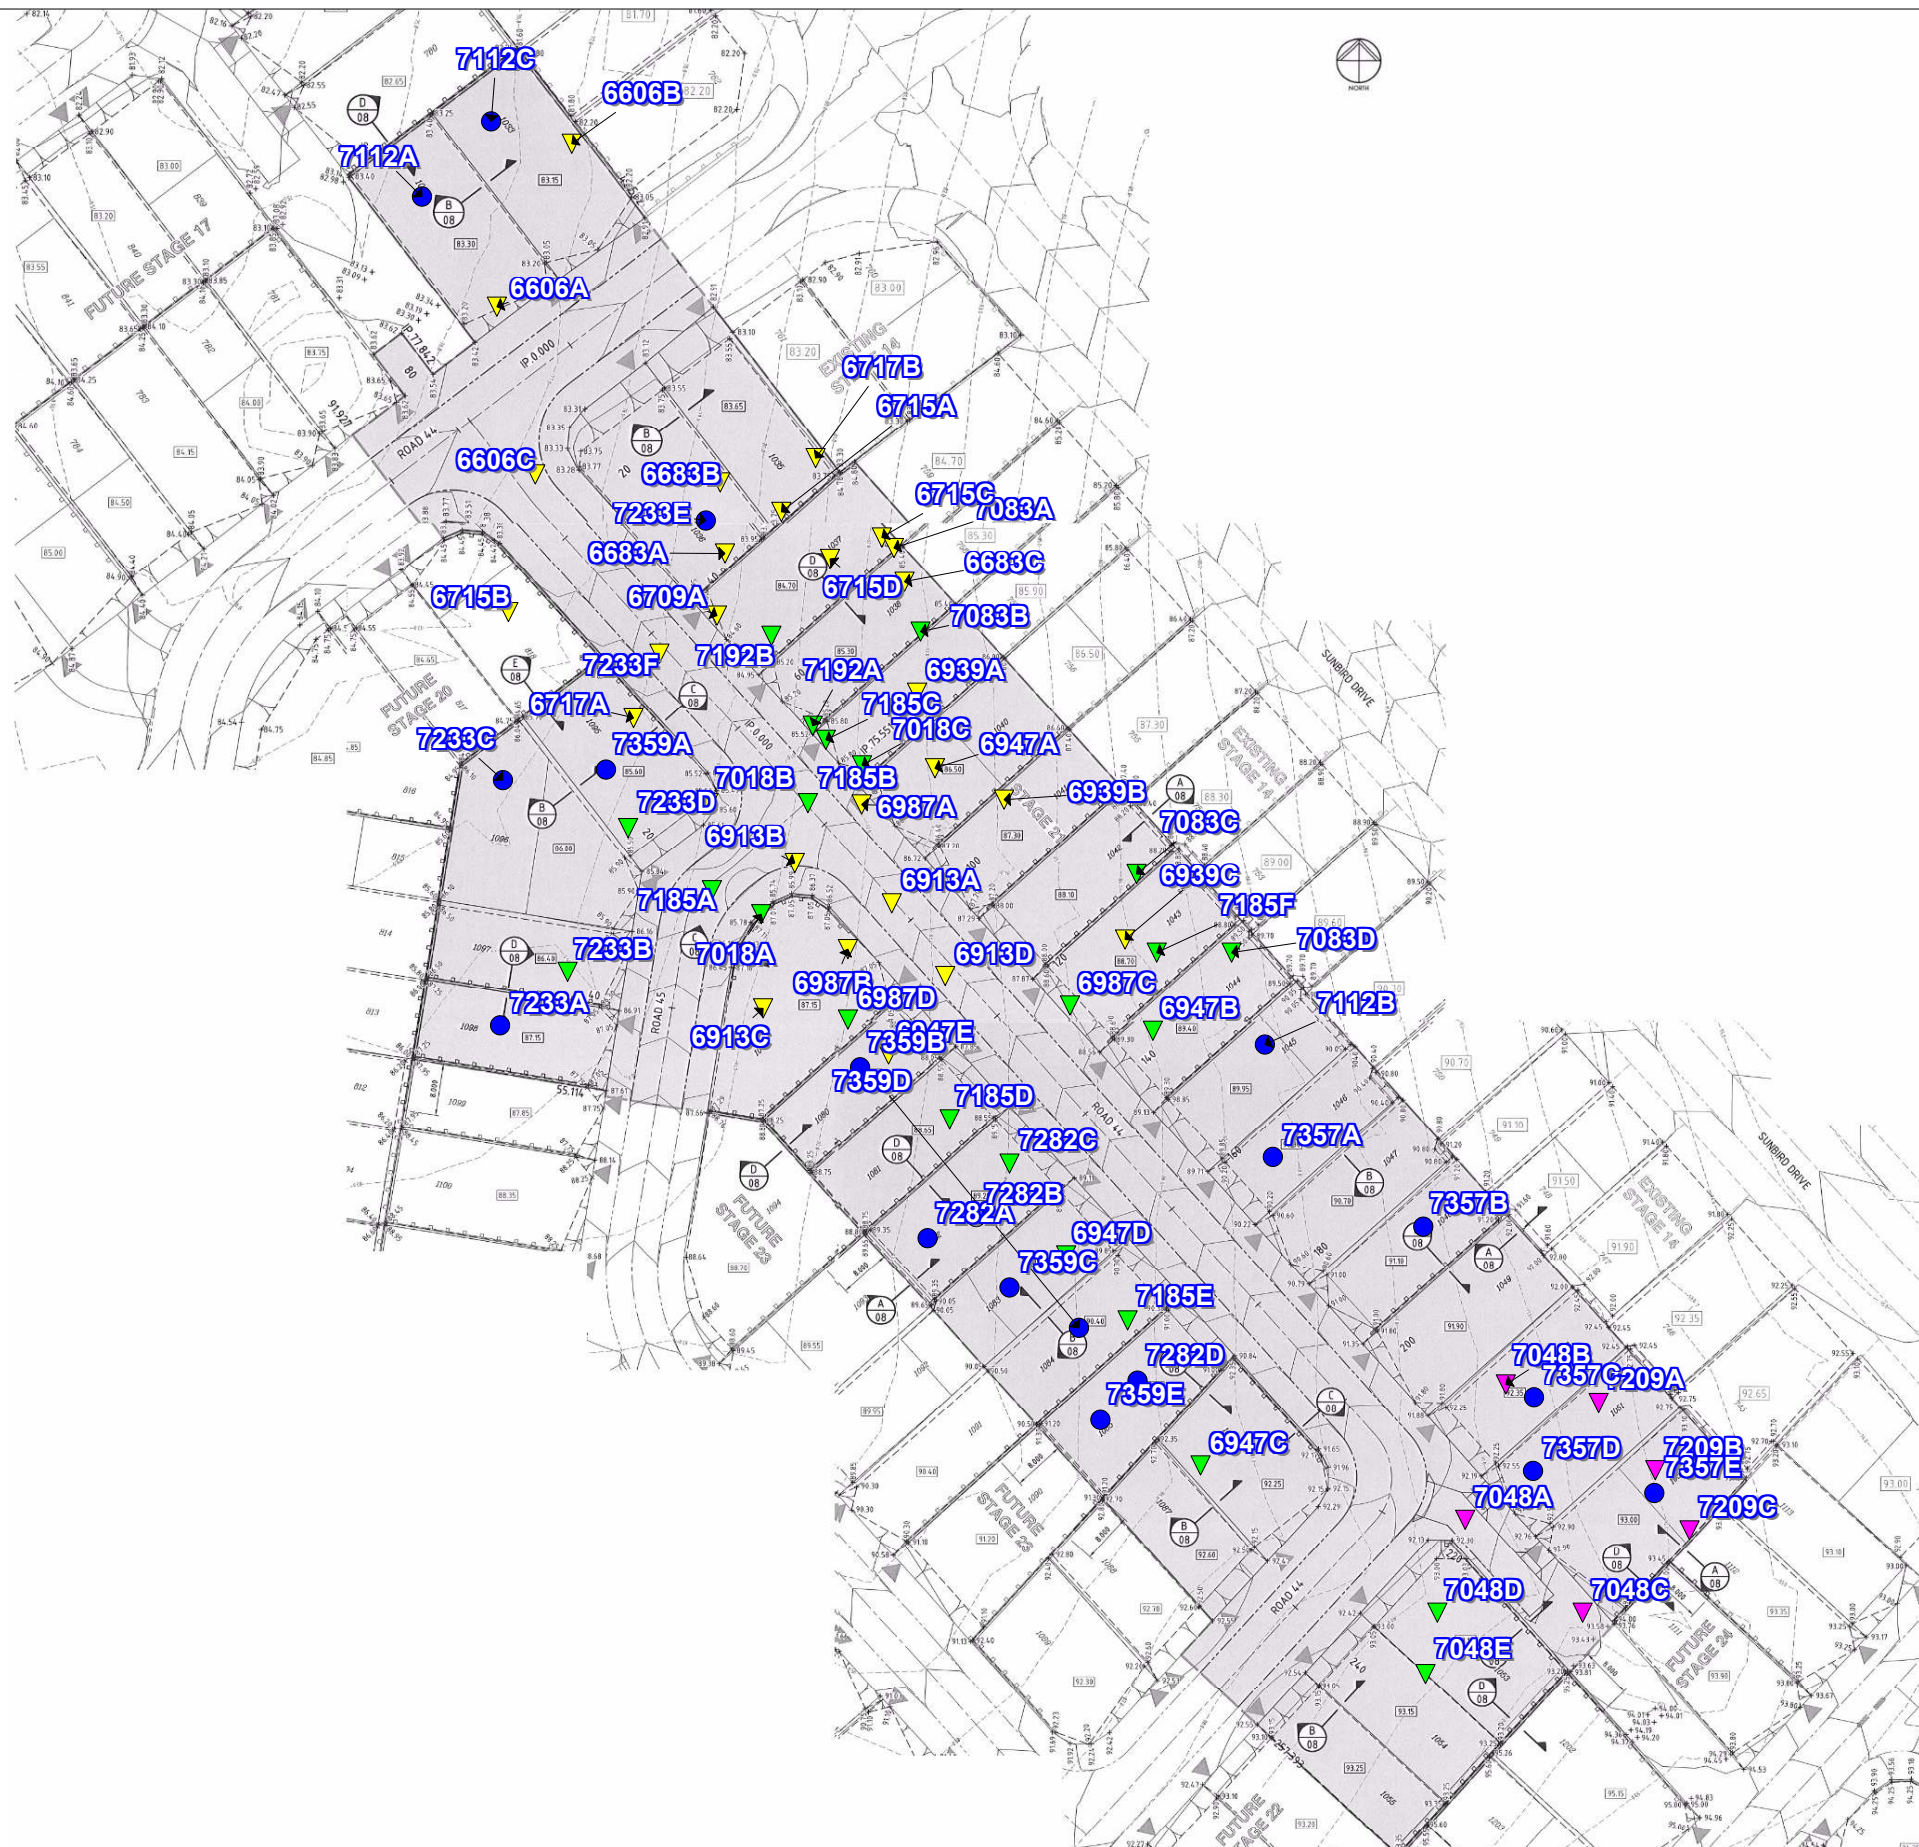

MORRISON GEOTECHNIC PTY LTD

ABN: 51 009 878 899

Unit 1/ 35 Limestone St, Darra 4076 Ph: 3279 0900
 Email: brisbanelab@morrisongeo.com.au

Engineers: M. Ballard
 D. Dragun
 Geologists: R. Howchin
 Laboratory: M. Morrison

LEGEND

- ▼ R.L 80.0 - 84.99
- ▼ R.L 85.0 - 89.99
- ▼ R.L 90.0 - 94.99
- Final Level

Map Description :	EARTHWORKS FIELD DENSITY TESTING - Level 1 Inspection		
Client :	SHADFORTHS PTY LTD		
Project :	EDENS CROSSING - STAGE 21		
Project No :	DL20/027	Drawing No :	DL20/027 - 01
		Scale :	Not to Scale



MORRISON GEOTECHNIC PTY LTD

ABN: 51 009 878 899

Unit 1/ 35 Limestone St, Darra 4076 Ph: 3279 0900
 Email: brisbanelab@morrisongeo.com.au Fax: 3279 0955

Engineers: D.Riley, J. Daly
 D.Dragun, & S.Wynne
 Geologists: L.Bexley & R.Howchin
 Laboratory: M.Morrison

LEGEND

- ▼ R.L 77.0 - 78.99
- ▼ R.L 79.0 - 80.99
- ▼ R.L 81.0 - 82.99
- ▼ R.L 83.0 - 84.99
- Final Level

Map Description :	EARTHWORKS FIELD DENSITY TESTING - Level 1 Inspection		
Client :	CCA WINSLOW		
Project :	EDENS CROSSING, FUTURE STAGES 15-20		
Project No :	DL17/398	Drawing No :	DL17/398 - 01
		Scale :	Not to Scale

Brisbane Office
Job Number: DL20/027
Ref No: 16172
Author: R. Mitchell

22nd April 2020

Shadforths Civil Pty Ltd
99 Sandalwood Lane
Forest Glen 4556

ATTENTION: MR MICHAEL PRITCHARD
Email: Michael.Pritchard@shadcivil.com.au

Dear Sir,

**RE: LOT 1082
LEVEL ONE COMPLIANCE REPORT FOR
EARTHWORKS FILL CONSTRUCTION
EDENS CROSSING STAGE 21**

Earthworks filling operations were carried out on Lot 1082 at the above Development to form a working platform to support a future residential building.

Earthworks were constructed by CCA Winslow (The Client) between May 2017 and March 2018 and Shadforths Civil (The Client) between January 2020 and March 2020.

This report should be read in conjunction with Morrison Geotechnic Report "16058 – DL20/027 Shadforths – Level One Compliance Report – Eden's Crossing Stage 21" Dated 21st April 2020. The Brief from the Client for was limited to:

- Level One Inspection of the placement and compaction of fill materials in accordance with AS3798 2007 – "Guidelines on Earthworks for Commercial and Residential Developments"
- Relative Density Control Testing in accordance with AS1289 – Testing of Soils for Engineering Purposes and at frequencies required in AS3798 Table 8.
- Ipswich City Council Specifications.
- Notes on KN Group Pty Ltd Civil Drawings.

Level One Inspections and Testing was carried out on the stripped ground surfaces and during the placement and compaction of fill materials. Field and laboratory testing included proof roll testing of the stripped surface and compaction testing.

Compaction testing at the Eden's Crossing Stage 21 Development was carried out at a frequency of 1 test per 500m³ of placed and compacted fill as defined in AS3798 Table 8.1. Test locations were selected using Random Stratified methods. Compaction testing was carried out at frequencies representative of the fill volume as a mass. On this basis, compaction testing was not required on each individual Lot.

A marked-up site plan shown the location of compaction testing is attached.

Fill constructed on Lot 1082 has been observed to be placed and compacted in accordance with the Brief. The fill on Lot 1082 can be termed as "Controlled Fill" in accordance with AS 2870-2011 "Residential Slabs and Footings".

This statement does not include any topsoil, which may have been placed for use as Lot dressing or any other subsequent earthworks after March 2020.

If there are any queries concerning the above please do not hesitate to contact this office, or alternatively send to my email at mickmorrison@morrisongeo.com.au.

Yours faithfully,


A handwritten signature in grey ink, appearing to read 'Rhys Mitchell', with a long horizontal flourish extending to the right.

RHYS MITCHELL

For and on Behalf of

MORRISON GEOTECHNIC PTY LIMITED

Encl: Marked Up Site Pan

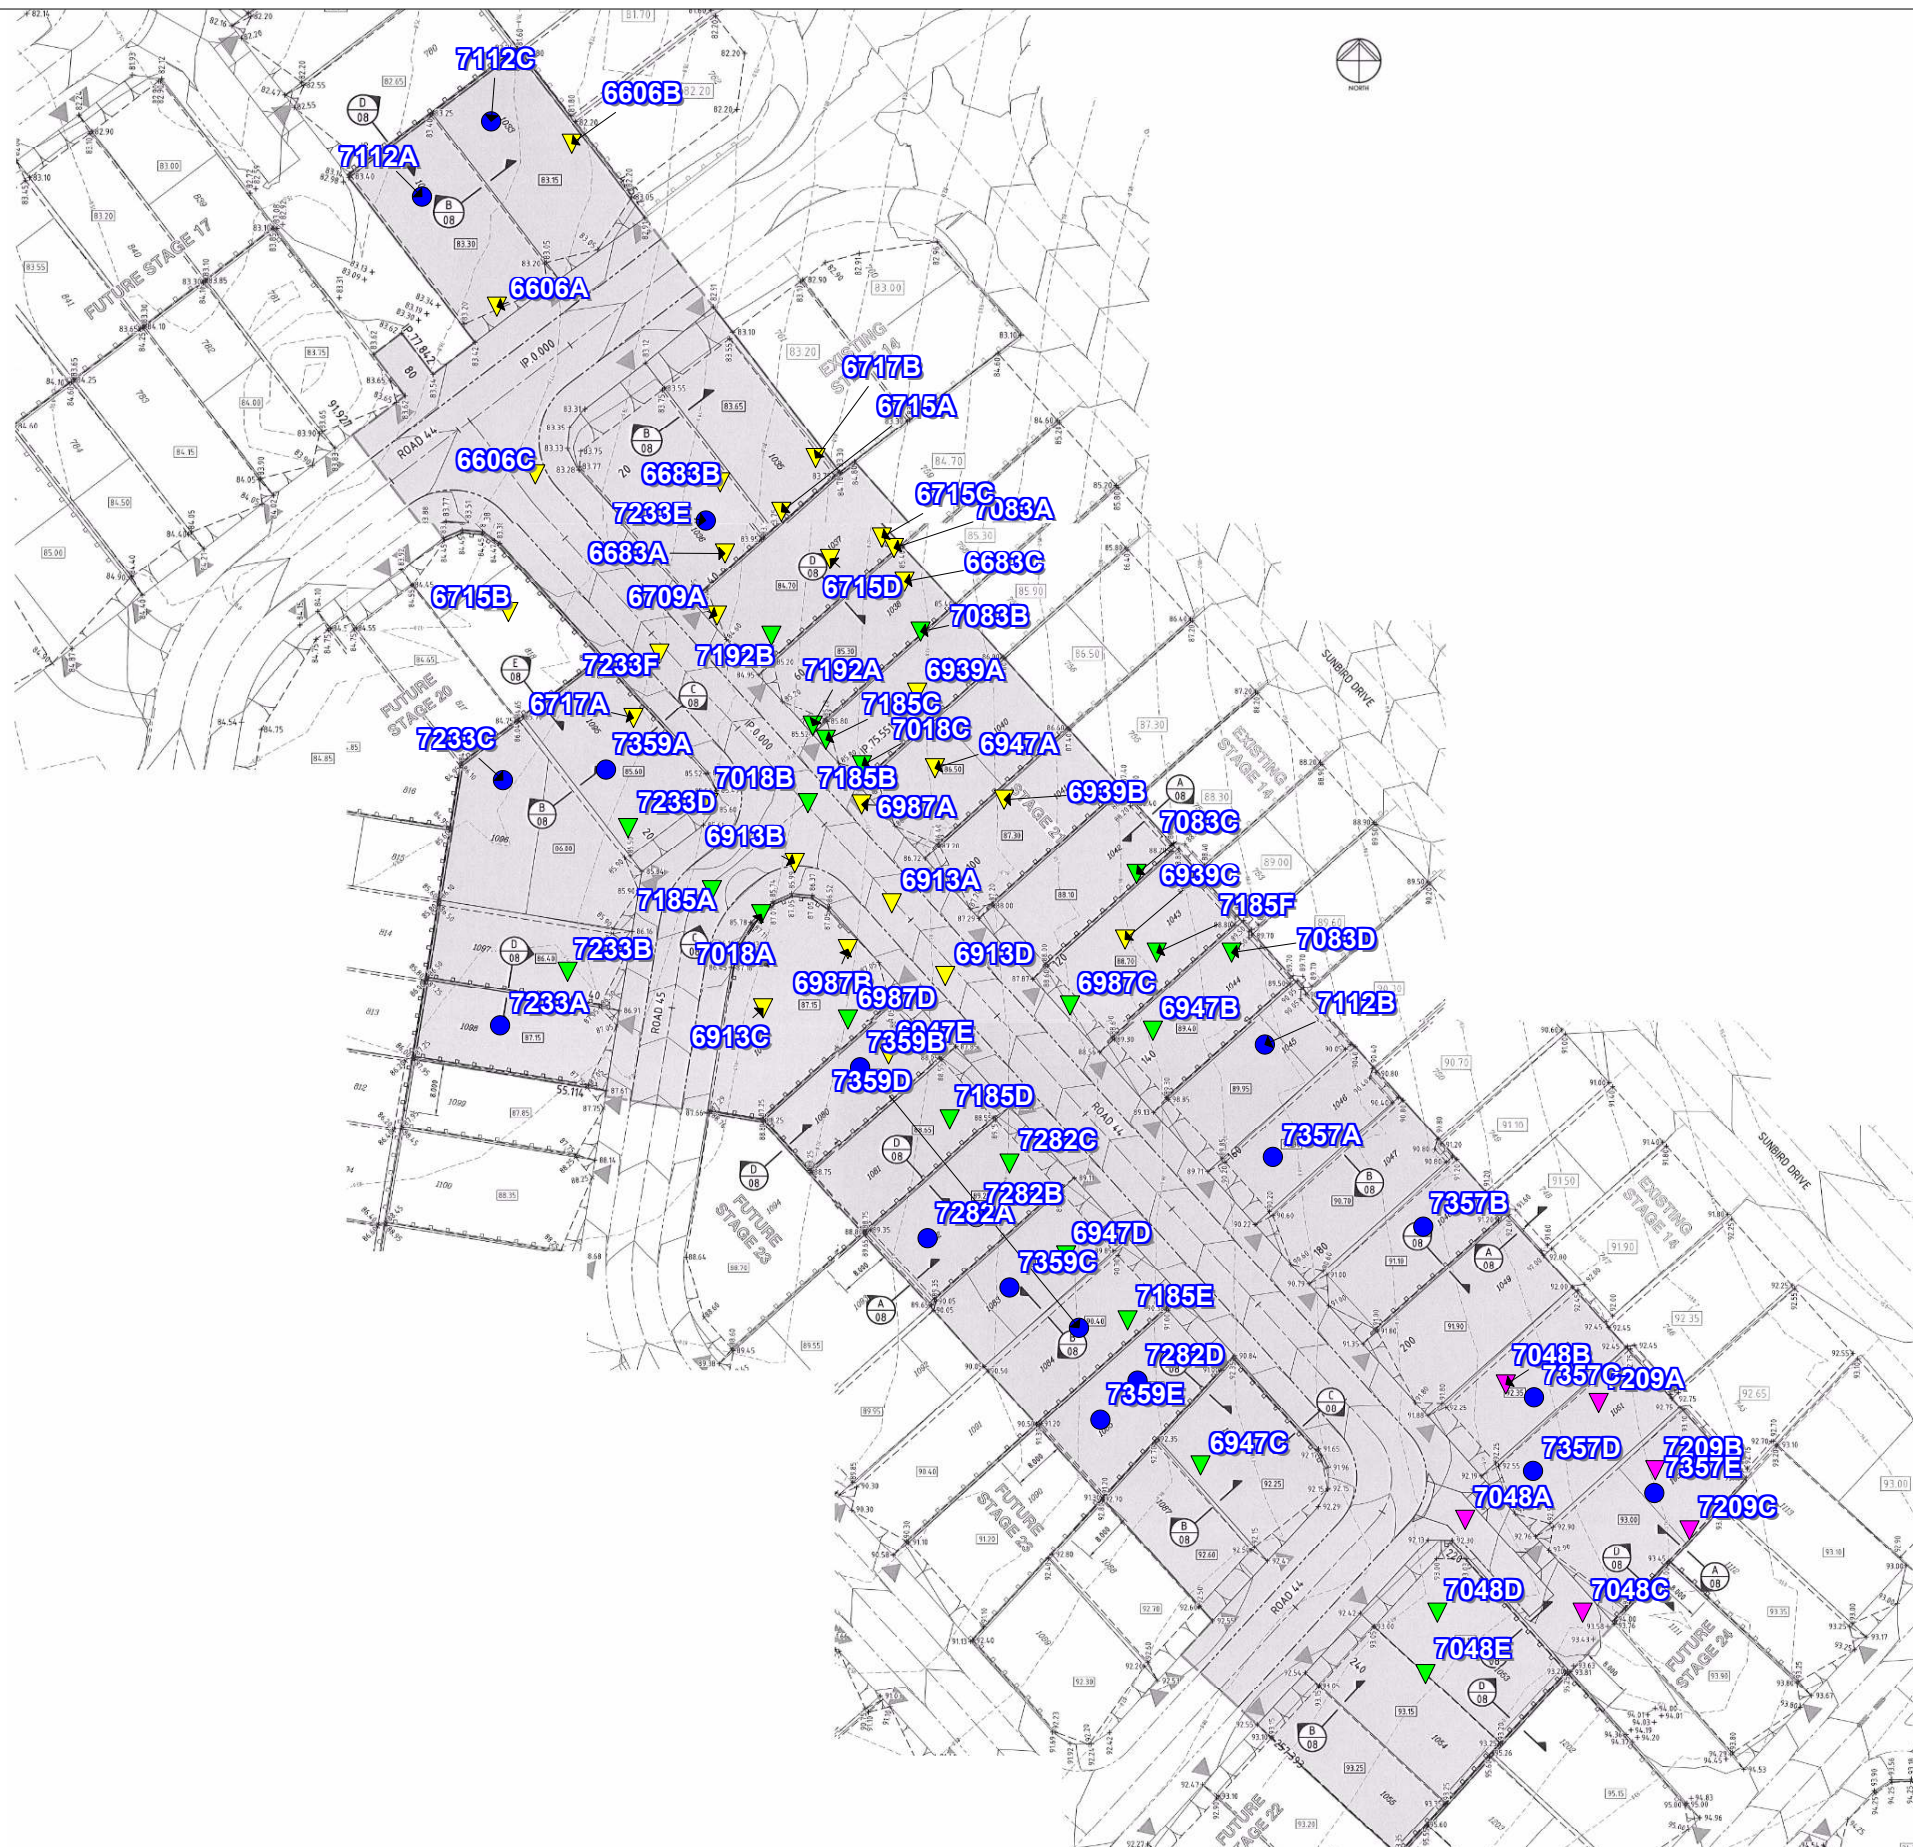

MORRISON GEOTECHNIC PTY LTD

ABN: 51 009 878 899

Unit 1/ 35 Limestone St, Darra 4076 Ph: 3279 0900
 Email: brisbanelab@morrisongeo.com.au

Engineers: M. Ballard
 D. Dragun
 Geologists: R. Howchin
 Laboratory: M. Morrison

LEGEND

- ▼ R.L 80.0 - 84.99
- ▼ R.L 85.0 - 89.99
- ▼ R.L 90.0 - 94.99
- Final Level

Map Description :	EARTHWORKS FIELD DENSITY TESTING - Level 1 Inspection		
Client :	SHADFORTHS PTY LTD		
Project :	EDENS CROSSING - STAGE 21		
Project No :	DL20/027	Drawing No :	DL20/027 - 01
		Scale :	Not to Scale



MORRISON GEOTECHNIC PTY LTD

ABN: 51 009 878 899

Unit 1/ 35 Limestone St, Darra 4076 Ph: 3279 0900
 Email: brisbanelab@morrisongeo.com.au Fax: 3279 0955

Engineers: D.Riley, J. Daly
 D.Dragun, & S.Wynne
 Geologists: L.Bexley & R.Howchin
 Laboratory: M.Morrison

LEGEND

- ▼ R.L 77.0 - 78.99
- ▼ R.L 79.0 - 80.99
- ▼ R.L 81.0 - 82.99
- ▼ R.L 83.0 - 84.99
- ▼ R.L 85.0 - 86.99
- Final Level

Map Description :	EARTHWORKS FIELD DENSITY TESTING - Level 1 Inspection		
Client :	CCA WINSLOW		
Project :	EDENS CROSSING, FUTURE STAGES 15-20		
Project No :	DL17/398	Drawing No :	DL17/398 - 01
		Scale :	Not to Scale

Brisbane Office
Job Number: DL20/027
Ref No: 16173
Author: R. Mitchell

22nd April 2020

Shadforths Civil Pty Ltd
99 Sandalwood Lane
Forest Glen 4556

ATTENTION: MR MICHAEL PRITCHARD
Email: Michael.Pritchard@shadcivil.com.au

Dear Sir,

**RE: LOT 1083
LEVEL ONE COMPLIANCE REPORT FOR
EARTHWORKS FILL CONSTRUCTION
EDENS CROSSING STAGE 21**

Earthworks filling operations were carried out on Lot 1083 at the above Development to form a working platform to support a future residential building.

Earthworks were constructed by CCA Winslow (The Client) between May 2017 and March 2018 and Shadforths Civil (The Client) between January 2020 and March 2020.

This report should be read in conjunction with Morrison Geotechnic Report “16058 – DL20/027 Shadforths – Level One Compliance Report – Eden’s Crossing Stage 21” Dated 21st April 2020. The Brief from the Client for was limited to:

- Level One Inspection of the placement and compaction of fill materials in accordance with AS3798 2007 – “Guidelines on Earthworks for Commercial and Residential Developments”
- Relative Density Control Testing in accordance with AS1289 – Testing of Soils for Engineering Purposes and at frequencies required in AS3798 Table 8.
- Ipswich City Council Specifications.
- Notes on KN Group Pty Ltd Civil Drawings.

Level One Inspections and Testing was carried out on the stripped ground surfaces and during the placement and compaction of fill materials. Field and laboratory testing included proof roll testing of the stripped surface and compaction testing.

Compaction testing at the Eden’s Crossing Stage 21 Development was carried out at a frequency of 1 test per 500m³ of placed and compacted fill as defined in AS3798 Table 8.1. Test locations were selected using Random Stratified methods. Compaction testing was carried out at frequencies representative of the fill volume as a mass. On this basis, compaction testing was not required on each individual Lot.

A marked-up site plan shown the location of compaction testing is attached.

Fill constructed on Lot 1083 has been observed to be placed and compacted in accordance with the Brief. The fill on Lot 1083 can be termed as "Controlled Fill" in accordance with AS 2870-2011 "Residential Slabs and Footings".

This statement does not include any topsoil, which may have been placed for use as Lot dressing or any other subsequent earthworks after March 2020.

If there are any queries concerning the above please do not hesitate to contact this office, or alternatively send to my email at mickmorrison@morrisongeo.com.au.

Yours faithfully,


A handwritten signature in grey ink, appearing to read 'Rhys Mitchell', with a long horizontal flourish extending to the right.

RHYS MITCHELL

For and on Behalf of

MORRISON GEOTECHNIC PTY LIMITED

Encl: Marked Up Site Pan

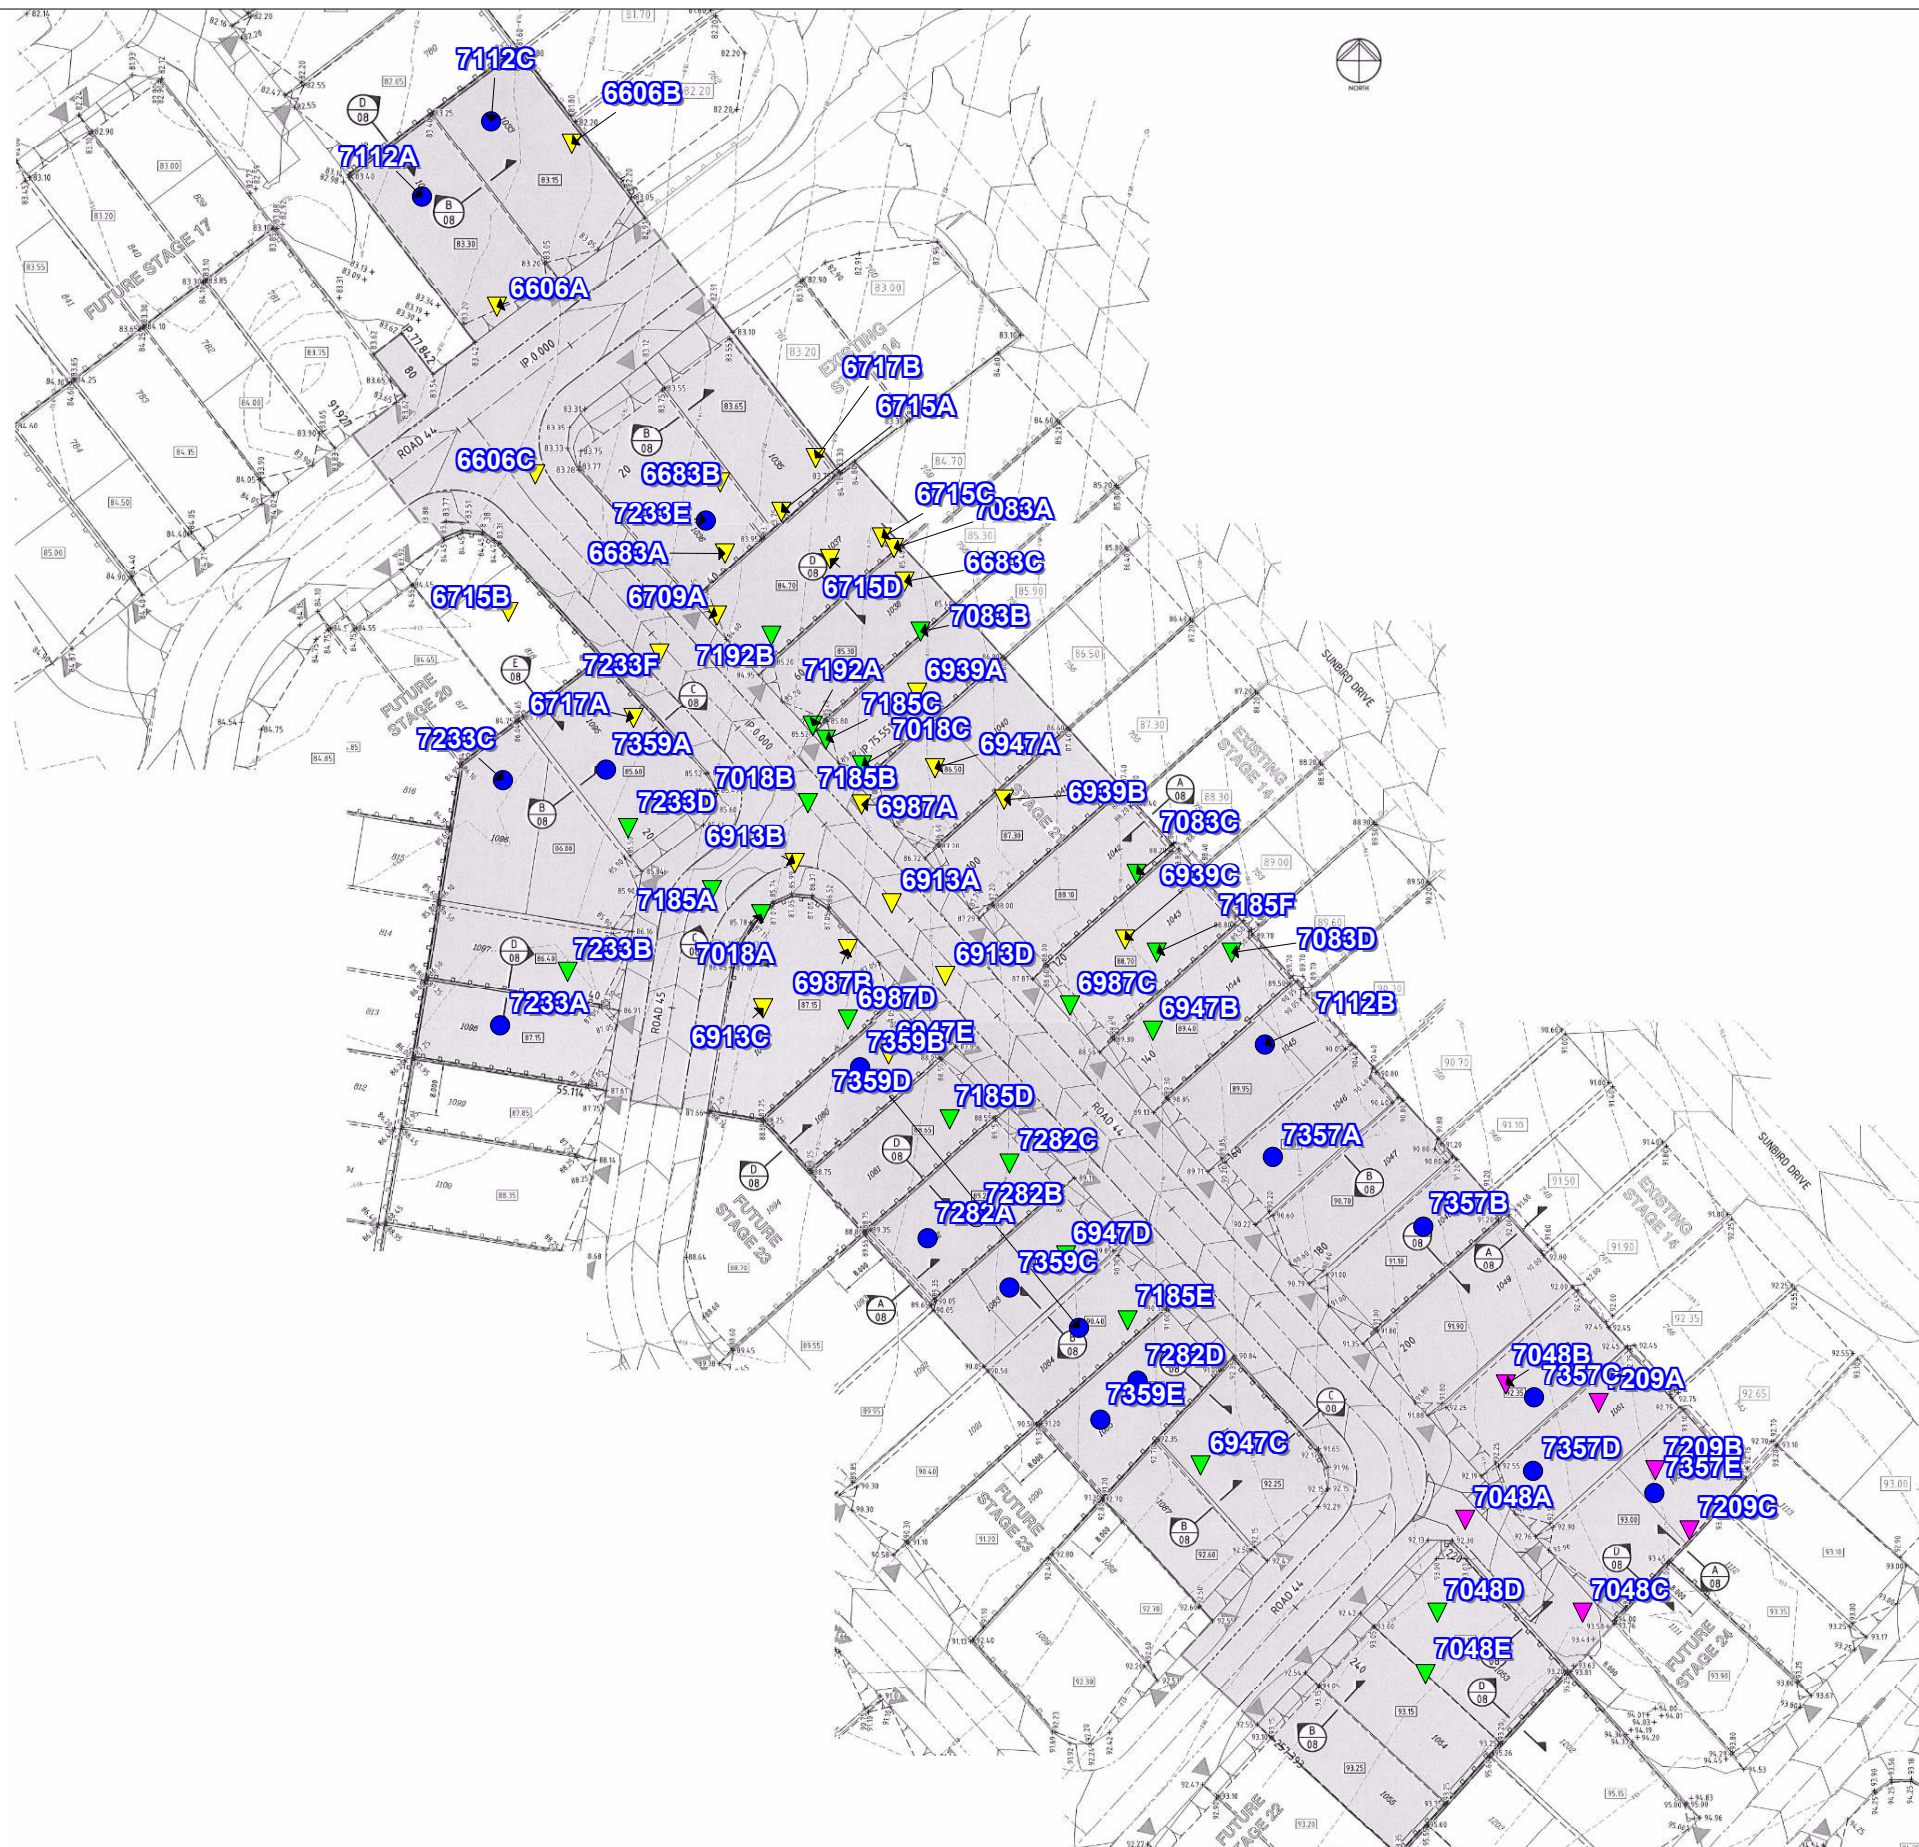

MORRISON GEOTECHNIC PTY LTD

ABN: 51 009 878 899

Unit 1/ 35 Limestone St, Darra 4076 Ph: 3279 0900
 Email: brisbanelab@morrisongeo.com.au

Engineers: M. Ballard
 D. Dragun
 Geologists: R. Howchin
 Laboratory: M. Morrison

LEGEND

- ▲ R.L 80.0 - 84.99
- ▲ R.L 85.0 - 89.99
- ▲ R.L 90.0 - 94.99
- Final Level

Map Description :	EARTHWORKS FIELD DENSITY TESTING - Level 1 Inspection		
Client :	SHADFORTHS PTY LTD		
Project :	EDENS CROSSING - STAGE 21		
Project No :	DL20/027	Drawing No :	DL20/027 - 01
		Scale :	Not to Scale



MORRISON GEOTECHNIC PTY LTD

ABN: 51 009 878 899

Unit 1/ 35 Limestone St, Darra 4076 Ph: 3279 0900
 Email: brisbanelab@morrisongeo.com.au Fax: 3279 0955

Engineers: D.Riley, J. Daly
 D.Dragun, & S.Wynne
 Geologists: L.Bexley & R.Howchin
 Laboratory: M.Morrison

LEGEND

- ▼ R.L 77.0 - 78.99
- ▼ R.L 79.0 - 80.99
- ▼ R.L 81.0 - 82.99
- ▼ R.L 83.0 - 84.99
- ▼ R.L 85.0 - 86.99
- Final Level

Map Description :	EARTHWORKS FIELD DENSITY TESTING - Level 1 Inspection		
Client :	CCA WINSLOW		
Project :	EDENS CROSSING, FUTURE STAGES 15-20		
Project No :	DL17/398	Drawing No :	DL17/398 - 01
		Scale :	Not to Scale

Brisbane Office
Job Number: DL20/027
Ref No: 16174
Author: R. Mitchell

22nd April 2020

Shadforths Civil Pty Ltd
99 Sandalwood Lane
Forest Glen 4556

ATTENTION: MR MICHAEL PRITCHARD
Email: Michael.Pritchard@shadcivil.com.au

Dear Sir,

**RE: LOT 1084
LEVEL ONE COMPLIANCE REPORT FOR
EARTHWORKS FILL CONSTRUCTION
EDENS CROSSING STAGE 21**

Earthworks filling operations were carried out on Lot 1084 at the above Development to form a working platform to support a future residential building.

Earthworks were constructed by CCA Winslow (The Client) between May 2017 and March 2018 and Shadforths Civil (The Client) between January 2020 and March 2020.

This report should be read in conjunction with Morrison Geotechnic Report “16058 – DL20/027 Shadforths – Level One Compliance Report – Eden’s Crossing Stage 21” Dated 21st April 2020. The Brief from the Client for was limited to:

- Level One Inspection of the placement and compaction of fill materials in accordance with AS3798 2007 – “Guidelines on Earthworks for Commercial and Residential Developments”
- Relative Density Control Testing in accordance with AS1289 – Testing of Soils for Engineering Purposes and at frequencies required in AS3798 Table 8.
- Ipswich City Council Specifications.
- Notes on KN Group Pty Ltd Civil Drawings.

Level One Inspections and Testing was carried out on the stripped ground surfaces and during the placement and compaction of fill materials. Field and laboratory testing included proof roll testing of the stripped surface and compaction testing.

Compaction testing at the Eden’s Crossing Stage 21 Development was carried out at a frequency of 1 test per 500m³ of placed and compacted fill as defined in AS3798 Table 8.1. Test locations were selected using Random Stratified methods. Compaction testing was carried out at frequencies representative of the fill volume as a mass. On this basis, compaction testing was not required on each individual Lot.

A marked-up site plan shown the location of compaction testing is attached.

Fill constructed on Lot 1084 has been observed to be placed and compacted in accordance with the Brief. The fill on Lot 1084 can be termed as "Controlled Fill" in accordance with AS 2870-2011 "Residential Slabs and Footings".

This statement does not include any topsoil, which may have been placed for use as Lot dressing or any other subsequent earthworks after March 2020.

If there are any queries concerning the above please do not hesitate to contact this office, or alternatively send to my email at mickmorrison@morrisongeo.com.au.

Yours faithfully,


A handwritten signature in grey ink, appearing to read 'Rhys Mitchell', with a horizontal line extending to the right.

RHYS MITCHELL

For and on Behalf of

MORRISON GEOTECHNIC PTY LIMITED

Encl: Marked Up Site Pan

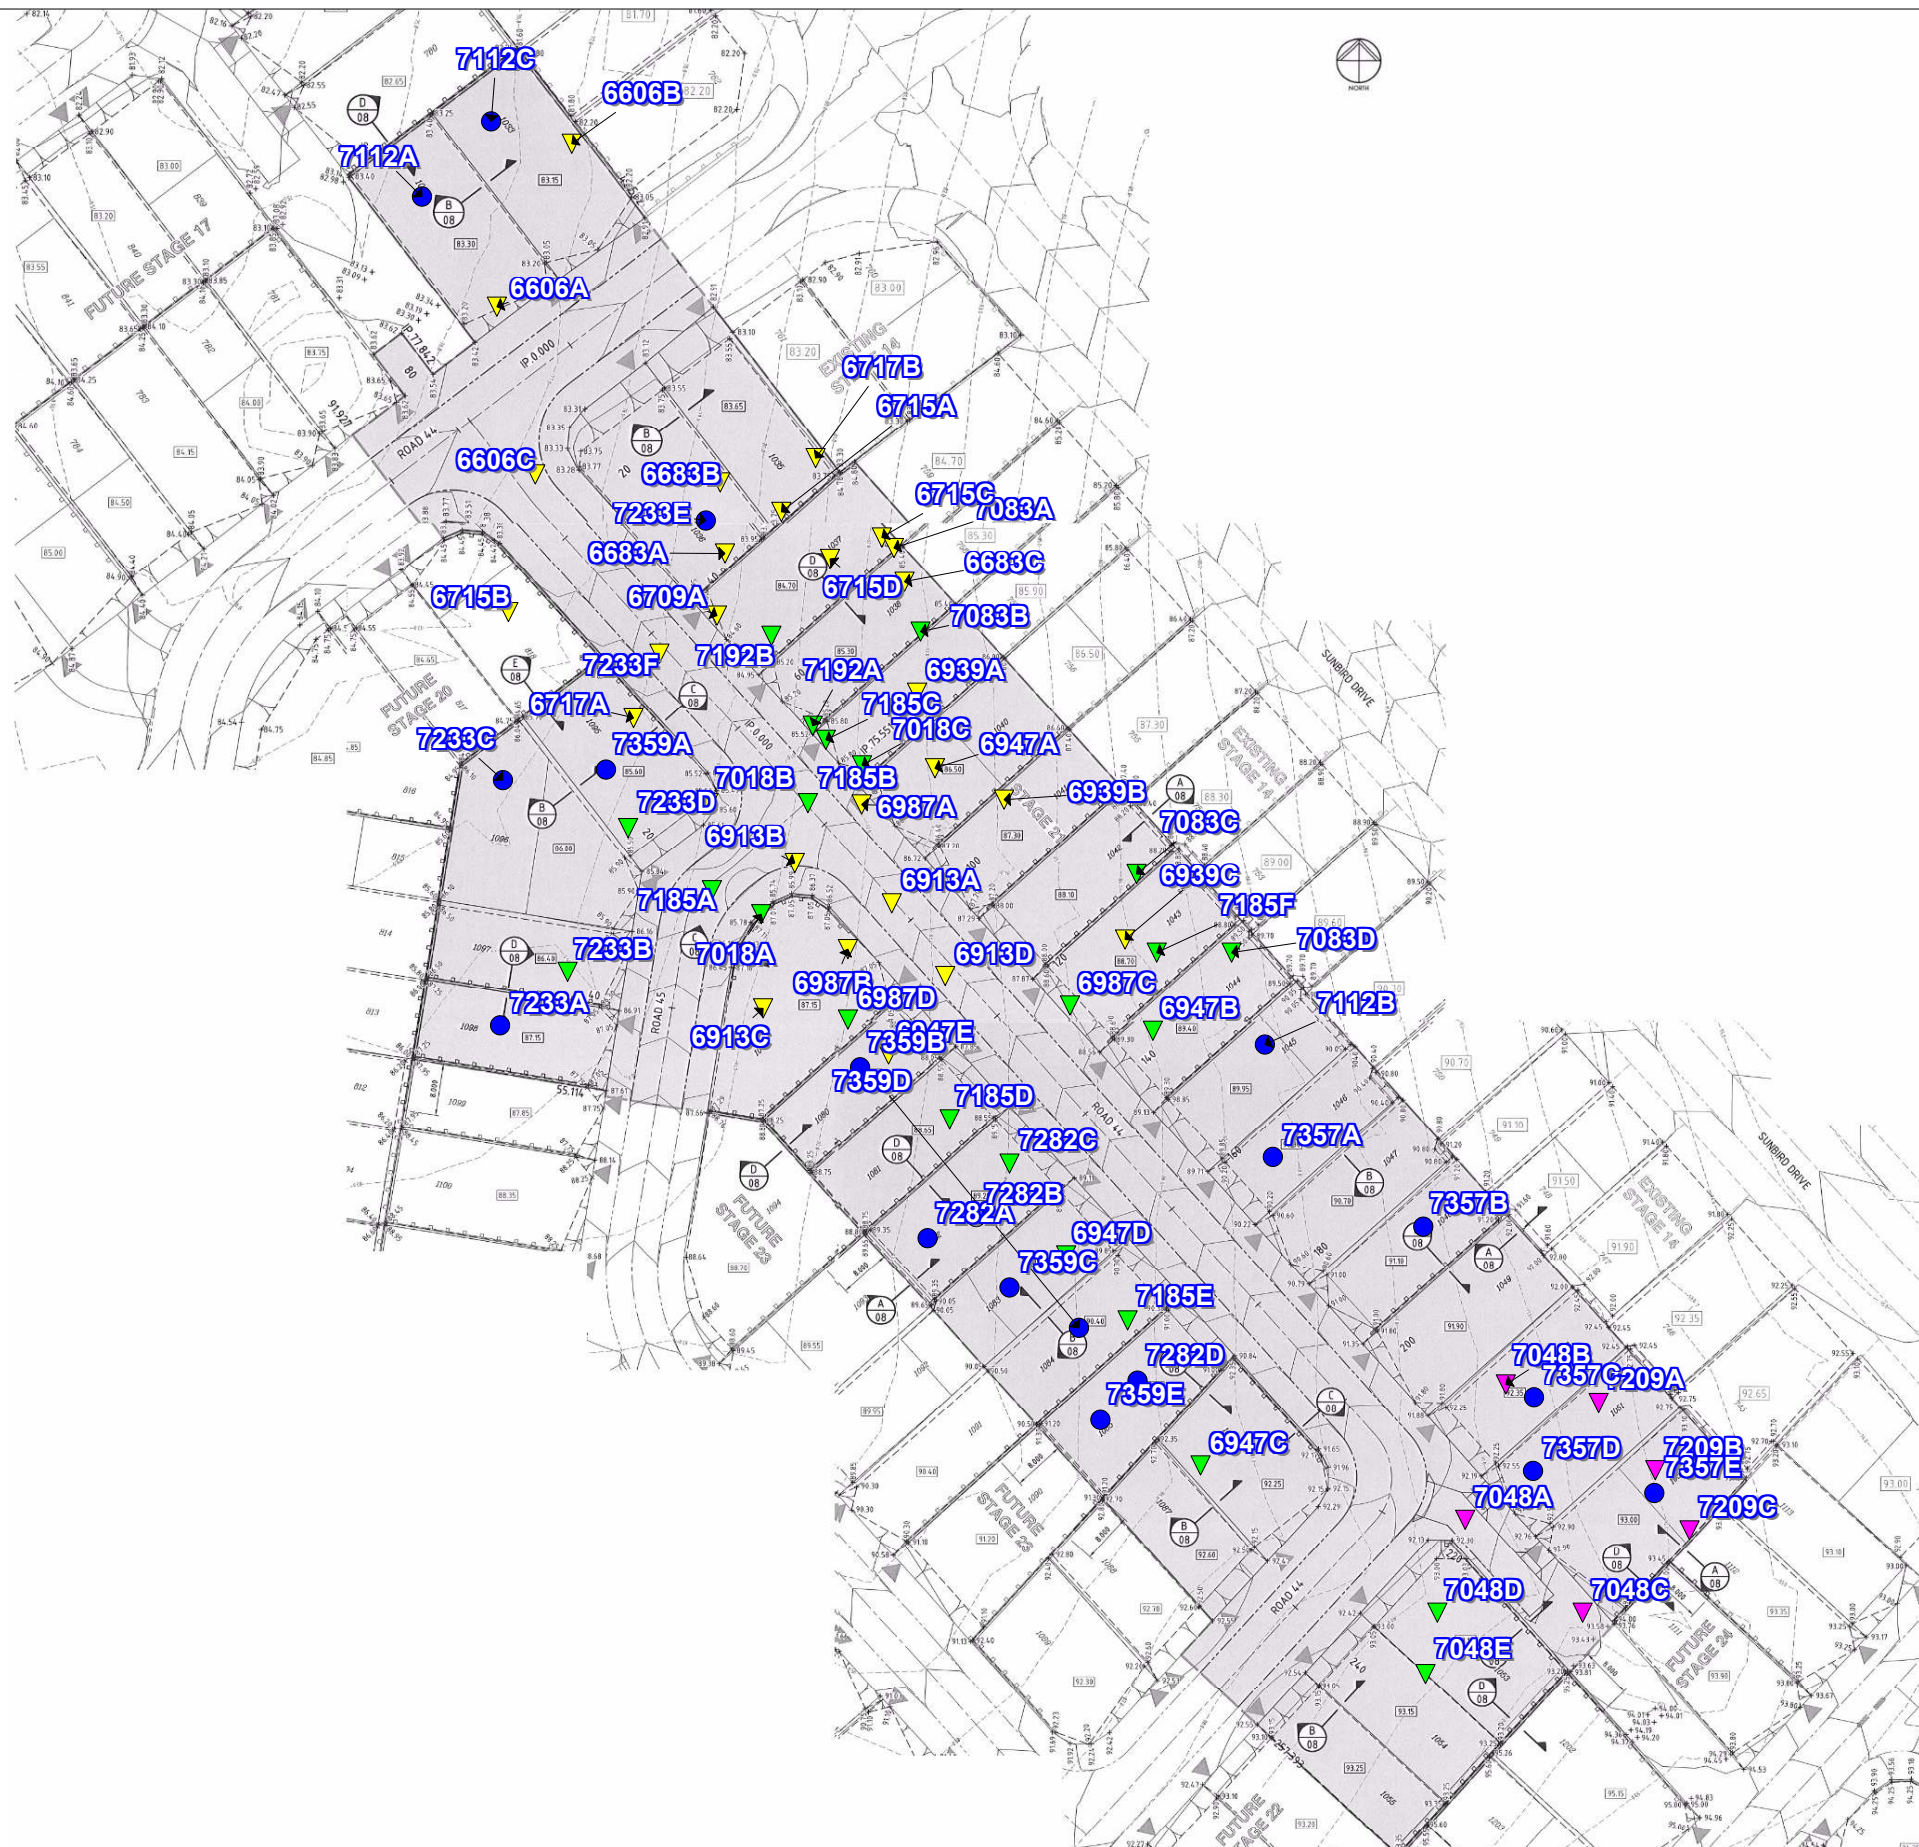

MORRISON GEOTECHNIC PTY LTD

ABN: 51 009 878 899

Unit 1/ 35 Limestone St, Darra 4076 Ph: 3279 0900
 Email: brisbanelab@morrisongeo.com.au

Engineers: M. Ballard
 D. Dragun
 Geologists: R. Howchin
 Laboratory: M. Morrison

LEGEND

- ▲ R.L 80.0 - 84.99
- ▲ R.L 85.0 - 89.99
- ▲ R.L 90.0 - 94.99
- Final Level

Map Description :	EARTHWORKS FIELD DENSITY TESTING - Level 1 Inspection		
Client :	SHADFORTHS PTY LTD		
Project :	EDENS CROSSING - STAGE 21		
Project No :	DL20/027	Drawing No :	DL20/027 - 01
		Scale :	Not to Scale



MORRISON GEOTECHNIC PTY LTD

ABN: 51 009 878 899

Unit 1/ 35 Limestone St, Darra 4076 Ph: 3279 0900
 Email: brisbanelab@morrisongeo.com.au Fax: 3279 0955

Engineers: D.Riley, J. Daly
 D.Dragun, & S.Wynne
 Geologists: L.Bexley & R.Howchin
 Laboratory: M.Morrison

LEGEND

- ▼ R.L 77.0 - 78.99
- ▼ R.L 79.0 - 80.99
- ▼ R.L 81.0 - 82.99
- ▼ R.L 83.0 - 84.99
- ▼ R.L 85.0 - 86.99
- Final Level

Map Description :	EARTHWORKS FIELD DENSITY TESTING - Level 1 Inspection		
Client :	CCA WINSLOW		
Project :	EDENS CROSSING, FUTURE STAGES 15-20		
Project No :	DL17/398	Drawing No :	DL17/398 - 01
		Scale :	Not to Scale

Brisbane Office
Job Number: DL20/027
Ref No: 16175
Author: R. Mitchell

22nd April 2020

Shadforths Civil Pty Ltd
99 Sandalwood Lane
Forest Glen 4556

ATTENTION: MR MICHAEL PRITCHARD
Email: Michael.Pritchard@shadcivil.com.au

Dear Sir,

**RE: LOT 1085
LEVEL ONE COMPLIANCE REPORT FOR
EARTHWORKS FILL CONSTRUCTION
EDENS CROSSING STAGE 21**

Earthworks filling operations were carried out on Lot 1085 at the above Development to form a working platform to support a future residential building.

Earthworks were constructed by CCA Winslow (The Client) between May 2017 and March 2018 and Shadforths Civil (The Client) between January 2020 and March 2020.

This report should be read in conjunction with Morrison Geotechnic Report “16058 – DL20/027 Shadforths – Level One Compliance Report – Eden’s Crossing Stage 21” Dated 21st April 2020. The Brief from the Client for was limited to:

- Level One Inspection of the placement and compaction of fill materials in accordance with AS3798 2007 – “Guidelines on Earthworks for Commercial and Residential Developments”
- Relative Density Control Testing in accordance with AS1289 – Testing of Soils for Engineering Purposes and at frequencies required in AS3798 Table 8.
- Ipswich City Council Specifications.
- Notes on KN Group Pty Ltd Civil Drawings.

Level One Inspections and Testing was carried out on the stripped ground surfaces and during the placement and compaction of fill materials. Field and laboratory testing included proof roll testing of the stripped surface and compaction testing.

Compaction testing at the Eden’s Crossing Stage 21 Development was carried out at a frequency of 1 test per 500m³ of placed and compacted fill as defined in AS3798 Table 8.1. Test locations were selected using Random Stratified methods. Compaction testing was carried out at frequencies representative of the fill volume as a mass. On this basis, compaction testing was not required on each individual Lot.

A marked-up site plan shown the location of compaction testing is attached.

Fill constructed on Lot 1085 has been observed to be placed and compacted in accordance with the Brief. The fill on Lot 1085 can be termed as "Controlled Fill" in accordance with AS 2870-2011 "Residential Slabs and Footings".

This statement does not include any topsoil, which may have been placed for use as Lot dressing or any other subsequent earthworks after March 2020.

If there are any queries concerning the above please do not hesitate to contact this office, or alternatively send to my email at mickmorrison@morrisongeo.com.au.

Yours faithfully,


A handwritten signature in grey ink, appearing to read 'Rhys Mitchell', with a long horizontal flourish extending to the right.

RHYS MITCHELL

For and on Behalf of

MORRISON GEOTECHNIC PTY LIMITED

Encl: Marked Up Site Pan

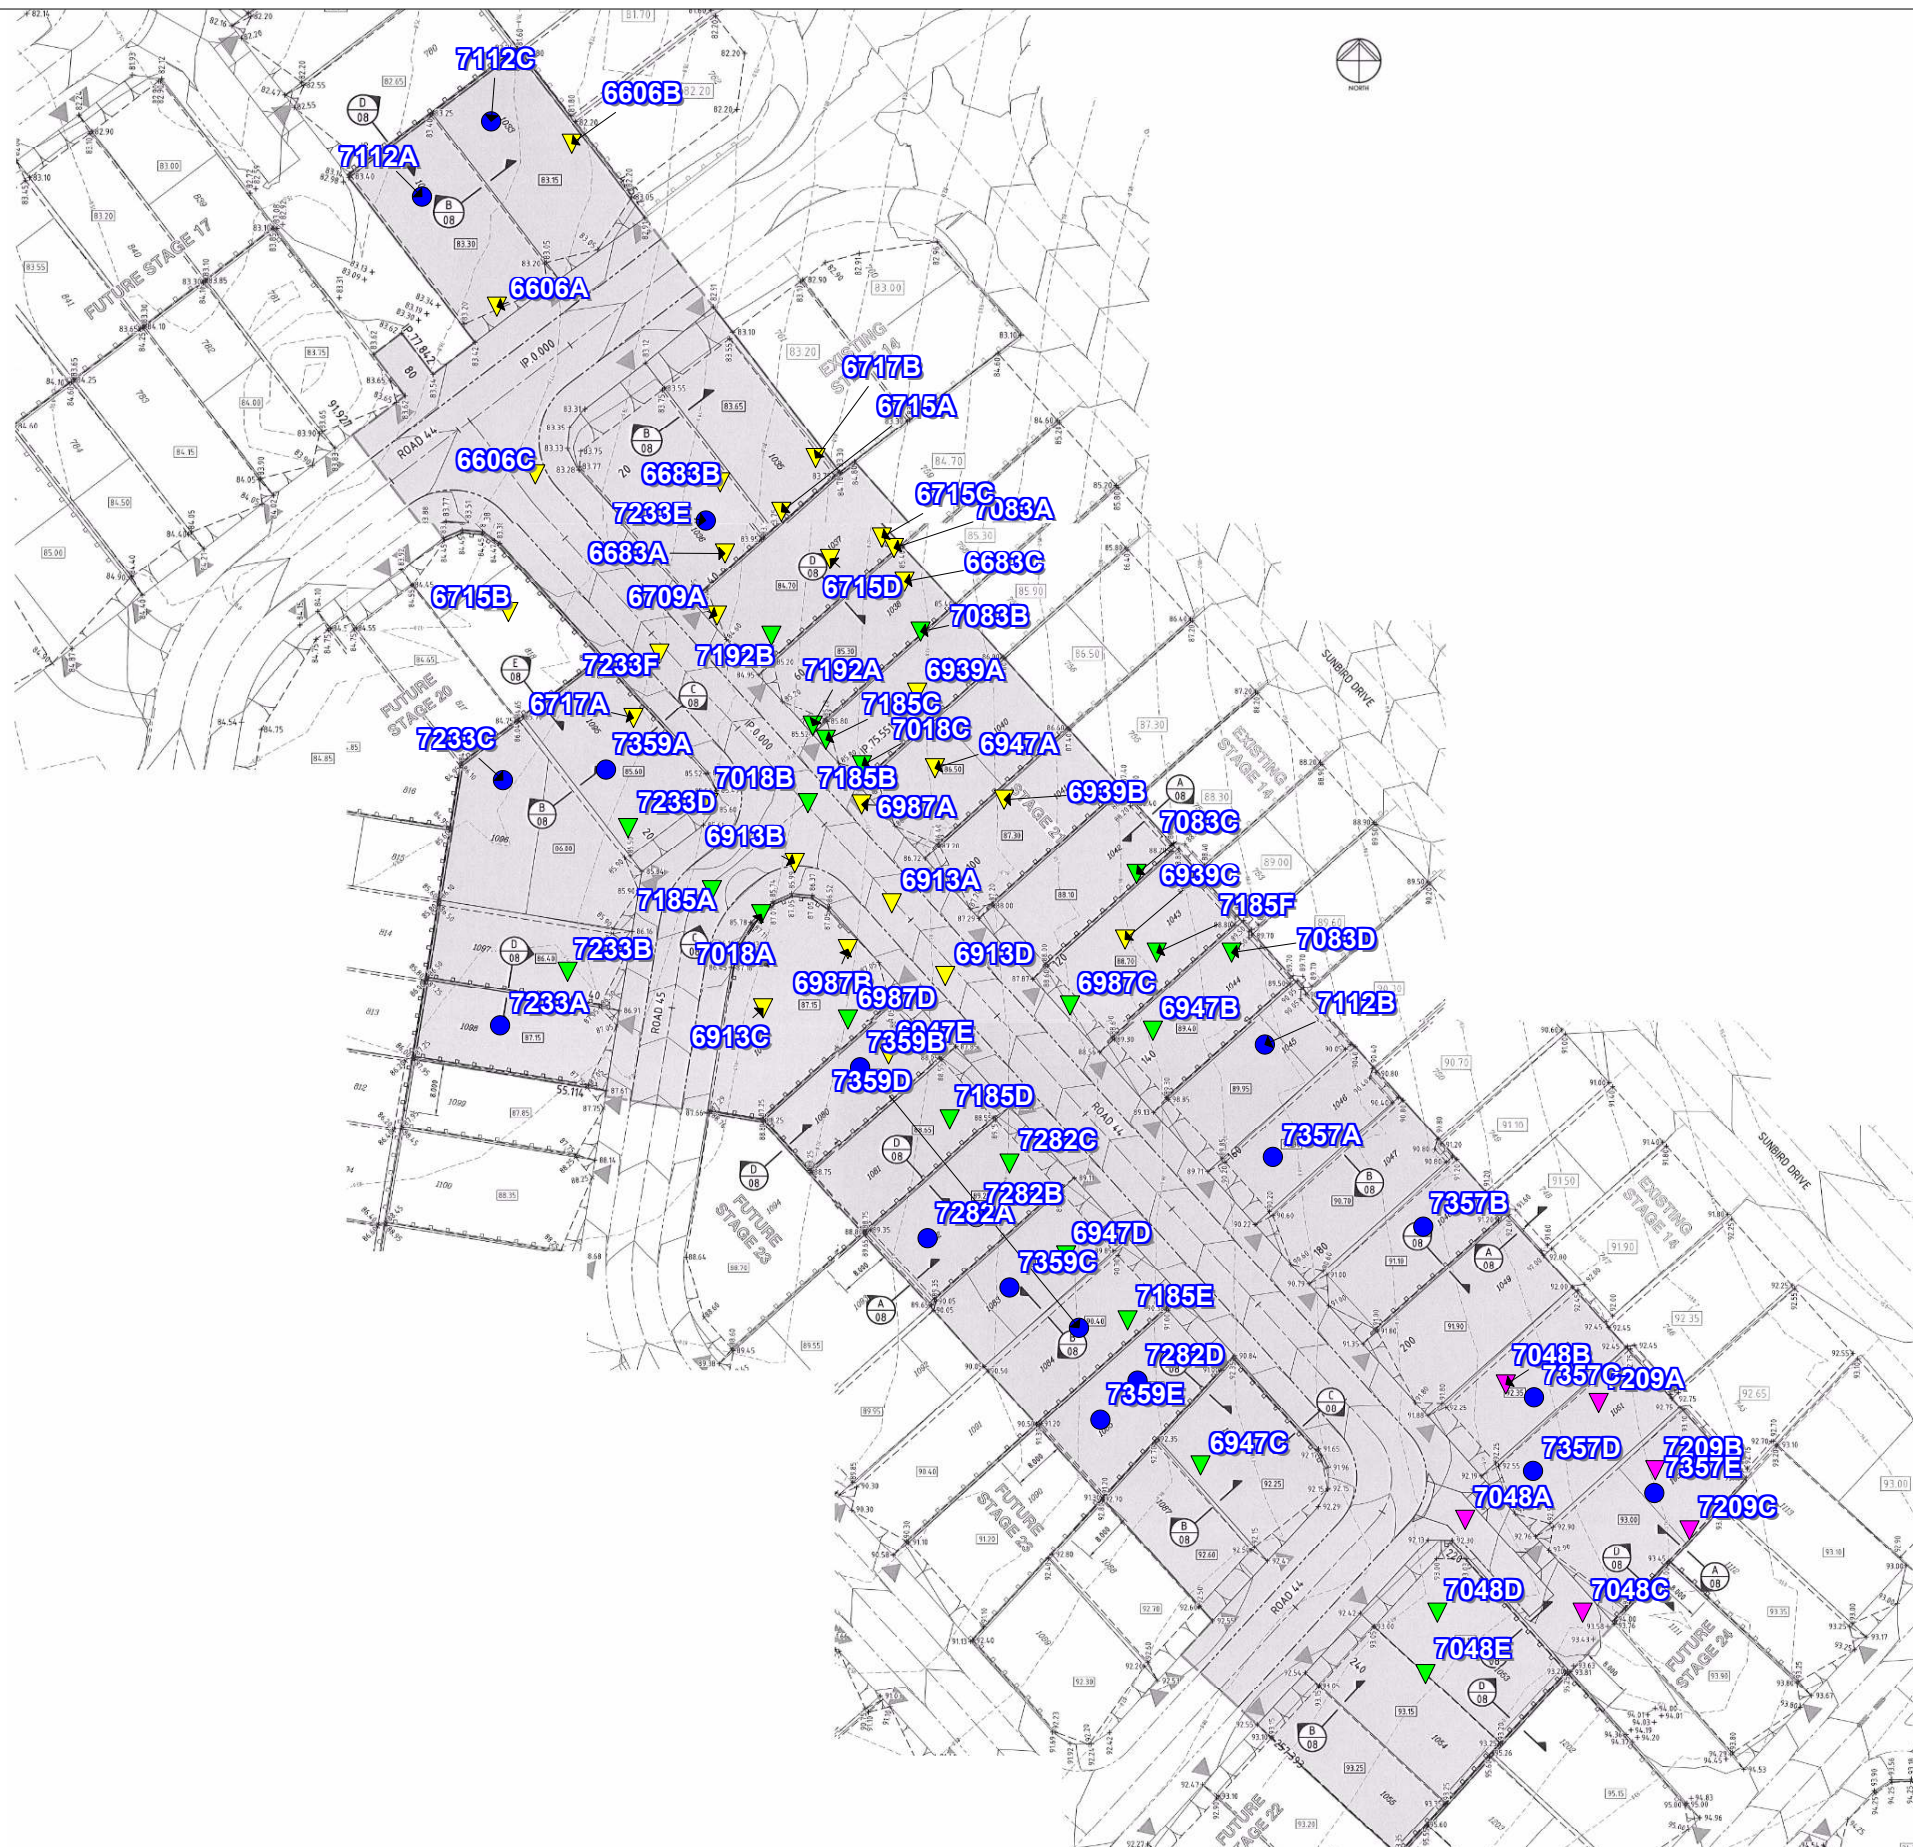

MORRISON GEOTECHNIC PTY LTD

ABN: 51 009 878 899

Unit 1/ 35 Limestone St, Darra 4076 Ph: 3279 0900
 Email: brisbanelab@morrisongeo.com.au

Engineers: M. Ballard
 D. Dragun
 Geologists: R. Howchin
 Laboratory: M. Morrison

LEGEND

- ▼ R.L 80.0 - 84.99
- ▼ R.L 85.0 - 89.99
- ▼ R.L 90.0 - 94.99
- Final Level

Map Description :	EARTHWORKS FIELD DENSITY TESTING - Level 1 Inspection		
Client :	SHADFORTHS PTY LTD		
Project :	EDENS CROSSING - STAGE 21		
Project No :	DL20/027	Drawing No :	DL20/027 - 01
		Scale :	Not to Scale



MORRISON GEOTECHNIC PTY LTD

ABN: 51 009 878 899

Unit 1/ 35 Limestone St, Darra 4076 Ph: 3279 0900
 Email: brisbanelab@morrisongeo.com.au Fax: 3279 0955

Engineers: D.Riley, J. Daly
 D.Dragun, & S.Wynne
 Geologists: L.Bexley & R.Howchin
 Laboratory: M.Morrison

LEGEND

- ▼ R.L 77.0 - 78.99
- ▼ R.L 79.0 - 80.99
- ▼ R.L 81.0 - 82.99
- ▼ R.L 83.0 - 84.99
- Final Level

Map Description :	EARTHWORKS FIELD DENSITY TESTING - Level 1 Inspection		
Client :	CCA WINSLOW		
Project :	EDENS CROSSING, FUTURE STAGES 15-20		
Project No :	DL17/398	Drawing No :	DL17/398 - 01
		Scale :	Not to Scale

Brisbane Office
Job Number: DL20/027
Ref No: 16176
Author: R. Mitchell

22nd April 2020

Shadforths Civil Pty Ltd
99 Sandalwood Lane
Forest Glen 4556

ATTENTION: MR MICHAEL PRITCHARD
Email: Michael.Pritchard@shadcivil.com.au

Dear Sir,

**RE: LOT 1086
LEVEL ONE COMPLIANCE REPORT FOR
EARTHWORKS FILL CONSTRUCTION
EDENS CROSSING STAGE 21**

Earthworks filling operations were carried out on Lot 1086 at the above Development to form a working platform to support a future residential building.

Earthworks were constructed by CCA Winslow (The Client) between May 2017 and March 2018 and Shadforths Civil (The Client) between January 2020 and March 2020.

This report should be read in conjunction with Morrison Geotechnic Report “16058 – DL20/027 Shadforths – Level One Compliance Report – Eden’s Crossing Stage 21” Dated 21st April 2020. The Brief from the Client for was limited to:

- Level One Inspection of the placement and compaction of fill materials in accordance with AS3798 2007 – “Guidelines on Earthworks for Commercial and Residential Developments”
- Relative Density Control Testing in accordance with AS1289 – Testing of Soils for Engineering Purposes and at frequencies required in AS3798 Table 8.
- Ipswich City Council Specifications.
- Notes on KN Group Pty Ltd Civil Drawings.

Level One Inspections and Testing was carried out on the stripped ground surfaces and during the placement and compaction of fill materials. Field and laboratory testing included proof roll testing of the stripped surface and compaction testing.

Compaction testing at the Eden’s Crossing Stage 21 Development was carried out at a frequency of 1 test per 500m³ of placed and compacted fill as defined in AS3798 Table 8.1. Test locations were selected using Random Stratified methods. Compaction testing was carried out at frequencies representative of the fill volume as a mass. On this basis, compaction testing was not required on each individual Lot.

A marked-up site plan shown the location of compaction testing is attached.

Fill constructed on Lot 1086 has been observed to be placed and compacted in accordance with the Brief. The fill on Lot 1086 can be termed as "Controlled Fill" in accordance with AS 2870-2011 "Residential Slabs and Footings".

This statement does not include any topsoil, which may have been placed for use as Lot dressing or any other subsequent earthworks after March 2020.

If there are any queries concerning the above please do not hesitate to contact this office, or alternatively send to my email at mickmorrison@morrisongeo.com.au.

Yours faithfully,


A handwritten signature in grey ink, appearing to read 'Rhys Mitchell', with a long horizontal flourish extending to the right.

RHYS MITCHELL

For and on Behalf of

MORRISON GEOTECHNIC PTY LIMITED

Encl: Marked Up Site Pan

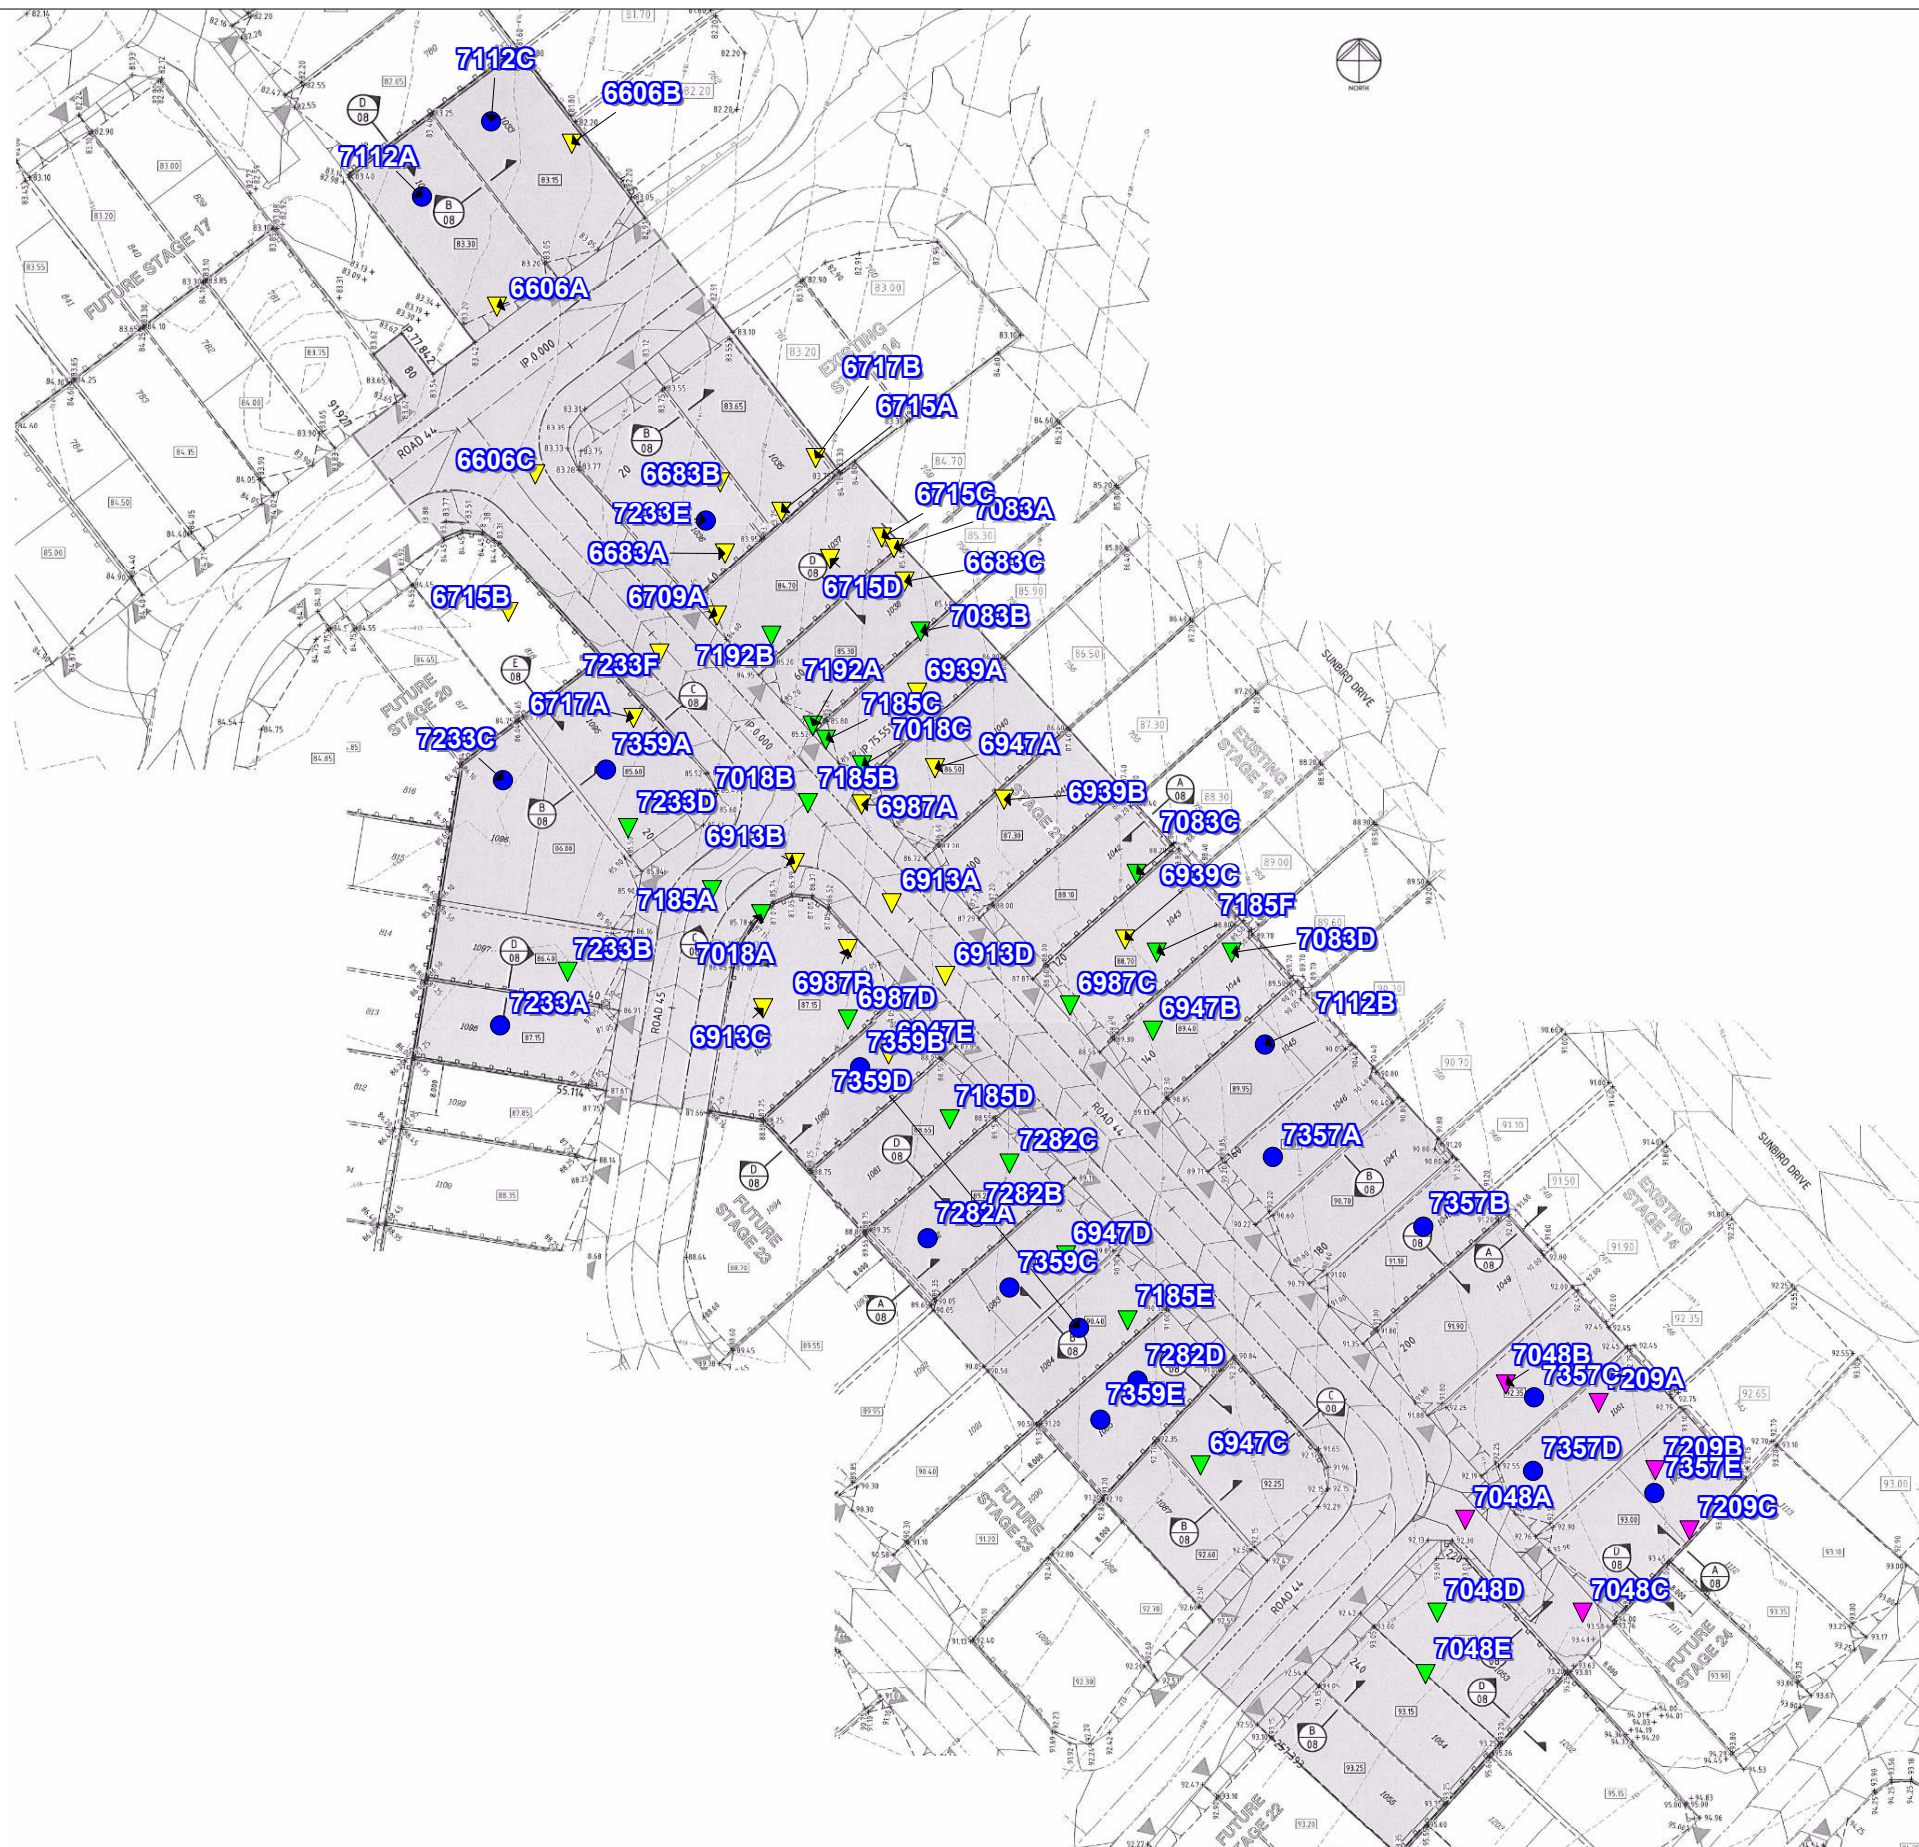

MORRISON GEOTECHNIC PTY LTD

ABN: 51 009 878 899

Unit 1/ 35 Limestone St, Darra 4076 Ph: 3279 0900
 Email: brisbanelab@morrisongeo.com.au

Engineers: M. Ballard
 D. Dragun
 Geologists: R. Howchin
 Laboratory: M. Morrison

LEGEND

- ▲ R.L 80.0 - 84.99
- ▲ R.L 85.0 - 89.99
- ▲ R.L 90.0 - 94.99
- Final Level

Map Description :	EARTHWORKS FIELD DENSITY TESTING - Level 1 Inspection		
Client :	SHADFORTHS PTY LTD		
Project :	EDENS CROSSING - STAGE 21		
Project No :	DL20/027	Drawing No :	DL20/027 - 01
Scale :	Not to Scale		



MORRISON GEOTECHNIC PTY LTD

ABN: 51 009 878 899

Unit 1/ 35 Limestone St, Darra 4076 Ph: 3279 0900
 Email: brisbanelab@morrisongeo.com.au Fax: 3279 0955

Engineers: D.Riley, J. Daly
 D.Dragun, & S.Wynne
 Geologists: L.Bexley & R.Howchin
 Laboratory: M.Morrison

LEGEND

- ▼ R.L 77.0 - 78.99
- ▼ R.L 79.0 - 80.99
- ▼ R.L 81.0 - 82.99
- ▼ R.L 83.0 - 84.99
- Final Level

Map Description :	EARTHWORKS FIELD DENSITY TESTING - Level 1 Inspection		
Client :	CCA WINSLOW		
Project :	EDENS CROSSING, FUTURE STAGES 15-20		
Project No :	DL17/398	Drawing No :	DL17/398 - 01
		Scale :	Not to Scale

Brisbane Office
Job Number: DL20/027
Ref No: 16177
Author: R. Mitchell

22nd April 2020

Shadforths Civil Pty Ltd
99 Sandalwood Lane
Forest Glen 4556

ATTENTION: MR MICHAEL PRITCHARD
Email: Michael.Pritchard@shadcivil.com.au

Dear Sir,

**RE: LOT 1087
LEVEL ONE COMPLIANCE REPORT FOR
EARTHWORKS FILL CONSTRUCTION
EDENS CROSSING STAGE 21**

Earthworks filling operations were carried out on Lot 1087 at the above Development to form a working platform to support a future residential building.

Earthworks were constructed by CCA Winslow (The Client) between May 2017 and March 2018 and Shadforths Civil (The Client) between January 2020 and March 2020.

This report should be read in conjunction with Morrison Geotechnic Report "16058 – DL20/027 Shadforths – Level One Compliance Report – Eden's Crossing Stage 21" Dated 21st April 2020. The Brief from the Client for was limited to:

- Level One Inspection of the placement and compaction of fill materials in accordance with AS3798 2007 – "Guidelines on Earthworks for Commercial and Residential Developments"
- Relative Density Control Testing in accordance with AS1289 – Testing of Soils for Engineering Purposes and at frequencies required in AS3798 Table 8.
- Ipswich City Council Specifications.
- Notes on KN Group Pty Ltd Civil Drawings.

Level One Inspections and Testing was carried out on the stripped ground surfaces and during the placement and compaction of fill materials. Field and laboratory testing included proof roll testing of the stripped surface and compaction testing.

Compaction testing at the Eden's Crossing Stage 21 Development was carried out at a frequency of 1 test per 500m³ of placed and compacted fill as defined in AS3798 Table 8.1. Test locations were selected using Random Stratified methods. Compaction testing was carried out at frequencies representative of the fill volume as a mass. On this basis, compaction testing was not required on each individual Lot.

A marked-up site plan shown the location of compaction testing is attached.

Fill constructed on Lot 1087 has been observed to be placed and compacted in accordance with the Brief. The fill on Lot 1087 can be termed as "Controlled Fill" in accordance with AS 2870-2011 "Residential Slabs and Footings".

This statement does not include any topsoil, which may have been placed for use as Lot dressing or any other subsequent earthworks after March 2020.

If there are any queries concerning the above please do not hesitate to contact this office, or alternatively send to my email at mickmorrison@morrisongeo.com.au.

Yours faithfully,


A handwritten signature in grey ink, appearing to read 'Rhys Mitchell', with a horizontal line extending to the right.

RHYS MITCHELL

For and on Behalf of

MORRISON GEOTECHNIC PTY LIMITED

Encl: Marked Up Site Pan

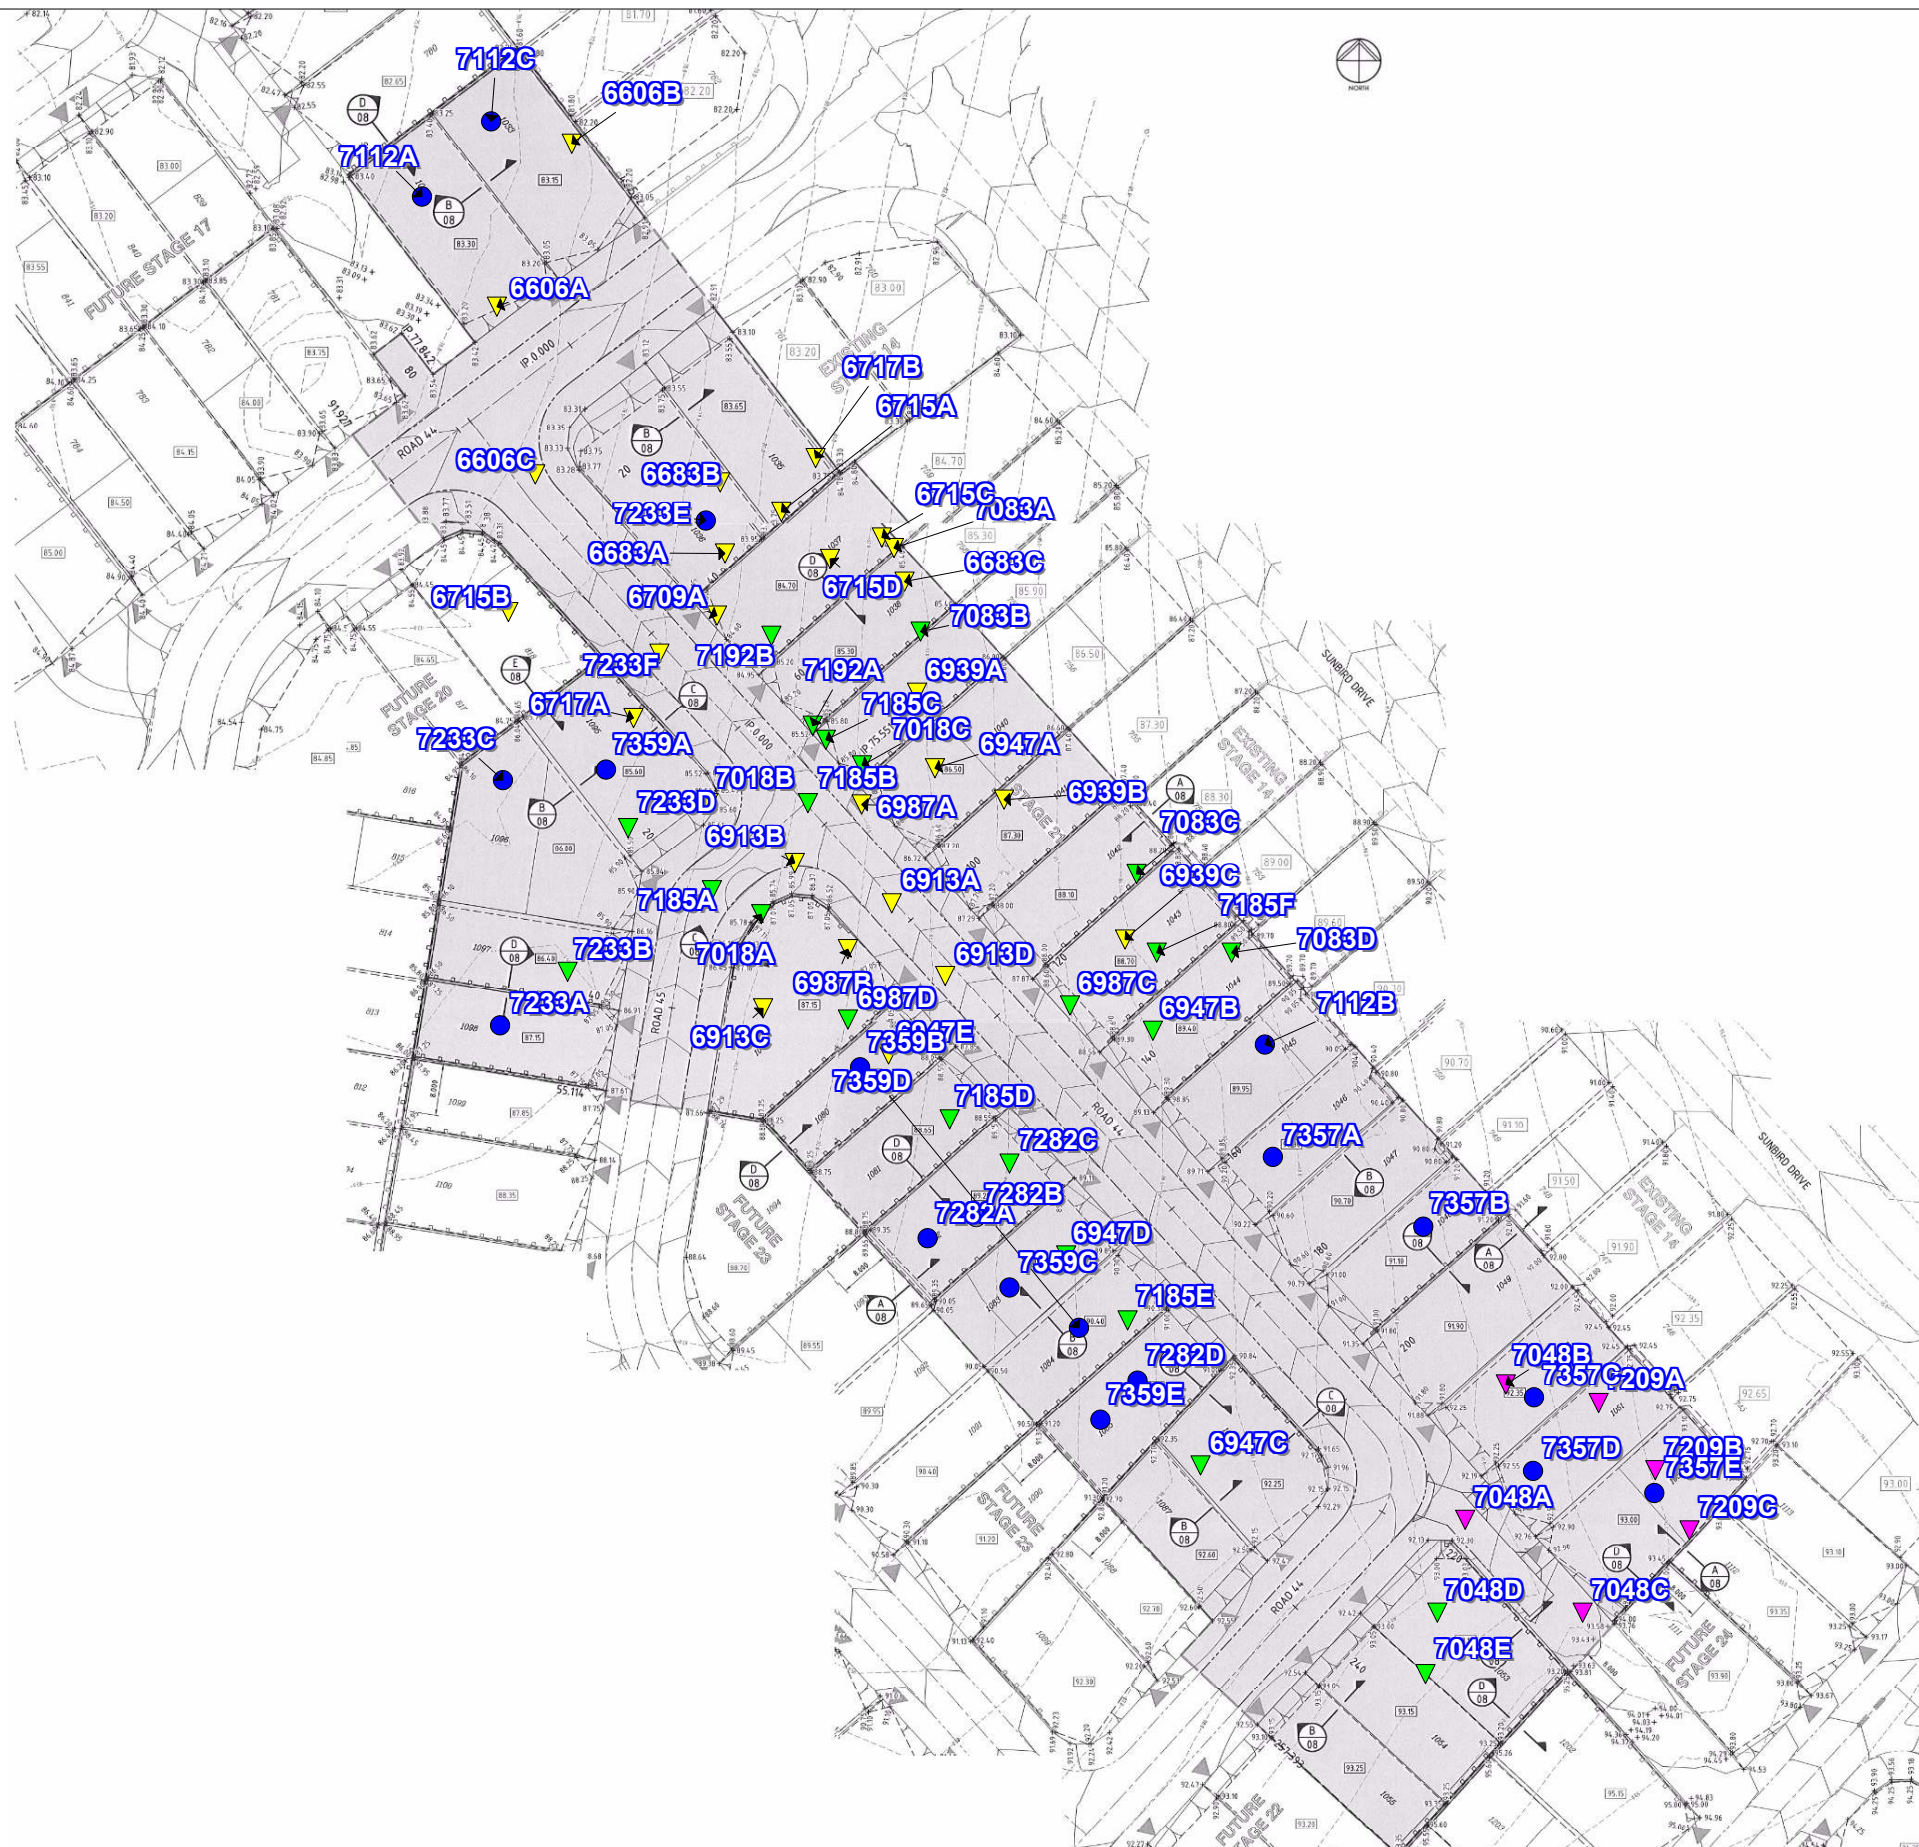

MORRISON GEOTECHNIC PTY LTD

ABN: 51 009 878 899

Unit 1/ 35 Limestone St, Darra 4076 Ph: 3279 0900
 Email: brisbanelab@morrisongeo.com.au

Engineers: M. Ballard
 D. Dragun
 Geologists: R. Howchin
 Laboratory: M. Morrison

LEGEND

- ▼ R.L 80.0 - 84.99
- ▼ R.L 85.0 - 89.99
- ▼ R.L 90.0 - 94.99
- Final Level

Map Description :	EARTHWORKS FIELD DENSITY TESTING - Level 1 Inspection		
Client :	SHADFORTHS PTY LTD		
Project :	EDENS CROSSING - STAGE 21		
Project No :	DL20/027	Drawing No :	DL20/027 - 01
Scale :	Not to Scale		



MORRISON GEOTECHNIC PTY LTD

ABN: 51 009 878 899

Unit 1/ 35 Limestone St, Darra 4076 Ph: 3279 0900
 Email: brisbanelab@morrisongeo.com.au Fax: 3279 0955

Engineers: D.Riley, J. Daly
 D.Dragun, & S.Wynne
 Geologists: L.Bexley & R.Howchin
 Laboratory: M.Morrison

LEGEND

- ▼ R.L 77.0 - 78.99
- ▼ R.L 79.0 - 80.99
- ▼ R.L 81.0 - 82.99
- ▼ R.L 83.0 - 84.99
- ▼ R.L 85.0 - 86.99
- Final Level

Map Description :	EARTHWORKS FIELD DENSITY TESTING - Level 1 Inspection		
Client :	CCA WINSLOW		
Project :	EDENS CROSSING, FUTURE STAGES 15-20		
Project No :	DL17/398	Drawing No :	DL17/398 - 01
		Scale :	Not to Scale

Brisbane Office
Job Number: DL20/027
Ref No: 16178
Author: R. Mitchell

22nd April 2020

Shadforths Civil Pty Ltd
99 Sandalwood Lane
Forest Glen 4556

ATTENTION: MR MICHAEL PRITCHARD
Email: Michael.Pritchard@shadcivil.com.au

Dear Sir,

**RE: LOT 1095
LEVEL ONE COMPLIANCE REPORT FOR
EARTHWORKS FILL CONSTRUCTION
EDENS CROSSING STAGE 21**

Earthworks filling operations were carried out on Lot 1095 at the above Development to form a working platform to support a future residential building.

Earthworks were constructed by CCA Winslow (The Client) between May 2017 and March 2018 and Shadforths Civil (The Client) between January 2020 and March 2020.

This report should be read in conjunction with Morrison Geotechnic Report “16058 – DL20/027 Shadforths – Level One Compliance Report – Eden’s Crossing Stage 21” Dated 21st April 2020. The Brief from the Client for was limited to:

- Level One Inspection of the placement and compaction of fill materials in accordance with AS3798 2007 – “Guidelines on Earthworks for Commercial and Residential Developments”
- Relative Density Control Testing in accordance with AS1289 – Testing of Soils for Engineering Purposes and at frequencies required in AS3798 Table 8.
- Ipswich City Council Specifications.
- Notes on KN Group Pty Ltd Civil Drawings.

Level One Inspections and Testing was carried out on the stripped ground surfaces and during the placement and compaction of fill materials. Field and laboratory testing included proof roll testing of the stripped surface and compaction testing.

Compaction testing at the Eden’s Crossing Stage 21 Development was carried out at a frequency of 1 test per 500m³ of placed and compacted fill as defined in AS3798 Table 8.1. Test locations were selected using Random Stratified methods. Compaction testing was carried out at frequencies representative of the fill volume as a mass. On this basis, compaction testing was not required on each individual Lot.

A marked-up site plan shown the location of compaction testing is attached.

Fill constructed on Lot 1095 has been observed to be placed and compacted in accordance with the Brief. The fill on Lot 1095 can be termed as "Controlled Fill" in accordance with AS 2870-2011 "Residential Slabs and Footings".

This statement does not include any topsoil, which may have been placed for use as Lot dressing or any other subsequent earthworks after March 2020.

If there are any queries concerning the above please do not hesitate to contact this office, or alternatively send to my email at mickmorrison@morrisongeo.com.au.

Yours faithfully,


A handwritten signature in grey ink, appearing to read 'Rhys Mitchell', with a long horizontal flourish extending to the right.

RHYS MITCHELL

For and on Behalf of

MORRISON GEOTECHNIC PTY LIMITED

Encl: Marked Up Site Pan

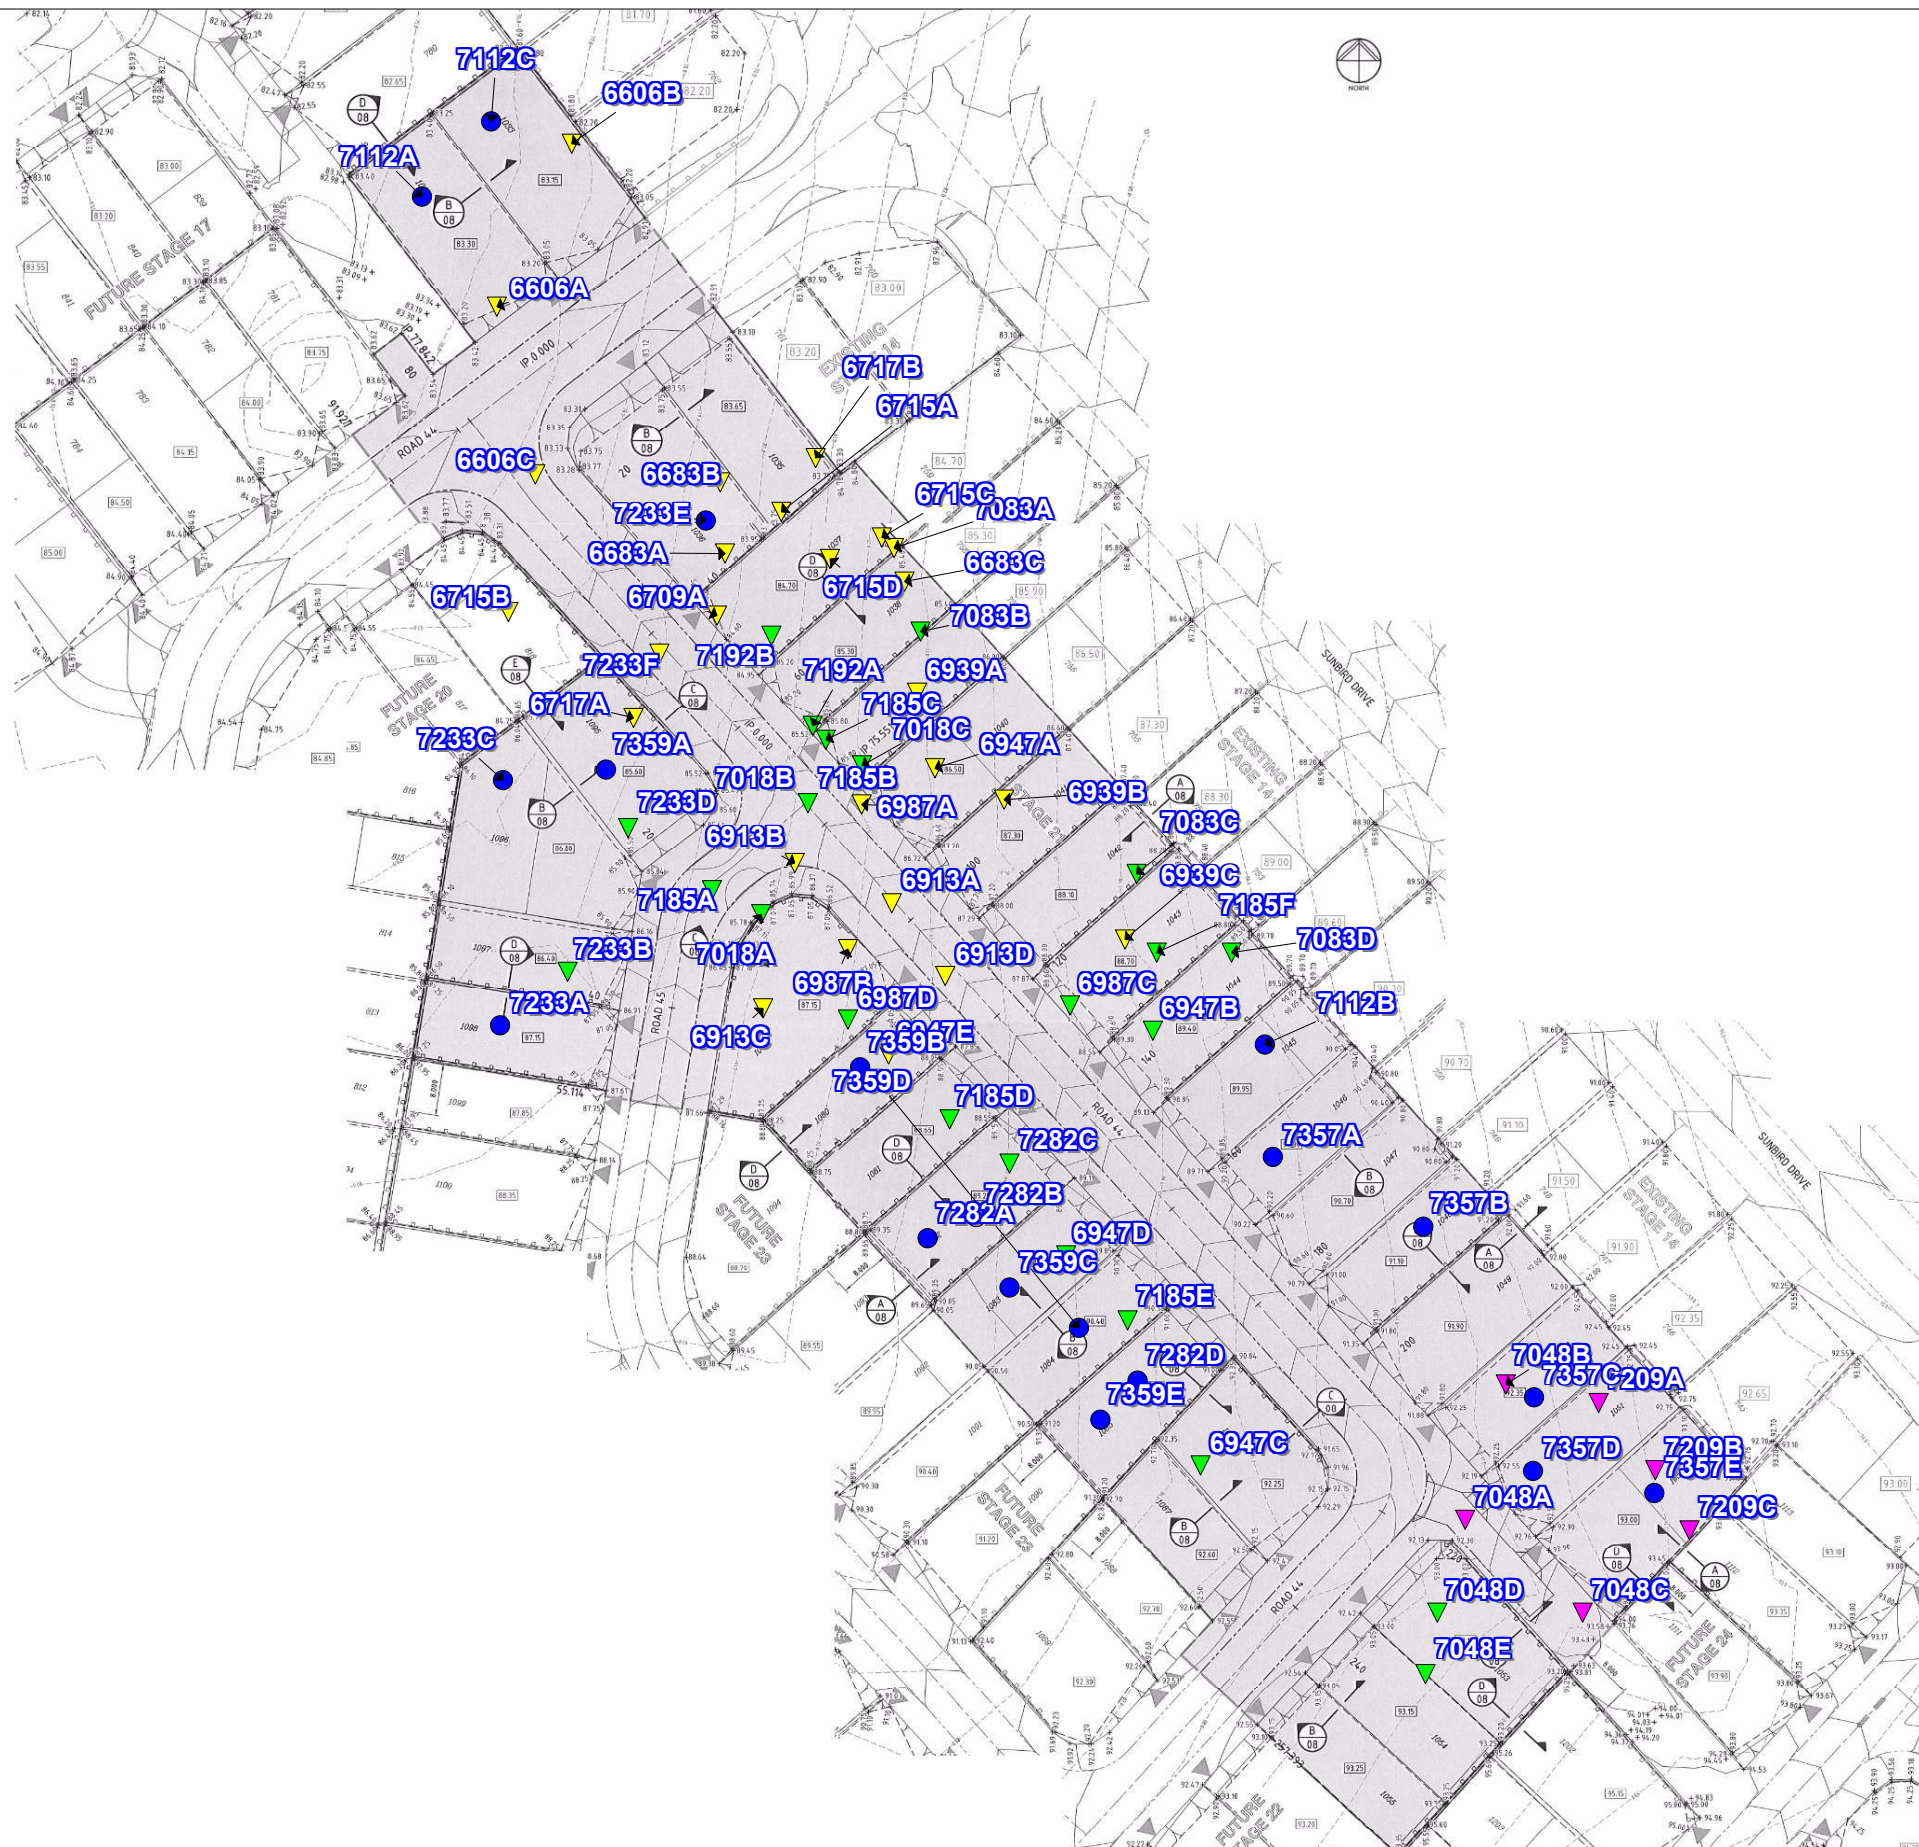

MORRISON GEOTECHNIC PTY LTD

ABN: 51 009 878 899

Unit 1/ 35 Limestone St, Darra 4076 Ph: 3279 0900
 Email: brisbanelab@morrisongeo.com.au

Engineers: M. Ballard
 D. Dragun
 Geologists: R. Howchin
 Laboratory: M. Morrison

LEGEND

- ▲ R.L 80.0 - 84.99
- ▲ R.L 85.0 - 89.99
- ▲ R.L 90.0 - 94.99
- Final Level

Map Description :	EARTHWORKS FIELD DENSITY TESTING - Level 1 Inspection		
Client :	SHADFORTHS PTY LTD		
Project :	EDENS CROSSING - STAGE 21		
Project No :	DL20/027	Drawing No :	DL20/027 - 01
Scale :	Not to Scale		



MORRISON GEOTECHNIC PTY LTD

ABN: 51 009 878 899

Unit 1/ 35 Limestone St, Darra 4076 Ph: 3279 0900
 Email: brisbanelab@morrisongeo.com.au Fax: 3279 0955

Engineers: D.Riley, J. Daly
 D.Dragun, & S.Wynne
 Geologists: L.Bexley & R.Howchin
 Laboratory: M.Morrison

LEGEND

- ▼ R.L 77.0 - 78.99
- ▼ R.L 79.0 - 80.99
- ▼ R.L 81.0 - 82.99
- ▼ R.L 83.0 - 84.99
- Final Level

Map Description :	EARTHWORKS FIELD DENSITY TESTING - Level 1 Inspection		
Client :	CCA WINSLOW		
Project :	EDENS CROSSING, FUTURE STAGES 15-20		
Project No :	DL17/398	Drawing No :	DL17/398 - 01
		Scale :	Not to Scale

Brisbane Office
Job Number: DL20/027
Ref No: 16179
Author: R. Mitchell

22nd April 2020

Shadforths Civil Pty Ltd
99 Sandalwood Lane
Forest Glen 4556

ATTENTION: MR MICHAEL PRITCHARD
Email: Michael.Pritchard@shadcivil.com.au

Dear Sir,

**RE: LOT 1096
LEVEL ONE COMPLIANCE REPORT FOR
EARTHWORKS FILL CONSTRUCTION
EDENS CROSSING STAGE 21**

Earthworks filling operations were carried out on Lot 1096 at the above Development to form a working platform to support a future residential building.

Earthworks were constructed by CCA Winslow (The Client) between May 2017 and March 2018 and Shadforths Civil (The Client) between January 2020 and March 2020.

This report should be read in conjunction with Morrison Geotechnic Report “16058 – DL20/027 Shadforths – Level One Compliance Report – Eden’s Crossing Stage 21” Dated 21st April 2020. The Brief from the Client for was limited to:

- Level One Inspection of the placement and compaction of fill materials in accordance with AS3798 2007 – “Guidelines on Earthworks for Commercial and Residential Developments”
- Relative Density Control Testing in accordance with AS1289 – Testing of Soils for Engineering Purposes and at frequencies required in AS3798 Table 8.
- Ipswich City Council Specifications.
- Notes on KN Group Pty Ltd Civil Drawings.

Level One Inspections and Testing was carried out on the stripped ground surfaces and during the placement and compaction of fill materials. Field and laboratory testing included proof roll testing of the stripped surface and compaction testing.

Compaction testing at the Eden’s Crossing Stage 21 Development was carried out at a frequency of 1 test per 500m³ of placed and compacted fill as defined in AS3798 Table 8.1. Test locations were selected using Random Stratified methods. Compaction testing was carried out at frequencies representative of the fill volume as a mass. On this basis, compaction testing was not required on each individual Lot.

A marked-up site plan shown the location of compaction testing is attached.

Fill constructed on Lot 1096 has been observed to be placed and compacted in accordance with the Brief. The fill on Lot 1096 can be termed as "Controlled Fill" in accordance with AS 2870-2011 "Residential Slabs and Footings".

This statement does not include any topsoil, which may have been placed for use as Lot dressing or any other subsequent earthworks after March 2020.

If there are any queries concerning the above please do not hesitate to contact this office, or alternatively send to my email at mickmorrison@morrisongeo.com.au.

Yours faithfully,


A handwritten signature in grey ink, appearing to read 'Rhys Mitchell', with a long horizontal flourish extending to the right.

RHYS MITCHELL

For and on Behalf of

MORRISON GEOTECHNIC PTY LIMITED

Encl: Marked Up Site Pan

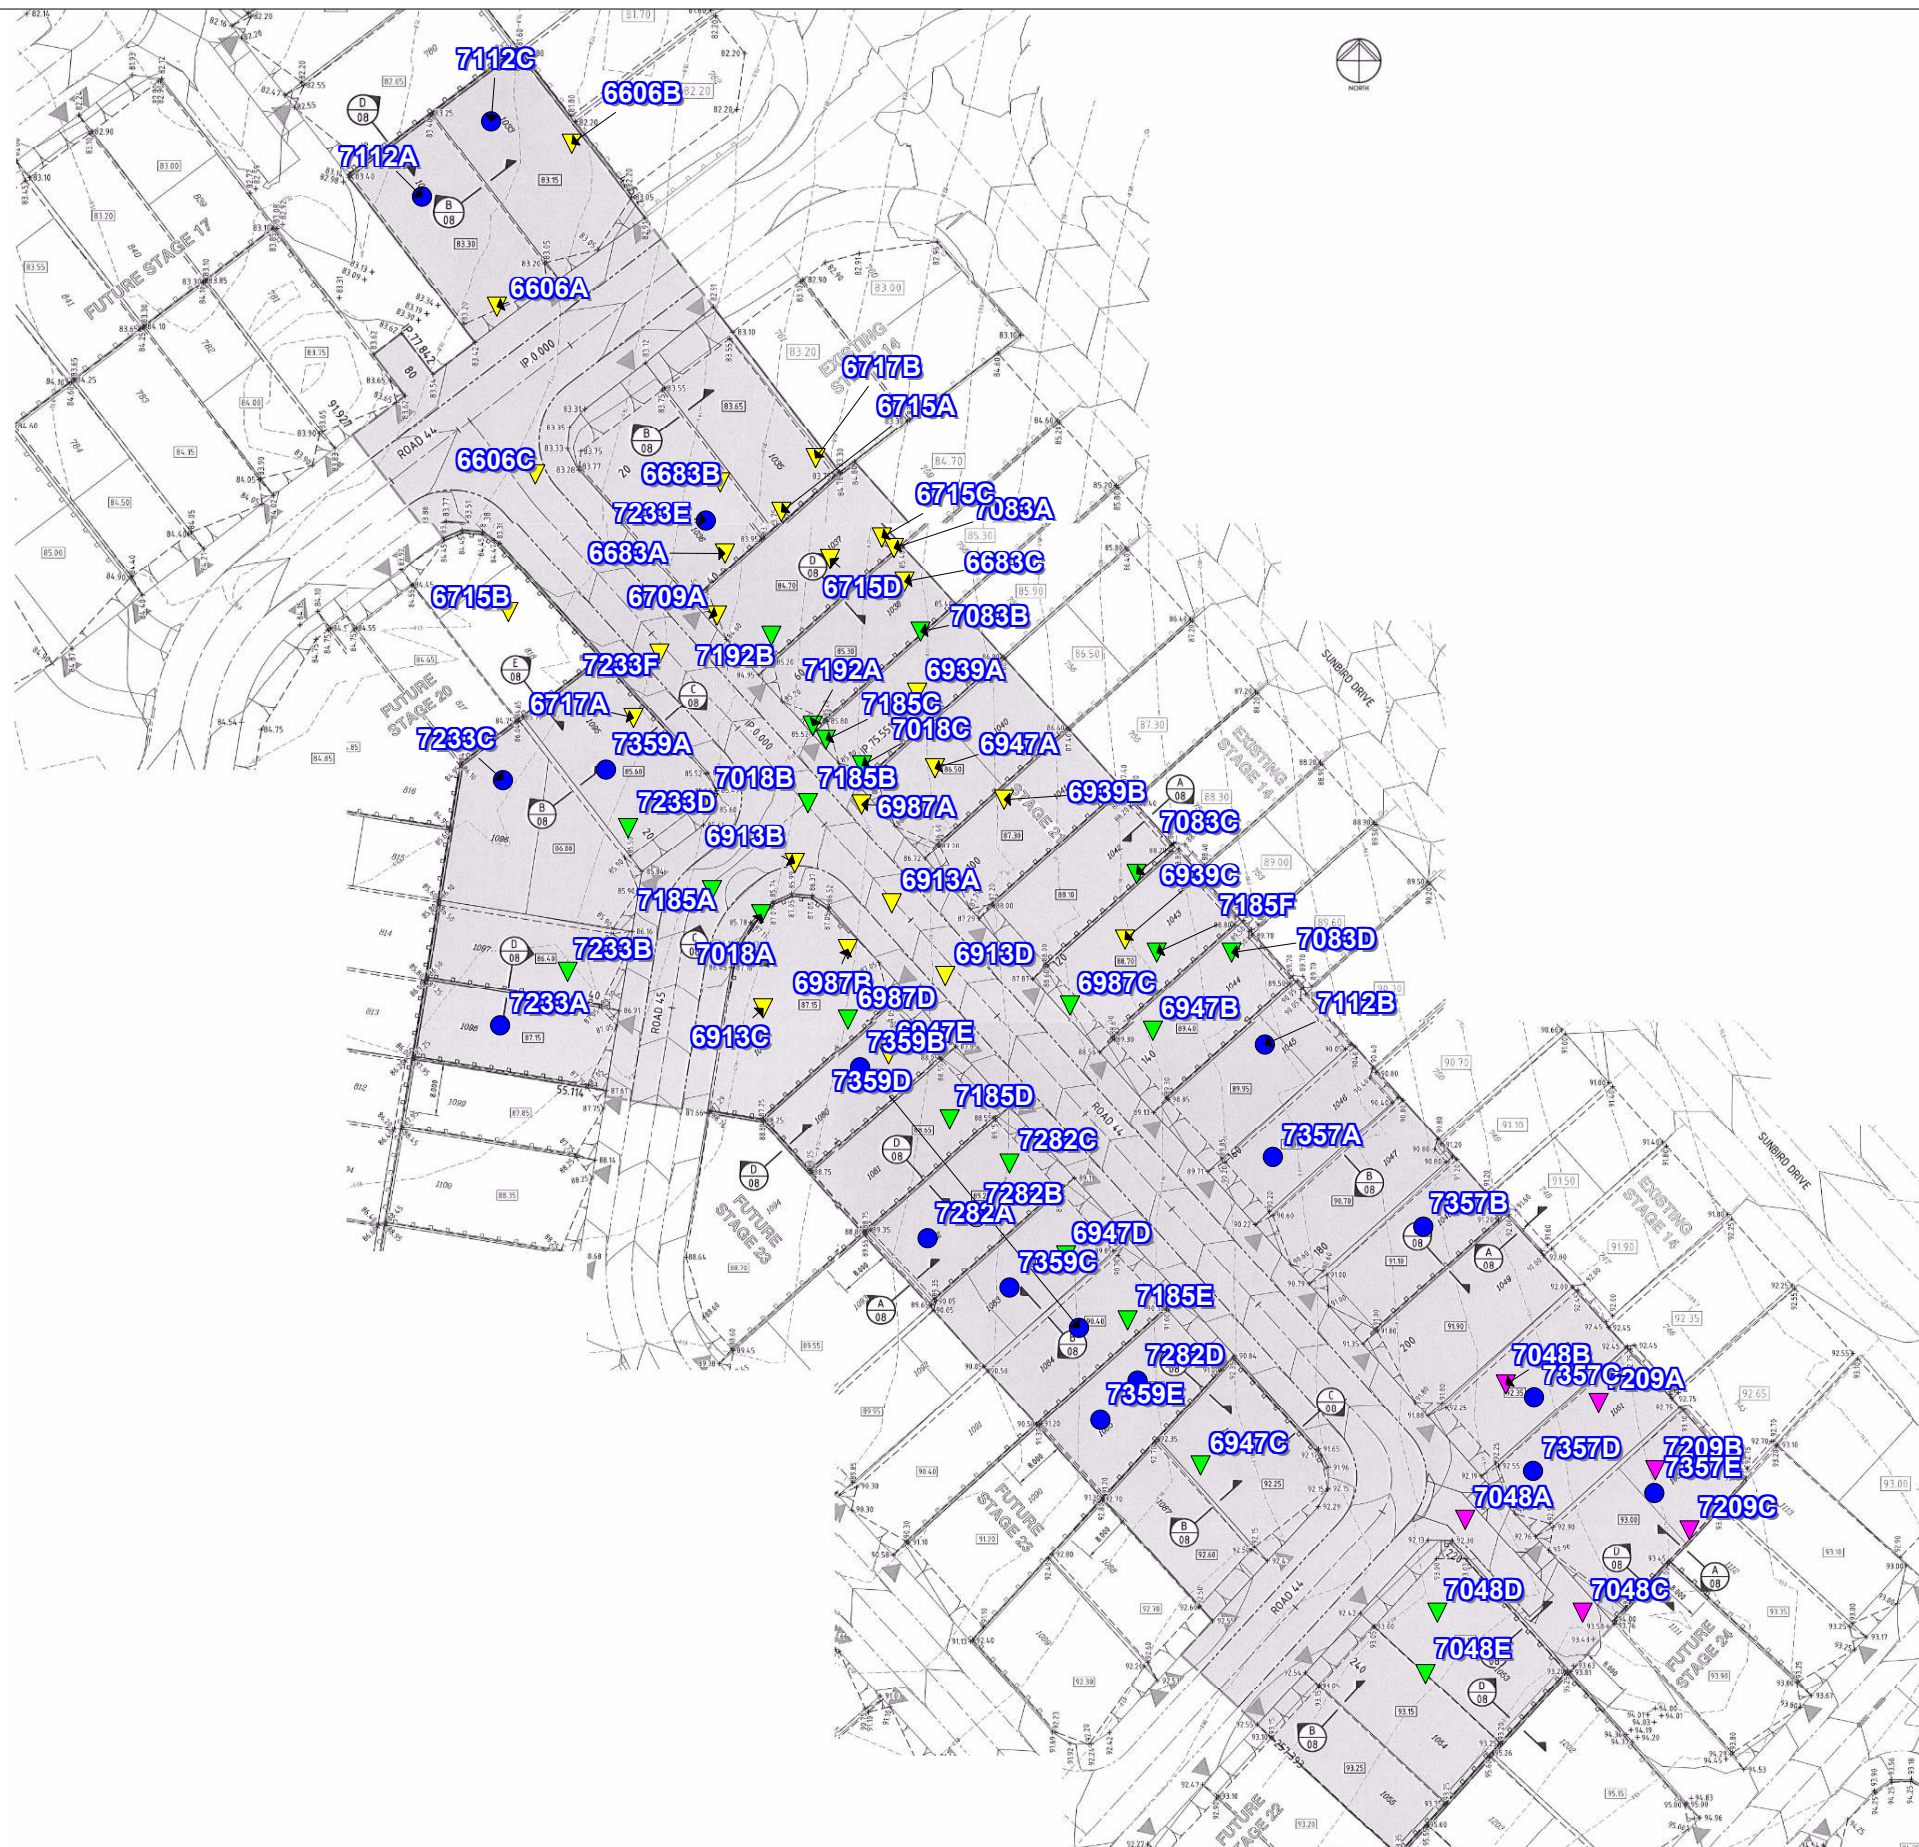

MORRISON GEOTECHNIC PTY LTD

ABN: 51 009 878 899

Unit 1/ 35 Limestone St, Darra 4076 Ph: 3279 0900
 Email: brisbanelab@morrisongeo.com.au

Engineers: M. Ballard
 D. Dragun
 Geologists: R. Howchin
 Laboratory: M. Morrison

LEGEND

- ▲ R.L 80.0 - 84.99
- ▲ R.L 85.0 - 89.99
- ▲ R.L 90.0 - 94.99
- Final Level

Map Description :	EARTHWORKS FIELD DENSITY TESTING - Level 1 Inspection		
Client :	SHADFORTHS PTY LTD		
Project :	EDENS CROSSING - STAGE 21		
Project No :	DL20/027	Drawing No :	DL20/027 - 01
		Scale :	Not to Scale



MORRISON GEOTECHNIC PTY LTD

ABN: 51 009 878 899

Unit 1/ 35 Limestone St, Darra 4076 Ph: 3279 0900
 Email: brisbanelab@morrisongeo.com.au Fax: 3279 0955

Engineers: D.Riley, J. Daly
 D.Dragun, & S.Wynne
 Geologists: L.Bexley & R.Howchin
 Laboratory: M.Morrison

LEGEND

- ▼ R.L 77.0 - 78.99
- ▼ R.L 79.0 - 80.99
- ▼ R.L 81.0 - 82.99
- ▼ R.L 83.0 - 84.99
- ▼ R.L 85.0 - 86.99
- Final Level

Map Description :	EARTHWORKS FIELD DENSITY TESTING - Level 1 Inspection		
Client :	CCA WINSLOW		
Project :	EDENS CROSSING, FUTURE STAGES 15-20		
Project No :	DL17/398	Drawing No :	DL17/398 - 01
		Scale :	Not to Scale

Brisbane Office
Job Number: DL20/027
Ref No: 16180
Author: R. Mitchell

22nd April 2020

Shadforths Civil Pty Ltd
99 Sandalwood Lane
Forest Glen 4556

ATTENTION: MR MICHAEL PRITCHARD
Email: Michael.Pritchard@shadcivil.com.au

Dear Sir,

**RE: LOT 1097
LEVEL ONE COMPLIANCE REPORT FOR
EARTHWORKS FILL CONSTRUCTION
EDENS CROSSING STAGE 21**

Earthworks filling operations were carried out on Lot 1097 at the above Development to form a working platform to support a future residential building.

Earthworks were constructed by CCA Winslow (The Client) between May 2017 and March 2018 and Shadforths Civil (The Client) between January 2020 and March 2020.

This report should be read in conjunction with Morrison Geotechnic Report “16058 – DL20/027 Shadforths – Level One Compliance Report – Eden’s Crossing Stage 21” Dated 21st April 2020. The Brief from the Client for was limited to:

- Level One Inspection of the placement and compaction of fill materials in accordance with AS3798 2007 – “Guidelines on Earthworks for Commercial and Residential Developments”
- Relative Density Control Testing in accordance with AS1289 – Testing of Soils for Engineering Purposes and at frequencies required in AS3798 Table 8.
- Ipswich City Council Specifications.
- Notes on KN Group Pty Ltd Civil Drawings.

Level One Inspections and Testing was carried out on the stripped ground surfaces and during the placement and compaction of fill materials. Field and laboratory testing included proof roll testing of the stripped surface and compaction testing.

Compaction testing at the Eden’s Crossing Stage 21 Development was carried out at a frequency of 1 test per 500m³ of placed and compacted fill as defined in AS3798 Table 8.1. Test locations were selected using Random Stratified methods. Compaction testing was carried out at frequencies representative of the fill volume as a mass. On this basis, compaction testing was not required on each individual Lot.

A marked-up site plan shown the location of compaction testing is attached.

Fill constructed on Lot 1097 has been observed to be placed and compacted in accordance with the Brief. The fill on Lot 1097 can be termed as "Controlled Fill" in accordance with AS 2870-2011 "Residential Slabs and Footings".

This statement does not include any topsoil, which may have been placed for use as Lot dressing or any other subsequent earthworks after March 2020.

If there are any queries concerning the above please do not hesitate to contact this office, or alternatively send to my email at mickmorrison@morrisongeo.com.au.

Yours faithfully,




RHYS MITCHELL

For and on Behalf of

MORRISON GEOTECHNIC PTY LIMITED

Encl: Marked Up Site Pan

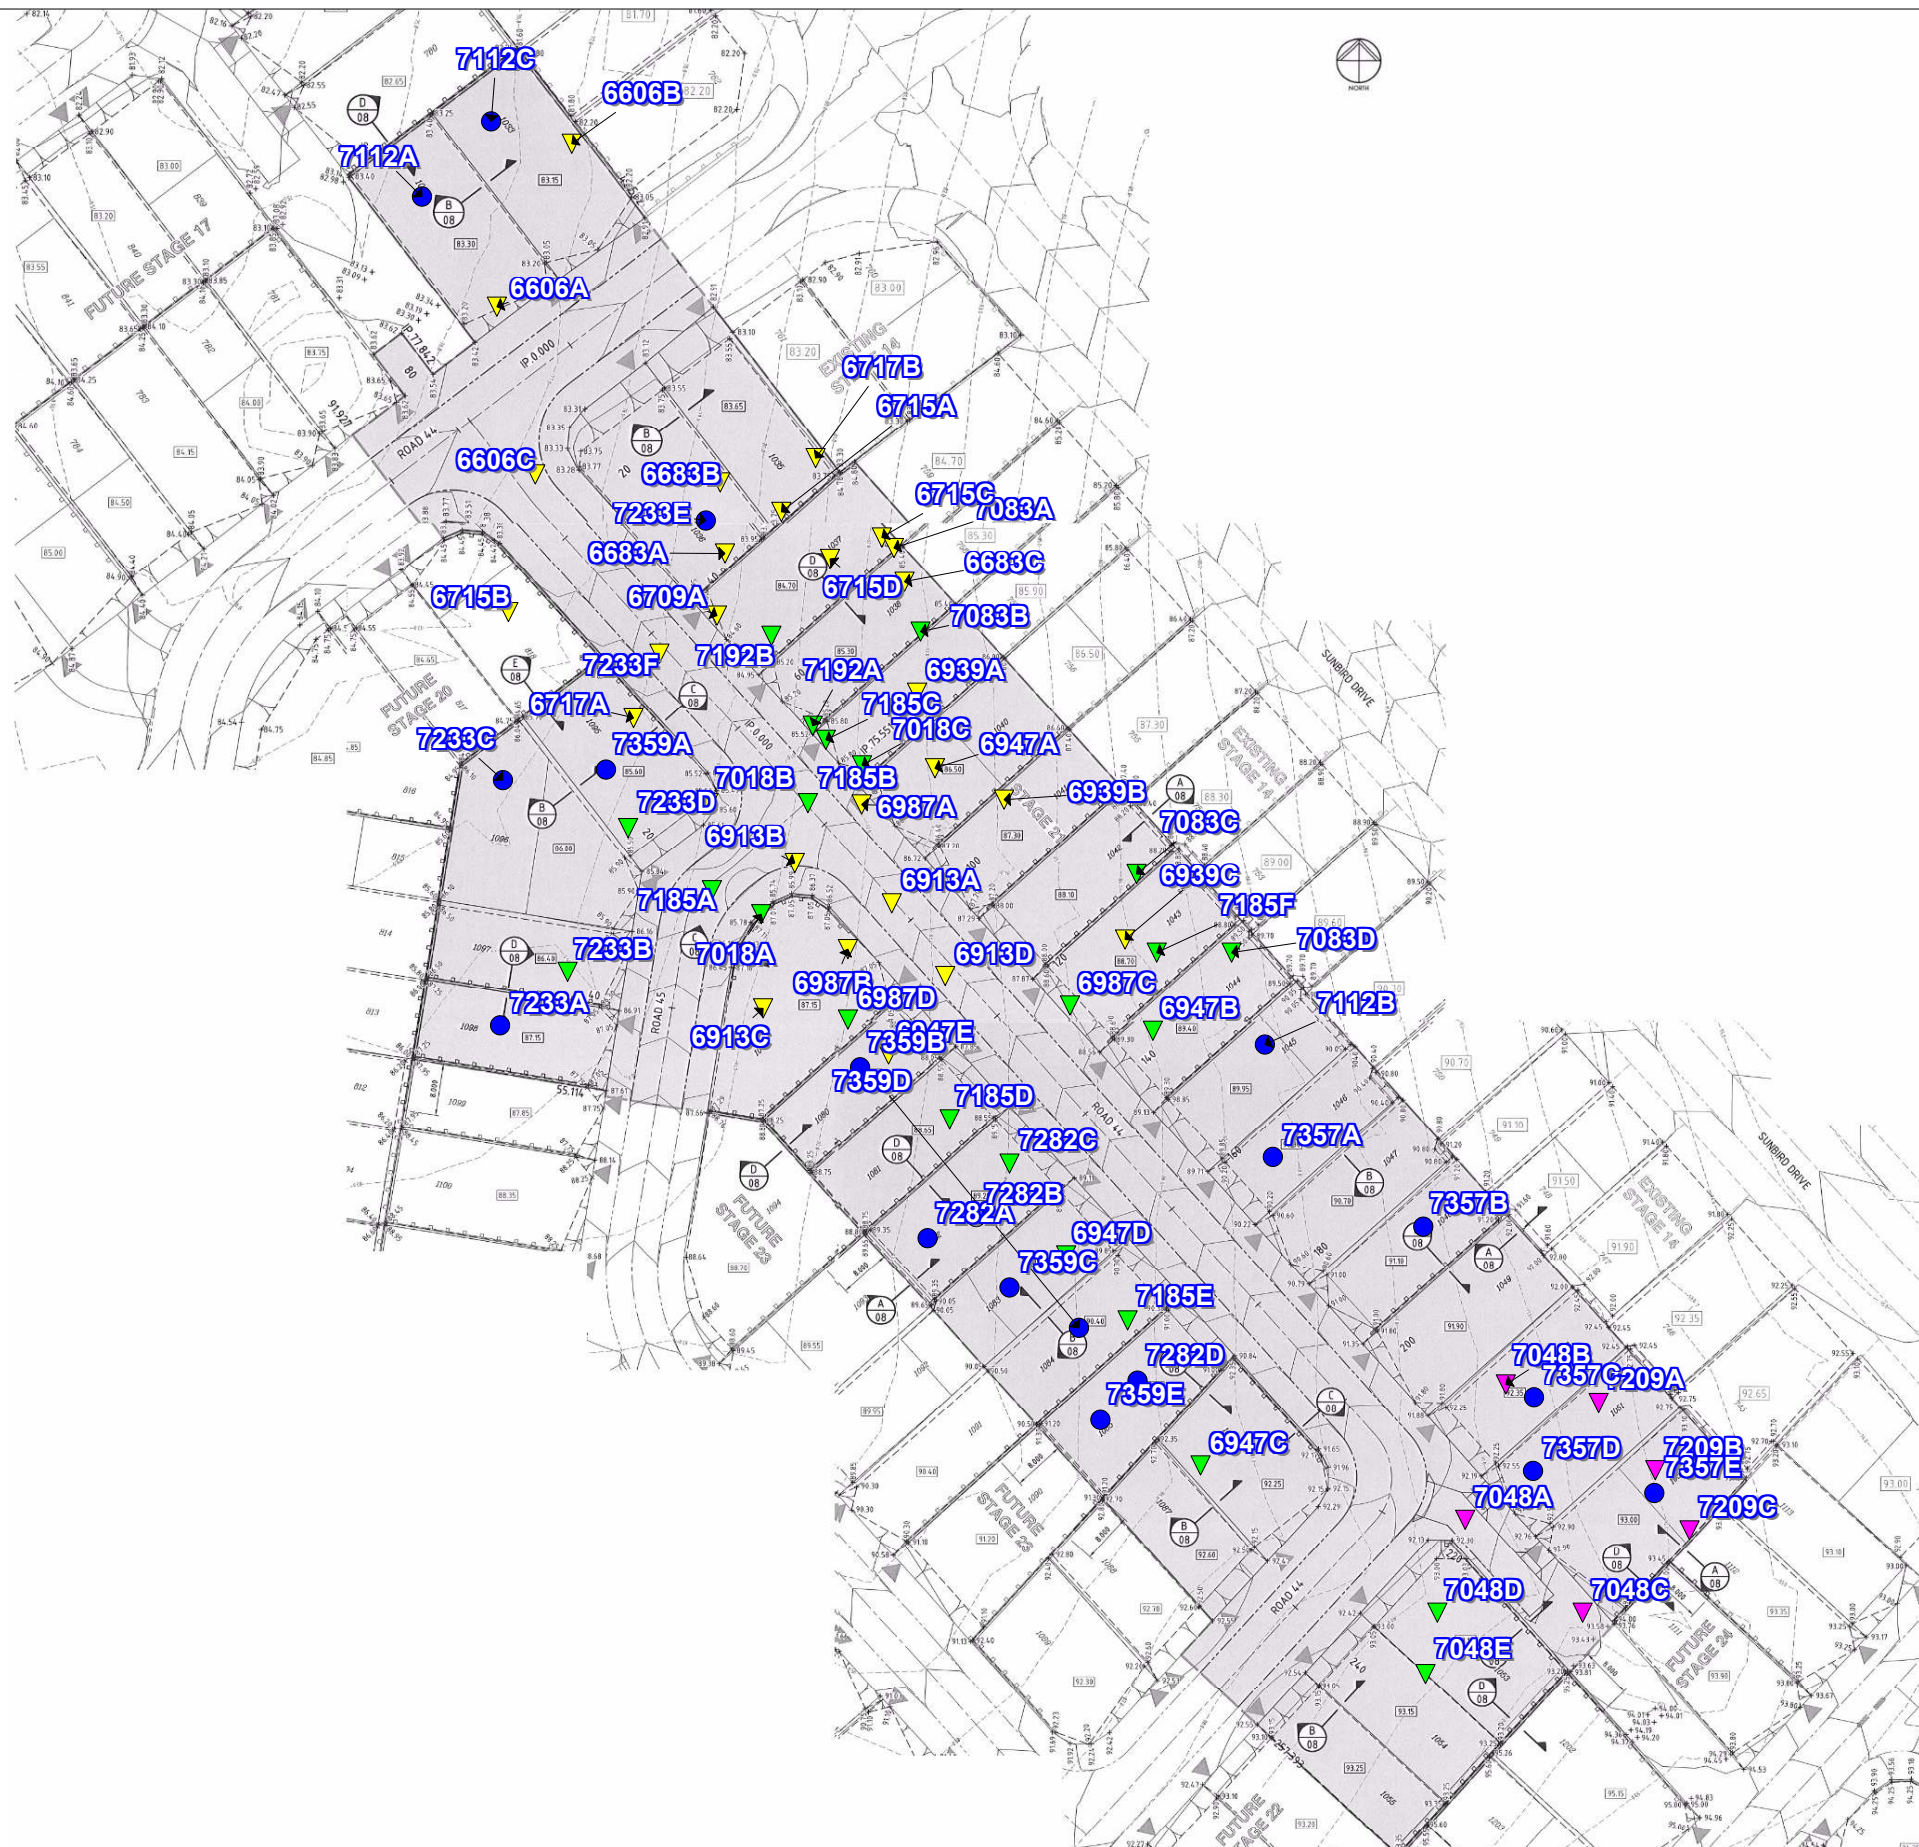

MORRISON GEOTECHNIC PTY LTD

ABN: 51 009 878 899

Unit 1/ 35 Limestone St, Darra 4076 Ph: 3279 0900
 Email: brisbanelab@morrisongeo.com.au

Engineers: M. Ballard
 D. Dragun
 Geologists: R. Howchin
 Laboratory: M. Morrison

LEGEND

- ▼ R.L 80.0 - 84.99
- ▼ R.L 85.0 - 89.99
- ▼ R.L 90.0 - 94.99
- Final Level

Map Description :	EARTHWORKS FIELD DENSITY TESTING - Level 1 Inspection		
Client :	SHADFORTHS PTY LTD		
Project :	EDENS CROSSING - STAGE 21		
Project No :	DL20/027	Drawing No :	DL20/027 - 01
		Scale :	Not to Scale



MORRISON GEOTECHNIC PTY LTD

ABN: 51 009 878 899

Unit 1/ 35 Limestone St, Darra 4076 Ph: 3279 0900
 Email: brisbanelab@morrisongeo.com.au Fax: 3279 0955

Engineers: D.Riley, J. Daly
 D.Dragun, & S.Wynne
 Geologists: L.Bexley & R.Howchin
 Laboratory: M.Morrison

LEGEND

- ▼ R.L 77.0 - 78.99
- ▼ R.L 79.0 - 80.99
- ▼ R.L 81.0 - 82.99
- ▼ R.L 83.0 - 84.99
- ▼ R.L 85.0 - 86.99
- Final Level

Map Description :	EARTHWORKS FIELD DENSITY TESTING - Level 1 Inspection		
Client :	CCA WINSLOW		
Project :	EDENS CROSSING, FUTURE STAGES 15-20		
Project No :	DL17/398	Drawing No :	DL17/398 - 01
		Scale :	Not to Scale

Brisbane Office
Job Number: DL20/027
Ref No: 16181
Author: R. Mitchell

22nd April 2020

Shadforths Civil Pty Ltd
99 Sandalwood Lane
Forest Glen 4556

ATTENTION: MR MICHAEL PRITCHARD
Email: Michael.Pritchard@shadcivil.com.au

Dear Sir,

**RE: LOT 1098
LEVEL ONE COMPLIANCE REPORT FOR
EARTHWORKS FILL CONSTRUCTION
EDENS CROSSING STAGE 21**

Earthworks filling operations were carried out on Lot 1098 at the above Development to form a working platform to support a future residential building.

Earthworks were constructed by CCA Winslow (The Client) between May 2017 and March 2018 and Shadforths Civil (The Client) between January 2020 and March 2020.

This report should be read in conjunction with Morrison Geotechnic Report “16058 – DL20/027 Shadforths – Level One Compliance Report – Eden’s Crossing Stage 21” Dated 21st April 2020. The Brief from the Client for was limited to:

- Level One Inspection of the placement and compaction of fill materials in accordance with AS3798 2007 – “Guidelines on Earthworks for Commercial and Residential Developments”
- Relative Density Control Testing in accordance with AS1289 – Testing of Soils for Engineering Purposes and at frequencies required in AS3798 Table 8.
- Ipswich City Council Specifications.
- Notes on KN Group Pty Ltd Civil Drawings.

Level One Inspections and Testing was carried out on the stripped ground surfaces and during the placement and compaction of fill materials. Field and laboratory testing included proof roll testing of the stripped surface and compaction testing.

Compaction testing at the Eden’s Crossing Stage 21 Development was carried out at a frequency of 1 test per 500m³ of placed and compacted fill as defined in AS3798 Table 8.1. Test locations were selected using Random Stratified methods. Compaction testing was carried out at frequencies representative of the fill volume as a mass. On this basis, compaction testing was not required on each individual Lot.

A marked-up site plan shown the location of compaction testing is attached.

Fill constructed on Lot 1098 has been observed to be placed and compacted in accordance with the Brief. The fill on Lot 1098 can be termed as "Controlled Fill" in accordance with AS 2870-2011 "Residential Slabs and Footings".

This statement does not include any topsoil, which may have been placed for use as Lot dressing or any other subsequent earthworks after March 2020.

If there are any queries concerning the above please do not hesitate to contact this office, or alternatively send to my email at mickmorrison@morrisongeo.com.au.

Yours faithfully,


A handwritten signature in grey ink, appearing to read 'Rhys Mitchell', with a horizontal line extending to the right.

RHYS MITCHELL

For and on Behalf of

MORRISON GEOTECHNIC PTY LIMITED

Encl: Marked Up Site Pan

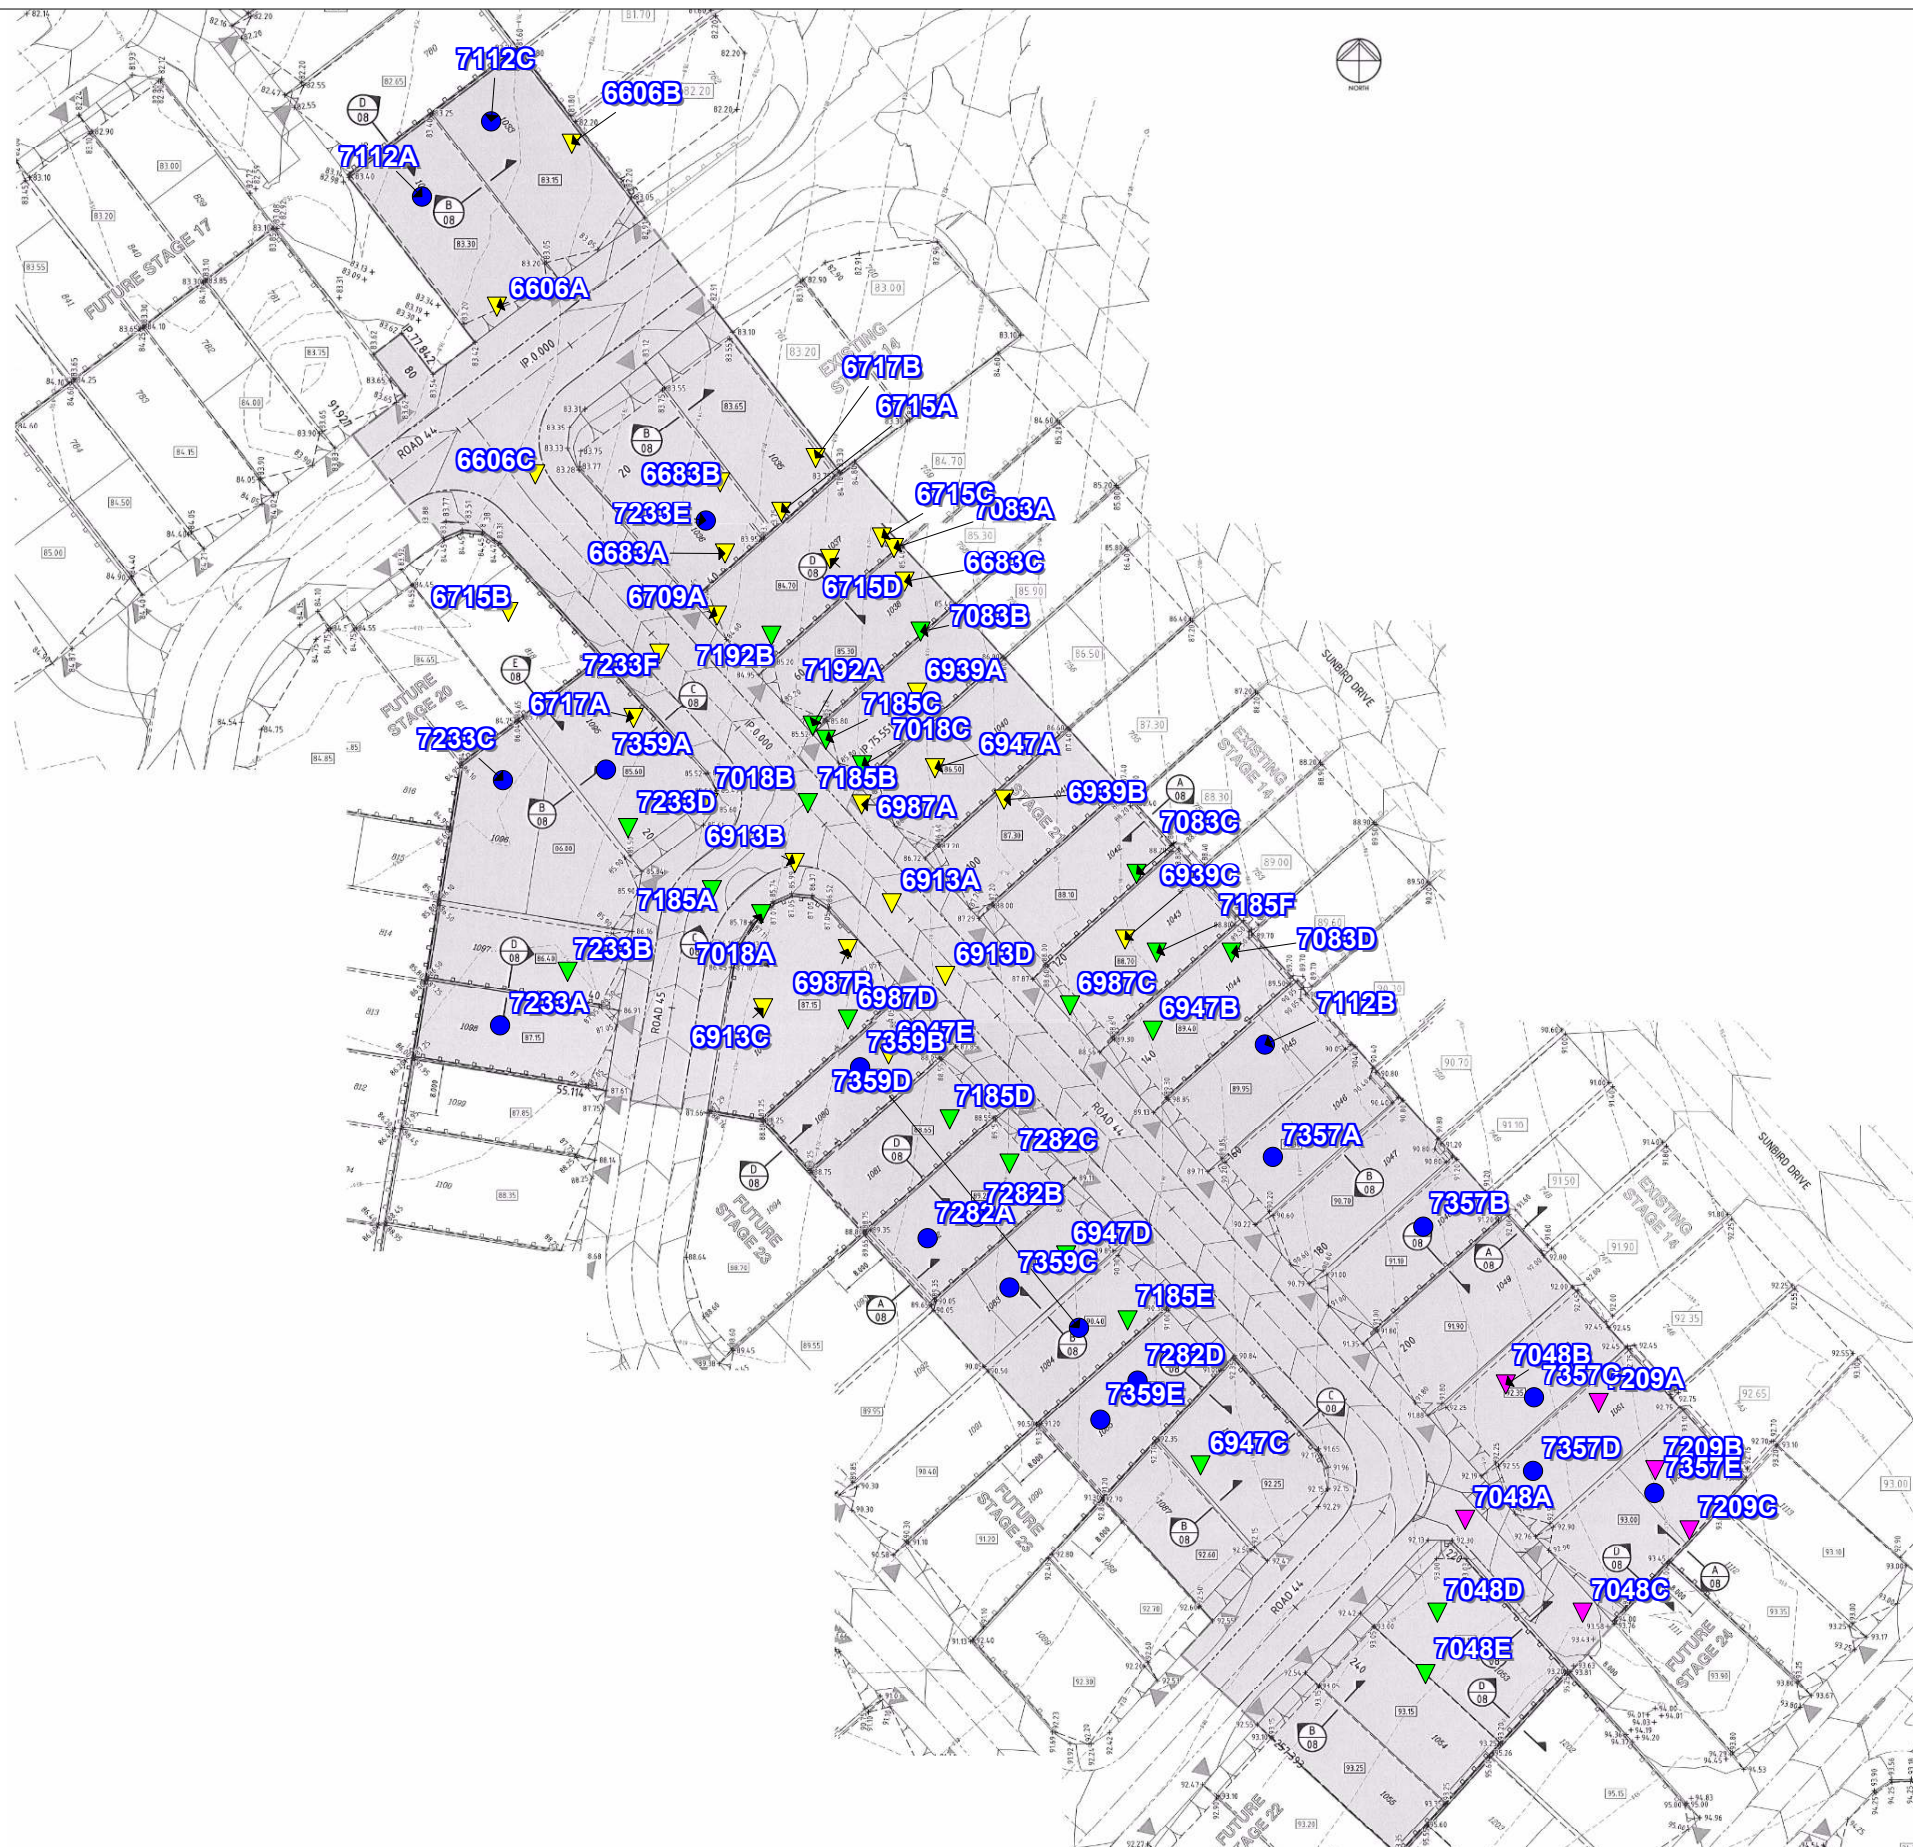

MORRISON GEOTECHNIC PTY LTD

ABN: 51 009 878 899

Unit 1/ 35 Limestone St, Darra 4076 Ph: 3279 0900
 Email: brisbanelab@morrisongeo.com.au

Engineers: M. Ballard
 D. Dragun
 Geologists: R. Howchin
 Laboratory: M. Morrison

LEGEND

- ▲ R.L 80.0 - 84.99
- ▲ R.L 85.0 - 89.99
- ▲ R.L 90.0 - 94.99
- Final Level

Map Description :	EARTHWORKS FIELD DENSITY TESTING - Level 1 Inspection		
Client :	SHADFORTHS PTY LTD		
Project :	EDENS CROSSING - STAGE 21		
Project No :	DL20/027	Drawing No :	DL20/027 - 01
Scale :	Not to Scale		



MORRISON GEOTECHNIC PTY LTD

ABN: 51 009 878 899

Unit 1/ 35 Limestone St, Darra 4076 Ph: 3279 0900
 Email: brisbanelab@morrisongeo.com.au Fax: 3279 0955

Engineers: D.Riley, J. Daly
 D.Dragun, & S.Wynne
 Geologists: L.Bexley & R.Howchin
 Laboratory: M.Morrison

LEGEND

- ▼ R.L 77.0 - 78.99
- ▼ R.L 79.0 - 80.99
- ▼ R.L 81.0 - 82.99
- ▼ R.L 83.0 - 84.99
- Final Level

Map Description :	EARTHWORKS FIELD DENSITY TESTING - Level 1 Inspection		
Client :	CCA WINSLOW		
Project :	EDENS CROSSING, FUTURE STAGES 15-20		
Project No :	DL17/398	Drawing No :	DL17/398 - 01
		Scale :	Not to Scale