


SEE INSET

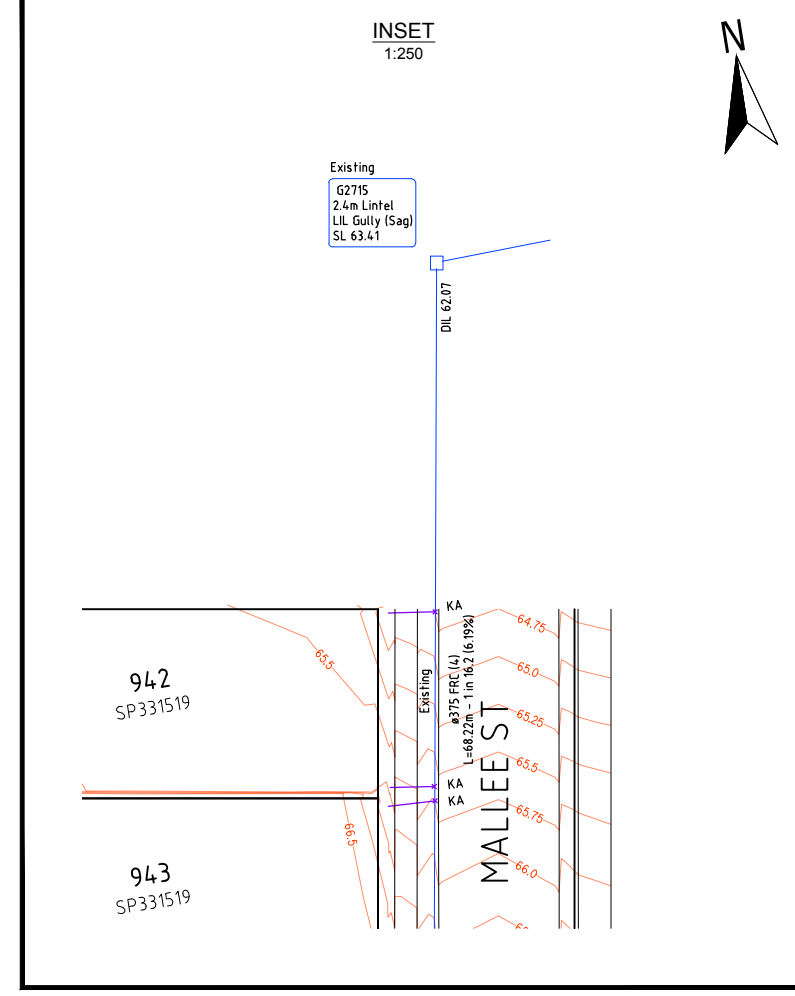

INSET
1:250

AS CONSTRUCTED CERTIFICATION
EDEN'S CROSSING - STAGE 29

I, _____ (Company's representative Name) _____ (Signature)
 _____ (Date) _____ (RPEQ)
 Being a duly representative of:- _____ (Company Name)

Hereby certify that
 1. The information contained in this drawing / document is in compliance with approved drawings and design supplied under the terms of the contract.
 2. This represents an accurate "As constructed" record of works carried out and accept responsibility for the information contained in this drawing / document.

REGISTERED SURVEYOR'S CERTIFICATION
EDEN'S CROSSING - STAGE 29

Saunders Havill Group Pty Ltd, Registered Surveyor, hereby certify that the vertical and horizontal locations and dimensions shown on this plan are a true and correct record and were located by survey.

M. Klein 4611 07/12/2023
 Authorised Signatory Reg. Surveyor No. Date

COORDINATE DATUM NOTE:
 HORIZONTAL COORDINATES (E.N) SUPPLIED ARE MAPPING GRID OF AUSTRALIA (MGA), ZONE 56 BASED ON THE UNIVERSAL TRANSVERSE MERCATOR PROJECTION AND THE GEOCENTRIC DATUM OF AUSTRALIA 2020.


ADAC Verification Plot

Project Name: Eden's Crossing - Stage 29
 Description: Subdivision
 Works Approval ID: 3534/2022/OW
 Receiver: Ipswich City Council
 Construction date: 2022-08-18
 Status: As Constructed

ADAC version: 5.0.1
 Horizontal coordinates: MGA zone 56 (GDA2020)
 Vertical datum: AHD derived
 Notes: Vertical Origin: PM203676, RL 74.071
 Surveyor: Saunders Havill Group (Reg ID 4611)
 Engineer: KN Group

Note: See ADAC xml file for full attribute information

AS CONSTRUCTED

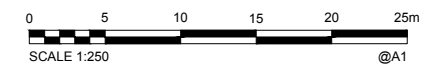

A1	INDEX	DATE	REVISIONS	DRAWN	CHECKED	PASSED
	A	07.12.2023	Original Issue			

DRAWN	PS	30/08/2023
CHECKED	AH	09/11/2023
PASSED		
INITIALS	DATE	


saunders havill group
 Brisbane Springfield
 head office 9 Thompson St Bowen Hills Q 4006
 phone 1300 423 SHG web www.saundershavill.com
 Drawing No: 9112 S 51 AC A

kn group
 400 35 102 03 011
 11, 62 Astor Terrace
 Ipswich QLD 4700
 07 3017 1900
 www.knigroup.com.au

City of Ipswich

IPSWICH CITY COUNCIL
 AS CONSTRUCTED - ROADS & DRAINAGE
 EDEN'S CROSSING - STAGE 29
 MALLEE STREET, REDBANK PLAINS

SCALE	1:250
SHEET	1 OF 1 SHEETS
DRAWING NO.	

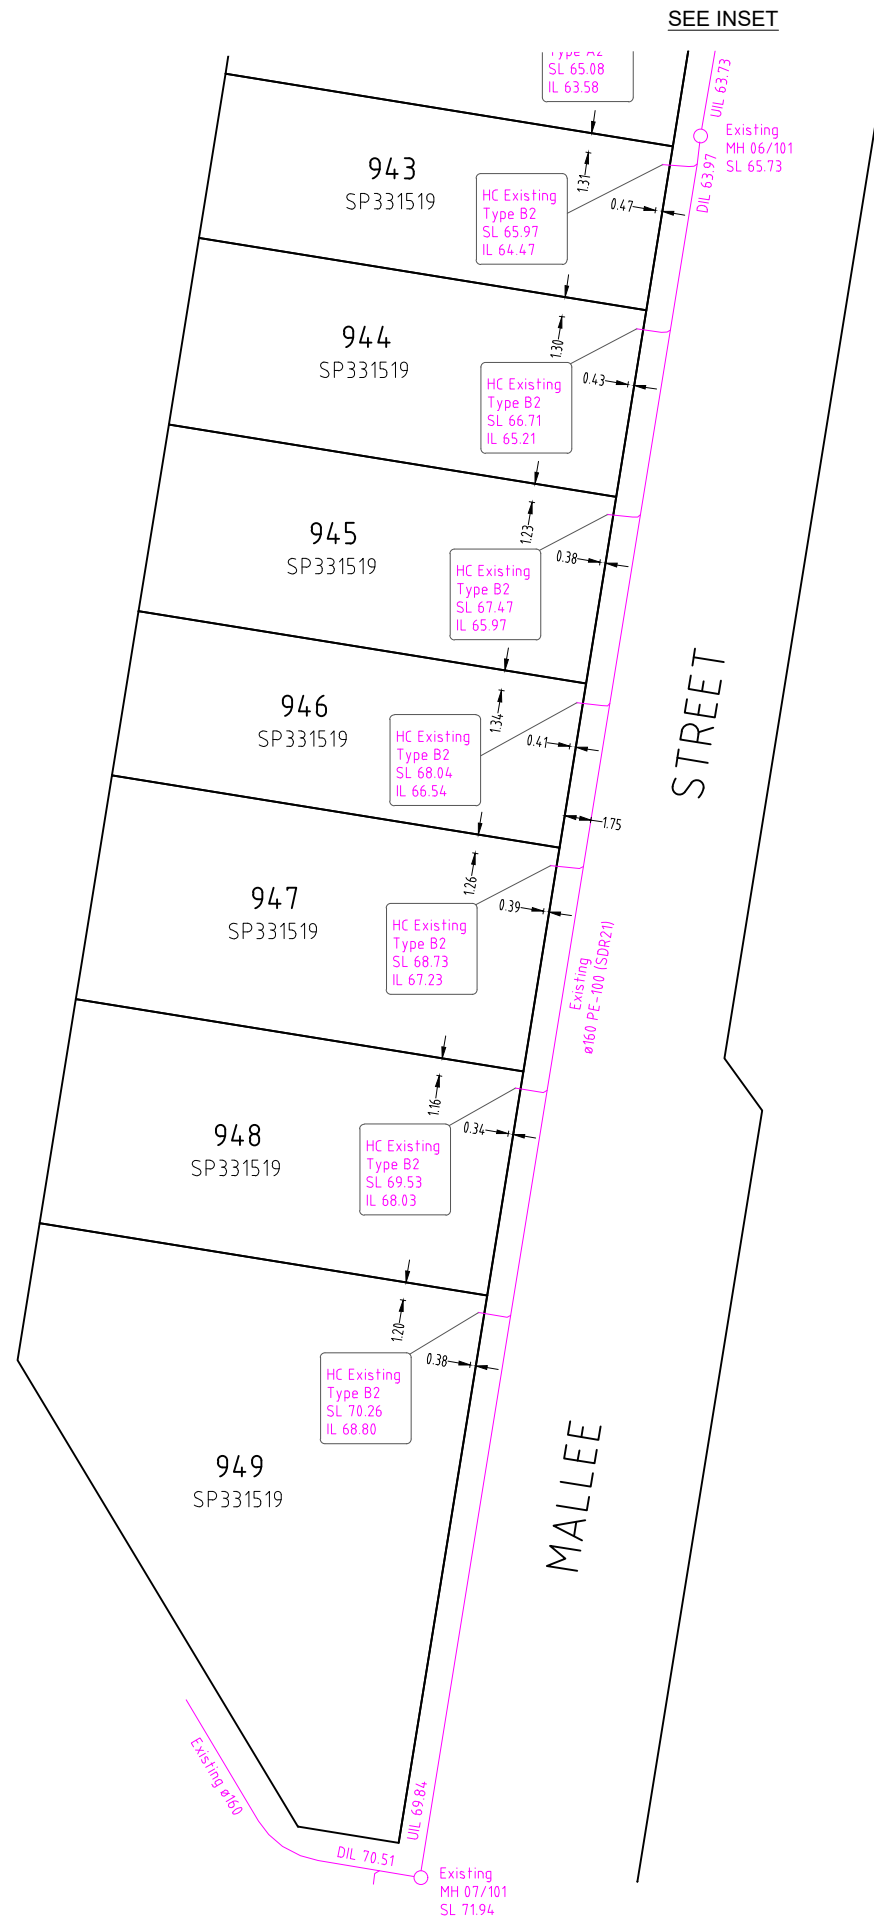

Plan of ADAC Survey Data


Project Name: Eden's Crossing Estate - Stage 29	ADAC version: 5.0.1
Description: Subdivision	Horizontal coordinates: MGA zone 56 (GDA2020)
Works Approval ID: 22-PNT-55208	Vertical datum: AHD derived
Receiver: Urban Utilities	Notes: Vertical Origin: PM203676, RL 74.071
Construction date: 2023-08-18	Surveyor: Saunders Havill Group (Reg ID 4611)
Status: As Constructed	Engineer: KN Group

Note: See ADAC xml file for full attribute information


REGISTERED SURVEYOR'S CERTIFICATION
EDEN'S CROSSING - STAGE 29

Saunders Havill Group Pty Ltd, Registered Surveyor, hereby certify that the vertical and horizontal locations and dimensions shown on this plan are a true and correct record and were located by survey.

M. Klein
Authorised Signatory Reg. Surveyor No. 4611 Date: 21-11-2023

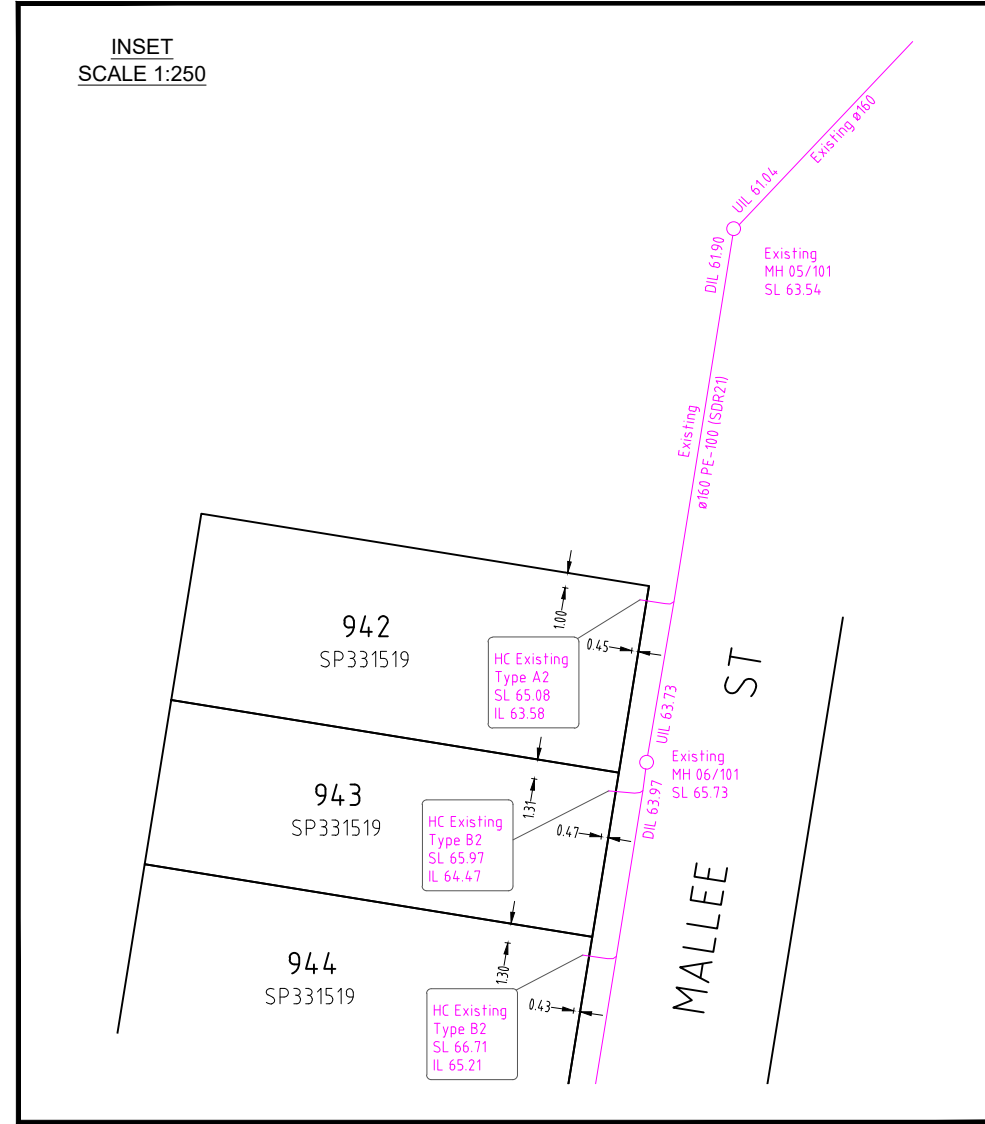

All house connections are $\phi 110$ unless otherwise noted.

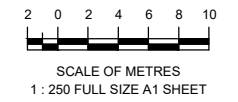

A1										
REV NO	DATE	REVISION PURPOSE / DESCRIPTION	DRAWN	RPEQ	RPEQ No	DRAWN	RPEQ	RPEQ No	INITIALS	DATE
A	21/11/2023	Original Issue								

SH saunders havill group	Saunders Havill Group Pty Ltd ABN 54 144 592 540 head office 9 Thompson St Bowen Hills Q 4006 phone 0900 629 5142 web www.saundershavill.com	
Drawing No: 9112 S 48 AC A		

EDEN'S CROSSING ESTATE - STAGE 29
MALLEE STREET, REDBANK PLAINS
PLAN OF ADAC SURVEY DATA
SEWERAGE RETICULATION 22-PNT-55208

DRAWING STATUS AS CONSTRUCTED	
SHEET 1 OF 1 SHEETS	
DRAWING NO.	REV.
	A

