

DRAWING REVISIONS		REFERENCE DRAWINGS		DESIGN FILE No.	DESIGNED	THIS WORK WAS PREPARED BY:		 MORETON BAY REGIONAL COUNCIL CABOOLTURE DISTRICT OFFICE 2 HASKING STREET CABOOLTURE QLD 4510 PO BOX 159 CABOOLTURE QLD 4510 Telephone: (07) 3433 0100 Fax: (07) 3433 4000	RIVERBANK ESTATE STAGE 7A AS CONSTRUCTED ROADS AND DRAINAGE	CSC SUBDIVISION REFERENCE	
REV.	REVISION DESCRIPTION	DRG. No.	DESCRIPTION	CONSTRUCT. No.	DATE	DM	DA/34766/2017/V4D/1				
A	AS CONSTRUCTED				26.09.2018	ADH	SCALE 1:250 ORIGINAL SIZE A1		No. 1 OF 2 PLANS ASCON GRID NUMBER	REV. B	
B	FOOTPATHS & LANDSCAPING ADDED				26.09.2018						

ENGINEER'S CERTIFICATION

I, _____ hereby certify that:
 1. The information contained in this drawing / document is in compliance with approved drawings and design.
 2. The new drainage and transport works defined by this drawing have been designed and constructed in accordance with Council Standards.
 3. This represents an accurate record of as-constructed works.
 4. I accept responsibility for the information contained in this drawing / document.

RPEQ (signature) RPEQ No. _____ Date: _____


REGISTERED SURVEYOR'S CERTIFICATION

I, Andrew Robert Thurston (Cad. Surv.), hereby certify that the vertical and horizontal locations and dimensions shown on this plan are a true and correct record and were located by survey.


Registered Surveyor (sig.) _____
 Reg. Surveyor No. 3047 Date: 26/09/2018

LEGEND:

- NEW STORMWATER LINE
- TOP OF BANK
- - - BOTTOM OF BANK
- CONTOURS
- SW — EXISTING STORMWATER LINE
- NEW STORMWATER MANHOLE
- NEW STORMWATER GULLY PIT
- NEW RETAINING WALL
- - - NEW RETAINING WALL AND ACOUSTIC BARRIER

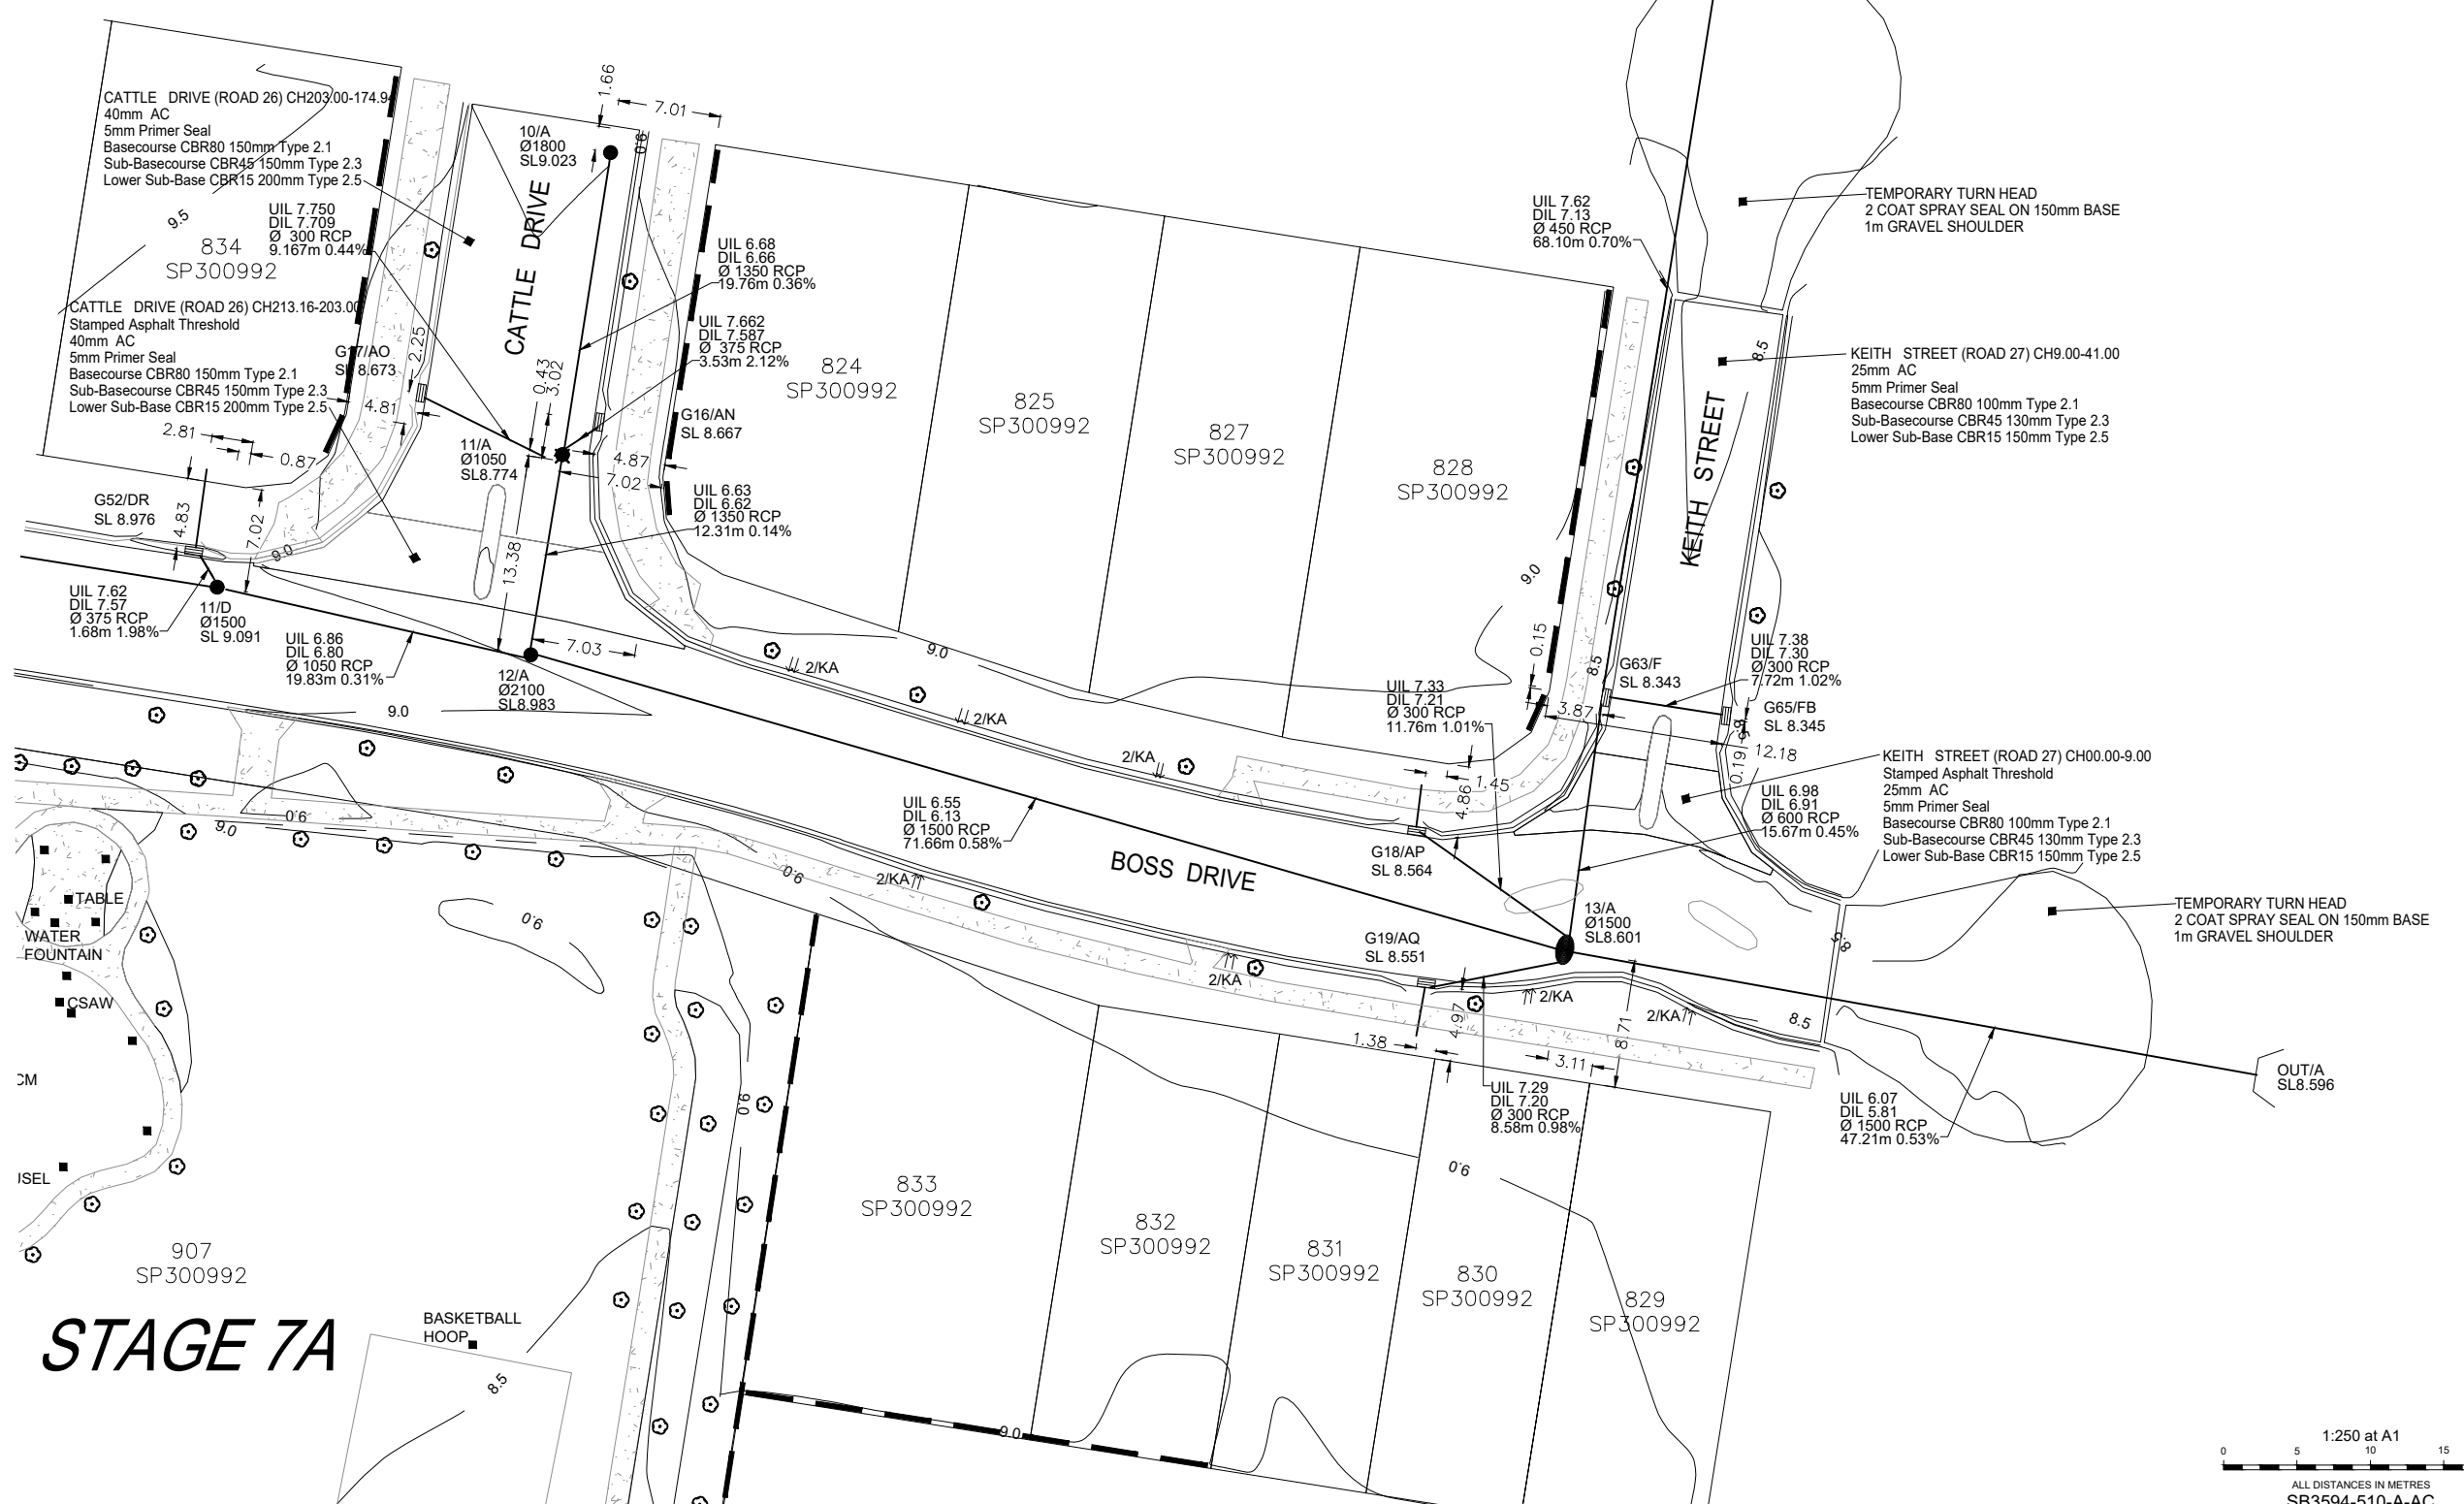

STAGE 7A

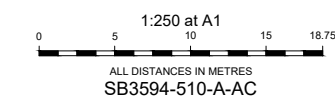

DRAWING REVISIONS		REFERENCE DRAWINGS		DESIGN FILE No.		DESIGNED	
REV.	REVISION DESCRIPTION	DRG. No.	DESCRIPTION	CONSTRUCT. No.	DATE	DATE	DM
A	AS CONSTRUCTED				26.09.2018		
B	FOOTPATHS & LANDSCAPING ADDED						

THIS WORK WAS PREPARED BY:

WOLTER consulting group

Scale: 1:250 ORIGINAL SIZE A1

MORETON BAY REGIONAL COUNCIL
 CABOOLTURE DISTRICT OFFICE
 2 HASKING STREET CABOOLTURE QLD 4510
 PO BOX 159 CABOOLTURE QLD 4510
 Telephone: (07) 3433 0100
 Fax: (07) 3433 4000

RIVERBANK ESTATE
 STAGE 7A
 AS CONSTRUCTED
 ROADS AND DRAINAGE

CSC SUBDIVISION REFERENCE	
DA/34766/2017/V4D/1	
No. 2 OF 2 PLANS	
ASCON GRID NUMBER	REV.
	B