


WARNING
BEWARE OF UNDERGROUND/OVERHEAD SERVICES
THE LOCATION OF SERVICES ARE APPROXIMATE ONLY, AND THEIR EXACT POSITION SHOULD BE PROVEN ON SITE. NO GUARANTEE IS GIVEN THAT ALL EXISTING SERVICES ARE SHOWN. SPECIAL CONSIDERATION SHOULD BE GIVEN TO CONSTRUCTION PROCEDURES UNDER OVERHEAD ELECTRICITY TRANSMISSION LINES.

WORKS ON OR NEAR BARWON WATER ASSETS - CONTRACTOR TO REFER TO BARWON WATER'S CUSTOMER GUIDE FOR 'WORKS ON OR NEAR BARWON WATER ASSETS' AND MAKE APPLICATIONS AS PER BARWON WATER'S REQUIREMENTS.

WARNING
BEWARE OF TRANSMISSION LINES
TRANSMISSION POWER LINES IN CLOSE PROXIMITY OF WORKS, INDUCED ELECTRICAL CURRENTS MAY OCCUR. APPROPRIATE SAFETY MEASURES TO BE CARRIED OUT.

file name: 303446CR200.dwg, layout name: CR200, plot date: 25/11/2022, 9:21 AM, sheet: 2 of 17, sheets

| Rev | Amendments | Approved | Date |
|-----|---------------------------|----------|----------|
| 1 | AS CONSTRUCTED | M.H. | 25/11/22 |
| 0 | ISSUED FOR CONSTRUCTION | M.H. | 09/09/21 |
| B | OVERLAND FOW ARROWS ADDED | M.H. | 02/09/21 |
| A | ISSUED FOR APPROVAL | M.H. | 11/08/21 |

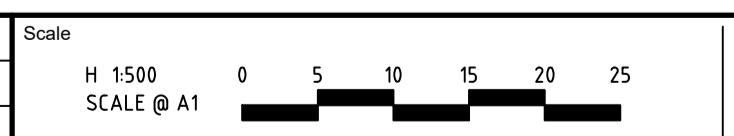

ISO 9001
ISO 45001
ISO 14001
System Certified

© Spiire Australia Pty Ltd All Rights Reserved
This document is produced by Spiire Australia Pty Ltd solely for the benefit of and use by the client in accordance with the terms of the retainer. Spiire Australia Pty Ltd does not and shall not assume any responsibility or liability whatsoever to any third party arising out of any use or reliance by third party on the content of this document.



L6 414 LA TROBE STREET PO BOX 16084 MELBOURNE VICTORIA 8007 AUSTRALIA T 61 3 9993 7888 spiire.com.au ABN 55 050 029 635



Designed P.CLIFTON
Authorised M.HOLMES
Checked J. KOEHLER
Date 11/08/21

NEWHAVEN ESTATE
STAGE 14
ROAD AND DRAINAGE
FACE PLAN
WYNDHAM CITY COUNCIL
PEET NO.1895 PTY LTD

AS CONSTRUCTED Dwg No **303446CR200** Rev **1**