

PSM 201158
 E: 506353.976
 N: 7042428.644
 RL: 12.944m

LEGEND:

- | | | | |
|--|-----------------------------|--|--------------------------|
| | STORMWATER LINE | | SPOT HEIGHT |
| | EXISTING STORMWATER LINE | | BARRIER CONTINUOUS |
| | STORMWATER MANHOLE | | BARRIER |
| | STORMWATER MANHOLE EXTENDED | | SIGN |
| | STORMWATER PIT | | KERB LINE BACK OF KERB |
| | STORMWATER GULLY PIT | | KERB LINE INVERT OF KERB |
| | TOP OF BANK | | KERB LINE LIP OF KERB |
| | BOTTOM OF BANK | | ROAD CENTRE LINE |
| | CHANGE OF GRADE | | SUB SOIL DRAIN |
| | CONTOURS | | RETAINING WALL BASE |

Surveyors As Constructed Certification

I: Andrew Robert Thurston (surveyors name) 03047 (surveyors registration number)
 being a certified/registered surveyor and duly authorised representative of:
 The Wolter Consulting Group (consulting firm or company name)

Hereby certify the information contained in this drawing is an accurate as constructed representation of the works
 • accept responsibility for the as constructed survey information contained in this drawing
 • acknowledge the as constructed survey information contained in the drawing may be relied on by council and others

Certification of Stage: Stage 1 (stage number) by *ACT* (signature) On 28 / 08 / 2020. (date)

For The Wolter Consulting Group (consulting firm or company name)
 Note: Where consulting firms, company name or stage numbers do not apply, complete with N/A for not applicable


Engineers As Constructed Certification

I: (engineers name) (RPEQ number)
 being a certified/registered engineer and duly authorised representative of:
 (consulting firm or company name)

Hereby certify the information contained in this drawing is an accurate as constructed representation of the works
 • accept responsibility for the as constructed survey information contained in this drawing
 • acknowledge the as constructed survey information contained in the drawing may be relied on by council and others

Certification of Stage: (stage number) by (signature) On / / 2020. (date)

For (consulting firm or company name)
 Note: Where consulting firms, company name or stage numbers do not apply, complete with N/A for not applicable

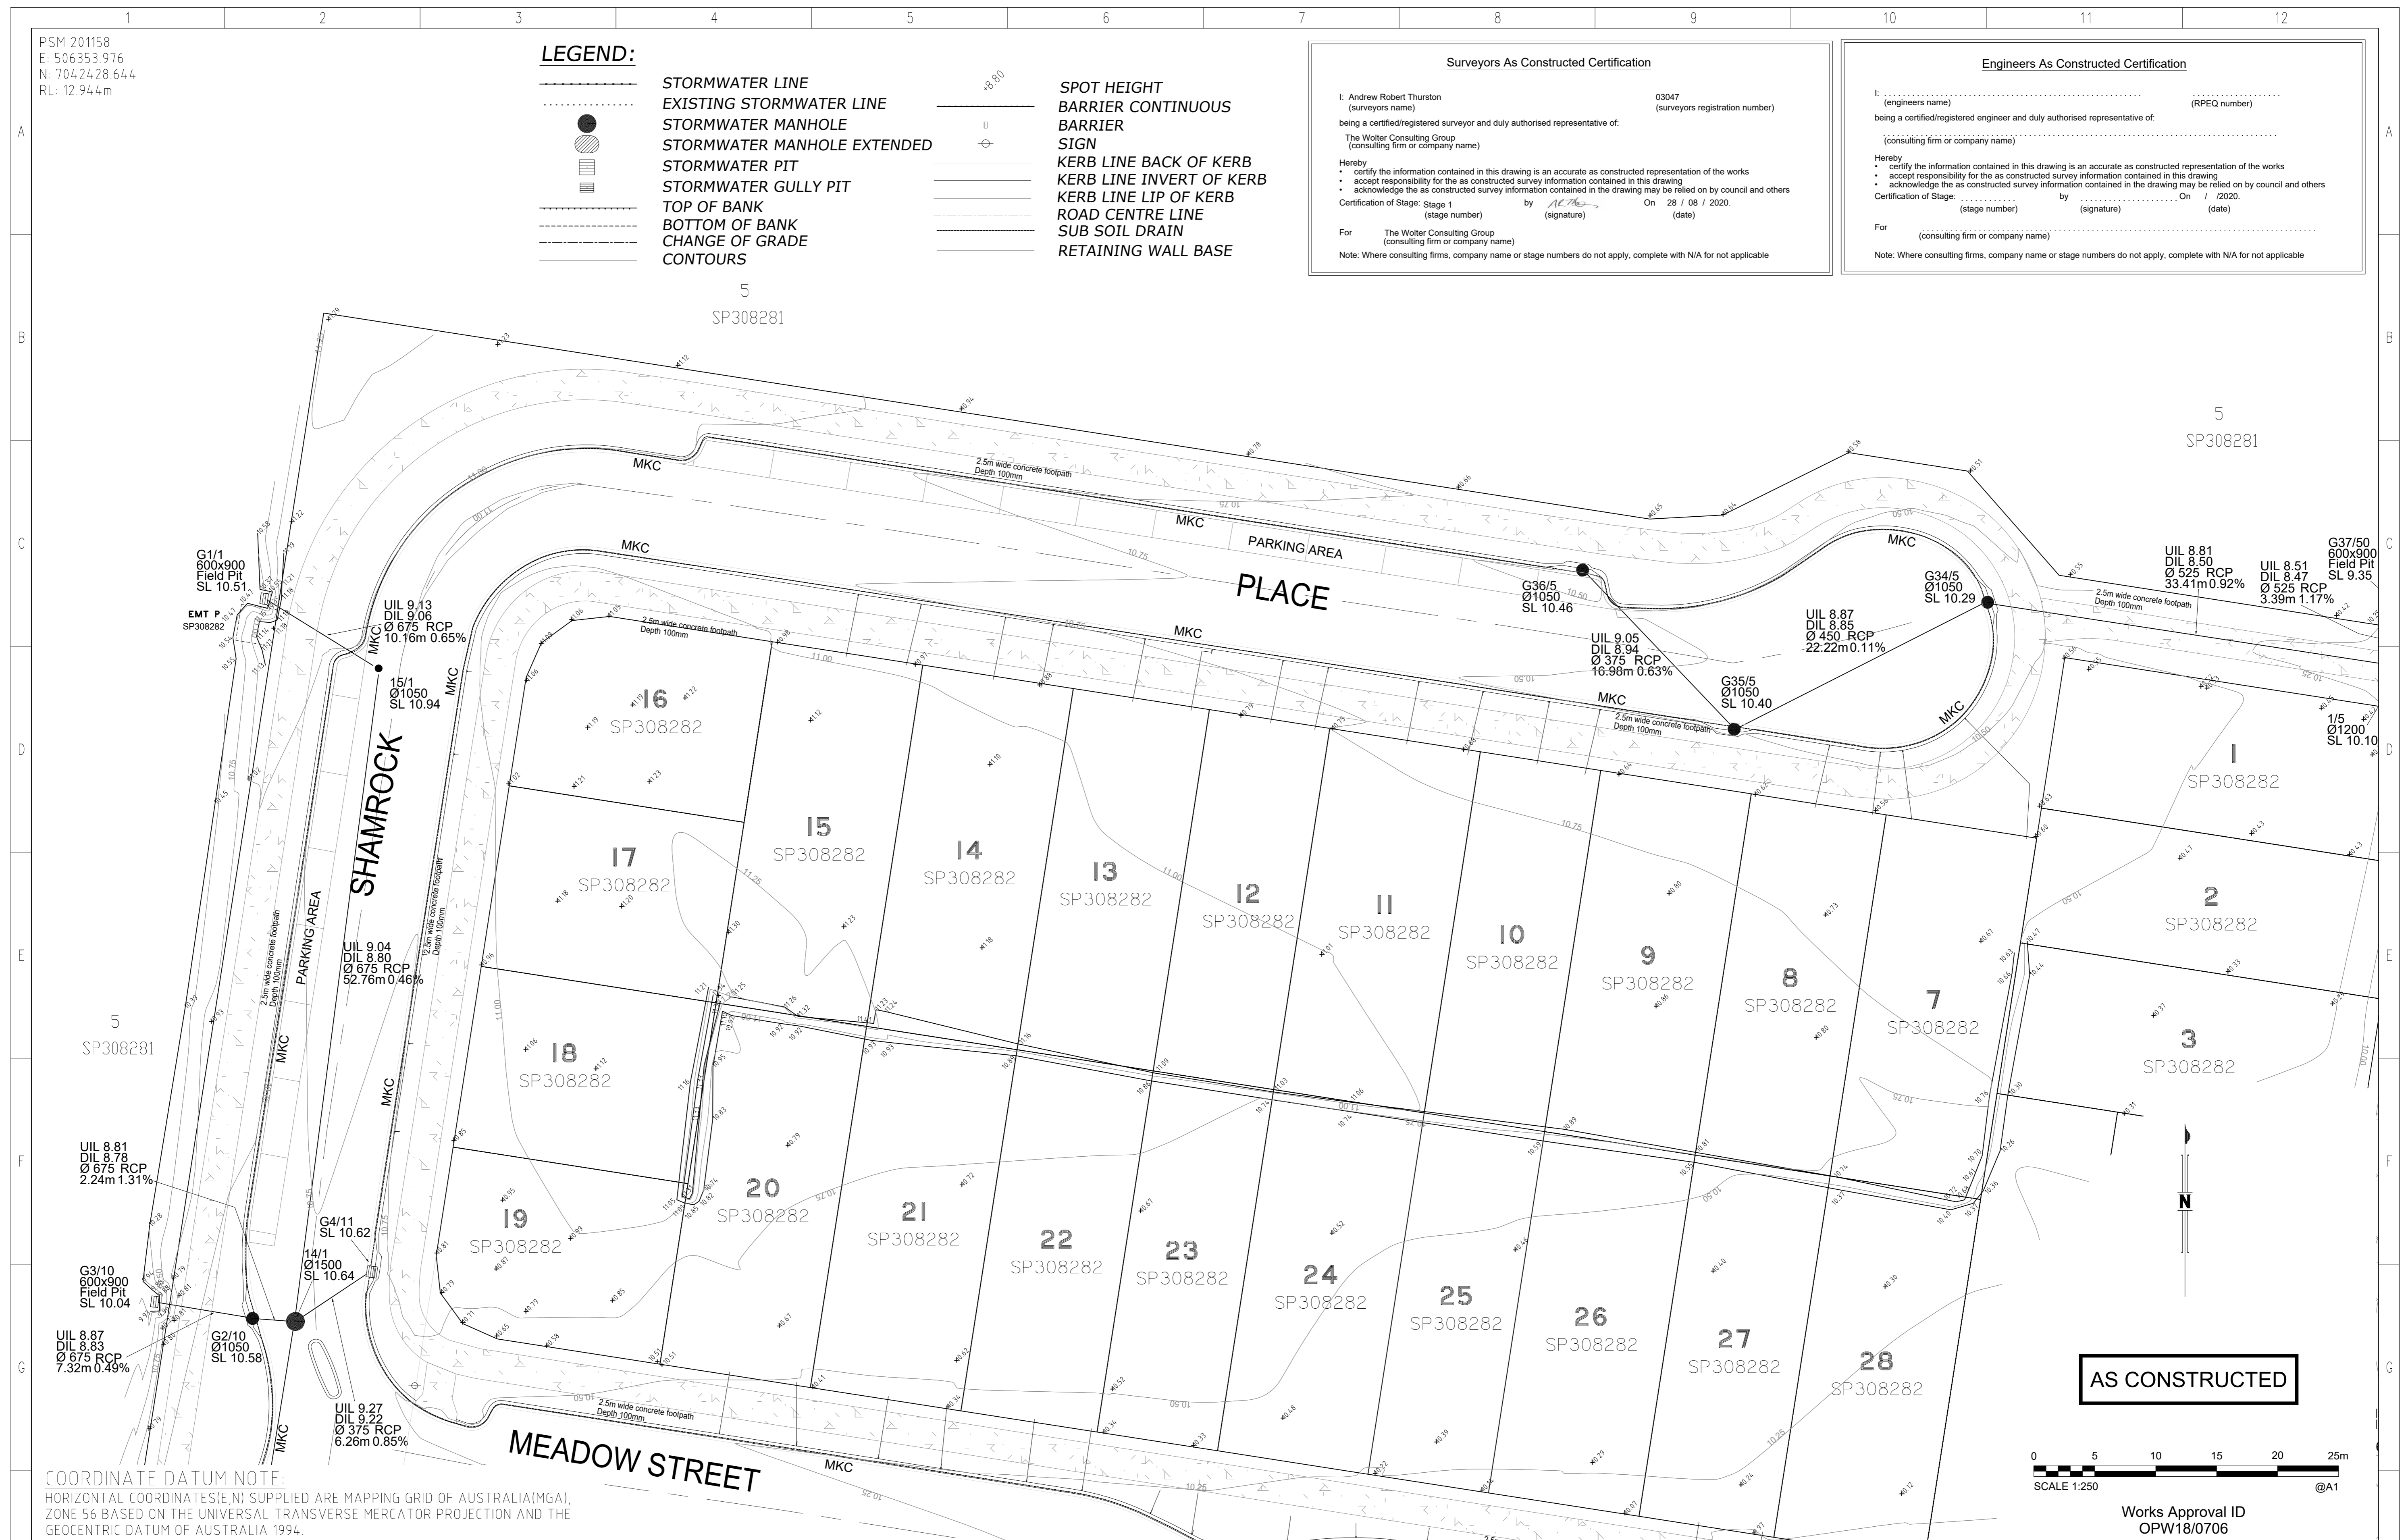

COORDINATE DATUM NOTE:
 HORIZONTAL COORDINATES(E,N) SUPPLIED ARE MAPPING GRID OF AUSTRALIA(MGA), ZONE 56 BASED ON THE UNIVERSAL TRANSVERSE MERCATOR PROJECTION AND THE GEOCENTRIC DATUM OF AUSTRALIA 1994.

AS CONSTRUCTED

Works Approval ID
 OPW18/0706

DRAWING REVISIONS		REFERENCE DRAWINGS		DESIGN FILE No.	DESIGNED
REV.	REVISION DESCRIPTION	DRG. No.	DESCRIPTION	CONSTRUCT. No.	DATE
A	AS CONSTRUCTED				
B	AS CONSTRUCTED - NEW BASIN				
C	AS CONSTRUCTED - SIGN/RW ADDED				

FIELD BOOK	CHECKED	DATE
SS3787	ADH	28.08.2020
AHD		28.08.2020
MGA-56		

WOLTER consulting group
 Planning Urban Design Landscape Environment Surveying
 Brisbane: Level 2, 1 Breakfast Ck Road, Newstead, QLD 4006 Phone: (07) 3666 5200

SCALE 1:250 ORIGINAL SIZE A1

SUNSHINE COAST COUNCIL
 CALOUNDRA OFFICE
 1 OMARAH AVENUE, CALOUNDRA QLD 4551
 MAROOCHYDORE OFFICE
 10 FIRST AVENUE, MAROOCHYDORE QLD 4558
 NAMBOUR OFFICE
 Cnr CURRIE and BURY STREETS, NAMBOUR QLD 4560
 LOCKED BAG 72, SUNSHINE COAST
 MAIL CENTRE QLD 4560
 Telephone: (07) 5475 7528
 Fax: (07) 5475 7277

VILLAGE GREEN
 STAGE 1
 AS CONSTRUCTED
 ROADS, DRAINAGE AND SURFACE

SUBDIVISION REFERENCE	
RAL 180186 SCC	
No. 1 OF 13 PLANS	
ASCON GRID NUMBER	REV.
	C

Surveyors As Constructed Certification

I: Andrew Robert Thurston (surveyors name) 03047 (surveyors registration number)
being a certified/registered surveyor and duly authorised representative of:
The Wolter Consulting Group (consulting firm or company name)

Hereby:
• certify the information contained in this drawing is an accurate as constructed representation of the works
• accept responsibility for the as constructed survey information contained in this drawing
• acknowledge the as constructed survey information contained in the drawing may be relied on by council and others

Certification of Stage: Stage 1 (stage number) by [Signature] On 28 / 08 / 2020. (date)

For The Wolter Consulting Group (consulting firm or company name)
Note: Where consulting firms, company name or stage numbers do not apply, complete with N/A for not applicable

Engineers As Constructed Certification

I: (engineers name) (RPEQ number)
being a certified/registered engineer and duly authorised representative of:
(consulting firm or company name)


Hereby:
• certify the information contained in this drawing is an accurate as constructed representation of the works
• accept responsibility for the as constructed survey information contained in this drawing
• acknowledge the as constructed survey information contained in the drawing may be relied on by council and others

Certification of Stage: (stage number) by (signature) On / / 2020. (date)

For (consulting firm or company name)
Note: Where consulting firms, company name or stage numbers do not apply, complete with N/A for not applicable

LEGEND:

- STORMWATER LINE
- EXISTING STORMWATER LINE
- STORMWATER MANHOLE
- ⊙ STORMWATER MANHOLE EXTENDED
- STORMWATER PIT
- STORMWATER GULLY PIT
- - - TOP OF BANK
- - - BOTTOM OF BANK
- - - CHANGE OF GRADE
- CONTOURS
- +8.00 SPOT HEIGHT
- BARRIER CONTINUOUS
- BARRIER
- SIGN
- KERB LINE BACK OF KERB
- KERB LINE INVERT OF KERB
- KERB LINE LIP OF KERB
- ROAD CENTRE LINE
- SUB SOIL DRAIN
- RETAINING WALL BASE

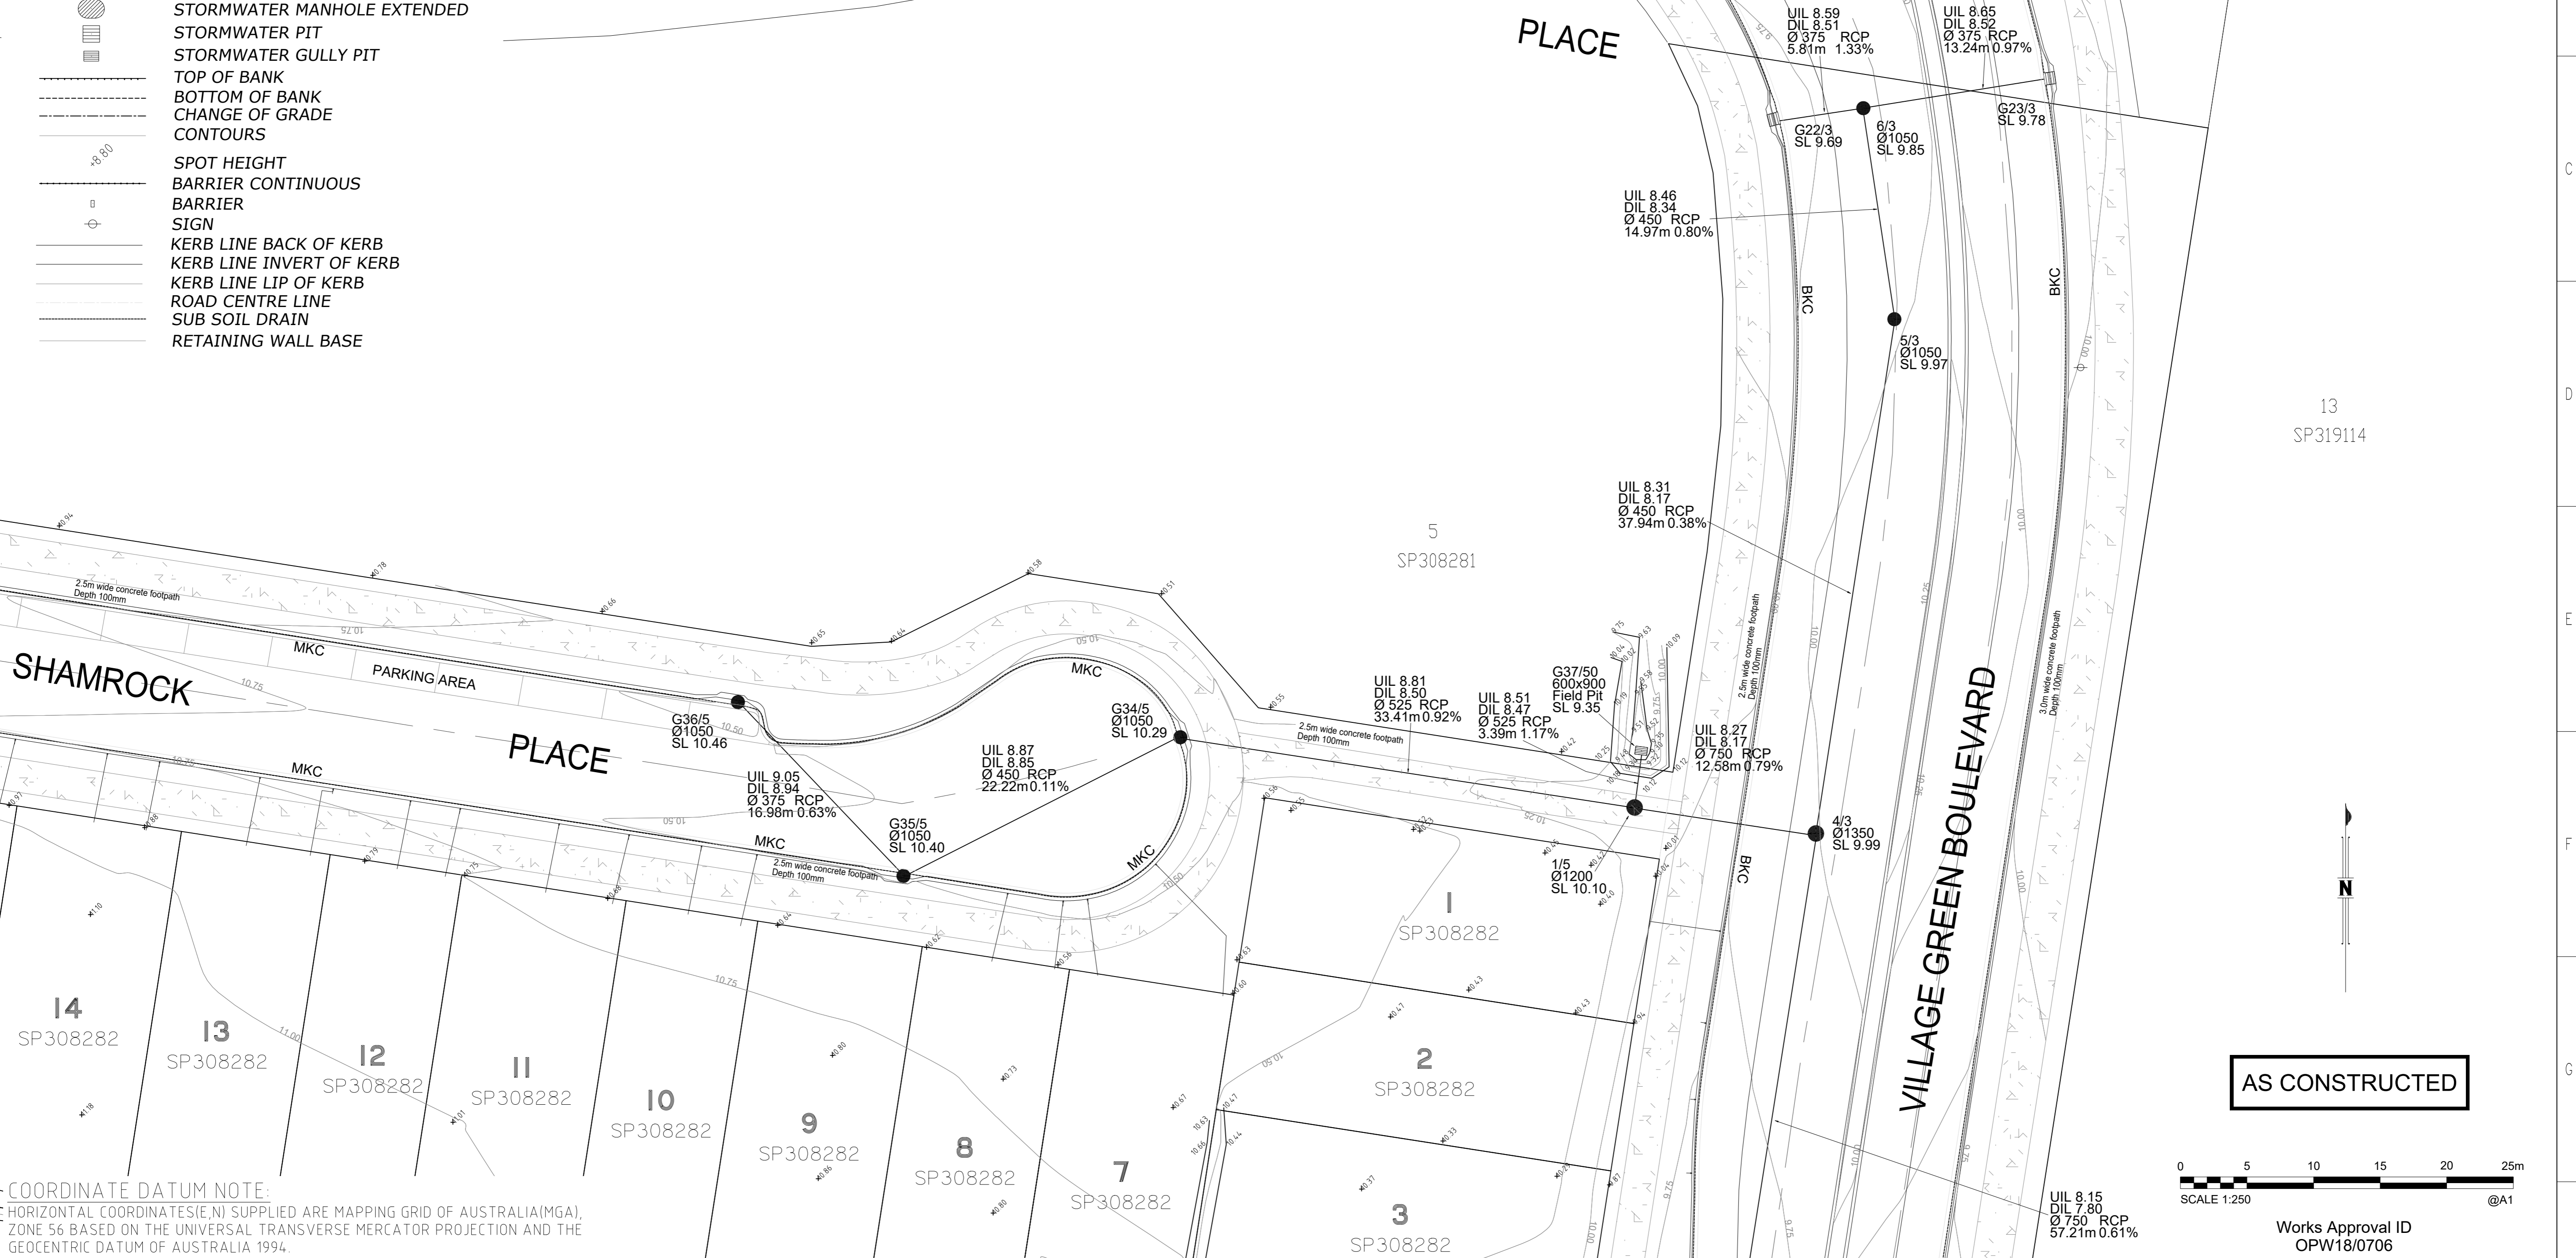

COORDINATE DATUM NOTE:
HORIZONTAL COORDINATES (E, N) SUPPLIED ARE MAPPING GRID OF AUSTRALIA (MGA), ZONE 56 BASED ON THE UNIVERSAL TRANSVERSE MERCATOR PROJECTION AND THE GEOCENTRIC DATUM OF AUSTRALIA 1994.

DRAWING REVISIONS		REFERENCE DRAWINGS		DESIGN FILE No.	DESIGNED
REV.	REVISION DESCRIPTION	DRG. No.	DESCRIPTION	CONSTRUCT. No.	DATE
A	AS CONSTRUCTED				
B	AS CONSTRUCTED - NEW BASIN			SS3787	28.08.2020
C	AS CONSTRUCTED - SIGN/RW ADDED				

WOLTER consulting group
Planning Urban Design Landscape Environment Surveying
Brisbane: Level 2, 1 Breakfast Ck Road, Newstead, QLD 4006. Phone: (07) 3666 5200

SCALE 1:250 ORIGINAL SIZE A1

SUNSHINE COAST COUNCIL
CALOUNDRA OFFICE
1 OMRAH AVENUE, CALOUNDRA QLD 4551
MAROOCHYDORE OFFICE
10 FIRST AVENUE, MAROOCHYDORE QLD 4558
NAMBOUR OFFICE
CAR CURRIE AND BURY STREETS, NAMBOUR QLD 4560
LOCKED BAG 72, SUNSHINE COAST
MAIL CENTRE QLD 4560
Telephone: (07) 5475 7528
Fax: (07) 5475 7277

VILLAGE GREEN
STAGE 1
AS CONSTRUCTED
ROADS, DRAINAGE AND SURFACE

SUBDIVISION REFERENCE	
RAL 180186 SCC	
No. 2 OF 13 PLANS	
ASCON GRID NUMBER	REV.
	C



PSM 201158
E: 506353.976
N: 7042428.644
RL: 12.944m

COORDINATE DATUM NOTE:
HORIZONTAL COORDINATES (E, N) SUPPLIED ARE MAPPING GRID OF AUSTRALIA (MGA), ZONE 56 BASED ON THE UNIVERSAL TRANSVERSE MERCATOR PROJECTION AND THE GEOCENTRIC DATUM OF AUSTRALIA 1994.

Surveyors As Constructed Certification

I: Andrew Robert Thurston (surveyors name) 03047 (surveyors registration number)
being a certified/registered surveyor and duly authorised representative of:
The Wolter Consulting Group (consulting firm or company name)

Herby
• certify the information contained in this drawing is an accurate as constructed representation of the works
• accept responsibility for the as constructed survey information contained in this drawing
• acknowledge the as constructed survey information contained in the drawing may be relied on by council and others

Certification of Stage: Stage 1 by [Signature] On 28 / 08 / 2020.
(stage number) (signature) (date)

For The Wolter Consulting Group (consulting firm or company name)

Note: Where consulting firms, company name or stage numbers do not apply, complete with N/A for not applicable

Engineers As Constructed Certification

I: (engineers name) (RPEQ number)
being a certified/registered engineer and duly authorised representative of:
..... (consulting firm or company name)

Herby
• certify the information contained in this drawing is an accurate as constructed representation of the works
• accept responsibility for the as constructed survey information contained in this drawing
• acknowledge the as constructed survey information contained in the drawing may be relied on by council and others

Certification of Stage: by On / / 2020.
(stage number) (signature) (date)

For (consulting firm or company name)

Note: Where consulting firms, company name or stage numbers do not apply, complete with N/A for not applicable

LEGEND:

- STORMWATER LINE
- EXISTING STORMWATER LINE
- STORMWATER MANHOLE
- STORMWATER MANHOLE EXTENDED
- STORMWATER PIT
- STORMWATER GULLY PIT
- TOP OF BANK
- BOTTOM OF BANK
- CHANGE OF GRADE
- CONTOURS
- SPOT HEIGHT
- BARRIER CONTINUOUS
- BARRIER
- SIGN
- KERB LINE BACK OF KERB
- KERB LINE INVERT OF KERB
- KERB LINE LIP OF KERB
- ROAD CENTRE LINE
- SUB SOIL DRAIN
- RETAINING WALL BASE

AS CONSTRUCTED



Works Approval ID
OPW18/0706

DRAWING REVISIONS		REFERENCE DRAWINGS		DESIGN FILE No.	DESIGNED	
REV.	REVISION DESCRIPTION	DRG. No.	DESCRIPTION	CONSTRUCT. No.	DATE	
A	AS CONSTRUCTED					
B	AS CONSTRUCTED - NEW BASIN			SS3787	28.08.2020	JWB
C	AS CONSTRUCTED - SIGN/RW ADDED					ADH
					28.08.2020	

WOLTER consulting group

Planning Urban Design Landscape Environment Surveying

Brisbane: Level 2, 1 Breakfast Ck Road, Newstead, QLD 4006 Phone: (07) 3666 5200

SCALE 1:250 ORIGINAL SIZE A1

SUNSHINE COAST COUNCIL

CALOUNDRA OFFICE
1 OMARAH AVENUE, CALOUNDRA QLD 4551

MAROOCHYDORE OFFICE
10 FIRST AVENUE, MAROOCHYDORE QLD 4558

NAMBOUR OFFICE
CAR CURRIE and BURY STREETS, NAMBOUR QLD 4560


LOCKED BAG 72, SUNSHINE COAST
MAIL CENTRE QLD 4560

Telephone: (07) 5475 7528
Fax: (07) 5475 7277

VILLAGE GREEN

STAGE 1
AS CONSTRUCTED
ROADS, DRAINAGE AND SURFACE


SUBDIVISION REFERENCE	
RAL 180186 SCC	
No. 3 OF 13 PLANS	
ASCON GRID NUMBER	REV.
	C

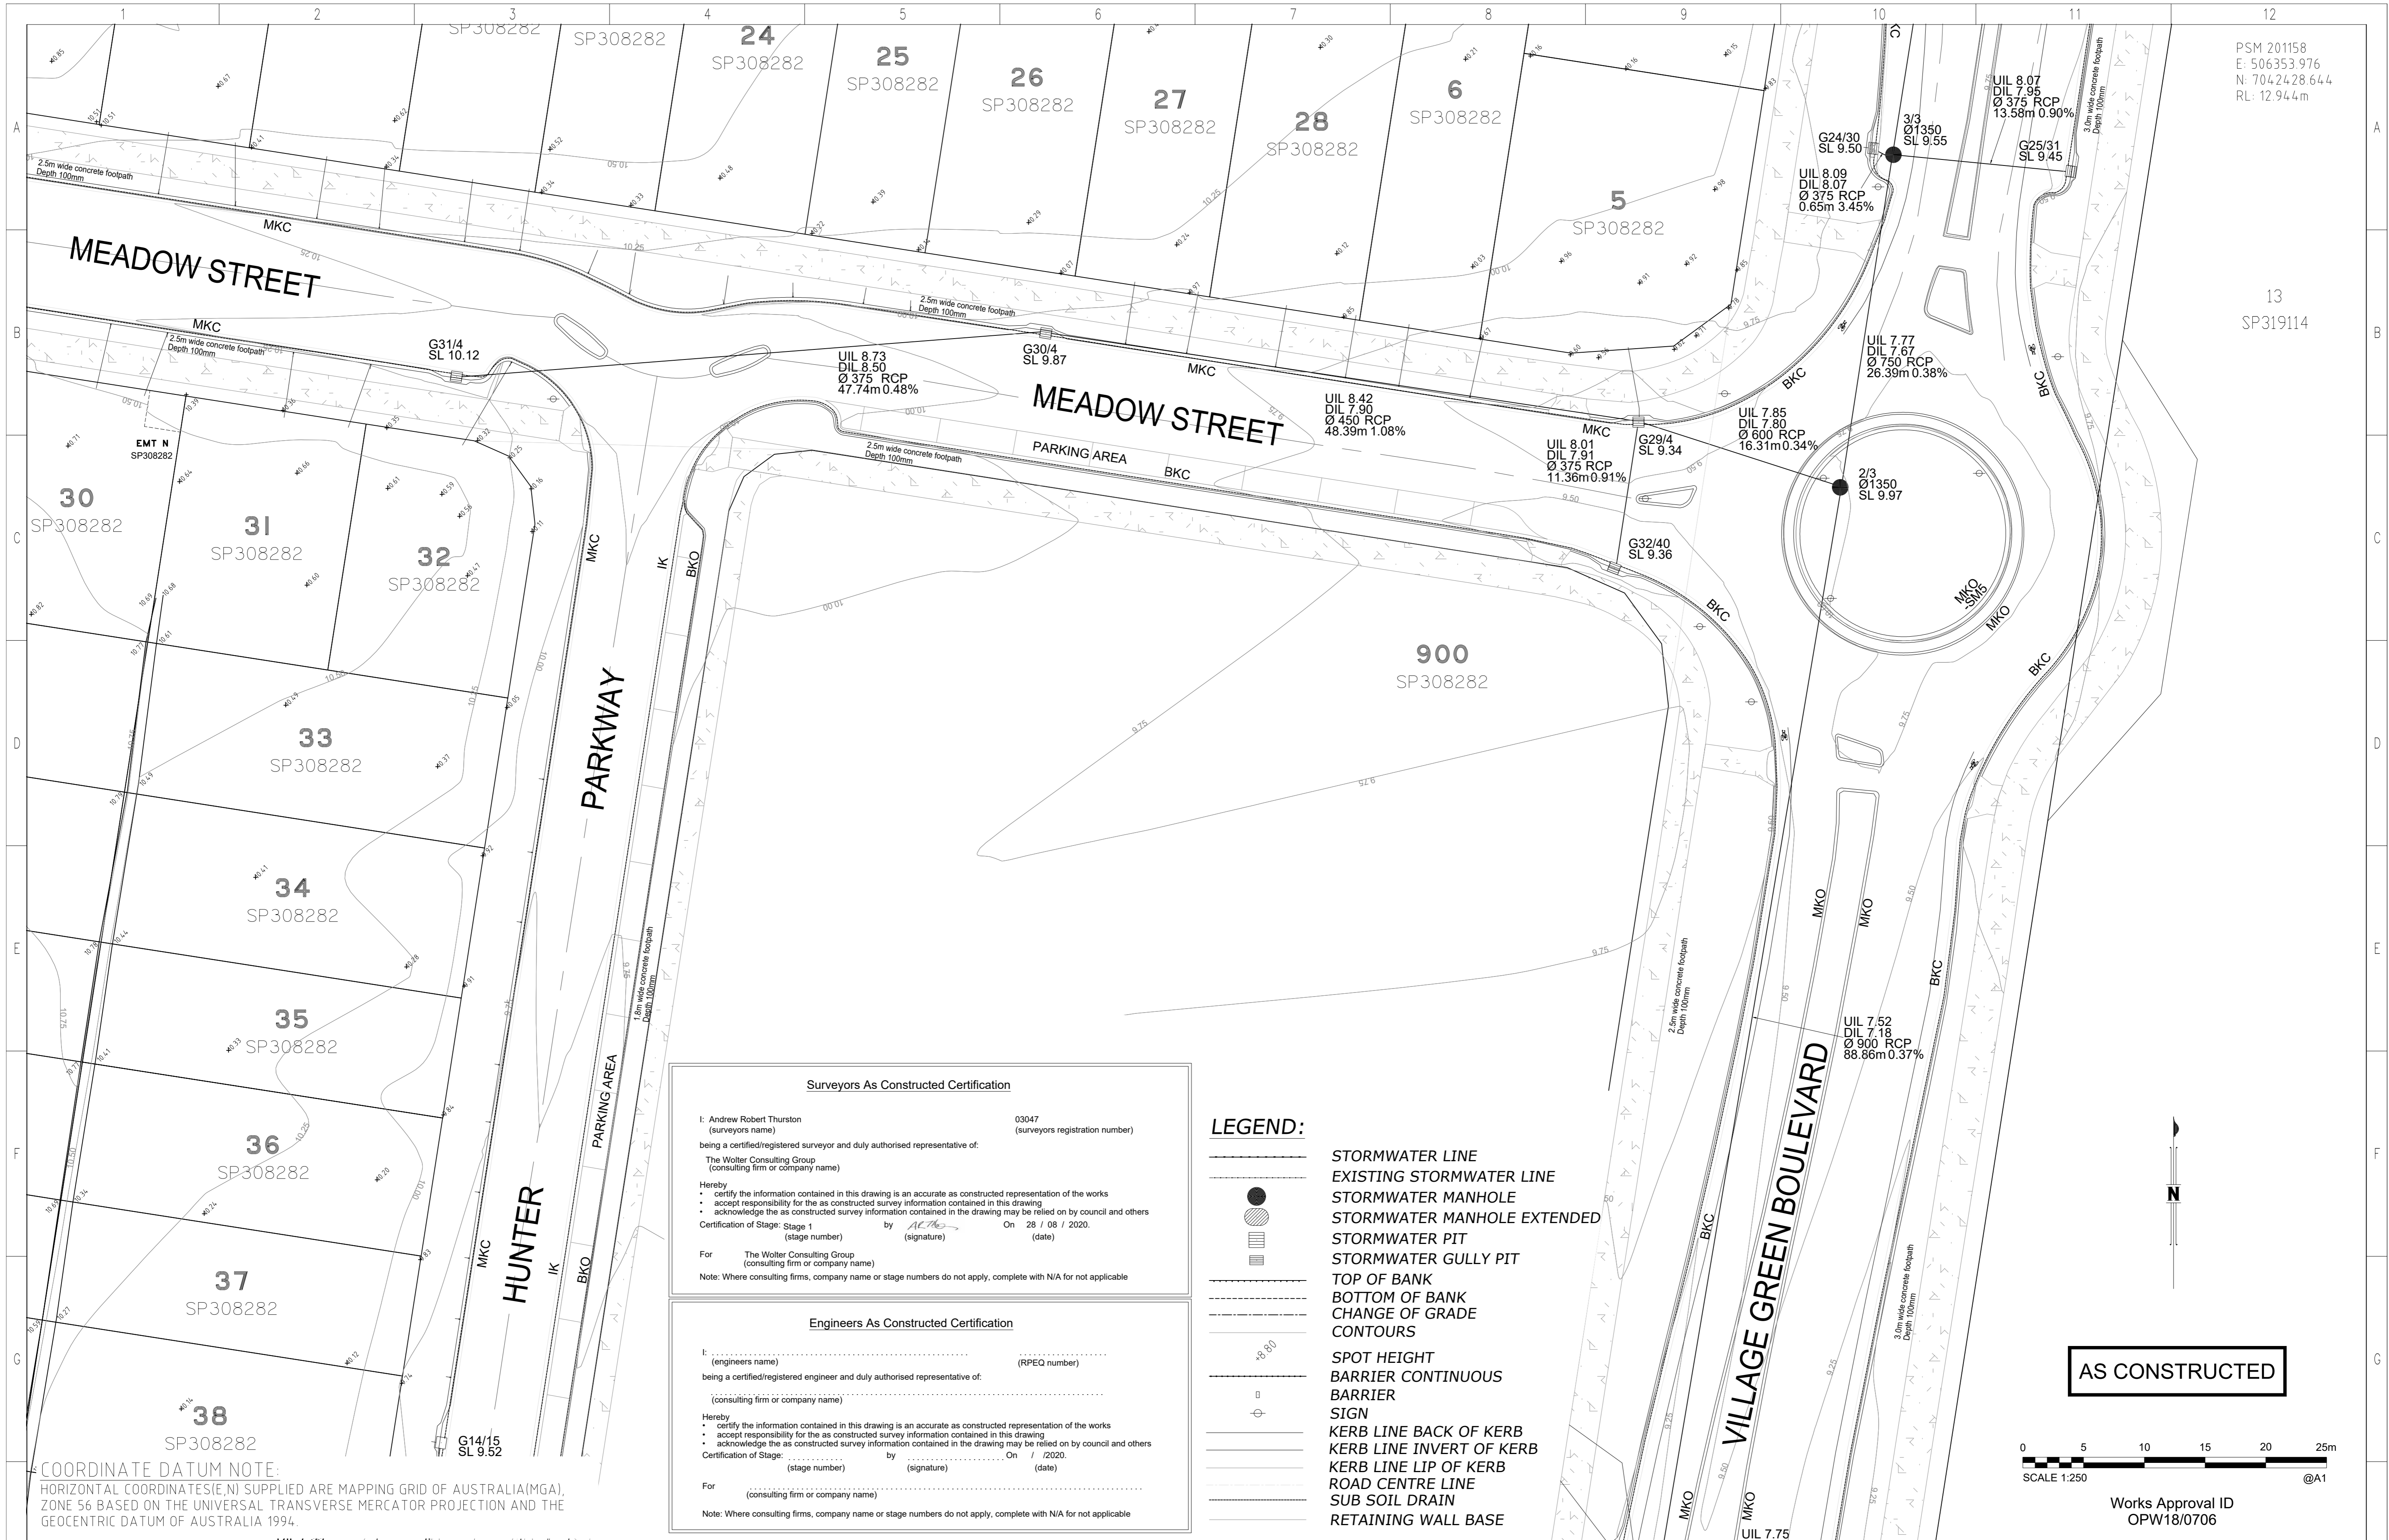

PSM 201158
E: 506353.976
N: 7042428.644
RL: 12.944m

13
SP319114

AS CONSTRUCTED

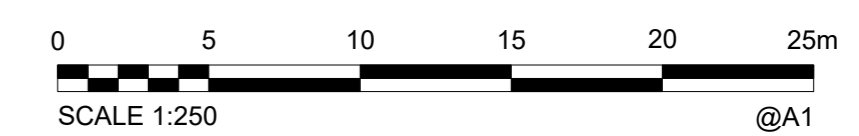

Works Approval ID
OPW18/0706

Surveyors As Constructed Certification

I: Andrew Robert Thurston (surveyors name) 03047 (surveyors registration number)
being a certified/registered surveyor and duly authorised representative of:
The Wolter Consulting Group (consulting firm or company name)

Hereby
 • certify the information contained in this drawing is an accurate as constructed representation of the works
 • accept responsibility for the as constructed survey information contained in this drawing
 • acknowledge the as constructed survey information contained in the drawing may be relied on by council and others

Certification of Stage: Stage 1 by *ACT* On 28 / 08 / 2020.
(stage number) (signature) (date)

For The Wolter Consulting Group (consulting firm or company name)
Note: Where consulting firms, company name or stage numbers do not apply, complete with N/A for not applicable

Engineers As Constructed Certification

I: (engineers name) (RPEQ number)
being a certified/registered engineer and duly authorised representative of:
(consulting firm or company name)

Hereby
 • certify the information contained in this drawing is an accurate as constructed representation of the works
 • accept responsibility for the as constructed survey information contained in this drawing
 • acknowledge the as constructed survey information contained in the drawing may be relied on by council and others

Certification of Stage: by On / / 2020.
(stage number) (signature) (date)

For (consulting firm or company name)
Note: Where consulting firms, company name or stage numbers do not apply, complete with N/A for not applicable

LEGEND:

- STORMWATER LINE
- EXISTING STORMWATER LINE
- STORMWATER MANHOLE
- STORMWATER MANHOLE EXTENDED
- STORMWATER PIT
- STORMWATER GULLY PIT
- TOP OF BANK
- BOTTOM OF BANK
- CHANGE OF GRADE
- CONTOURS
- SPOT HEIGHT
- BARRIER CONTINUOUS
- BARRIER
- SIGN
- KERB LINE BACK OF KERB
- KERB LINE INVERT OF KERB
- KERB LINE LIP OF KERB
- ROAD CENTRE LINE
- SUB SOIL DRAIN
- RETAINING WALL BASE

COORDINATE DATUM NOTE:
HORIZONTAL COORDINATES(E,N) SUPPLIED ARE MAPPING GRID OF AUSTRALIA(MGA), ZONE 56 BASED ON THE UNIVERSAL TRANSVERSE MERCATOR PROJECTION AND THE GEOCENTRIC DATUM OF AUSTRALIA 1994.

DRAWING REVISIONS		REFERENCE DRAWINGS		DESIGN FILE No.	DESIGNED
REV.	REVISION DESCRIPTION	DRG. No.	DESCRIPTION	CONSTRUCT. No.	DATE
A	AS CONSTRUCTED			SS3787	JWB
B	AS CONSTRUCTED - NEW BASIN				28.08.2020
C	AS CONSTRUCTED - SIGN/RW ADDED				ADH

FIELD BOOK	CHECKED	DATE
	ADH	28.08.2020

WOLTER consulting group

Planning Urban Design Landscape Environment Surveying

Brisbane: Level 2, 1 Breakfast Ck Road, Newstead, QLD 4006 Phone: (07) 3666 5200

SCALE 1:250 ORIGINAL SIZE A1

SUNSHINE COAST COUNCIL

CALOUNDRA OFFICE
1 OMRAH AVENUE, CALOUNDRA QLD 4551

MAROOCHYDORE OFFICE
10 FIRST AVENUE, MAROOCHYDORE QLD 4558

NAMBOUR OFFICE
Cnr CURRIE and BURY STREETS, NAMBOUR QLD 4560

LOCKED BAG 72, SUNSHINE COAST
MAIL CENTRE QLD 4560
Telephone: (07) 5475 7528
Fax: (07) 5475 7277

VILLAGE GREEN

STAGE 1
AS CONSTRUCTED
ROADS, DRAINAGE AND SURFACE

SUBDIVISION REFERENCE	
RAL 180186 SCC	
No. 4 OF 13 PLANS	
ASCON GRID NUMBER	REV.
	C

PSM 201158
 E: 506353.976
 N: 7042428.644
 RL: 12.944m

Surveyors As Constructed Certification

I: Andrew Robert Thurston (surveyors name) 03047 (surveyors registration number)
 being a certified/registered surveyor and duly authorised representative of:
 The Walter Consulting Group (consulting firm or company name)

Hereby
 • certify the information contained in this drawing is an accurate as constructed representation of the works
 • accept responsibility for the as constructed survey information contained in this drawing
 • acknowledge the as constructed survey information contained in the drawing may be relied on by council and others

Certification of Stage: Stage 1 (stage number) by A.R.T. (signature) On 28 / 08 / 2020. (date)

For The Walter Consulting Group (consulting firm or company name)
 Note: Where consulting firms, company name or stage numbers do not apply, complete with N/A for not applicable


Engineers As Constructed Certification

I: (engineers name) (RPEQ number)
 being a certified/registered engineer and duly authorised representative of:
 (consulting firm or company name)

Hereby
 • certify the information contained in this drawing is an accurate as constructed representation of the works
 • accept responsibility for the as constructed survey information contained in this drawing
 • acknowledge the as constructed survey information contained in the drawing may be relied on by council and others

Certification of Stage: (stage number) by (signature) On / / 2020. (date)

For (consulting firm or company name)
 Note: Where consulting firms, company name or stage numbers do not apply, complete with N/A for not applicable

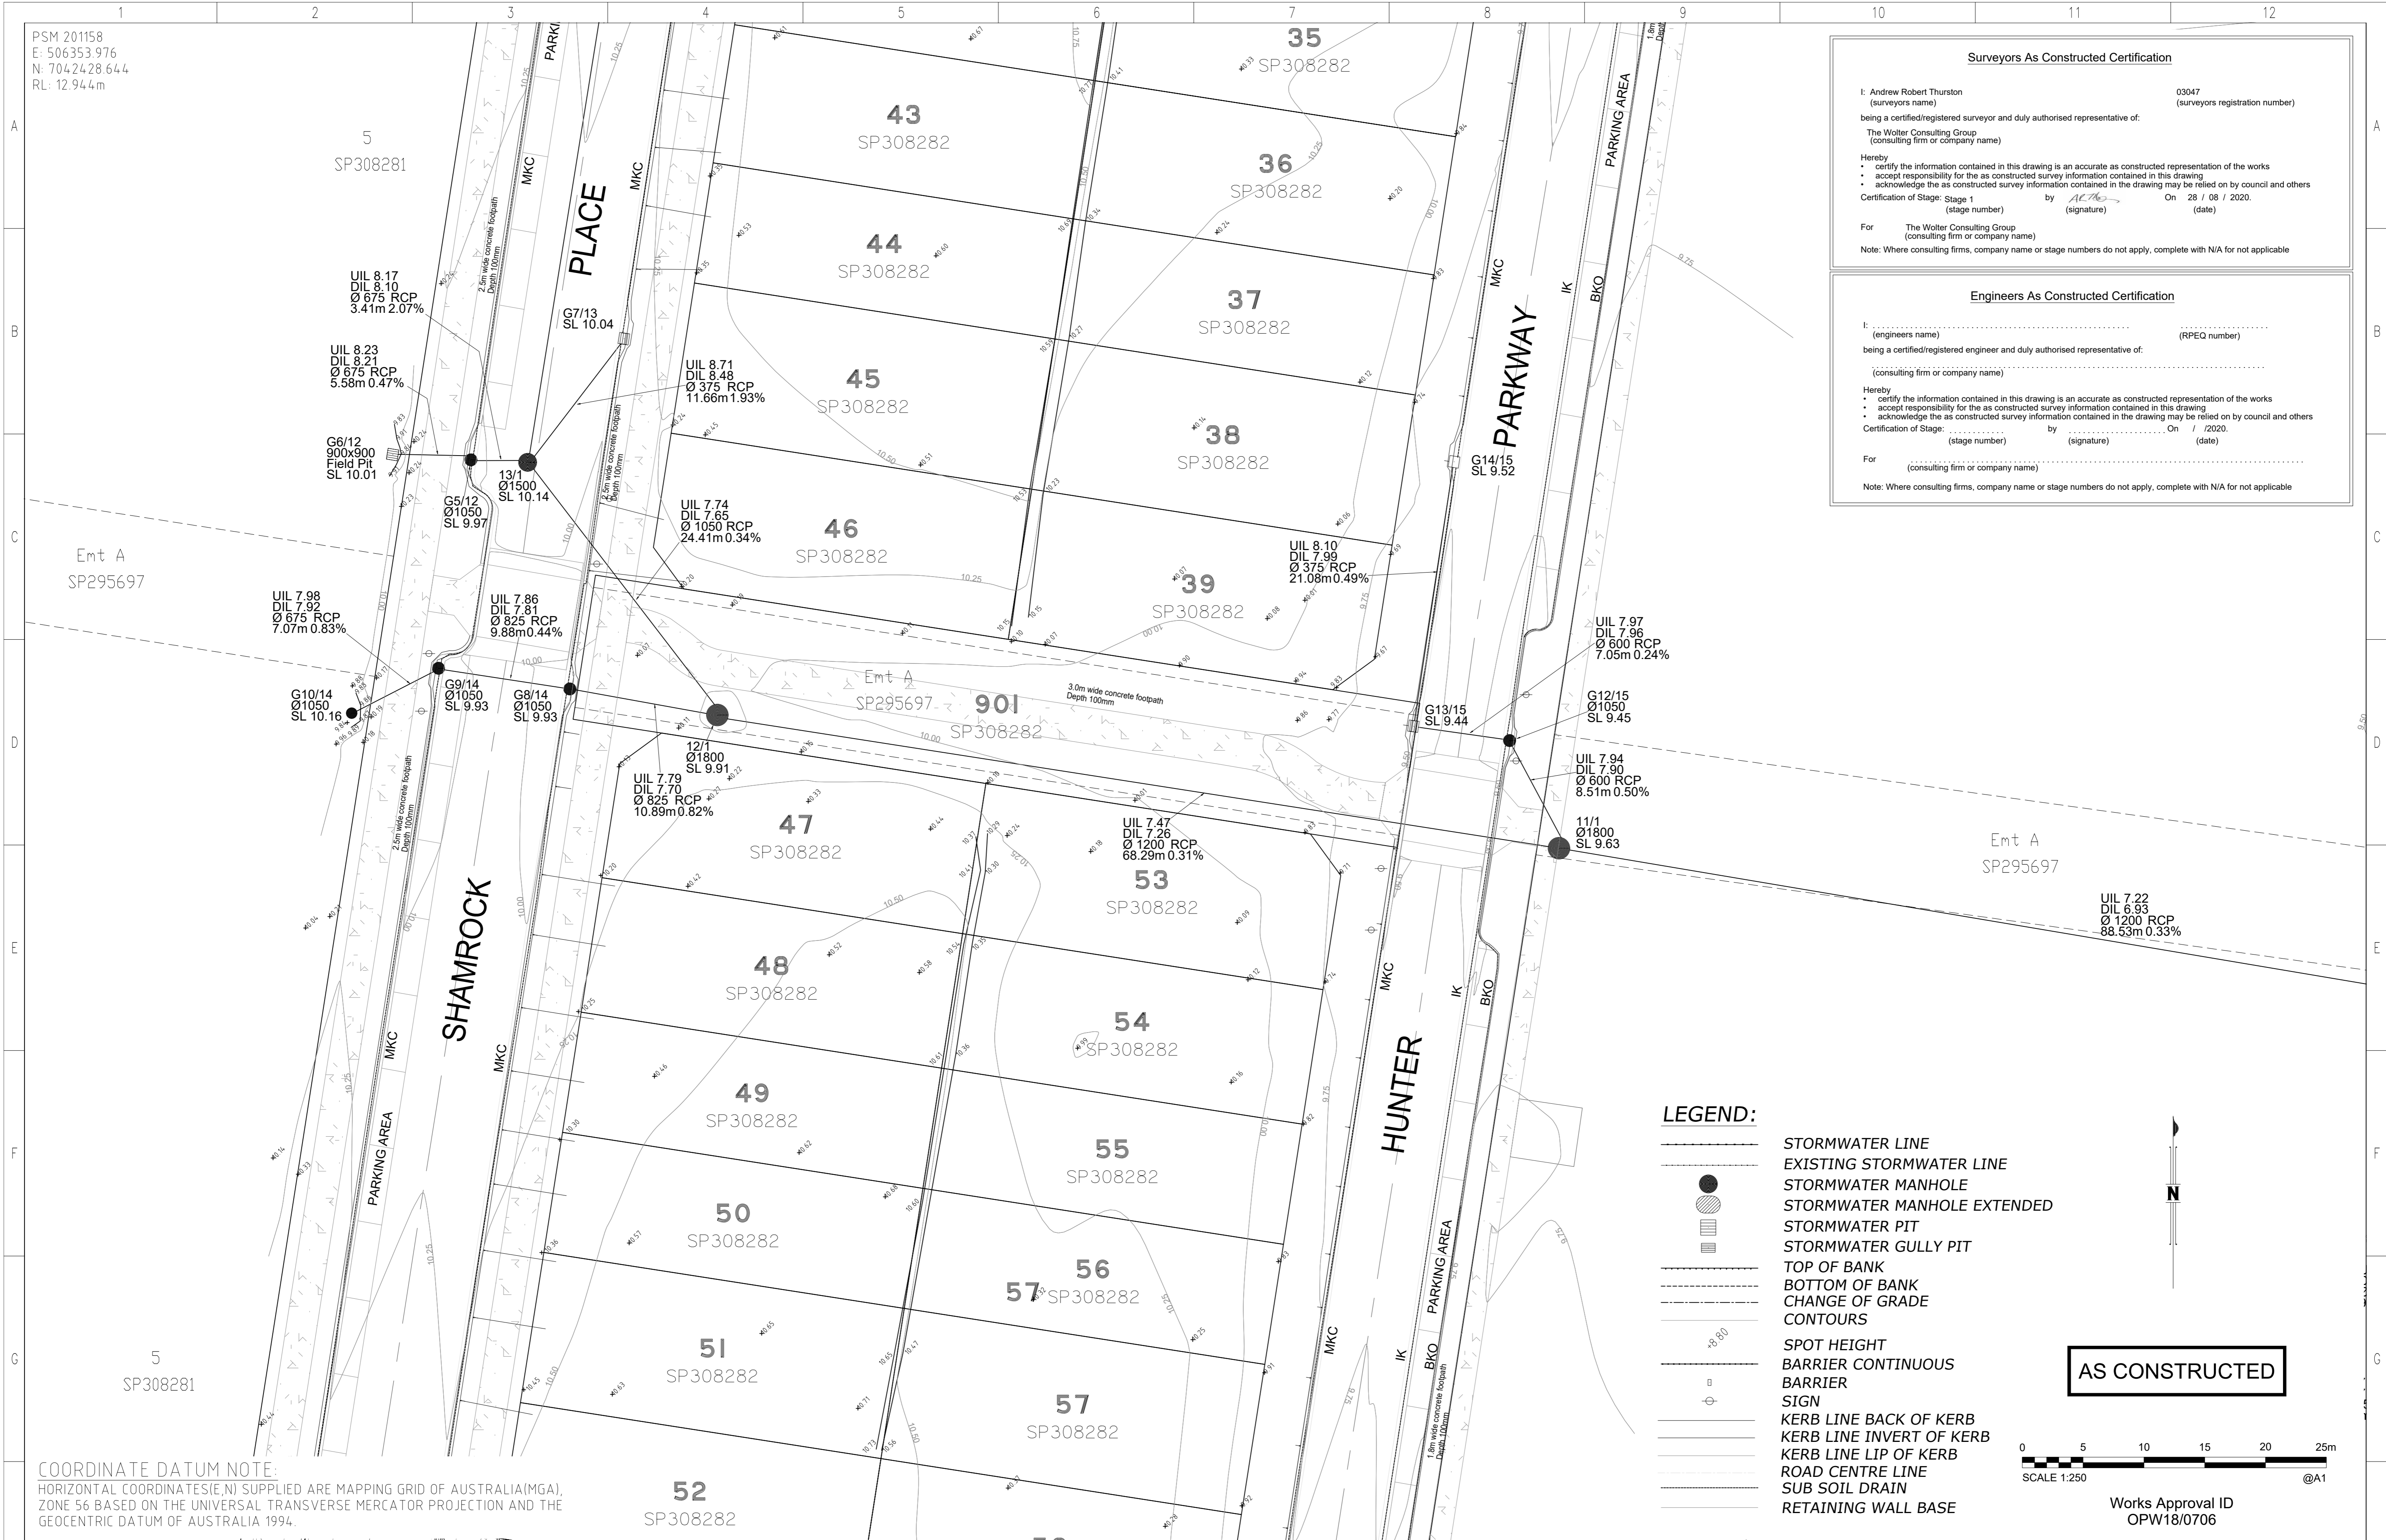

COORDINATE DATUM NOTE:
 HORIZONTAL COORDINATES (E, N) SUPPLIED ARE MAPPING GRID OF AUSTRALIA (MGA), ZONE 56 BASED ON THE UNIVERSAL TRANSVERSE MERCATOR PROJECTION AND THE GEOCENTRIC DATUM OF AUSTRALIA 1994.

DRAWING REVISIONS		REFERENCE DRAWINGS		DESIGN FILE No.	DESIGNED
REV.	REVISION DESCRIPTION	DRG. No.	DESCRIPTION	CONSTRUCT. No.	DATE
A	AS CONSTRUCTED				
B	AS CONSTRUCTED - NEW BASIN				
C	AS CONSTRUCTED - SIGN/RW ADDED				

DESIGNED	DATE	DESIGNED	DATE
JWB	28.08.2020	ADH	28.08.2020

WOLTER consulting group

Planning Urban Design Landscape Environment Surveying

Brisbane: Level 2, 1 Breakfast Ck Road, Newstead, QLD 4006 Phone: (07) 3666 5200

SCALE 1:250 ORIGINAL SIZE A1

SUNSHINE COAST COUNCIL

CALOUNDRA OFFICE
 1 OMRAH AVENUE, CALOUNDRA QLD 4551

MAROOCHYDORE OFFICE
 10 FIRST AVENUE, MAROOCHYDORE QLD 4558

NAMBOUR OFFICE
 Chr CURRIE and BURY STREETS, NAMBOUR QLD 4560

LOCKED BAG 72, SUNSHINE COAST
 MAIL CENTRE QLD 4560
 Telephone: (07) 5475 7528
 Fax: (07) 5475 7277

VILLAGE GREEN


STAGE 1
 AS CONSTRUCTED
 ROADS, DRAINAGE AND SURFACE

SUBDIVISION REFERENCE	
RAL 180186 SCC	
No. 5 OF 13 PLANS	
ASCON GRID NUMBER	REV.
	C

PSM 201158
 E: 506353.976
 N: 7042428.644
 RL: 12.944m

LEGEND:

- STORMWATER LINE
- - - EXISTING STORMWATER LINE
- STORMWATER MANHOLE
- STORMWATER MANHOLE EXTENDED
- STORMWATER PIT
- STORMWATER GULLY PIT
- TOP OF BANK
- - - BOTTOM OF BANK
- - - CHANGE OF GRADE
- CONTOURS
- SPOT HEIGHT
- BARRIER CONTINUOUS
- BARRIER
- SIGN
- KERB LINE BACK OF KERB
- KERB LINE INVERT OF KERB
- KERB LINE LIP OF KERB
- ROAD CENTRE LINE
- SUB SOIL DRAIN
- RETAINING WALL BASE

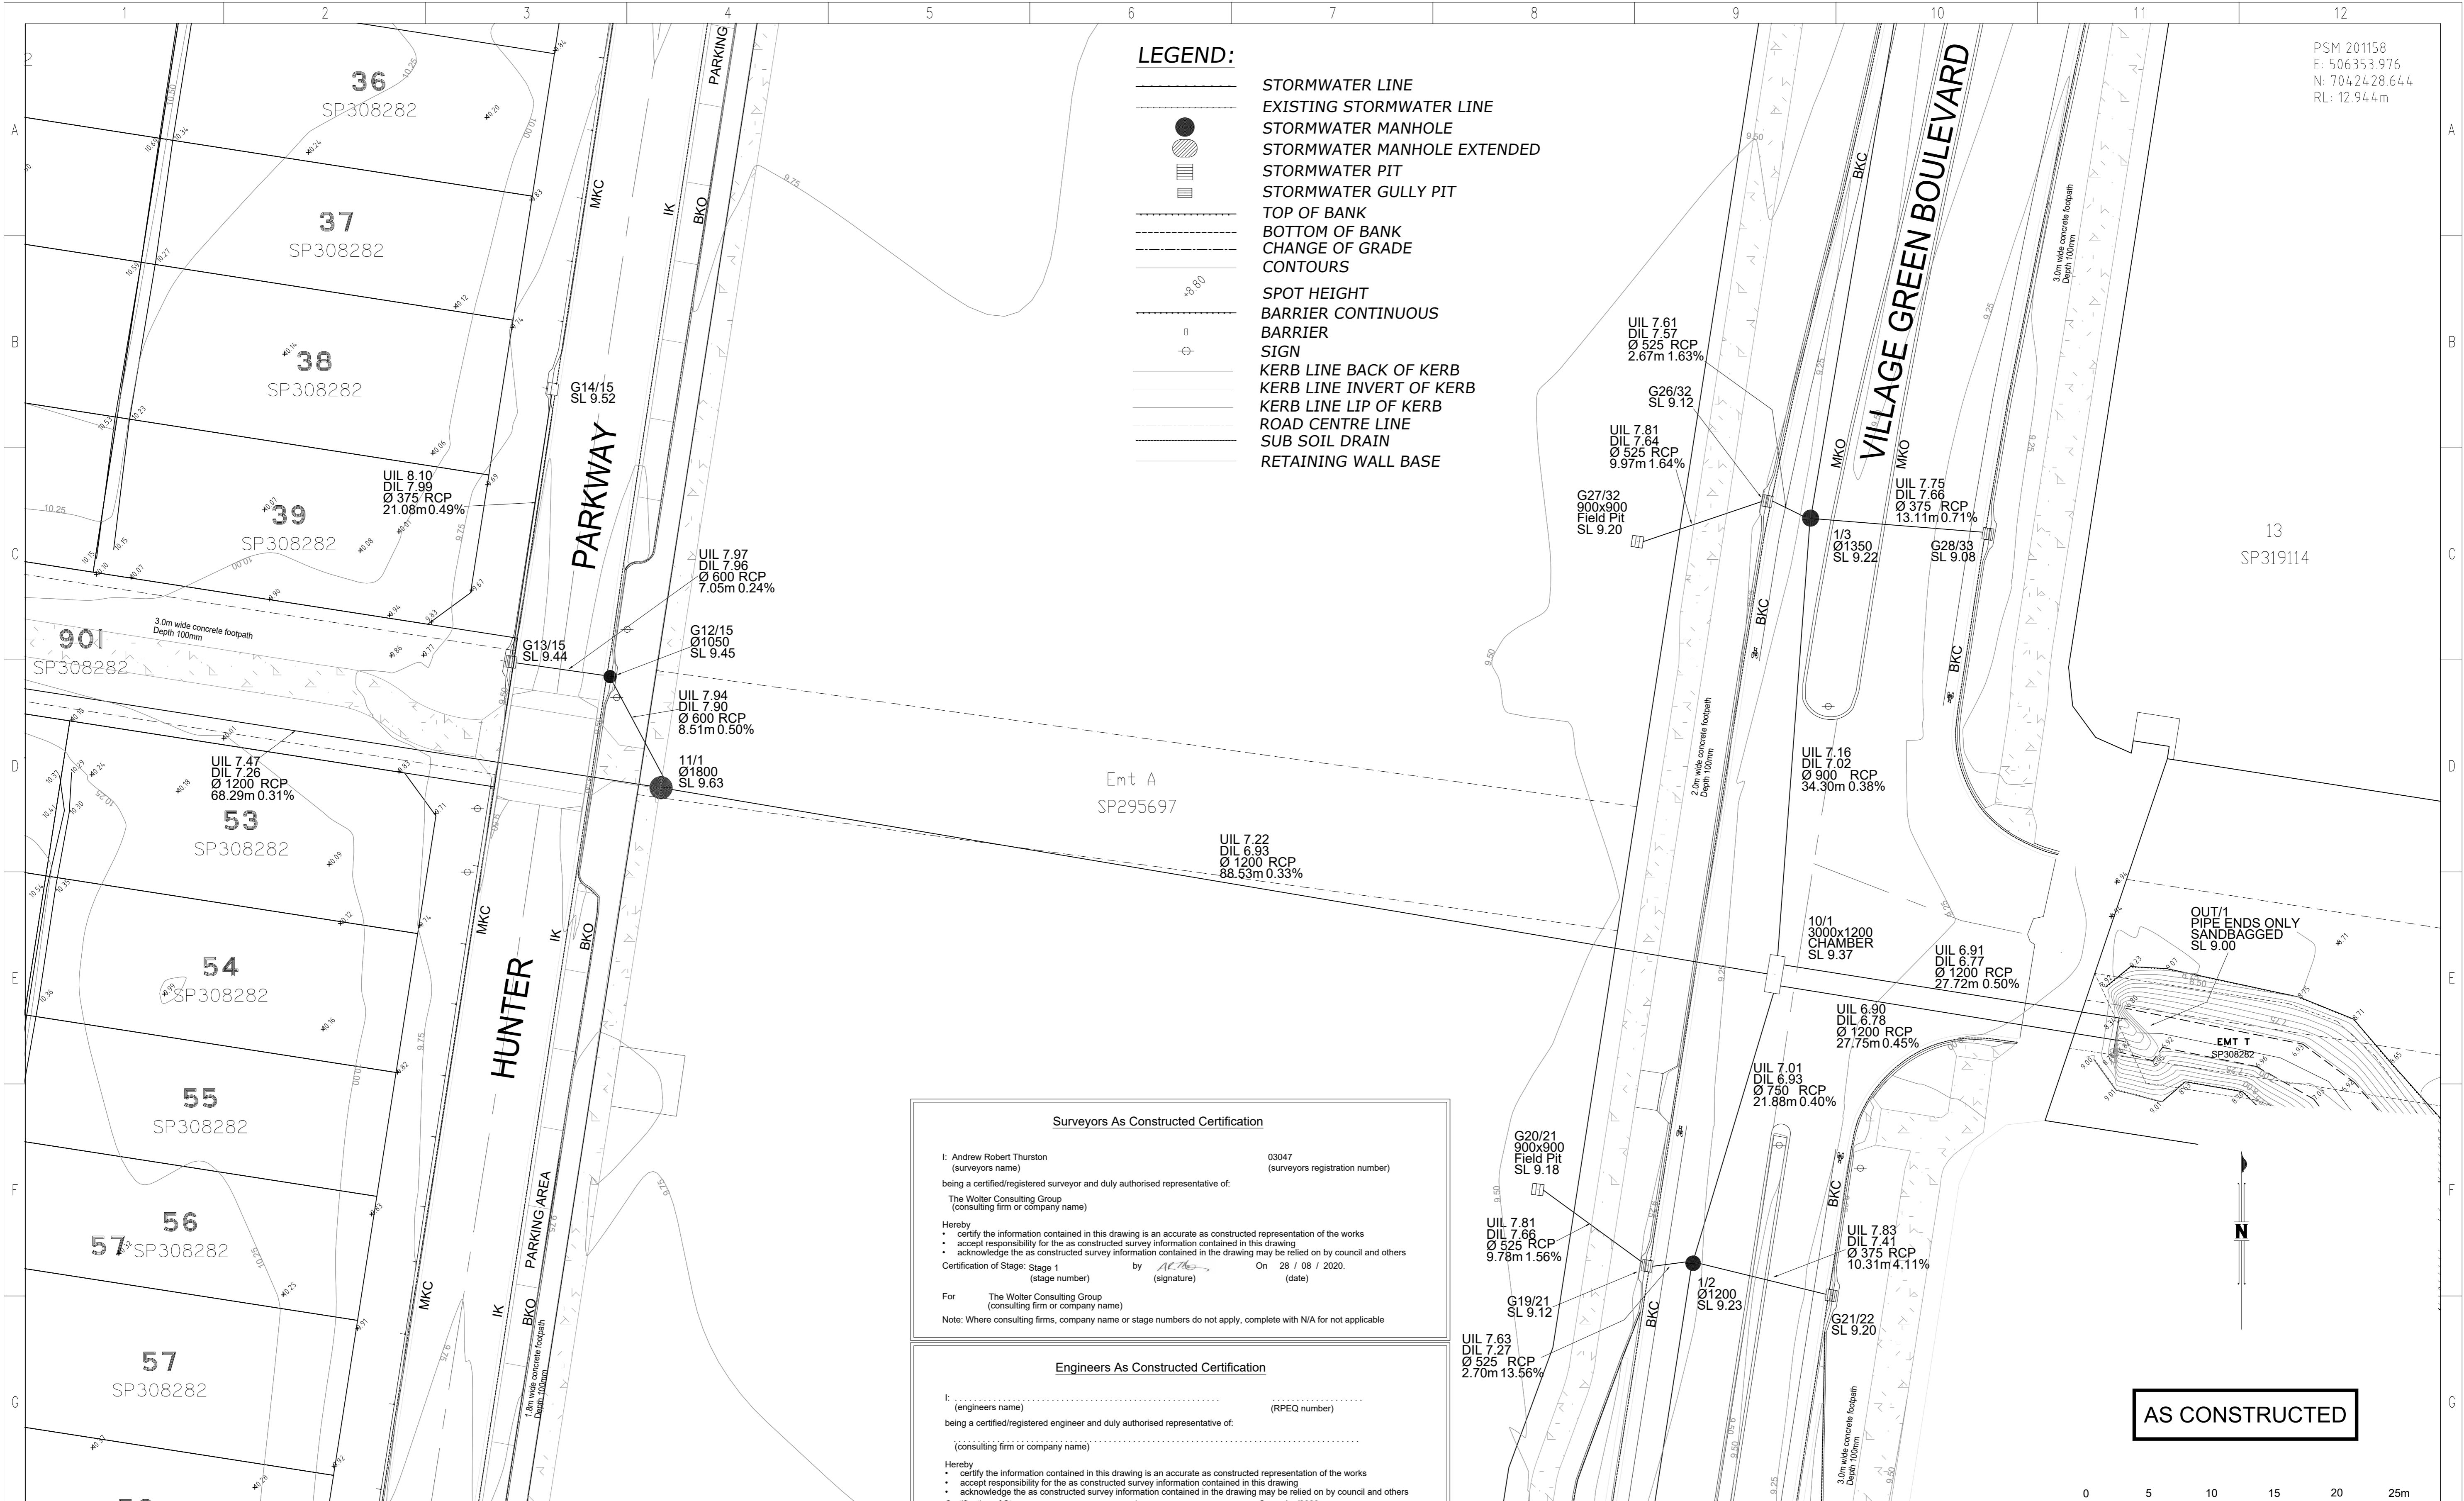

Surveyors As Constructed Certification

I: Andrew Robert Thurston (surveyors name) 03047 (surveyors registration number)
 being a certified/registered surveyor and duly authorised representative of:
 The Wolter Consulting Group (consulting firm or company name)

Herby:

- certify the information contained in this drawing is an accurate as constructed representation of the works
- accept responsibility for the as constructed survey information contained in this drawing
- acknowledge the as constructed survey information contained in the drawing may be relied on by council and others

Certification of Stage: Stage 1 by *ATB* On 28 / 08 / 2020.
 (stage number) (signature) (date)

For The Wolter Consulting Group (consulting firm or company name)
 Note: Where consulting firms, company name or stage numbers do not apply, complete with N/A for not applicable

Engineers As Constructed Certification

I: (engineers name) (RPEQ number)
 being a certified/registered engineer and duly authorised representative of:
 (consulting firm or company name)

Herby:

- certify the information contained in this drawing is an accurate as constructed representation of the works
- accept responsibility for the as constructed survey information contained in this drawing
- acknowledge the as constructed survey information contained in the drawing may be relied on by council and others

Certification of Stage: by On / / 2020.
 (stage number) (signature) (date)

For (consulting firm or company name)
 Note: Where consulting firms, company name or stage numbers do not apply, complete with N/A for not applicable

COORDINATE DATUM NOTE:
 HORIZONTAL COORDINATES(E,N) SUPPLIED ARE MAPPING GRID OF AUSTRALIA(MGA), ZONE 56 BASED ON THE UNIVERSAL TRANSVERSE MERCATOR PROJECTION AND THE GEOCENTRIC DATUM OF AUSTRALIA 1994.

AS CONSTRUCTED



Works Approval ID
 OPW18/0706

DRAWING REVISIONS		REFERENCE DRAWINGS		DESIGN FILE No.	DESIGNED
REV.	REVISION DESCRIPTION	DRG. No.	DESCRIPTION	CONSTRUCT. No.	DATE
A	AS CONSTRUCTED				
B	AS CONSTRUCTED - NEW BASIN			SS3787	28.08.2020
C	AS CONSTRUCTED - SIGN/RW ADDED				

WOLTER consulting group

Planning Urban Design Landscape Environment Surveying

Brisbane: Level 2, 1 Breakfast Ck Road, Newstead, QLD 4006 Phone: (07) 3666 5200

SCALE 1:250 ORIGINAL SIZE A1

SUNSHINE COAST COUNCIL

CALOUNDRA OFFICE
 1 OMRAH AVENUE, CALOUNDRA QLD 4551

MAROOCHYDORE OFFICE
 10 FIRST AVENUE, MAROOCHYDORE QLD 4558

NAMBOUR OFFICE
 CAR CURRIE and BURY STREETS, NAMBOUR QLD 4560

LOCKED BAG 72, SUNSHINE COAST
 MAIL CENTRE QLD 4560
 Telephone: (07) 5475 7528
 Fax: (07) 5475 7277

VILLAGE GREEN

STAGE 1
 AS CONSTRUCTED
 ROADS, DRAINAGE AND SURFACE

SUBDIVISION REFERENCE	
RAL 180186 SCC	
No. 6 OF 13 PLANS	
ASCON GRID NUMBER	REV.
	C

PSM 201158
 E: 506353.976
 N: 7042428.644
 RL: 12.944m

Surveyors As Constructed Certification

I: Andrew Robert Thurston (surveyors name) 03047 (surveyors registration number)
 being a certified/registered surveyor and duly authorised representative of:
 The Wolter Consulting Group (consulting firm or company name)

Hereby
 • certify the information contained in this drawing is an accurate as constructed representation of the works
 • accept responsibility for the as constructed survey information contained in this drawing
 • acknowledge the as constructed survey information contained in the drawing may be relied on by council and others

Certification of Stage: Stage 1 (stage number) by *ACT* (signature) On 28 / 08 / 2020. (date)

For The Wolter Consulting Group (consulting firm or company name)

Note: Where consulting firms, company name or stage numbers do not apply, complete with N/A for not applicable

Engineers As Constructed Certification

I: (engineers name) (RPEQ number)
 being a certified/registered engineer and duly authorised representative of:
 (consulting firm or company name)

Hereby
 • certify the information contained in this drawing is an accurate as constructed representation of the works
 • accept responsibility for the as constructed survey information contained in this drawing
 • acknowledge the as constructed survey information contained in the drawing may be relied on by council and others

Certification of Stage: (stage number) by (signature) On / / 2020. (date)

For (consulting firm or company name)

Note: Where consulting firms, company name or stage numbers do not apply, complete with N/A for not applicable



- LEGEND:**
- STORMWATER LINE
 - EXISTING STORMWATER LINE
 - STORMWATER MANHOLE
 - STORMWATER MANHOLE EXTENDED
 - STORMWATER PIT
 - STORMWATER GULLY PIT
 - TOP OF BANK
 - BOTTOM OF BANK
 - CHANGE OF GRADE
 - CONTOURS
 - SPOT HEIGHT
 - BARRIER CONTINUOUS
 - BARRIER
 - SIGN
 - KERB LINE BACK OF KERB
 - KERB LINE INVERT OF KERB
 - KERB LINE LIP OF KERB
 - ROAD CENTRE LINE
 - SUB SOIL DRAIN
 - RETAINING WALL BASE

COORDINATE DATUM NOTE:
 HORIZONTAL COORDINATES(E,N) SUPPLIED ARE MAPPING GRID OF AUSTRALIA(MGA),
 ZONE 56 BASED ON THE UNIVERSAL TRANSVERSE MERCATOR PROJECTION AND THE
 GEOCENTRIC DATUM OF AUSTRALIA 1994.

DRAWING REVISIONS		REFERENCE DRAWINGS		DESIGN FILE No.	DESIGNED
REV.	REVISION DESCRIPTION	DRG. No.	DESCRIPTION	CONSTRUCT. No.	DATE
A	AS CONSTRUCTED				
B	AS CONSTRUCTED - NEW BASIN			SS3787	28.08.2020
C	AS CONSTRUCTED - SIGN/RW ADDED				

WOLTER consulting group

Planning Urban Design Landscape Environment Surveying

Brisbane: Level 2, 1 Breakfast Ck Road, Newstead, QLD 4006 Phone: (07) 3666 5200

SCALE 1:250 ORIGINAL SIZE A1

SUNSHINE COAST COUNCIL

CALOUNDRA OFFICE
 1 OMRAH AVENUE, CALOUNDRA QLD 4551

MAROOCHYDORE OFFICE
 10 FIRST AVENUE, MAROOCHYDORE QLD 4558

NAMBOUR OFFICE
 Cnr CURRIE and BURY STREETS, NAMBOUR QLD 4560

LOCKED BAG 72, SUNSHINE COAST
 MAIL CENTRE QLD 4560
 Telephone: (07) 5475 7528
 Fax: (07) 5475 7277

VILLAGE GREEN

STAGE 1
 AS CONSTRUCTED
 ROADS, DRAINAGE AND SURFACE


SUBDIVISION REFERENCE	
RAL 180186 SCC	
No. 7 OF 13 PLANS	
ASCON GRID NUMBER	REV.
	C

UIL 7.52
 DIL 7.17
 Ø 600 RCP
 61.19m 0.56%

900
 SP308282

UIL 8.74
 DIL 8.48
 Ø 375 RCP
 32.89m 0.79%

UIL 8.39
 DIL 7.86
 Ø 450 RCP
 61.64m 0.87%

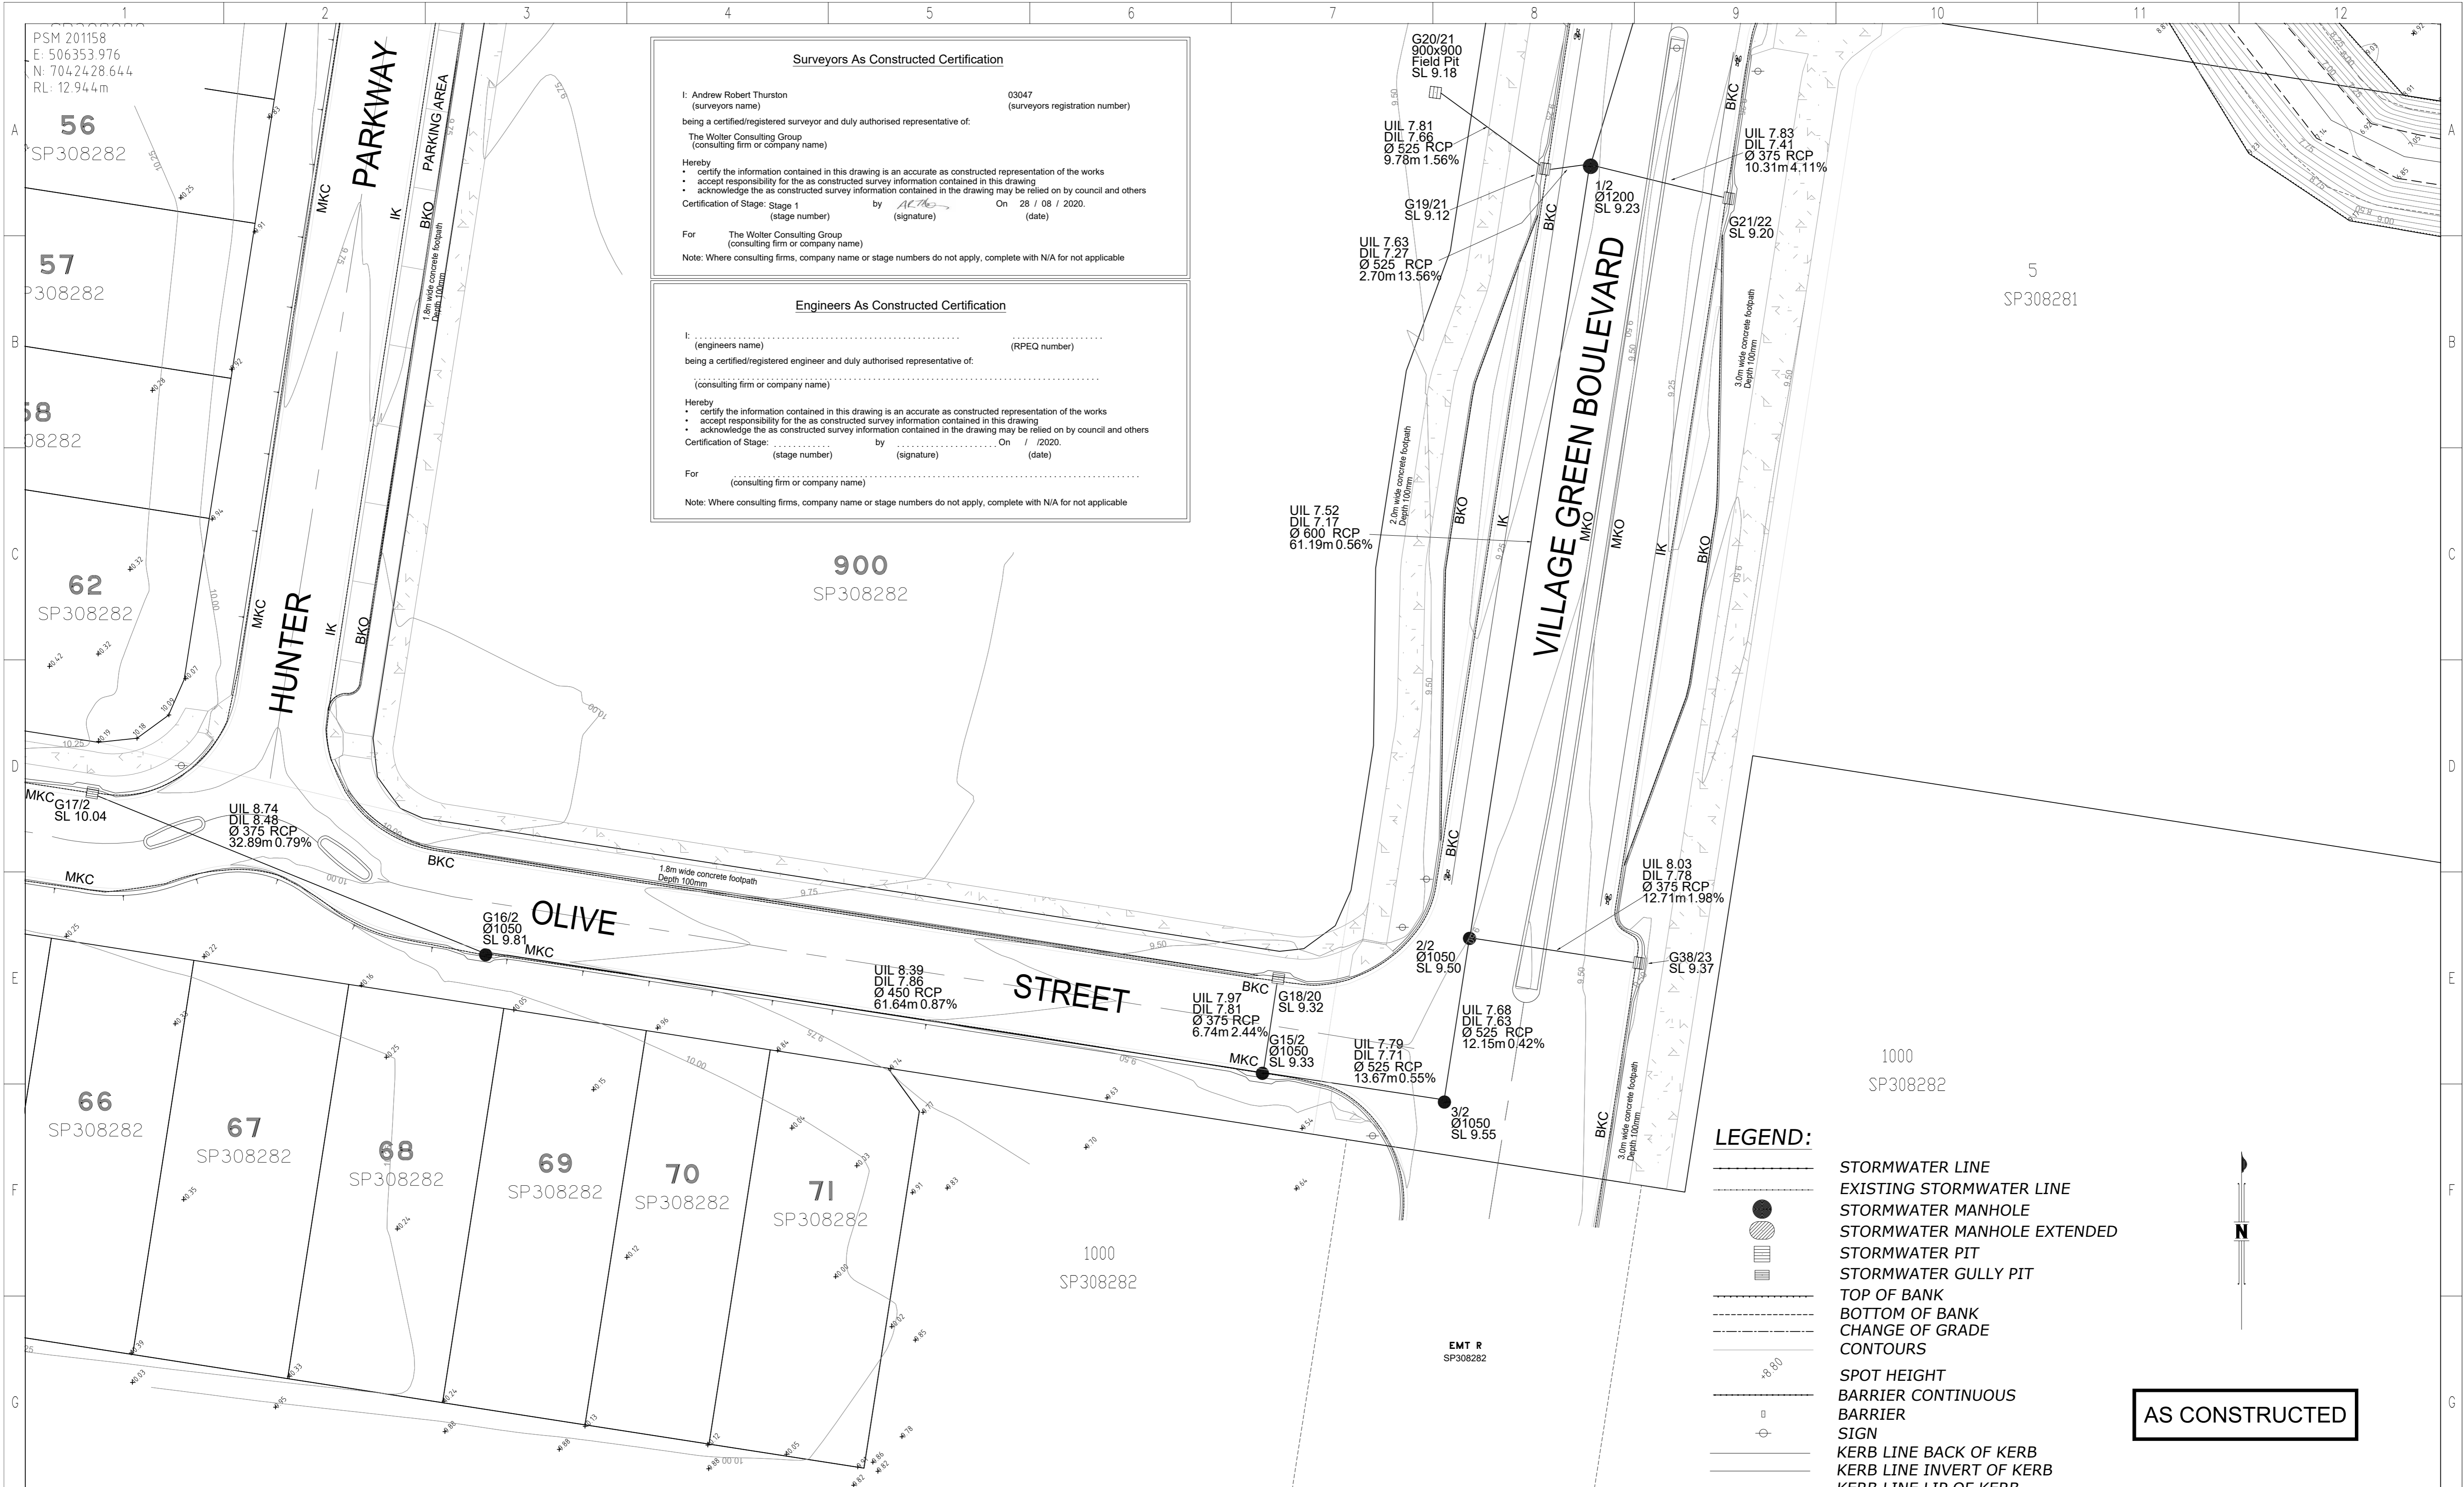

Surveyors As Constructed Certification

I: Andrew Robert Thurston (surveyors name) 03047 (surveyors registration number)
 being a certified/registered surveyor and duly authorised representative of:
 The Woller Consulting Group (consulting firm or company name)

Hereby
 • certify the information contained in this drawing is an accurate as constructed representation of the works
 • accept responsibility for the as constructed survey information contained in this drawing
 • acknowledge the as constructed survey information contained in the drawing may be relied on by council and others

Certification of Stage: Stage 1 by AC 76 On 28 / 08 / 2020.
 (stage number) (signature) (date)

For The Woller Consulting Group (consulting firm or company name)
 Note: Where consulting firms, company name or stage numbers do not apply, complete with N/A for not applicable

Engineers As Constructed Certification

I: (engineers name) (RPEQ number)
 being a certified/registered engineer and duly authorised representative of:
 (consulting firm or company name)

Hereby
 • certify the information contained in this drawing is an accurate as constructed representation of the works
 • accept responsibility for the as constructed survey information contained in this drawing
 • acknowledge the as constructed survey information contained in the drawing may be relied on by council and others

Certification of Stage: (stage number) by (signature) On / / 2020.
 (stage number) (signature) (date)

For (consulting firm or company name)
 Note: Where consulting firms, company name or stage numbers do not apply, complete with N/A for not applicable

LEGEND:

- STORMWATER LINE
- EXISTING STORMWATER LINE
- STORMWATER MANHOLE
- STORMWATER MANHOLE EXTENDED
- STORMWATER PIT
- STORMWATER GULLY PIT
- TOP OF BANK
- BOTTOM OF BANK
- CHANGE OF GRADE
- CONTOURS
- SPOT HEIGHT
- BARRIER CONTINUOUS
- BARRIER
- SIGN
- KERB LINE BACK OF KERB
- KERB LINE INVERT OF KERB
- KERB LINE LIP OF KERB
- ROAD CENTRE LINE
- SUB SOIL DRAIN
- RETAINING WALL BASE

AS CONSTRUCTED



COORDINATE DATUM NOTE:
 HORIZONTAL COORDINATES(E,N) SUPPLIED ARE MAPPING GRID OF AUSTRALIA(MGA), ZONE 56 BASED ON THE UNIVERSAL TRANSVERSE MERCATOR PROJECTION AND THE GEOCENTRIC DATUM OF AUSTRALIA 1994.

DRAWING REVISIONS		REFERENCE DRAWINGS		DESIGN FILE No.	DESIGNED
REV.	REVISION DESCRIPTION	DRG. No.	DESCRIPTION	CONSTRUCT. No.	DATE
A	AS CONSTRUCTED				
B	AS CONSTRUCTED - NEW BASIN				
C	AS CONSTRUCTED - SIGN/RW ADDED				

FIELD BOOK	CHECKED	DATE
SS3787	ADH	28.08.2020

LEVEL DATUM	AHD	DATE
MGA-56		28.08.2020


WOLLER
 consulting group
 Planning Urban Design Landscape Environment Surveying
 Brisbane: Level 2, 1 Breakfast Ck Road, Newstead, QLD 4006 Phone: (07) 3666 5200

SCALE 1:250 ORIGINAL SIZE A1

SUNSHINE COAST COUNCIL
 CALOUNDRA OFFICE
 1 OMARAH AVENUE, CALOUNDRA QLD 4551
 MAROOCHYDORE OFFICE
 10 FIRST AVENUE, MAROOCHYDORE QLD 4558
 NAMBOUR OFFICE
 Chr CURRIE and BURY STREETS, NAMBOUR QLD 4560
 LOCKED BAG 72, SUNSHINE COAST
 MAIL CENTRE QLD 4560
 Telephone: (07) 5475 7528
 Fax: (07) 5475 7277

VILLAGE GREEN
 STAGE 1
 AS CONSTRUCTED
 ROADS, DRAINAGE AND SURFACE

SUBDIVISION REFERENCE	
RAL 180186 SCC	
No. 8 OF 13 PLANS	
ASCON GRID NUMBER	REV.
	C

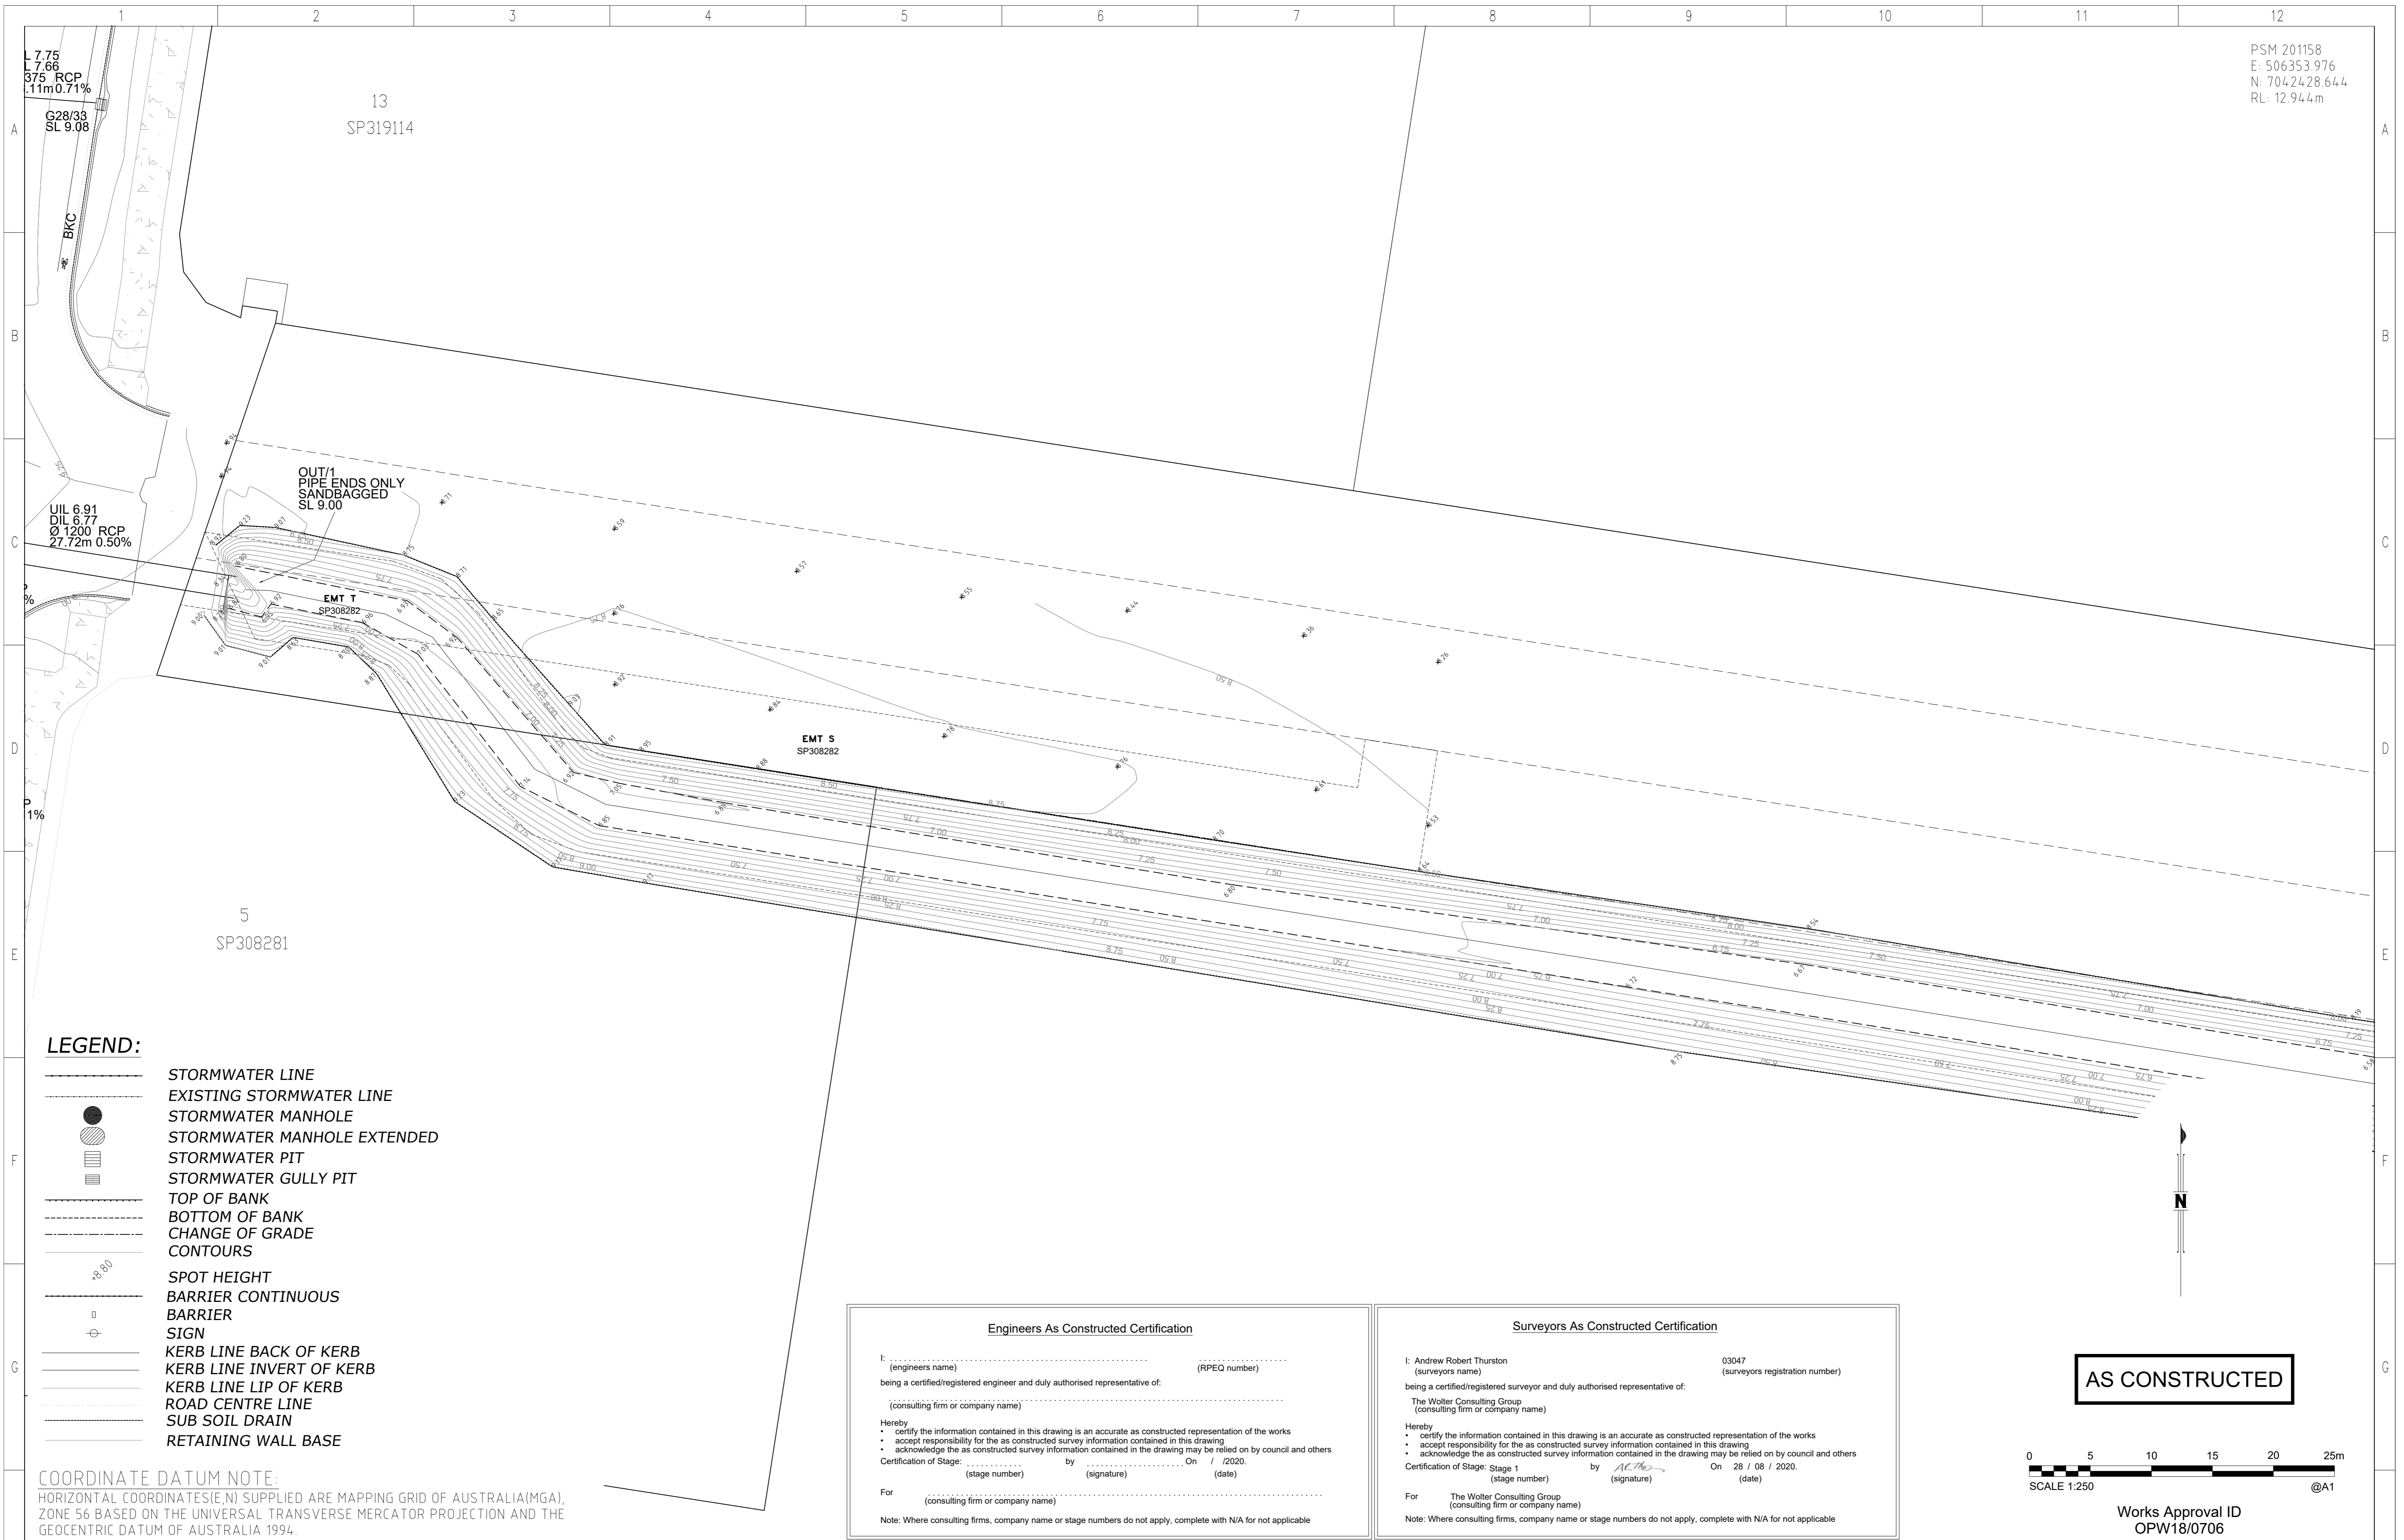

PSM 201158
 E: 506353.976
 N: 7042428.644
 RL: 12.944m

L 7.75
 L 7.68
 375 RCP
 1.11m 0.71%
 G28/38
 SL 9.08

UIL 6.91
 DIL 6.77
 Ø 1200 RCP
 27.72m 0.50%

- LEGEND:**
- STORMWATER LINE
 - EXISTING STORMWATER LINE
 - STORMWATER MANHOLE
 - ⊗ STORMWATER MANHOLE EXTENDED
 - ▭ STORMWATER PIT
 - ▭ STORMWATER GULLY PIT
 - TOP OF BANK
 - BOTTOM OF BANK
 - CHANGE OF GRADE
 - CONTOURS
 - +8.80 SPOT HEIGHT
 - BARRIER CONTINUOUS
 - BARRIER
 - ⊕ SIGN
 - KERB LINE BACK OF KERB
 - KERB LINE INVERT OF KERB
 - KERB LINE LIP OF KERB
 - ROAD CENTRE LINE
 - SUB SOIL DRAIN
 - RETAINING WALL BASE

COORDINATE DATUM NOTE:
 HORIZONTAL COORDINATES(E,N) SUPPLIED ARE MAPPING GRID OF AUSTRALIA(MGA), ZONE 56 BASED ON THE UNIVERSAL TRANSVERSE MERCATOR PROJECTION AND THE GEOCENTRIC DATUM OF AUSTRALIA 1994.

Engineers As Constructed Certification

I: _____ (engineers name) (RPEQ number) _____
 being a certified/registered engineer and duly authorised representative of:
 _____ (consulting firm or company name)

Hereby
 • certify the information contained in this drawing is an accurate as constructed representation of the works
 • accept responsibility for the as constructed survey information contained in this drawing
 • acknowledge the as constructed survey information contained in the drawing may be relied on by council and others

Certification of Stage: _____ by _____ On ____ / ____ / 2020.
 (stage number) (signature) (date)

For _____ (consulting firm or company name)

Note: Where consulting firms, company name or stage numbers do not apply, complete with N/A for not applicable

Surveyors As Constructed Certification

I: Andrew Robert Thurston 03047 (surveyors name) (surveyors registration number)
 being a certified/registered surveyor and duly authorised representative of:
 The Wolter Consulting Group (consulting firm or company name)

Hereby
 • certify the information contained in this drawing is an accurate as constructed representation of the works
 • accept responsibility for the as constructed survey information contained in this drawing
 • acknowledge the as constructed survey information contained in the drawing may be relied on by council and others

Certification of Stage: Stage 1 by _____ On 28 / 08 / 2020.
 (stage number) (signature) (date)

For The Wolter Consulting Group (consulting firm or company name)

Note: Where consulting firms, company name or stage numbers do not apply, complete with N/A for not applicable

AS CONSTRUCTED

0 5 10 15 20 25m
 SCALE 1:250 @A1

Works Approval ID
 OPW18/0706

DRAWING REVISIONS		REFERENCE DRAWINGS		DESIGN FILE No.	DESIGNED
REV.	REVISION DESCRIPTION	DRG. No.	DESCRIPTION	CONSTRUCT. No.	DATE
A	AS CONSTRUCTED				
B	AS CONSTRUCTED - NEW BASIN			SS3787	28.08.2020
C	AS CONSTRUCTED - SIGN/RW ADDED				
				AHD	28.08.2020
				MGA-56	

WOLTER consulting group

Planning Urban Design Landscape Environment Surveying

Brisbane: Level 2, 1 Breakfast Ck Road, Newstead, QLD 4006 Phone: (07) 3666 5200

SCALE 1:250 ORIGINAL SIZE A1

SUNSHINE COAST COUNCIL

CALOUNDRA OFFICE
 1 OMRAH AVENUE, CALOUNDRA QLD 4551

MAROOCHYDORE OFFICE
 10 FIRST AVENUE, MAROOCHYDORE QLD 4558

NAMBOUR OFFICE
 Cnr CURRIE and BURY STREETS, NAMBOUR QLD 4560


LOCKED BAG 72, SUNSHINE COAST
 MAIL CENTRE QLD 4560
 Telephone: (07) 5475 7528
 Fax: (07) 5475 7277

VILLAGE GREEN

**STAGE 1
 AS CONSTRUCTED
 ROADS, DRAINAGE AND SURFACE**

SUBDIVISION REFERENCE	
RAL 180186 SCC	
No. 9 OF 13 PLANS	
ASCON GRID NUMBER	REV.
	C

PSM 201158
 E: 506353.976
 N: 7042428.644
 RL: 12.944m

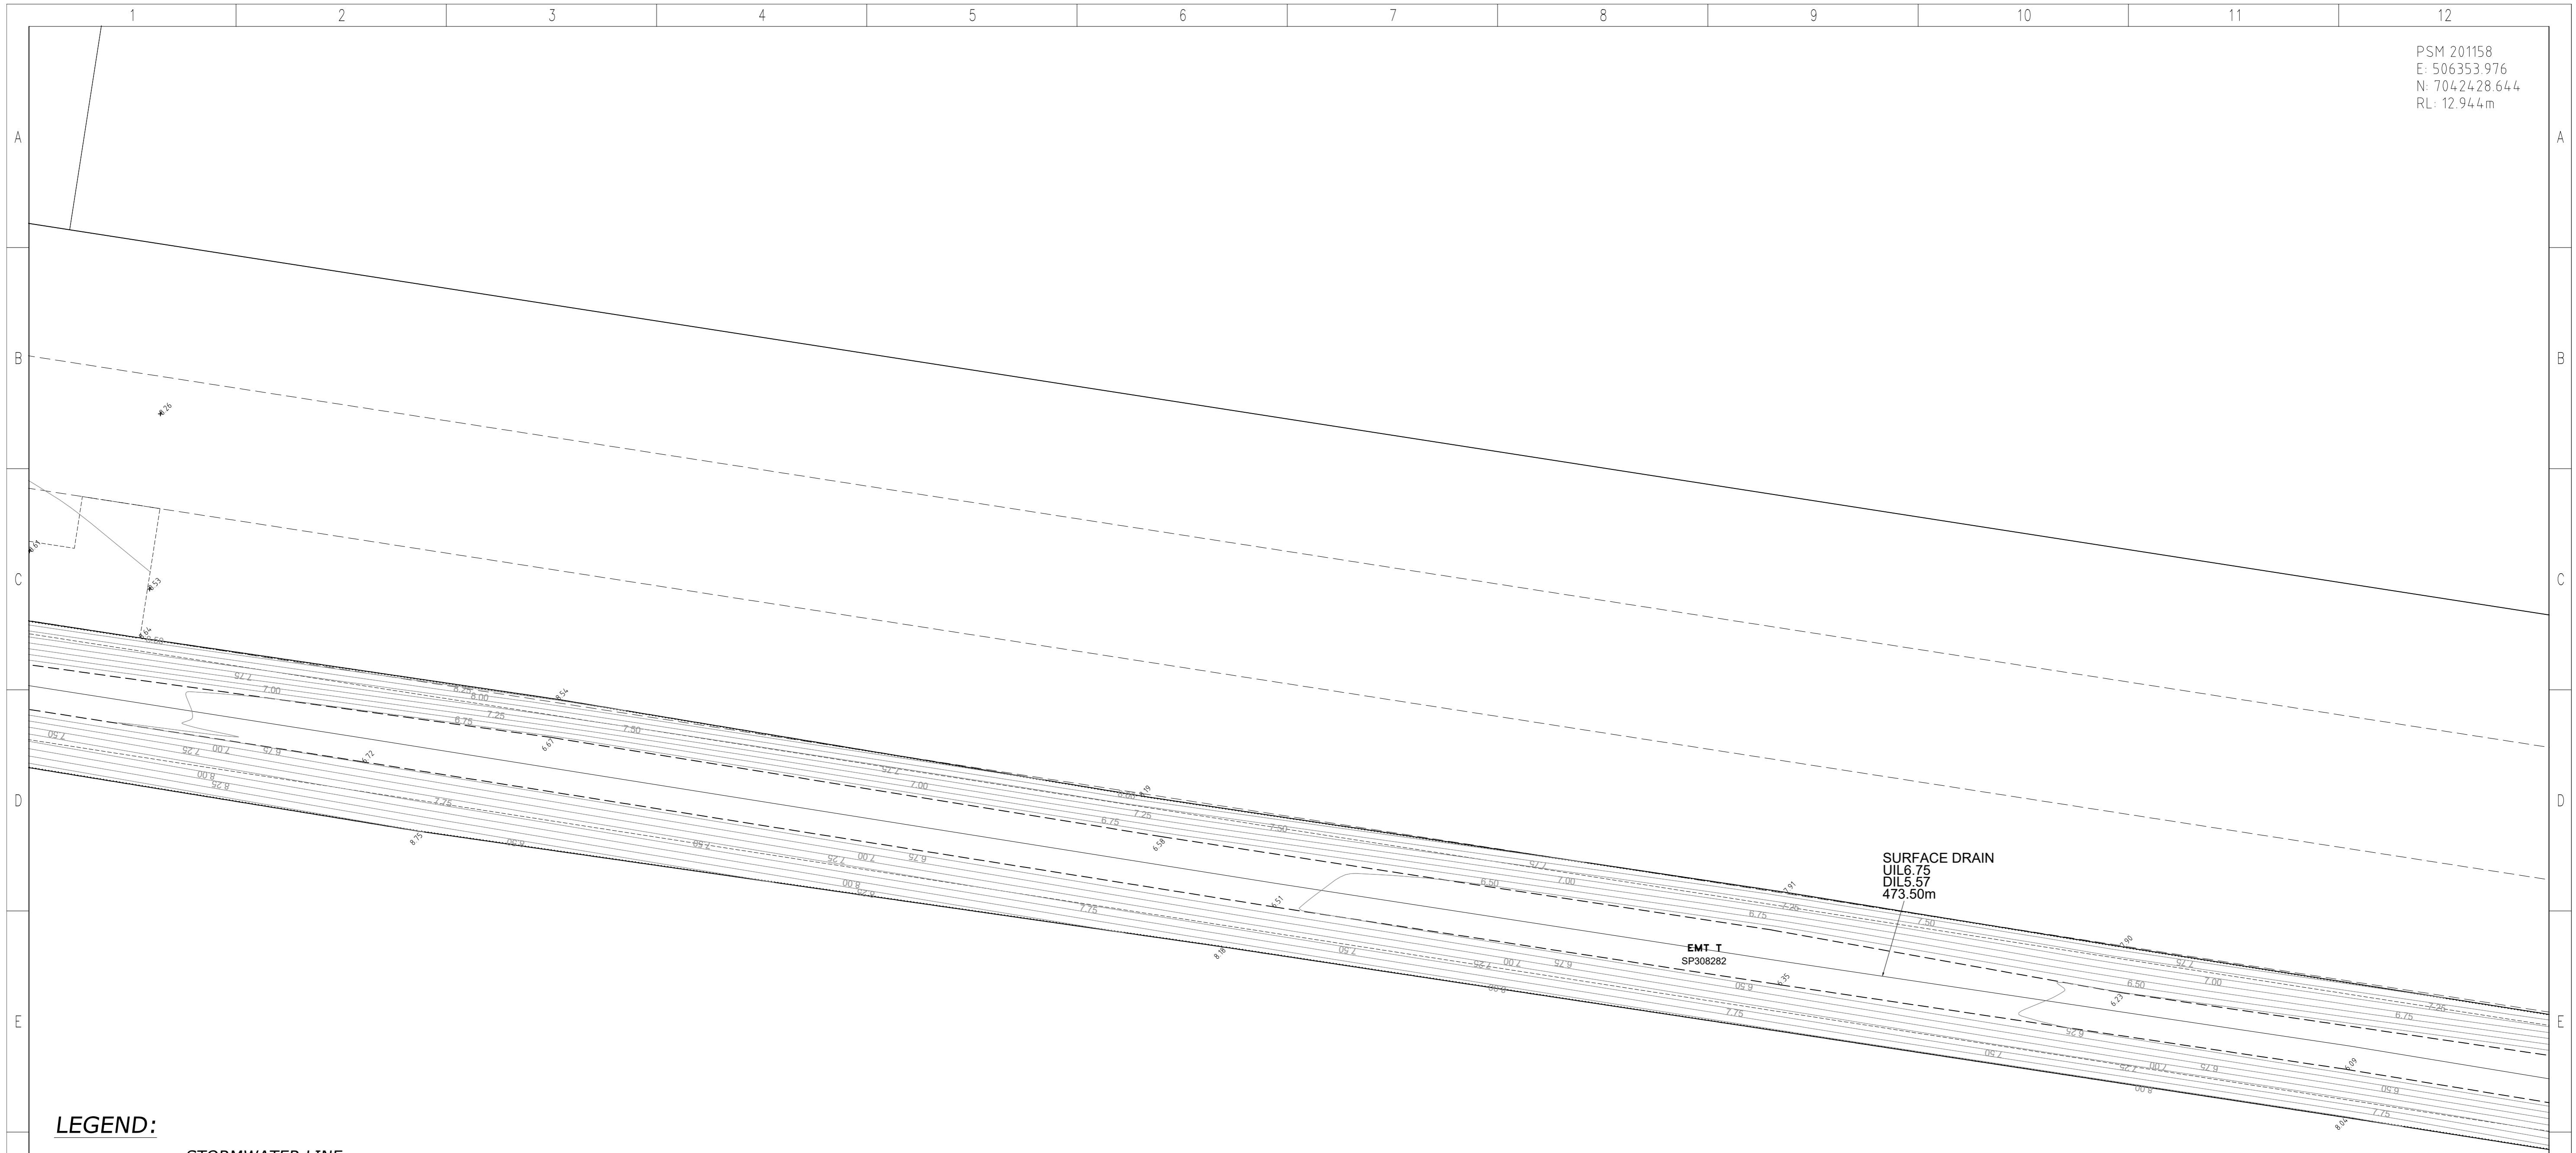

- LEGEND:**
- STORMWATER LINE
 - - - EXISTING STORMWATER LINE
 - STORMWATER MANHOLE
 - ⊗ STORMWATER MANHOLE EXTENDED
 - ▭ STORMWATER PIT
 - ▭ STORMWATER GULLY PIT
 - TOP OF BANK
 - BOTTOM OF BANK
 - CHANGE OF GRADE
 - CONTOURS
 - ⊕ SPOT HEIGHT
 - BARRIER CONTINUOUS
 - ▭ BARRIER
 - ⊕ SIGN
 - KERB LINE BACK OF KERB
 - KERB LINE INVERT OF KERB
 - KERB LINE LIP OF KERB
 - ROAD CENTRE LINE
 - SUB SOIL DRAIN
 - RETAINING WALL BASE

COORDINATE DATUM NOTE:
 HORIZONTAL COORDINATES(E,N) SUPPLIED ARE MAPPING GRID OF AUSTRALIA(MGA), ZONE 56 BASED ON THE UNIVERSAL TRANSVERSE MERCATOR PROJECTION AND THE GEOCENTRIC DATUM OF AUSTRALIA 1994.

Engineers As Constructed Certification

I, (engineers name) (RPEQ number)
 being a certified/registered engineer and duly authorised representative of:
 (consulting firm or company name)

Hereby
 • certify the information contained in this drawing is an accurate as constructed representation of the works
 • accept responsibility for the as constructed survey information contained in this drawing
 • acknowledge the as constructed survey information contained in the drawing may be relied on by council and others

Certification of Stage: by On / /2020.
 (stage number) (signature) (date)

For (consulting firm or company name)

Note: Where consulting firms, company name or stage numbers do not apply, complete with N/A for not applicable

Surveyors As Constructed Certification

I, Andrew Robert Thurston 03047 (surveyors registration number)
 being a certified/registered surveyor and duly authorised representative of:
 The Wolter Consulting Group (consulting firm or company name)

Hereby
 • certify the information contained in this drawing is an accurate as constructed representation of the works
 • accept responsibility for the as constructed survey information contained in this drawing
 • acknowledge the as constructed survey information contained in the drawing may be relied on by council and others

Certification of Stage: Stage 1 by On 28 / 08 / 2020.
 (stage number) (signature) (date)

For The Wolter Consulting Group (consulting firm or company name)

Note: Where consulting firms, company name or stage numbers do not apply, complete with N/A for not applicable

AS CONSTRUCTED



Works Approval ID
 OPW18/0706

DRAWING REVISIONS		REFERENCE DRAWINGS		DESIGN FILE No.	DESIGNED	
REV.	REVISION DESCRIPTION	DRG. No.	DESCRIPTION	CONSTRUCT. No.	DATE	
A	AS CONSTRUCTED					
B	AS CONSTRUCTED - NEW BASIN			SS3787	28.08.2020	JWB
C	AS CONSTRUCTED - SIGN/RW ADDED				28.08.2020	ADH


WOLTER
 consulting group
 Planning Urban Design Landscape Environment Surveying
 Brisbane: Level 2, 1 Breakfast Ck Road, Newstead, QLD 4006 Phone: (07) 3666 5200

SUNSHINE COAST COUNCIL
 CALOUNDRA OFFICE
 1 OMRAH AVENUE, CALOUNDRA QLD 4551
 MAROOCHYDORE OFFICE
 10 FIRST AVENUE, MAROOCHYDORE QLD 4558
 NAMBOUR OFFICE
 Cnr CURRIE and BURY STREETS, NAMBOUR QLD 4560
 LOCKED BAG 72, SUNSHINE COAST
 MAIL CENTRE QLD 4560
 Telephone: (07) 5475 7528
 Fax: (07) 5475 7277

VILLAGE GREEN
 STAGE 1
 AS CONSTRUCTED
 ROADS, DRAINAGE AND SURFACE

SUBDIVISION REFERENCE	
RAL 180186 SCC	
No. 10 OF 13 PLANS	
ASCON GRID NUMBER	REV.
	C

PSM 201158
 E: 506353.976
 N: 7042428.644
 RL: 12.944m

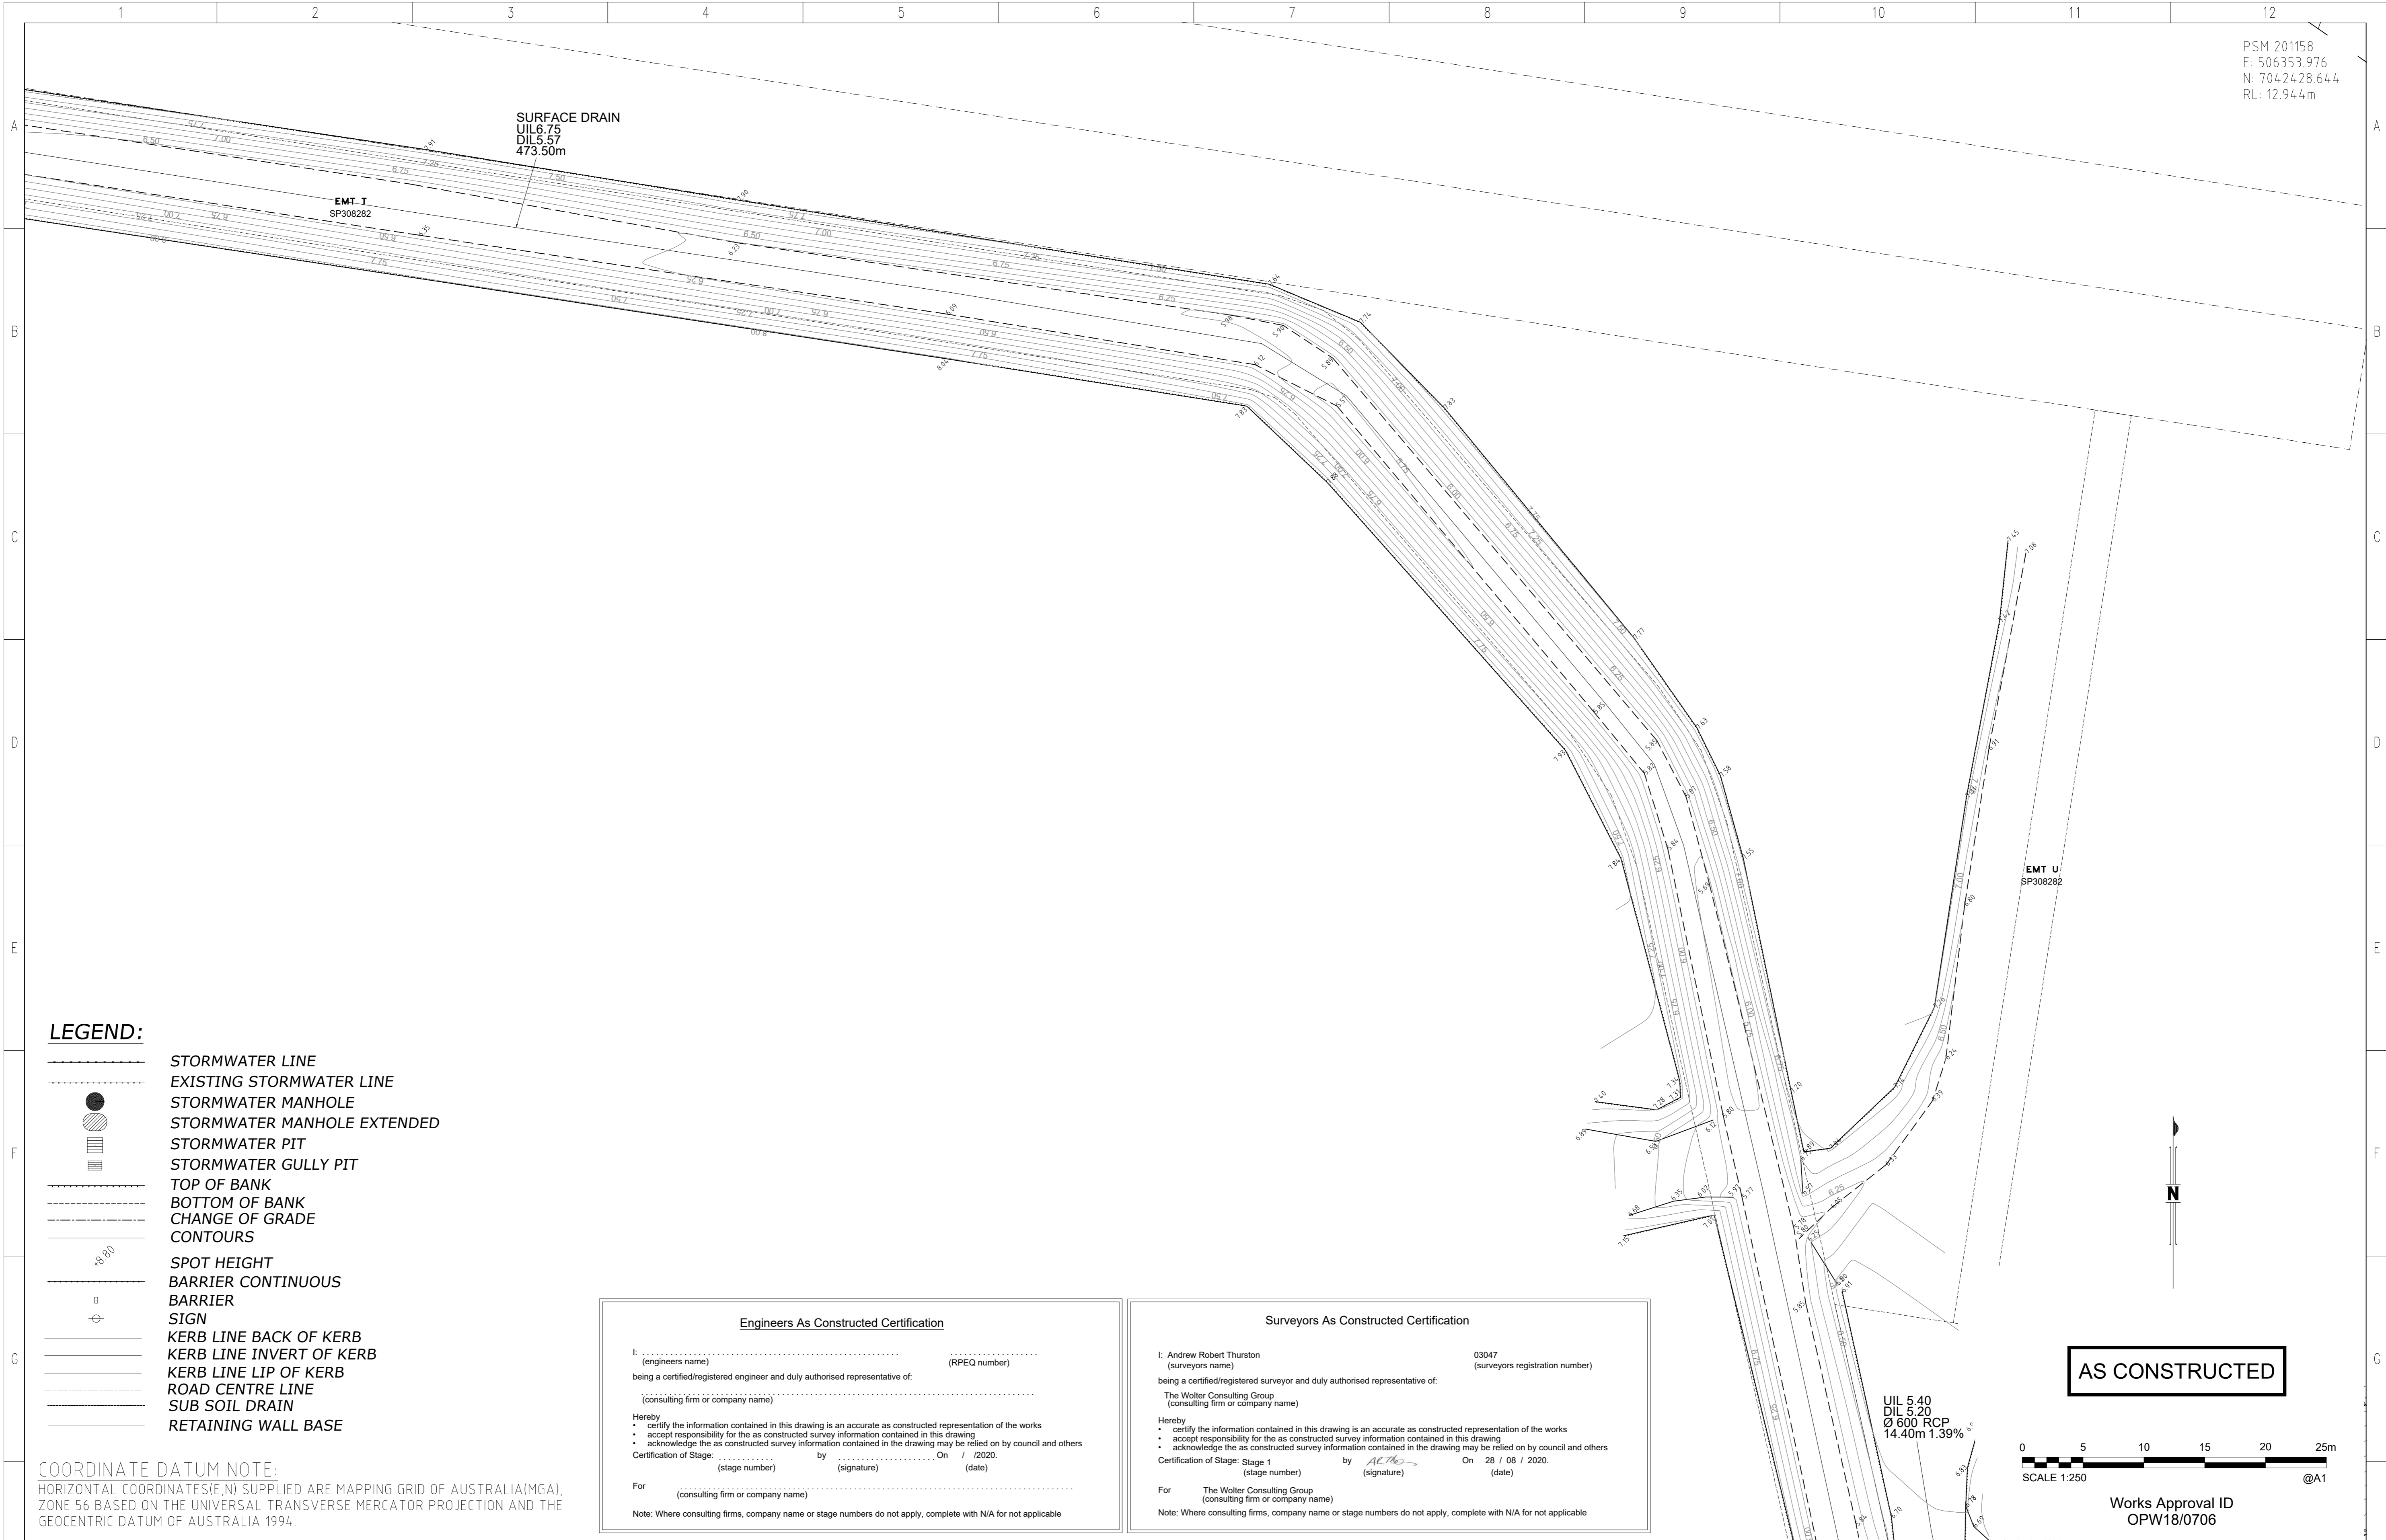

- LEGEND:**
- STORMWATER LINE
 - - - EXISTING STORMWATER LINE
 - STORMWATER MANHOLE
 - ⊕ STORMWATER MANHOLE EXTENDED
 - ▣ STORMWATER PIT
 - ▤ STORMWATER GULLY PIT
 - TOP OF BANK
 - - - BOTTOM OF BANK
 - - - CHANGE OF GRADE
 - CONTOURS
 - +8.80 SPOT HEIGHT
 - BARRIER CONTINUOUS
 - BARRIER
 - ⊕ SIGN
 - KERB LINE BACK OF KERB
 - KERB LINE INVERT OF KERB
 - KERB LINE LIP OF KERB
 - ROAD CENTRE LINE
 - SUB SOIL DRAIN
 - RETAINING WALL BASE

COORDINATE DATUM NOTE:
 HORIZONTAL COORDINATES(E,N) SUPPLIED ARE MAPPING GRID OF AUSTRALIA(MGA), ZONE 56 BASED ON THE UNIVERSAL TRANSVERSE MERCATOR PROJECTION AND THE GEOCENTRIC DATUM OF AUSTRALIA 1994.

Engineers As Constructed Certification

I: _____ (engineers name) _____ (RPEQ number)
 being a certified/registered engineer and duly authorised representative of:
 _____ (consulting firm or company name)

Hereby
 • certify the information contained in this drawing is an accurate as constructed representation of the works
 • accept responsibility for the as constructed survey information contained in this drawing
 • acknowledge the as constructed survey information contained in the drawing may be relied on by council and others

Certification of Stage: _____ by _____ On / / 2020.
 (stage number) (signature) (date)

For _____ (consulting firm or company name)

Note: Where consulting firms, company name or stage numbers do not apply, complete with N/A for not applicable

Surveyors As Constructed Certification

I: Andrew Robert Thurston 03047 (surveyors name) (surveyors registration number)
 being a certified/registered surveyor and duly authorised representative of:
 The Wolter Consulting Group (consulting firm or company name)

Hereby
 • certify the information contained in this drawing is an accurate as constructed representation of the works
 • accept responsibility for the as constructed survey information contained in this drawing
 • acknowledge the as constructed survey information contained in the drawing may be relied on by council and others

Certification of Stage: Stage 1 by A.R.T. On 28 / 08 / 2020.
 (stage number) (signature) (date)

For The Wolter Consulting Group (consulting firm or company name)

Note: Where consulting firms, company name or stage numbers do not apply, complete with N/A for not applicable

AS CONSTRUCTED



Works Approval ID
 OPW18/0706

DRAWING REVISIONS		REFERENCE DRAWINGS		DESIGN FILE No.	DESIGNED
REV.	REVISION DESCRIPTION	DRG. No.	DESCRIPTION	CONSTRUCT. No.	DATE
A	AS CONSTRUCTED				
B	AS CONSTRUCTED - NEW BASIN			SS3787	DRAWN JW/B
C	AS CONSTRUCTED - SIGN/RW ADDED				DATE 28.08.2020
					CHECKED ADH
					DATE 28.08.2020
					LEVEL DATUM AHD
					DATUM MGA-56


Planning	Urban Design	Landscape	Environment	Surveying
Brisbane: Level 2, 1 Breakfast Ck Road, Newstead, QLD 4006 Phone: (07) 3666 5200				
SCALE 1:250		ORIGINAL SIZE A1		

WOLTER consulting group

SUNSHINE COAST COUNCIL
 CALOUNDRA OFFICE
 1 OMRAH AVENUE, CALOUNDRA QLD 4551
 MAROOCHYDORE OFFICE
 10 FIRST AVENUE, MAROOCHYDORE QLD 4558
 NAMBOUR OFFICE
 Cnr CURRIE and BURY STREETS, NAMBOUR QLD 4560
 LOCKED BAG 72, SUNSHINE COAST
 MAIL CENTRE QLD 4560
 Telephone: (07) 5475 7528
 Fax: (07) 5475 7277

VILLAGE GREEN
 STAGE 1
 AS CONSTRUCTED
 ROADS, DRAINAGE AND SURFACE

SUBDIVISION REFERENCE	
RAL 180186 SCC	
No. 11 OF 13 PLANS	
ASCON GRID NUMBER	REV.
	C

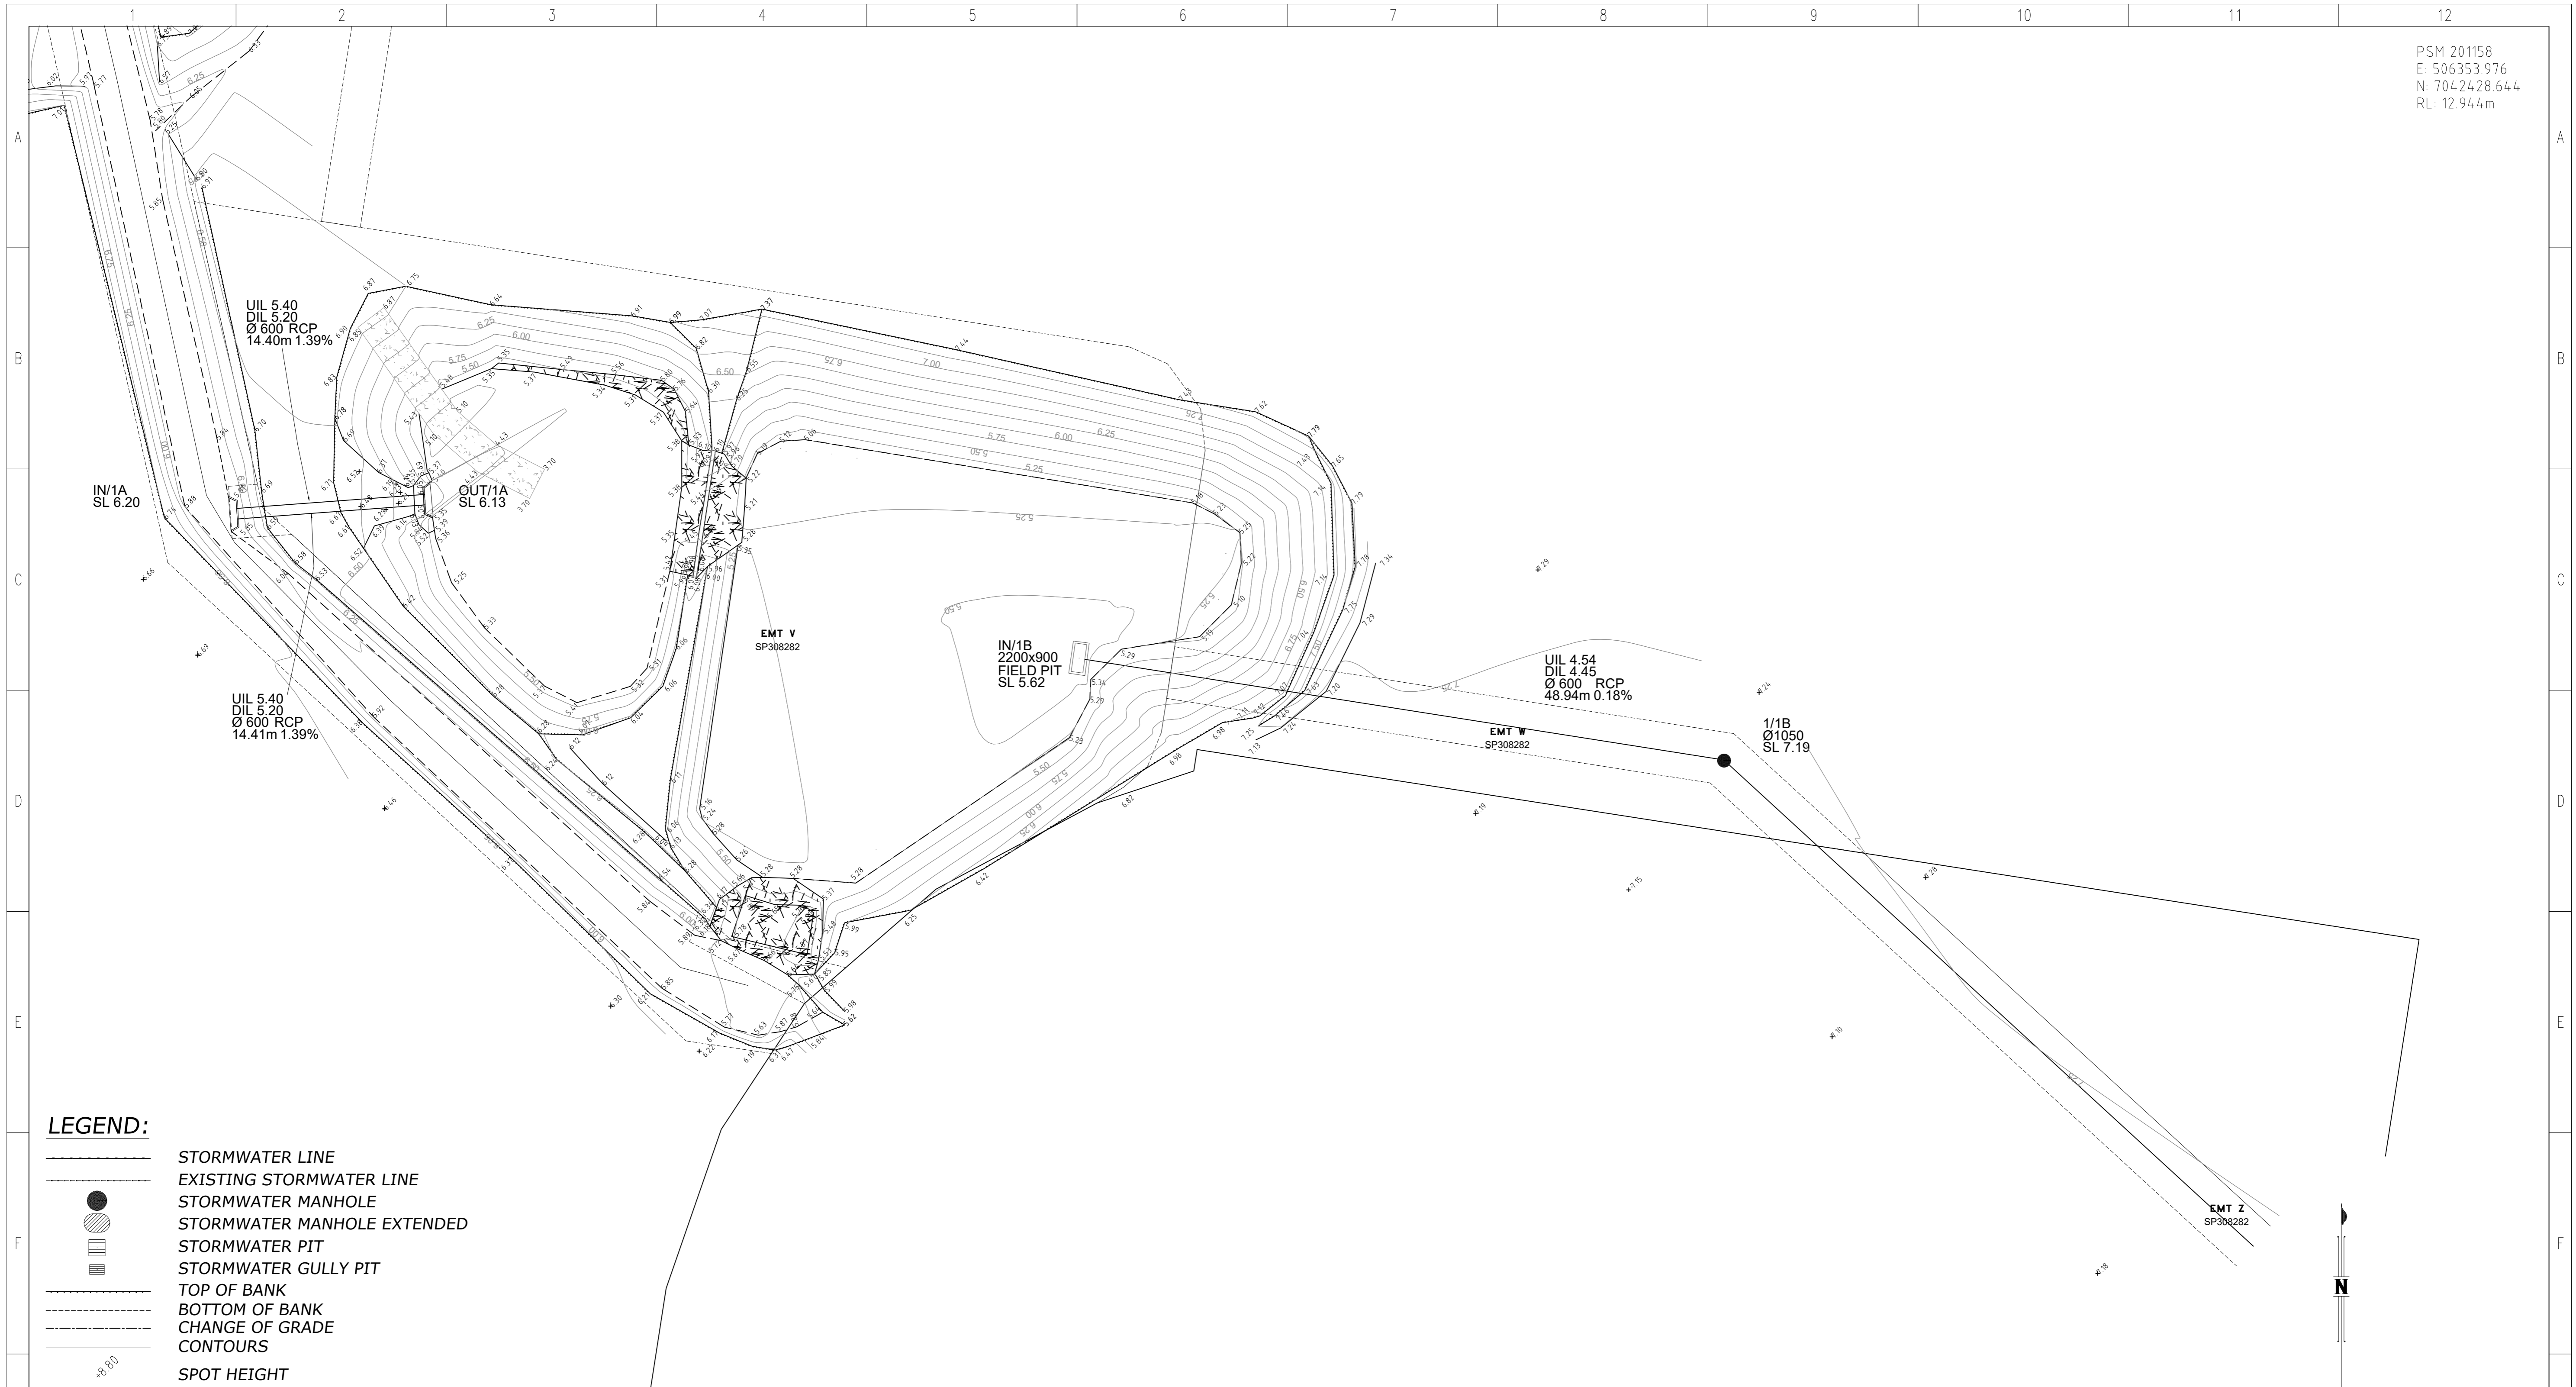


LEGEND:

- STORMWATER LINE
- EXISTING STORMWATER LINE
- STORMWATER MANHOLE
- STORMWATER MANHOLE EXTENDED
- STORMWATER PIT
- STORMWATER GULLY PIT
- TOP OF BANK
- BOTTOM OF BANK
- CHANGE OF GRADE
- CONTOURS
- SPOT HEIGHT
- BARRIER CONTINUOUS
- BARRIER
- SIGN
- KERB LINE BACK OF KERB
- KERB LINE INVERT OF KERB
- KERB LINE LIP OF KERB
- ROAD CENTRE LINE
- SUB SOIL DRAIN
- RETAINING WALL BASE

COORDINATE DATUM NOTE:
 HORIZONTAL COORDINATES(E,N) SUPPLIED ARE MAPPING GRID OF AUSTRALIA(MGA), ZONE 56 BASED ON THE UNIVERSAL TRANSVERSE MERCATOR PROJECTION AND THE GEOCENTRIC DATUM OF AUSTRALIA 1994.

AS CONSTRUCTED

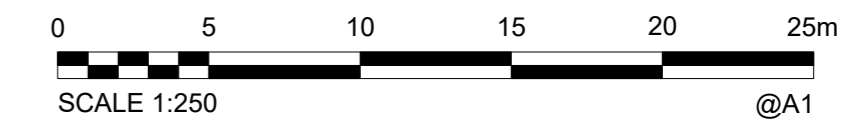

Works Approval ID
 OPW18/0706

Engineers As Constructed Certification

I: (engineers name) (RPEQ number)
 being a certified/registered engineer and duly authorised representative of:
 (consulting firm or company name)

Hereby
 • certify the information contained in this drawing is an accurate as constructed representation of the works
 • accept responsibility for the as constructed survey information contained in this drawing
 • acknowledge the as constructed survey information contained in the drawing may be relied on by council and others

Certification of Stage: by On / / 2020.
 (stage number) (signature) (date)

For
 (consulting firm or company name)

Note: Where consulting firms, company name or stage numbers do not apply, complete with N/A for not applicable

Surveyors As Constructed Certification

I: Andrew Robert Thurston 03047 (surveyors name) (surveyors registration number)
 being a certified/registered surveyor and duly authorised representative of:
 The Wolter Consulting Group
 (consulting firm or company name)

Hereby
 • certify the information contained in this drawing is an accurate as constructed representation of the works
 • accept responsibility for the as constructed survey information contained in this drawing
 • acknowledge the as constructed survey information contained in the drawing may be relied on by council and others

Certification of Stage: Stage 1 by A.R.T. On 28 / 08 / 2020.
 (stage number) (signature) (date)

For The Wolter Consulting Group
 (consulting firm or company name)

Note: Where consulting firms, company name or stage numbers do not apply, complete with N/A for not applicable

DRAWING REVISIONS		REFERENCE DRAWINGS		DESIGN FILE No.	DESIGNED
REV.	REVISION DESCRIPTION	DRG. No.	DESCRIPTION	CONSTRUCT. No.	DATE
A	AS CONSTRUCTED				
B	AS CONSTRUCTED - NEW BASIN			SS3787	28.08.2020
C	AS CONSTRUCTED - SIGN/RW ADDED				

WOLTER consulting group

Planning Urban Design Landscape Environment Surveying

Brisbane: Level 2, 1 Breakfast Ck Road, Newstead, QLD 4006 Phone: (07) 3666 5200

SCALE 1:250 ORIGINAL SIZE A1

SUNSHINE COAST COUNCIL

CALOUNDRA OFFICE
 1 OMRAH AVENUE, CALOUNDRA QLD 4551

MAROOCHYDORE OFFICE
 10 FIRST AVENUE, MAROOCHYDORE QLD 4558

NAMBOUR OFFICE
 Cnr CURRIE and BURY STREETS, NAMBOUR QLD 4560

LOCKED BAG 72, SUNSHINE COAST
 MAIL CENTRE QLD 4560
 Telephone: (07) 5475 7528
 Fax: (07) 5475 7277

VILLAGE GREEN

STAGE 1
AS CONSTRUCTED
ROADS, DRAINAGE AND SURFACE

SUBDIVISION REFERENCE	
RAL 180186 SCC	
No. 12 OF 13 PLANS	
ASCON GRID NUMBER	REV.
	C

PSM 201158
 E: 506353.976
 N: 7042428.644
 RL: 12.944m

Engineers As Constructed Certification

I,
 (engineers name) (RPEQ number)
 being a certified/registered engineer and duly authorised representative of:

 (consulting firm or company name)

Hereby
 • certify the information contained in this drawing is an accurate as constructed representation of the works
 • accept responsibility for the as constructed survey information contained in this drawing
 • acknowledge the as constructed survey information contained in the drawing may be relied on by council and others

Certification of Stage: by On / / 2020.
 (stage number) (signature) (date)

For

 (consulting firm or company name)

Note: Where consulting firms, company name or stage numbers do not apply, complete with N/A for not applicable

Surveyors As Constructed Certification

I, Andrew Robert Thurston 03047
 (surveyors name) (surveyors registration number)
 being a certified/registered surveyor and duly authorised representative of:
 The Wolter Consulting Group
 (consulting firm or company name)

Hereby
 • certify the information contained in this drawing is an accurate as constructed representation of the works
 • accept responsibility for the as constructed survey information contained in this drawing
 • acknowledge the as constructed survey information contained in the drawing may be relied on by council and others

Certification of Stage: Stage 1 by On 28 / 08 / 2020.
 (stage number) (signature) (date)

For The Wolter Consulting Group
 (consulting firm or company name)

Note: Where consulting firms, company name or stage numbers do not apply, complete with N/A for not applicable

A
B
C
D
E
F
G
H

A
B
C
D
E
F
G
H

- LEGEND:**
- STORMWATER LINE
 - - - EXISTING STORMWATER LINE
 - STORMWATER MANHOLE
 - STORMWATER MANHOLE EXTENDED
 - STORMWATER PIT
 - STORMWATER GULLY PIT
 - TOP OF BANK
 - - - BOTTOM OF BANK
 - - - CHANGE OF GRADE
 - CONTOURS
 - SPOT HEIGHT
 - BARRIER CONTINUOUS
 - BARRIER
 - SIGN
 - KERB LINE BACK OF KERB
 - KERB LINE INVERT OF KERB
 - KERB LINE LIP OF KERB
 - ROAD CENTRE LINE
 - SUB SOIL DRAIN
 - RETAINING WALL BASE

COORDINATE DATUM NOTE:
 HORIZONTAL COORDINATES(E,N) SUPPLIED ARE MAPPING GRID OF AUSTRALIA(MGA),
 ZONE 56 BASED ON THE UNIVERSAL TRANSVERSE MERCATOR PROJECTION AND THE
 GEOCENTRIC DATUM OF AUSTRALIA 1994.

DRAWING REVISIONS		REFERENCE DRAWINGS		DESIGN FILE No.	DESIGNED	
REV.	REVISION DESCRIPTION	DRG. No.	DESCRIPTION	CONSTRUCT. No.	DATE	
A	AS CONSTRUCTED					
B	AS CONSTRUCTED - NEW BASIN			SS3787	28.08.2020	JWB
C	AS CONSTRUCTED - SIGN/RW ADDED					ADH

WOLTER consulting group

Planning Urban Design Landscape Environment Surveying

Brisbane: Level 2, 1 Breakfast Ck Road, Newstead, QLD 4006 Phone: (07) 3666 5200

SCALE 1:250 ORIGINAL SIZE A1

SUNSHINE COAST COUNCIL

CALOUNDRA OFFICE
 1 OMRAH AVENUE, CALOUNDRA QLD 4551

MAROOCHYDORE OFFICE
 10 FIRST AVENUE, MAROOCHYDORE QLD 4558

NAMBOUR OFFICE
 Cnr CURRIE and BURY STREETS, NAMBOUR QLD 4560


LOCKED BAG 72, SUNSHINE COAST
 MAIL CENTRE QLD 4560
 Telephone: (07) 5475 7528
 Fax: (07) 5475 7277

VILLAGE GREEN


STAGE 1
 AS CONSTRUCTED
 ROADS, DRAINAGE AND SURFACE

SUBDIVISION REFERENCE	
RAL 180186 SCC	
No. 13 OF 13 PLANS	
ASCON GRID NUMBER	REV.
	C

1 2 3 4 5 6 7 8 9 10 11 12

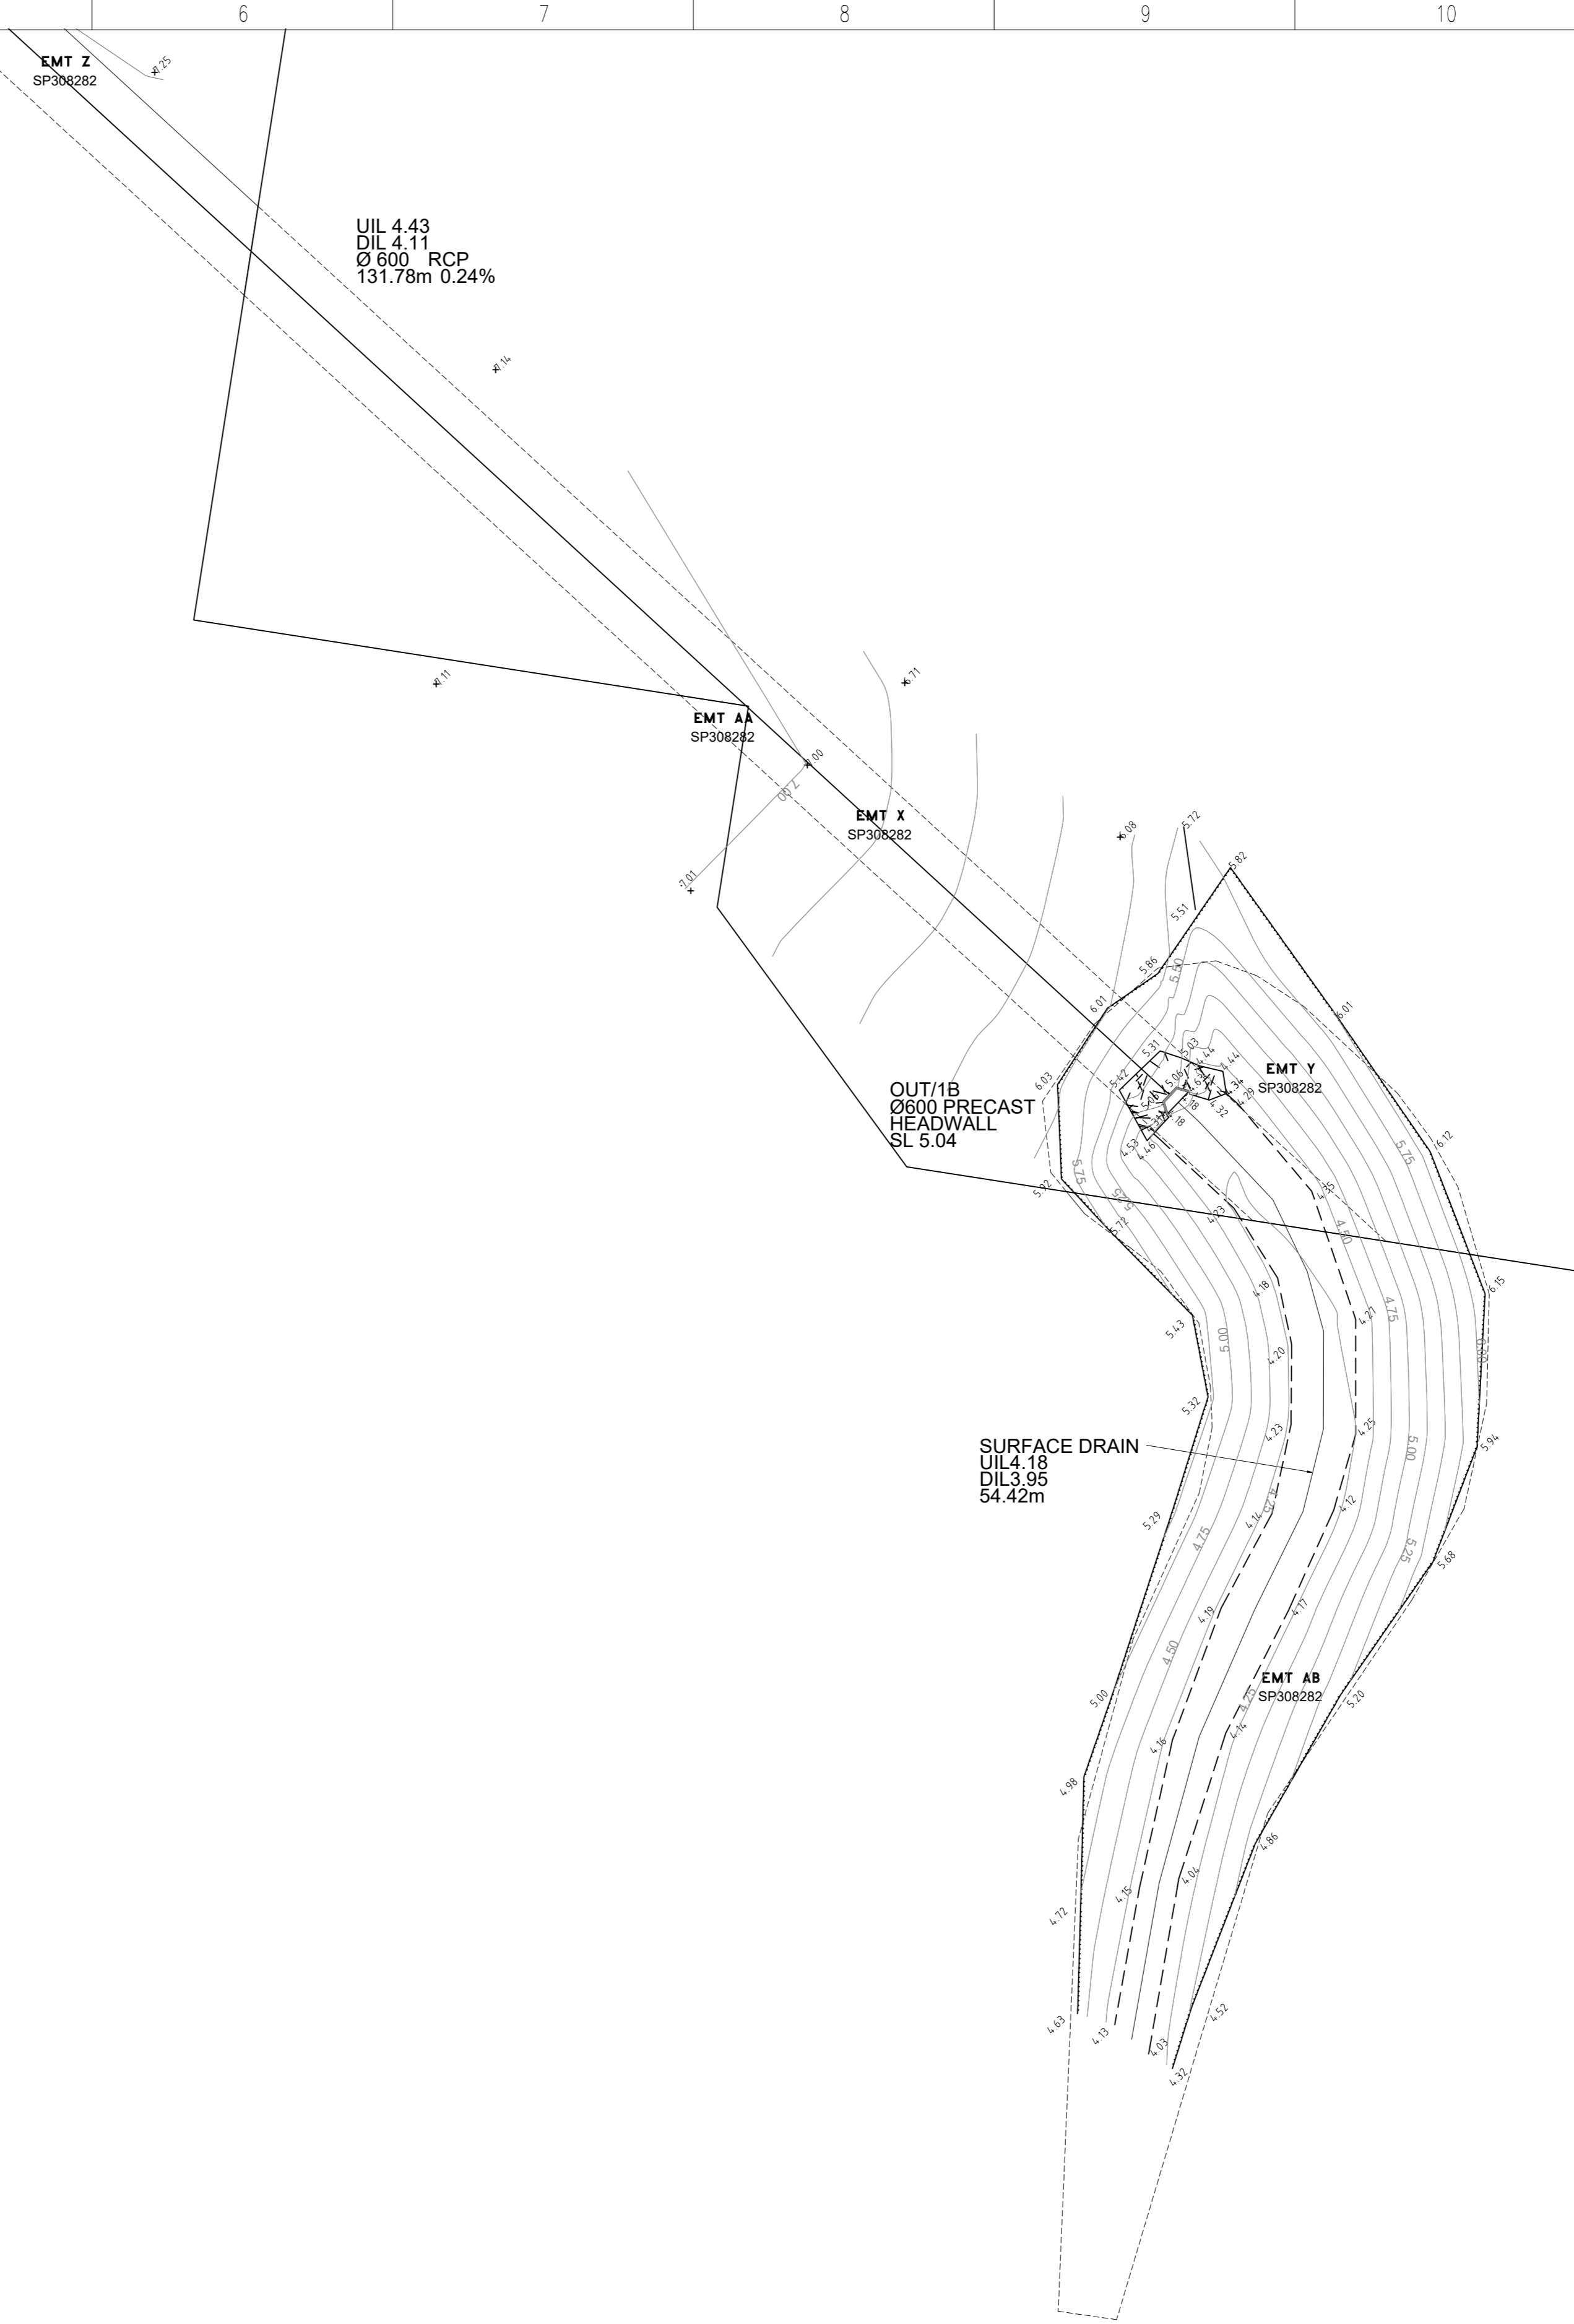

AS CONSTRUCTED

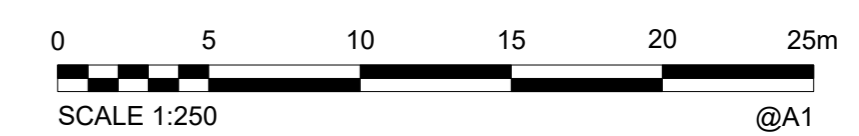

Works Approval ID
 OPW18/0706