


PSM 191027
 E: 495937.616
 N: 7003052.339
 RL: 8.767m

REGISTERED SURVEYOR'S CERTIFICATION
 I, Andrew Robert Thurston, hereby certify that the vertical and horizontal locations and dimensions shown on this plan are a true and correct record and were located by survey.
 Registered Surveyor (Sig) Reg. Surveyor No. #03047 Date: 20/08/2021

ENGINEER'S CERTIFICATION
 I, _____, hereby certify that:
 1. The information contained in this drawing / document is in compliance with approved drawings and design.
 2. The new drainage and transport works defined by this drawing have been designed and constructed in accordance with Council Standards.
 3. This represents an accurate record of as-constructed works.
 4. I accept responsibility for the information contained in this drawing / document.
 RPEO (Signature) RPEO No. _____ Date: _____

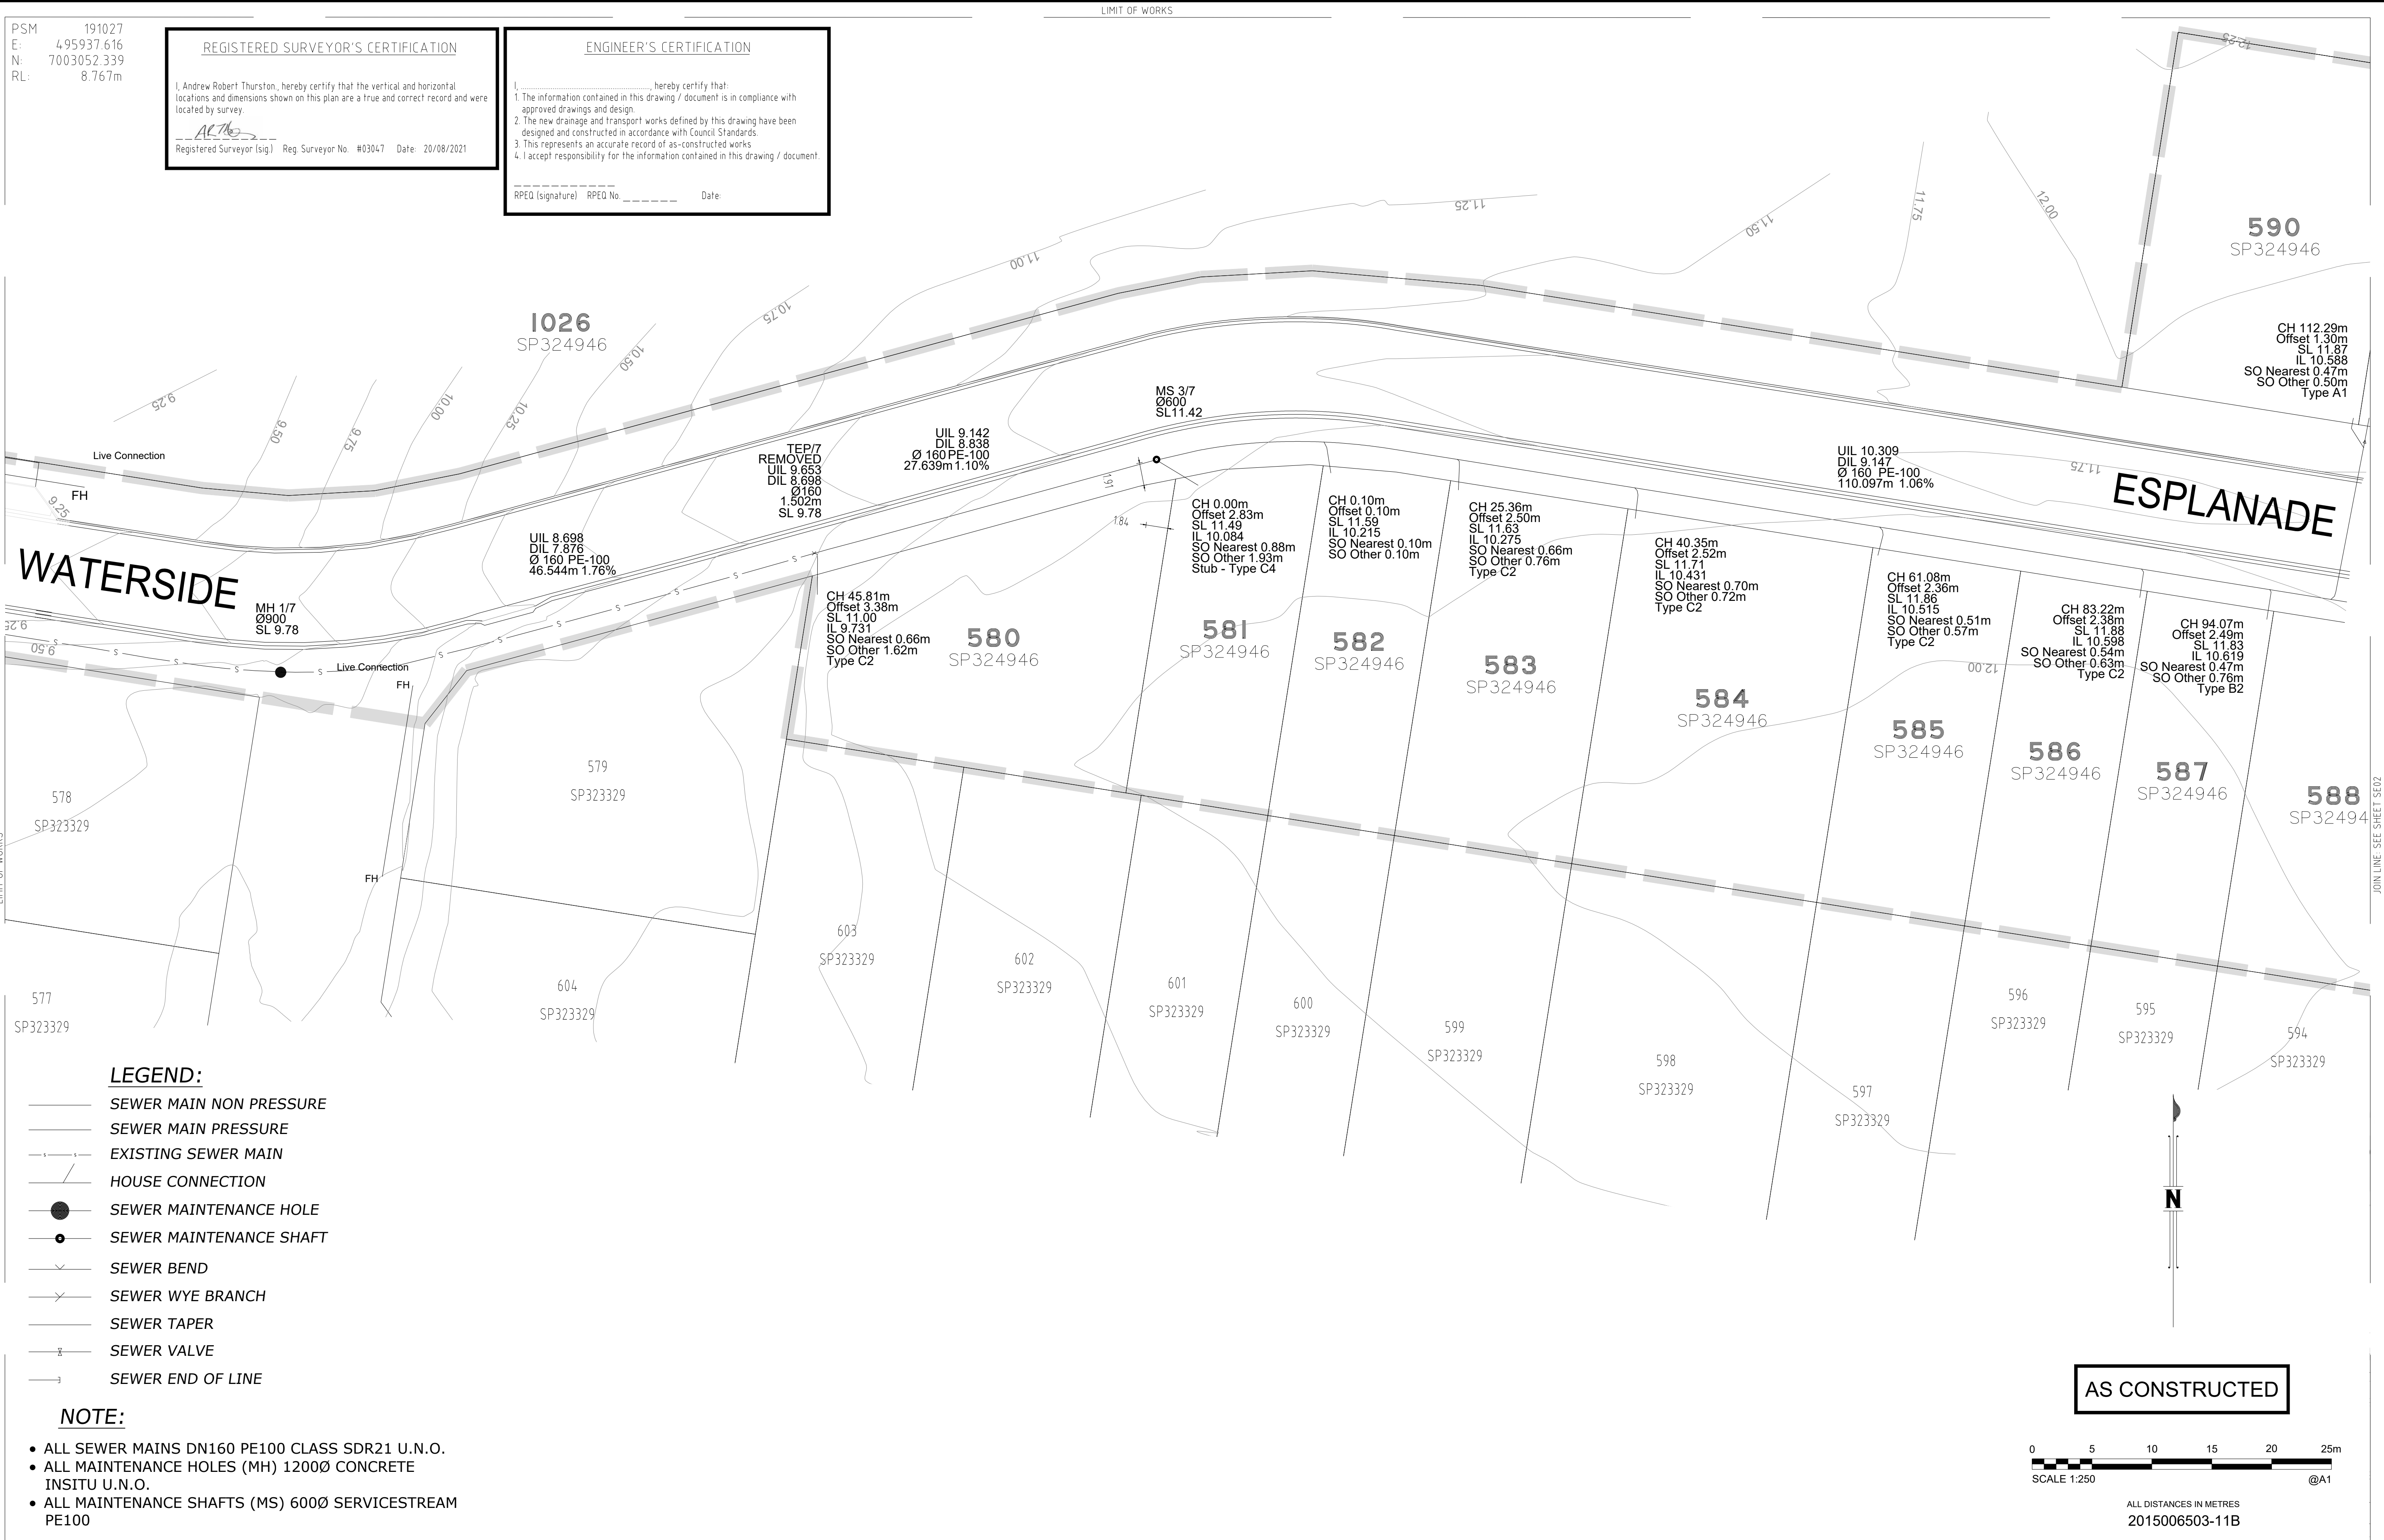


LEGEND:

- SEWER MAIN NON PRESSURE
- - - SEWER MAIN PRESSURE
- · · EXISTING SEWER MAIN
- HOUSE CONNECTION
- SEWER MAINTENANCE HOLE
- SEWER MAINTENANCE SHAFT
- ∨ SEWER BEND
- Y SEWER WYE BRANCH
- SEWER TAPER
- v SEWER VALVE
- SEWER END OF LINE

NOTE:

- ALL SEWER MAINS DN160 PE100 CLASS SDR21 U.N.O.
- ALL MAINTENANCE HOLES (MH) 1200Ø CONCRETE INSITU U.N.O.
- ALL MAINTENANCE SHAFTS (MS) 600Ø SERVICESTREAM PE100

AS CONSTRUCTED

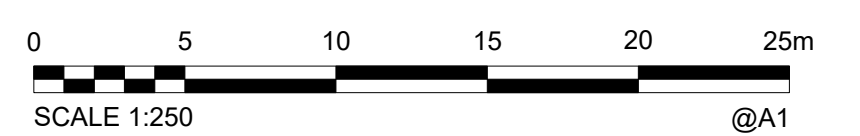

ALL DISTANCES IN METRES
 2015006503-11B

A1	INDEX	DATE	AS CONSTRUCTED	DRAWN	CHECKED	PASSED	DRAWN	CHECKED	PASSED
	A	20/08/2021	AS CONSTRUCTED	J Braga	A Dahn-Harvey	A Thurston	JWB	AMDH	ART

WOLTER consulting group
 Planning Urban Design Landscape Environment Surveying
 Brisbane: Level 2, 1 Breakfast Ck Road, Newstead, QLD 4006 Phone: (07) 3666 5200



Unitywater
 2015006503-11B
 Riverbank Estate
 Market Drive
 SEWER AND WATER RETICULATION

SHEET 2 OF 7 SHEETS	SCALE 250
REVISION DATE 20/08/2021	REVISION A
DISCIPLINE CODE C	
DRAWING NO.	U-2021-3551-SE01

ENGINEER'S CERTIFICATION

I, _____, hereby certify that:
 1. The information contained in this drawing / document is in compliance with approved drawings and design.
 2. The new drainage and transport works defined by this drawing have been designed and constructed in accordance with Council Standards.
 3. This represents an accurate record of as-constructed works.
 4. I accept responsibility for the information contained in this drawing / document.

RPEQ (signature) RPEQ No. _____ Date: _____


REGISTERED SURVEYOR'S CERTIFICATION

I, Andrew Robert Thurston, hereby certify that the vertical and horizontal locations and dimensions shown on this plan are a true and correct record and were located by survey.

AT
 Registered Surveyor (sig) Reg. Surveyor No. #03047 Date: 20/08/2021


- LEGEND:**
- SEWER MAIN NON PRESSURE
 - SEWER MAIN PRESSURE
 - - - EXISTING SEWER MAIN
 - HOUSE CONNECTION
 - SEWER MAINTENANCE HOLE
 - SEWER MAINTENANCE SHAFT
 - ↘ SEWER BEND
 - ↘ SEWER WYE BRANCH
 - SEWER TAPER
 - ⊥ SEWER VALVE
 - SEWER END OF LINE

- NOTE:**
- ALL SEWER MAINS DN160 PE100 CLASS SDR21 U.N.O.
 - ALL MAINTENANCE HOLES (MH) 1200Ø CONCRETE INSITU U.N.O.
 - ALL MAINTENANCE SHAFTS (MS) 600Ø SERVICESTREAM PE100

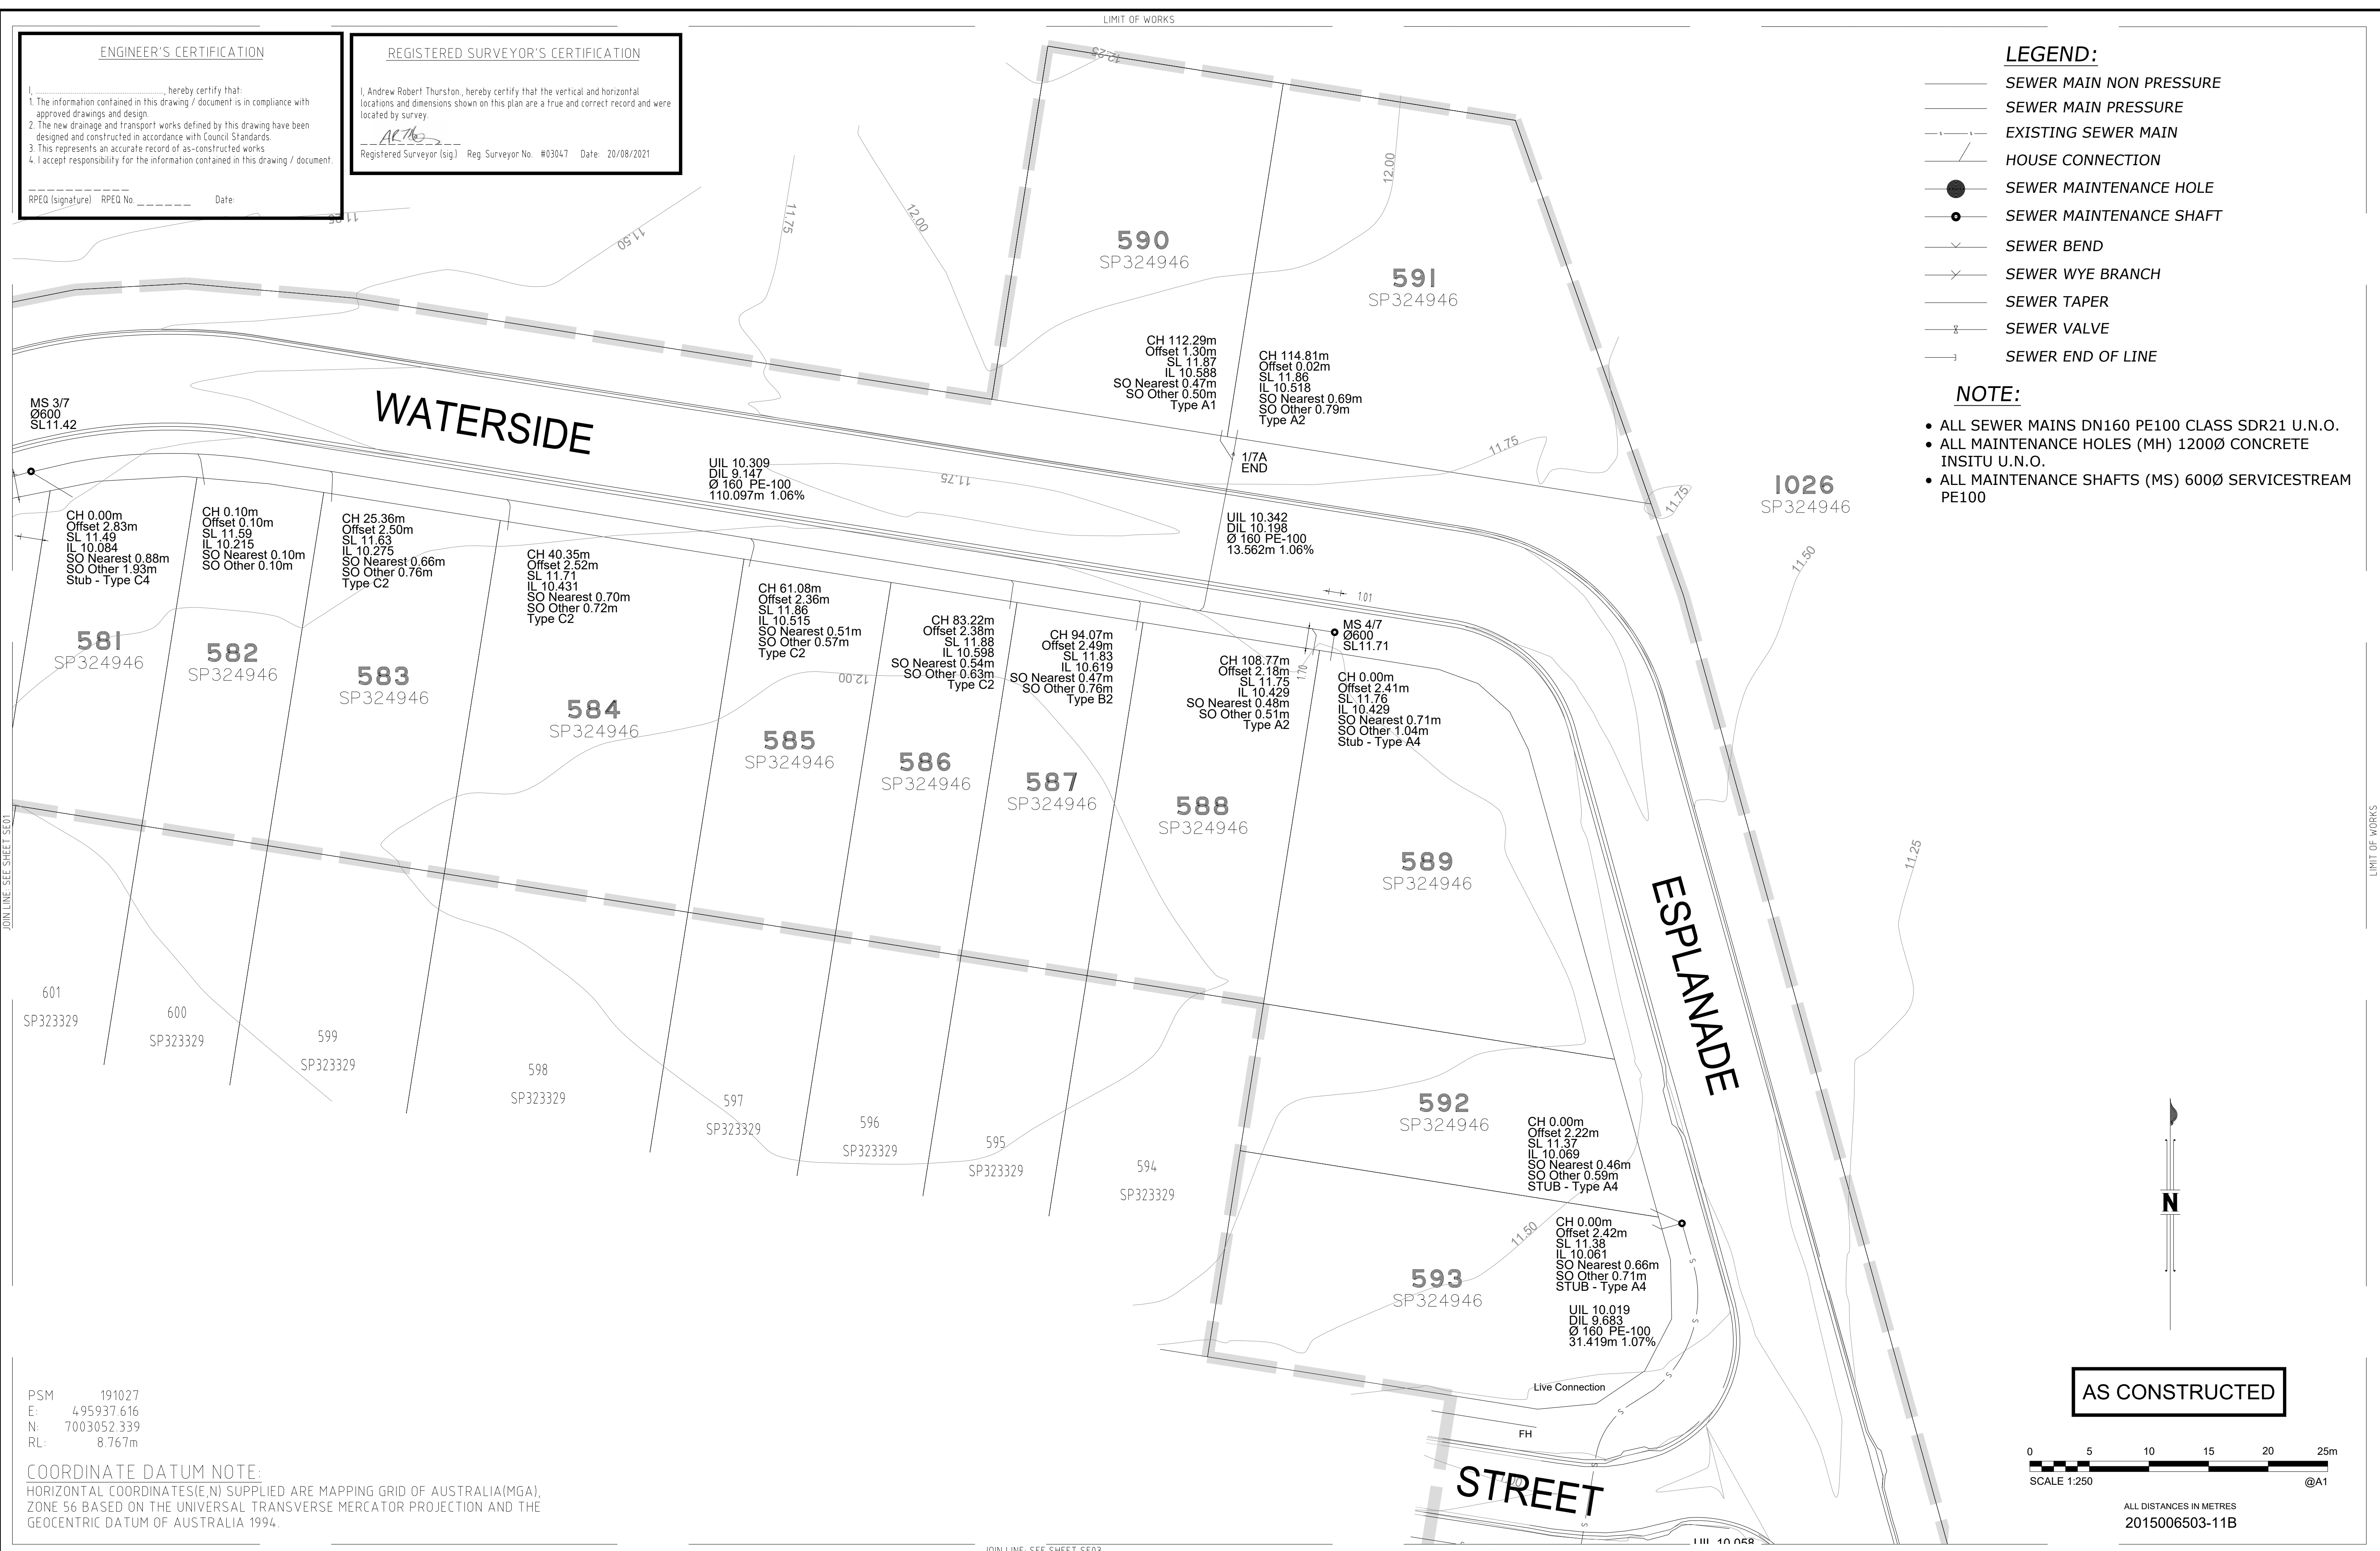

PSM 191027
 E: 495937.616
 N: 7003052.339
 RL: 8.767m

COORDINATE DATUM NOTE:
 HORIZONTAL COORDINATES(E,N) SUPPLIED ARE MAPPING GRID OF AUSTRALIA(MGA), ZONE 56 BASED ON THE UNIVERSAL TRANSVERSE MERCATOR PROJECTION AND THE GEOCENTRIC DATUM OF AUSTRALIA 1994.

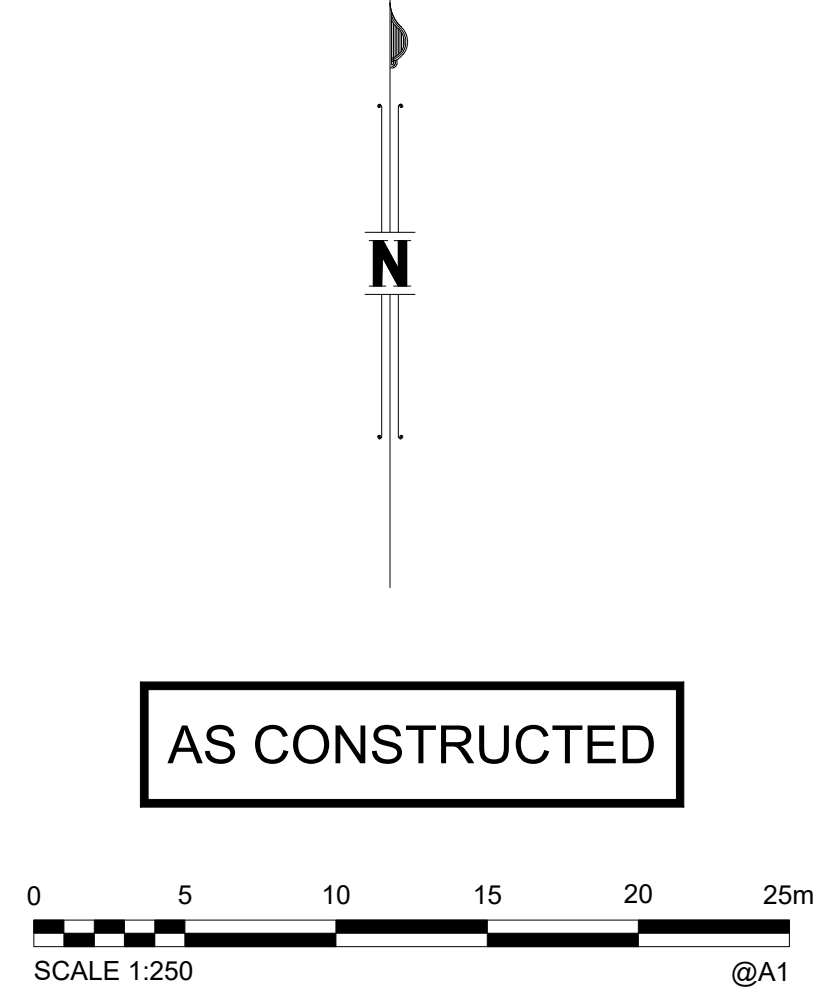

A1	INDEX	DATE	AS CONSTRUCTED	DRAWN	CHECKED	PASSED	INITIALS	DATE
	A	20/08/2021	AS CONSTRUCTED	J.Braga	A.Dalton-Harvey	A.Thurston		

JOIN LINE - SEE SHEET SE03

WOLTER
consulting group

Planning Urban Design Landscape Environment Surveying

Brisbane: Level 2, 1 Breakfast Ck Road, Newstead, QLD 4006 Phone: (07) 3666 5200



Unitywater

2015006503-11B
 Riverbank Estate
 Market Drive
 SEWER AND WATER RETICULATION

SHEET 3 OF 7 SHEETS	SCALE 250
REVISION DATE 20/08/2021	REVISION A
DISCIPLINE CODE C	
DRAWING NO.	U-2021-3551-SE02

PSM 191027
 E: 495937.616
 N: 7003052.339
 RL: 8.767m

JOIN LINE SEE SHEET SE02

ENGINEER'S CERTIFICATION
 I, _____, hereby certify that:
 1. The information contained in this drawing / document is in compliance with approved drawings and design.
 2. The new drainage and transport works defined by this drawing have been designed and constructed in accordance with Council Standards.
 3. This represents an accurate record of as-constructed works.
 4. I accept responsibility for the information contained in this drawing / document.
 RPEQ (signature) RPEQ No. _____ Date: _____

REGISTERED SURVEYOR'S CERTIFICATION
 I, Andrew Robert Thurston, hereby certify that the vertical and horizontal locations and dimensions shown on this plan are a true and correct record and were located by survey.
 Registered Surveyor (sig) Reg. Surveyor No. #03047 Date: 20/08/2021

JOIN LINE SEE SHEET SE02

LIMIT OF WORKS

- LEGEND:**
- SEWER MAIN NON PRESSURE
 - SEWER MAIN PRESSURE
 - - - EXISTING SEWER MAIN
 - HOUSE CONNECTION
 - SEWER MAINTENANCE HOLE
 - SEWER MAINTENANCE SHAFT
 - ↘ SEWER BEND
 - ↘ SEWER WYE BRANCH
 - SEWER TAPER
 - SEWER VALVE
 - SEWER END OF LINE

- NOTE:**
- ALL SEWER MAINS DN160 PE100 CLASS SDR21 U.N.O.
 - ALL MAINTENANCE HOLES (MH) 1200Ø CONCRETE INSITU U.N.O.
 - ALL MAINTENANCE SHAFTS (MS) 600Ø SERVICESTREAM PE100

A1	INDEX	DATE	AS CONSTRUCTED	REVISIONS	DRAWN	CHECKED	PASSED	INITIALS	DATE
	A	20/08/2021	AS CONSTRUCTED		J.Braga	A.Dalton-Harvey	A.Thurston		

WOLTER consulting group
 Planning Urban Design Landscape Environment Surveying
 Brisbane Level 2, 1 Breakfast Ck Road, Newstead, QLD 4006 Phone: (07) 3666 5200



Unitywater
 2015006503-11B
 Riverbank Estate
 Market Drive
 SEWER AND WATER RETICULATION

SHEET 4 OF 7 SHEETS	SCALE 250
REVISION DATE 20/08/2021	REVISION A
DISCIPLINE CODE C	
DRAWING NO. U-2021-3551-SE03	



AS CONSTRUCTED

0 5 10 15 20 25m
 SCALE 1:250 @A1

ALL DISTANCES IN METRES
 2015006503-11B


COORDINATE DATUM NOTE:
 HORIZONTAL COORDINATES(E,N) SUPPLIED ARE MAPPING GRID OF AUSTRALIA(MGA), ZONE 56 BASED ON THE UNIVERSAL TRANSVERSE MERCATOR PROJECTION AND THE GEOCENTRIC DATUM OF AUSTRALIA 1994.

PSM 191027
 E: 495937.616
 N: 7003052.339
 RL: 8.767m

LIMIT OF WORKS

COORDINATE DATUM NOTE:
 HORIZONTAL COORDINATES(E,N) SUPPLIED ARE MAPPING GRID OF AUSTRALIA(MGA),
 ZONE 56 BASED ON THE UNIVERSAL TRANSVERSE MERCATOR PROJECTION AND THE
 GEOCENTRIC DATUM OF AUSTRALIA 1994.

REGISTERED SURVEYOR'S CERTIFICATION

 

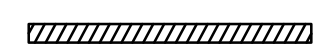

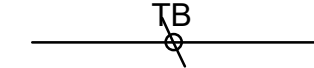
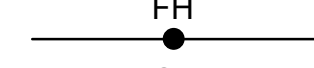
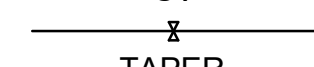

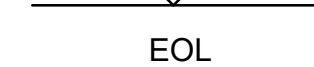




I, Andrew Robert Thurston, hereby certify that the vertical and horizontal
 locations and dimensions shown on this plan are a true and correct record and were
 located by survey.

 Registered Surveyor (Sig) Reg. Surveyor No. #03047 Date: 20/08/2021

ENGINEER'S CERTIFICATION

I, _____ hereby certify that:
 1. The information contained in this drawing / document is in compliance with
 approved drawings and design.
 2. The new drainage and transport works defined by this drawing have been
 designed and constructed in accordance with Council Standards.
 3. This represents an accurate record of as-constructed works
 4. I accept responsibility for the information contained in this drawing / document.

RPEQ (signature) RPEQ No. _____ Date: _____

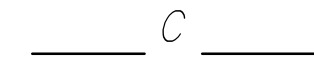LEGEND:


-  Ø100 OR Ø150 PVC-U CLASS PN16 WATERMAIN AS NOTED
-  EXISTING WATER MAIN
-  DICL WATERMAIN
-  READY TAP HOUSE CONNECTION
-  TAPPING BAND HOUSE CONNECTION
-  HYDRANT
-  SLUICE VALVE
-  TAPER/REDUCER
-  BEND
-  END CAP
-  WATER SERVICE PIPE
-  WATER SERVICE METER
-  WATER SERVICE CONDUIT 100Ø PVC-O

1026
 SP324946


590
 SP324946

WATERSIDE

ESPLANADE

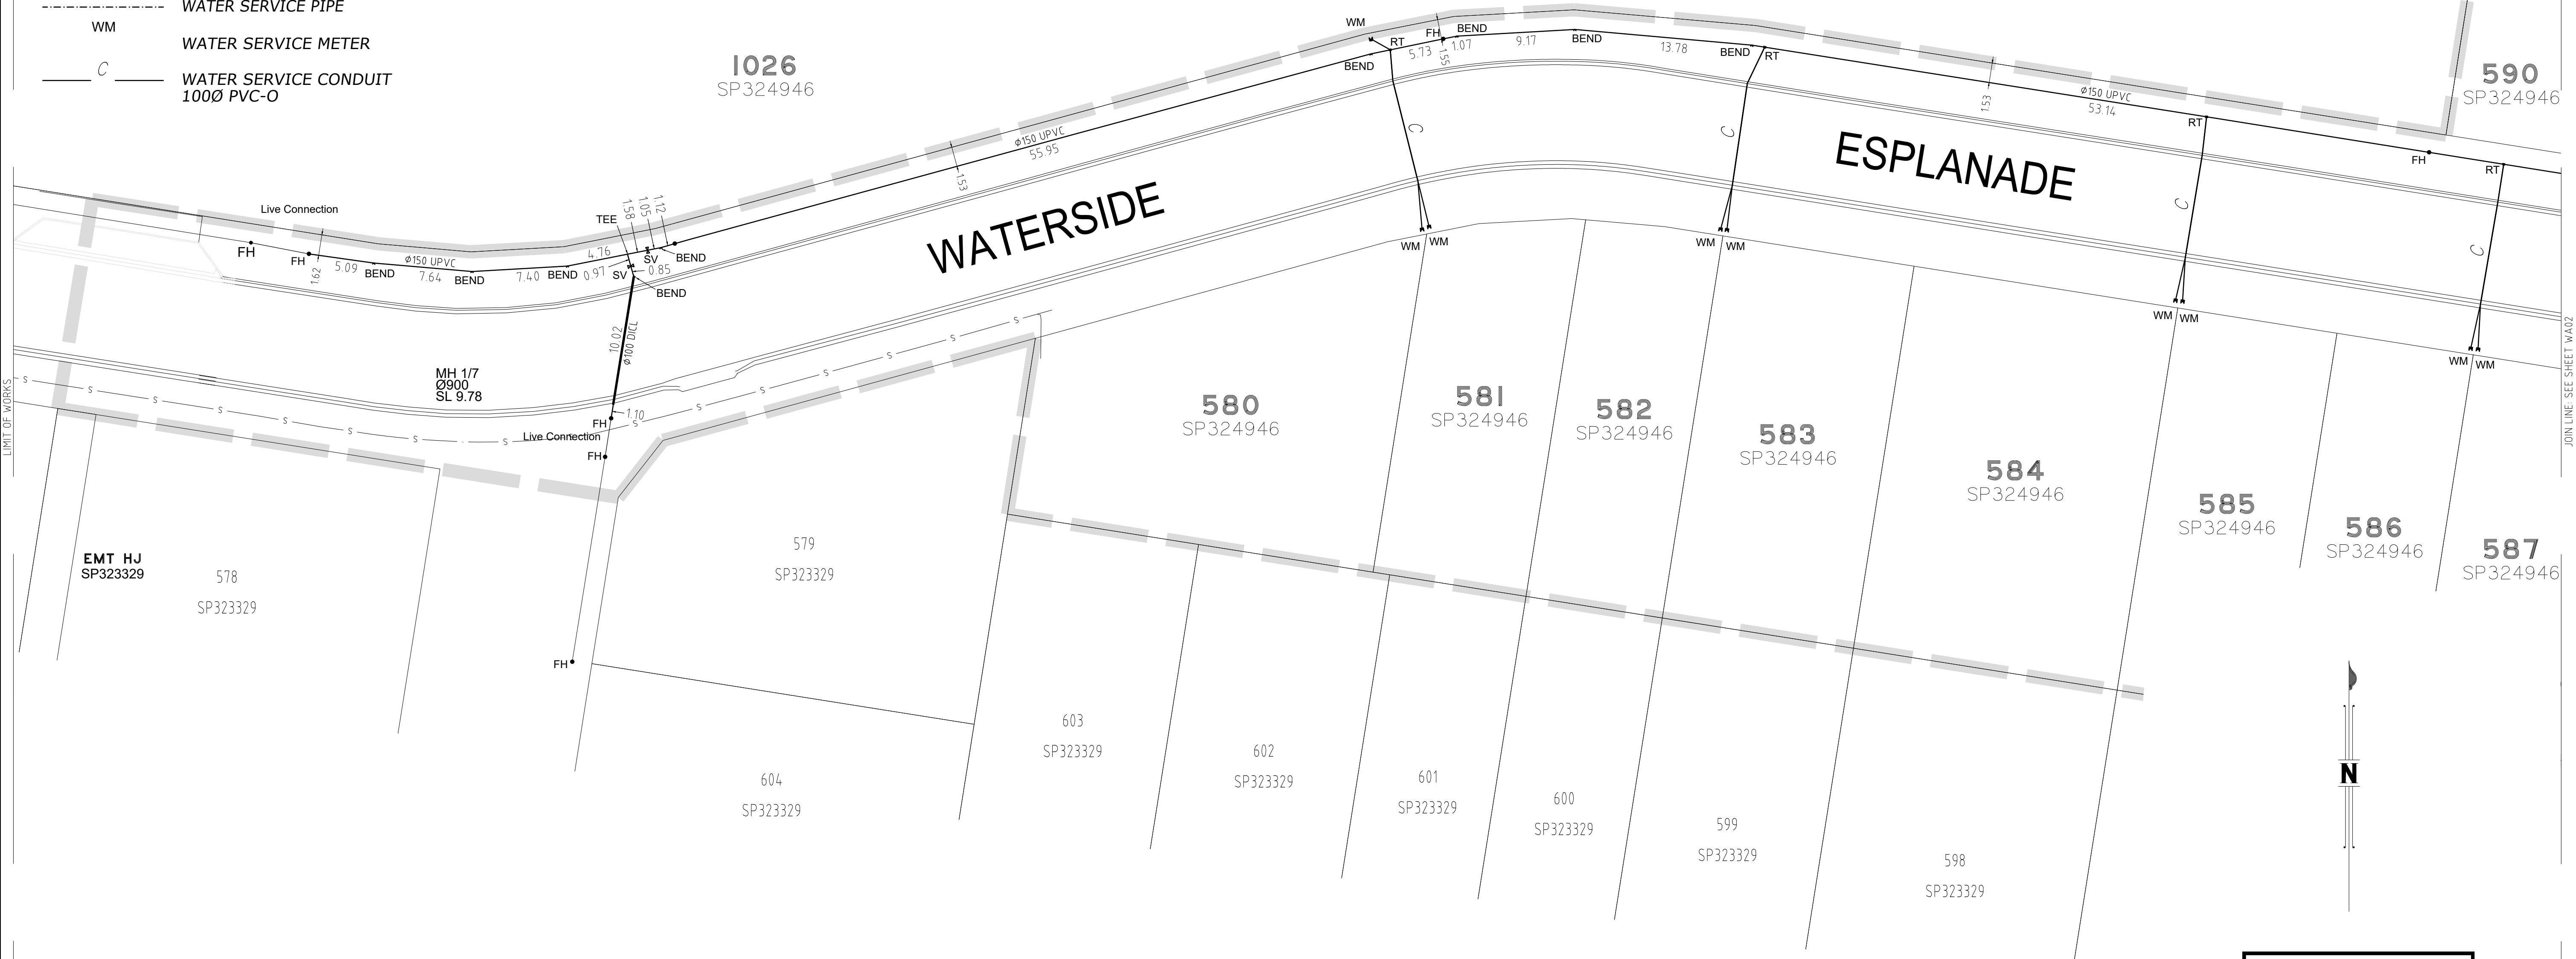

AS CONSTRUCTED

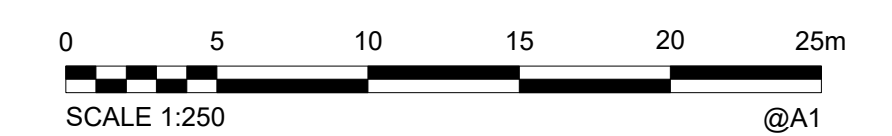

ALL DISTANCES IN METRES
 2015006503-11B

A1	INDEX	DATE	AS CONSTRUCTED	REVISIONS	DRAWN	CHECKED	PASSED	INITIALS	DATE
	A	20/08/2021	AS CONSTRUCTED		J.Braga	A.Dalton-Harvey	A.Thurston		

DRAWN	JWB	20/08/2021
CHECKED	AMDH	20/08/2021
PASSED	ART	20/08/2021



WOLTER
 consulting group

Planning Urban Design Landscape Environment Surveying

Brisbane: Level 2, 1 Breakfast Ck Road, Newstead, QLD 4006 Phone: (07) 3666 5200



Unitywater

Unitywater

2015006503-11B
 Riverbank Estate
 Market Drive

SEWER AND WATER RETICULATION

 

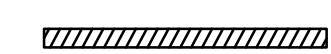








 

SHEET 5 OF 7 SHEETS	SCALE 250
REVISION DATE 20/08/2021	REVISION A
DISCIPLINE CODE C	
DRAWING NO.	U-2021-3551-WA01

PSM 191027
 E: 495937.616
 N: 7003052.339
 RL: 8.767m

COORDINATE DATUM NOTE:
 HORIZONTAL COORDINATES(E,N) SUPPLIED ARE MAPPING GRID OF AUSTRALIA(MGA), ZONE 56 BASED ON THE UNIVERSAL TRANSVERSE MERCATOR PROJECTION AND THE GEOCENTRIC DATUM OF AUSTRALIA 1994.

LIMIT OF WORKS

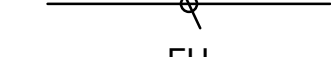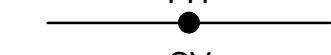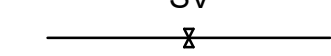LEGEND:

-  Ø100 OR Ø150 PVC-U CLASS PN16 WATERMAIN AS NOTED
-  EXISTING WATER MAIN
-  DICL WATERMAIN
-  RT READY TAP HOUSE CONNECTION
-  TB TAPPING BAND HOUSE CONNECTION
-  FH HYDRANT
-  SV SLUICE VALVE
-  TAPER TAPER/REDUCER
-  BEND BEND
-  EOL END CAP
-  WATER SERVICE PIPE
-  WM WATER SERVICE METER
-  C WATER SERVICE CONDUIT 100Ø PVC-O



ENGINEER'S CERTIFICATION

I, _____, hereby certify that:

- The information contained in this drawing / document is in compliance with approved drawings and design.
- The new drainage and transport works defined by this drawing have been designed and constructed in accordance with Council Standards.
- This represents an accurate record of as-constructed works.
- I accept responsibility for the information contained in this drawing / document.

RPEQ (signature): _____ RPEQ No: _____ Date: _____


REGISTERED SURVEYOR'S CERTIFICATION

I, Andrew Robert Thurston, hereby certify that the vertical and horizontal locations and dimensions shown on this plan are a true and correct record and were located by survey.

ALTh
 Registered Surveyor (sig) Reg. Surveyor No. #03047 Date: 20/08/2021



AS CONSTRUCTED

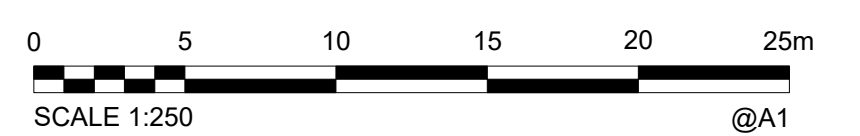

ALL DISTANCES IN METRES
 2015006503-11B

A1	INDEX	DATE	AS CONSTRUCTED	REVISIONS	DRAWN	CHECKED	PASSED	INITIALS	DATE
	A	20/08/2021	AS CONSTRUCTED		J.Braga	A.Dalton-Harvey	A.Thurston		

DRAWN	JWB	20/08/2021
CHECKED	AMDH	20/08/2021
PASSED	ART	20/08/2021

WOLTER consulting group

Planning Urban Design Landscape Environment Surveying

Brisbane: Level 2, 1 Breakfast Ck Road, Newstead, QLD 4006 Phone: (07) 3666 5200



Unitywater

2015006503-11B
 Riverbank Estate
 Market Drive
 SEWER AND WATER RETICULATION

SHEET 6 OF 7 SHEETS	SCALE 250
REVISION DATE 20/08/2021	REVISION A
DISCIPLINE CODE C	
DRAWING NO.	U-2021-3551-WA02

PSM 191027
 E: 4.95937.616
 N: 7003052.339
 RL: 8.767m

583
 SP324946

584
 SP324946

585
 SP324946

586
 SP324946

587
 SP324946

588
 SP324946

589
 SP324946

599
 SP323329

598
 SP323329

597
 SP323329

596
 SP323329

595
 SP323329

594
 SP323329

592
 SP324946

593
 SP324946

MH 2A/22
 Ø900
 SL 11.43

GEORGIA STREET

MS 3/22
 Ø800
 SL 11.13

619
 SP324946

612
 SP323329

613
 SP323329

614
 SP323329

615
 SP323329

616
 SP323329

617
 SP323329

618
 SP323329

620
 SP324946

622
 SP295505

621
 SP295505

1026
 SP324946

COORDINATE DATUM NOTE:
 HORIZONTAL COORDINATES(E,N) SUPPLIED ARE MAPPING GRID OF AUSTRALIA(MGA),
 ZONE 56 BASED ON THE UNIVERSAL TRANSVERSE MERCATOR PROJECTION AND THE
 GEOCENTRIC DATUM OF AUSTRALIA 1994.

LEGEND:

- Ø100 OR Ø150 PVC-U CLASS PN16 WATERMAIN AS NOTED
- EXISTING WATER MAIN
- ▨ DICL WATERMAIN
- RT READY TAP HOUSE CONNECTION
- TB TAPPING BAND HOUSE CONNECTION
- FH HYDRANT
- SV SLUICE VALVE
- TAPER TAPER/REDUCER
- BEND BEND
- EOL END CAP
- WATER SERVICE PIPE
- WM WATER SERVICE METER
- C WATER SERVICE CONDUIT 100Ø PVC-O

ENGINEER'S CERTIFICATION


I, _____, hereby certify that:
 1. The information contained in this drawing / document is in compliance with approved drawings and design.
 2. The new drainage and transport works defined by this drawing have been designed and constructed in accordance with Council Standards.
 3. This represents an accurate record of as-constructed works.
 4. I accept responsibility for the information contained in this drawing / document.

RPEQ (signature) RPEQ No. _____ Date: _____

REGISTERED SURVEYOR'S CERTIFICATION

I, Andrew Robert Thurston, hereby certify that the vertical and horizontal locations and dimensions shown on this plan are a true and correct record and were located by survey.

Registered Surveyor (sig) Reg Surveyor No. #03047 Date: 20/08/2021

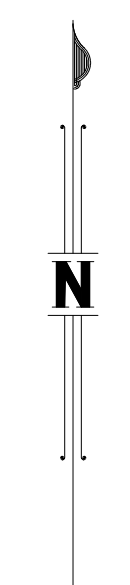

AS CONSTRUCTED



ALL DISTANCES IN METRES
 2015006503-11B

A1

INDEX	DATE	AS CONSTRUCTED	REVISIONS	DRAWN	CHECKED	PASSED
A	20/08/2021	AS CONSTRUCTED		J.Braga	A.Dahn-Harvey	A.Thurston

INITIALS	DATE
DRAWN: JWB	20/08/2021
CHECKED: AMDH	20/08/2021
PASSED: ART	20/08/2021

WOLTER consulting group
 Planning Urban Design Landscape Environment Surveying
 Brisbane: Level 2, 1 Breakfast Ck Road, Newstead, QLD 4006 Phone: (07) 3666 5200



Unitywater

2015006503-11B
 Riverbank Estate
 Market Drive
 SEWER AND WATER RETICULATION

SHEET 7 OF 7	SHEETS	SCALE 250
REVISION DATE	20/08/2021	REVISION A
DISCIPLINE CODE	C	
DRAWING NO.	U-2021-3551-WA03	

PSM 191027
 E: 495937.616
 N: 7003052.339
 RL: 8.767m

COORDINATE DATUM NOTE:
 HORIZONTAL COORDINATES(E,N) SUPPLIED ARE MAPPING GRID OF AUSTRALIA(MGA),
 ZONE 56 BASED ON THE UNIVERSAL TRANSVERSE MERCATOR PROJECTION AND THE
 GEOCENTRIC DATUM OF AUSTRALIA 1994.

LEGEND:


- STORMWATER LINE
- EXISTING STORMWATER LINE
- STORMWATER MANHOLE
- STORMWATER MANHOLE EXTENDED
- STORMWATER PIT
- STORMWATER GULLY PIT
- TOP OF BANK
- BOTTOM OF BANK
- CHANGE OF GRADE
- CONTOURS

Engineers As Constructed Certification

I:
 (engineers name) (RPEQ number)
 being a certified/registered engineer and duly authorised representative of:
 (consulting firm or company name)
 Hereby
 • certify the information contained in this drawing is an accurate as constructed representation of the works
 • accept responsibility for the as constructed survey information contained in this drawing
 • acknowledge the as constructed survey information contained in the drawing may be relied on by council and others
 Certification of Stage: by On / / 2020.
 (stage number) (signature) (date)
 For
 (consulting firm or company name)
 Note: Where consulting firms, company name or stage numbers do not apply, complete with N/A for not applicable

Surveyors As Constructed Certification

I: Andrew Robert Thurston #03047
 (surveyors name) (surveyors registration number)
 being a certified/registered surveyor and duly authorised representative of:
 WOLTER CONSULTING GROUP
 (consulting firm or company name)
 Hereby
 • certify the information contained in this drawing is an accurate as constructed representation of the works
 • accept responsibility for the as constructed survey information contained in this drawing
 • acknowledge the as constructed survey information contained in the drawing may be relied on by council and others
 Certification of Stage: 11B by A.R.T. On 20/08/2020.
 (stage number) (signature) (date)
 For WOLTER CONSULTING GROUP
 (consulting firm or company name)
 Note: Where consulting firms, company name or stage numbers do not apply, complete with N/A for not applicable

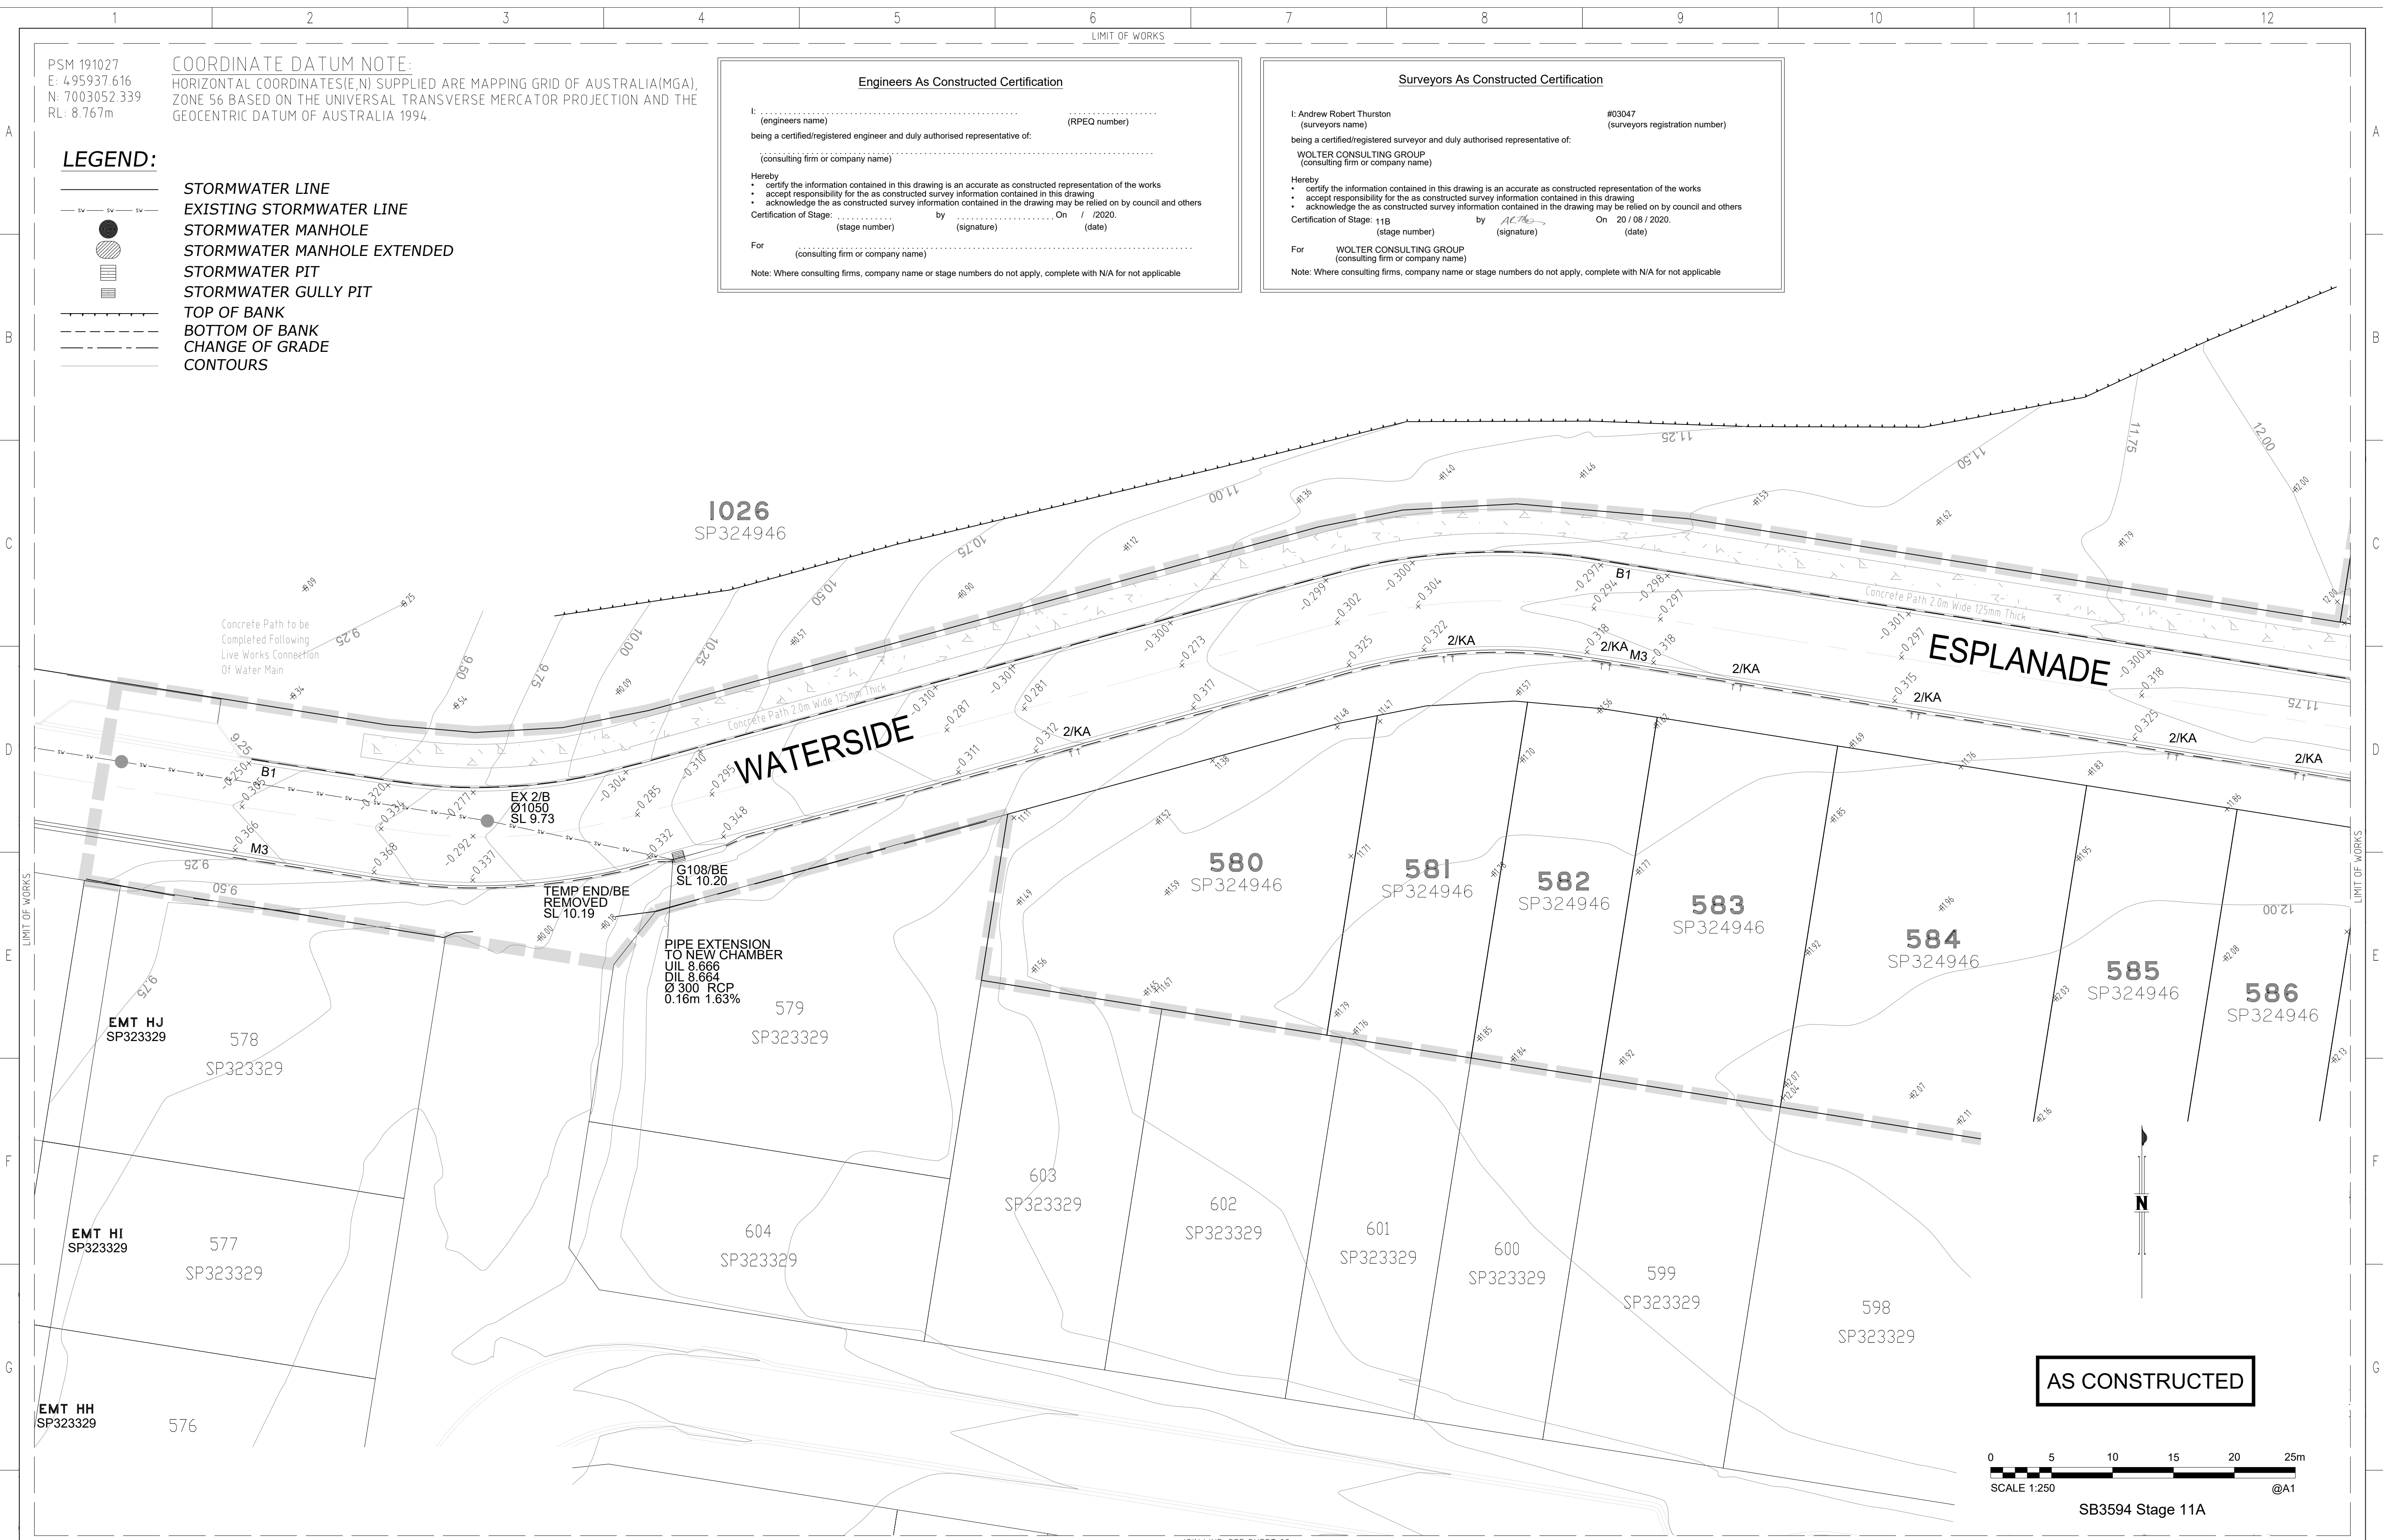

AS CONSTRUCTED



SB3594 Stage 11A

DRAWING REVISIONS		REFERENCE DRAWINGS		DESIGN FILE No.	DESIGNED	<p>WOLTER consulting group</p> <p>Planning Urban Design Landscapes Environment Surveying</p> <p>Brisbane Level 2, 1 Breakfast Ck Road, Newstead, QLD 4006 Phone: 07 5466 5200</p>	<p>MORETON BAY REGIONAL COUNCIL CABOOLTURE DISTRICT OFFICE 2 HASKING STREET CABOOLTURE QLD 4510 PO BOX 159 CABOOLTURE QLD 4510 Telephone: (07) 5433 0100 Fax:</p>	<p align="center">RIVERBANK ESTATE STAGE 11B AS CONSTRUCTED DRAINAGE, TRANSPORT AND SURFACE</p>	SUBDIVISION REFERENCE	
REV.	REVISION DESCRIPTION	DRG. No.	DESCRIPTION	CONSTRUCT. No.	DATE				DA/31012/2015/V4D/1	
A	AS CONSTRUCTED			SB3594/11B	20.08.2021				No. 1 OF 3 PLANS	
					20.08.2021				ASCON GRID NUMBER	
									REV.	
						-	A			

SCALE 1:250 ORIGINAL SIZE A1

JOIN LINE: SEE SHEET 02



LEGEND:

- SW — SW — STORMWATER LINE
- SW — SW — EXISTING STORMWATER LINE
- STORMWATER MANHOLE
- STORMWATER MANHOLE EXTENDED
- STORMWATER PIT
- STORMWATER GULLY PIT
- TOP OF BANK
- BOTTOM OF BANK
- CHANGE OF GRADE
- CONTOURS

COORDINATE DATUM NOTE:

HORIZONTAL COORDINATES(E,N) SUPPLIED ARE MAPPING GRID OF AUSTRALIA(MGA), ZONE 56 BASED ON THE UNIVERSAL TRANSVERSE MERCATOR PROJECTION AND THE GEOCENTRIC DATUM OF AUSTRALIA 1994.

Surveyors As Constructed Certification

I: Andrew Robert Thurston (surveyors name) #03047 (surveyors registration number)
 being a certified/registered surveyor and duly authorised representative of:
 WOLTER CONSULTING GROUP (consulting firm or company name)
 Hereby
 • certify the information contained in this drawing is an accurate as constructed representation of the works
 • accept responsibility for the as constructed survey information contained in this drawing
 • acknowledge the as constructed survey information contained in the drawing may be relied on by council and others
 Certification of Stage: 11B by [Signature] On 20 / 08 / 2020.
 (stage number) (signature) (date)
 For WOLTER CONSULTING GROUP (consulting firm or company name)
 Note: Where consulting firms, company name or stage numbers do not apply, complete with N/A for not applicable

Engineers As Constructed Certification


I: (engineers name) (RPEQ number)
 being a certified/registered engineer and duly authorised representative of:
 (consulting firm or company name)
 Hereby
 • certify the information contained in this drawing is an accurate as constructed representation of the works
 • accept responsibility for the as constructed survey information contained in this drawing
 • acknowledge the as constructed survey information contained in the drawing may be relied on by council and others
 Certification of Stage: (stage number) by (signature) On / / 2020.
 (stage number) (signature) (date)
 For (consulting firm or company name)
 Note: Where consulting firms, company name or stage numbers do not apply, complete with N/A for not applicable

AS CONSTRUCTED



SB3594 Stage 11B

DRAWING REVISIONS		REFERENCE DRAWINGS		DESIGN FILE No.		DESIGNED		<p>WOLTER consulting group</p> <p>Planning Urban Design Landscapes Environment Surveying Brisbane Level 2, 1 Breakfast Ct Road, Newstead, QLD 4006 Phone: 07 5466 5200</p>		<p>MORETON BAY REGIONAL COUNCIL CABOOLTURE DISTRICT OFFICE 2 HASKING STREET CABOOLTURE QLD 4510 PO BOX 159 CABOOLTURE QLD 4510 Telephone: (07) 5433 0100 Fax:</p>		RIVERBANK ESTATE		SUBDIVISION REFERENCE	
REV.	REVISION DESCRIPTION	DRG. No.	DESCRIPTION	CONSTRUCT. No.	DATE	DATE	DATE					STAGE 11A AS CONSTRUCTED		DA/31012/2015/V4D/1	
A	AS CONSTRUCTED			SURVEY FILE No. SB3594/11B	DRAWN	JWB	20.08.2021					DRAINAGE, TRANSPORT AND SURFACE		No. 2 OF 3 PLANS	
				FIELD BOOK	CHECKED	AMDH	20.08.2021					-		ASCON GRID NUMBER	
				LOG BOOK	DATE							-		REV.	
				LEVEL DATUM				-		A					
				DATUM				-		-					

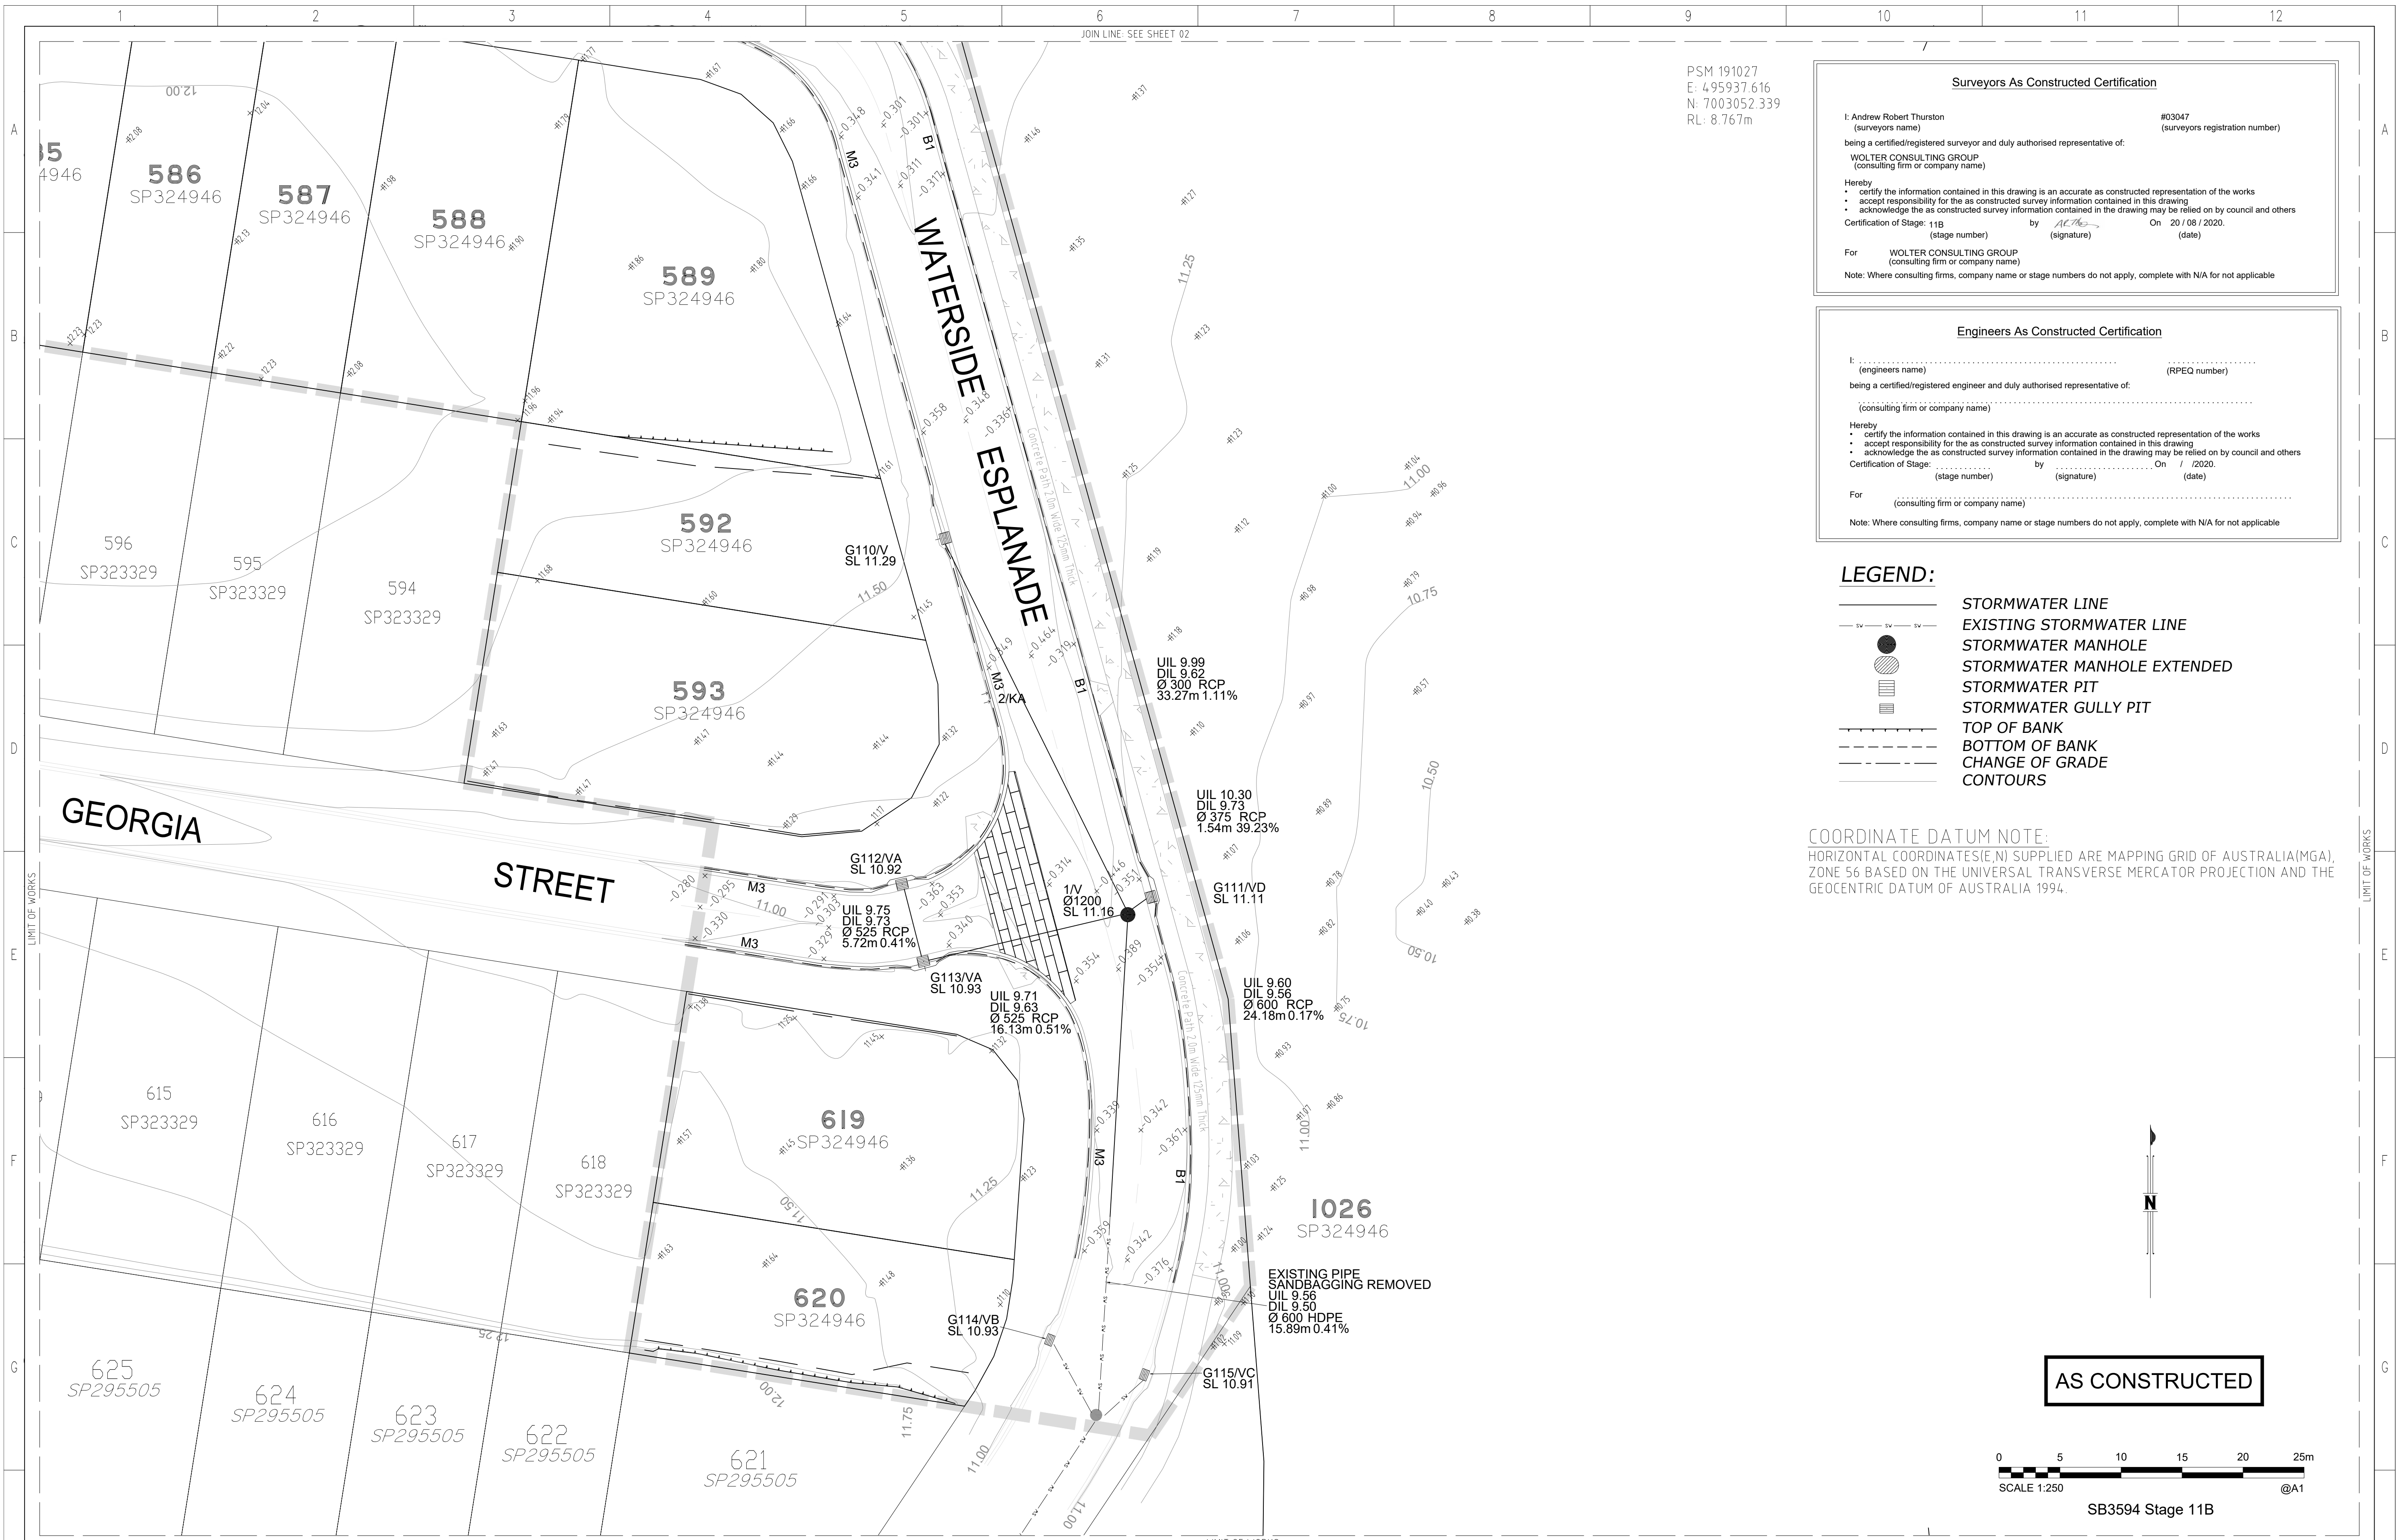

PSM 191027
 E: 495937.616
 N: 7003052.339
 RL: 8.767m

Surveyors As Constructed Certification

I: Andrew Robert Thurston (surveyors name) #03047 (surveyors registration number)
 being a certified/registered surveyor and duly authorised representative of:
WOLTER CONSULTING GROUP (consulting firm or company name)

Hereby
 • certify the information contained in this drawing is an accurate as constructed representation of the works
 • accept responsibility for the as constructed survey information contained in this drawing
 • acknowledge the as constructed survey information contained in the drawing may be relied on by council and others

Certification of Stage: 11B (stage number) by *AC* (signature) On 20/08/2020. (date)

For **WOLTER CONSULTING GROUP** (consulting firm or company name)

Note: Where consulting firms, company name or stage numbers do not apply, complete with N/A for not applicable

Engineers As Constructed Certification

I: (engineers name) (RPEQ number)
 being a certified/registered engineer and duly authorised representative of:
 (consulting firm or company name)

Hereby
 • certify the information contained in this drawing is an accurate as constructed representation of the works
 • accept responsibility for the as constructed survey information contained in this drawing
 • acknowledge the as constructed survey information contained in the drawing may be relied on by council and others

Certification of Stage: (stage number) by (signature) On / / 2020. (date)

For (consulting firm or company name)

Note: Where consulting firms, company name or stage numbers do not apply, complete with N/A for not applicable

- LEGEND:**
- STORMWATER LINE
 - - - EXISTING STORMWATER LINE
 - STORMWATER MANHOLE
 - ⊗ STORMWATER MANHOLE EXTENDED
 - STORMWATER PIT
 - STORMWATER GULLY PIT
 - TOP OF BANK
 - - - BOTTOM OF BANK
 - - - CHANGE OF GRADE
 - CONTOURS

COORDINATE DATUM NOTE:
 HORIZONTAL COORDINATES(E,N) SUPPLIED ARE MAPPING GRID OF AUSTRALIA(MGA), ZONE 56 BASED ON THE UNIVERSAL TRANSVERSE MERCATOR PROJECTION AND THE GEOCENTRIC DATUM OF AUSTRALIA 1994.

AS CONSTRUCTED



SB3594 Stage 11B @A1

DRAWING REVISIONS		REFERENCE DRAWINGS		DESIGN FILE No.		DESIGNED	
REV.	REVISION DESCRIPTION	DRG. No.	DESCRIPTION	CONSTRUCT. No.	DATE	DATE	DATE
A	AS CONSTRUCTED			SB3594/11B	20.08.2021	20.08.2021	20.08.2021

WOLTER consulting group

Planning Urban Design Landscapes Environment Surveying

Brisbane Level 2, 1 Breakfast Ct Road, Newstead, QLD 4006 Phone: 07 5466 5200

SCALE 1:250 ORIGINAL SIZE A1

Moreton Bay Regional Council

MORETON BAY REGIONAL COUNCIL
 CABOOLTURE DISTRICT OFFICE
 2 HASKING STREET CABOOLTURE QLD 4510
 PO BOX 159 CABOOLTURE QLD 4510
 Telephone: (07) 5493 0100
 Fax:

RIVERBANK ESTATE
 STAGE 11B
 AS CONSTRUCTED
 DRAINAGE, TRANSPORT AND SURFACE

SUBDIVISION REFERENCE	
DA/31012/2015/V4D/1	
No. 3 OF 3 PLANS	
ASCON GRID NUMBER	REV.
-	A