


# SPRING MOUNTAIN ACREAGE ESTATE STAGE 18B

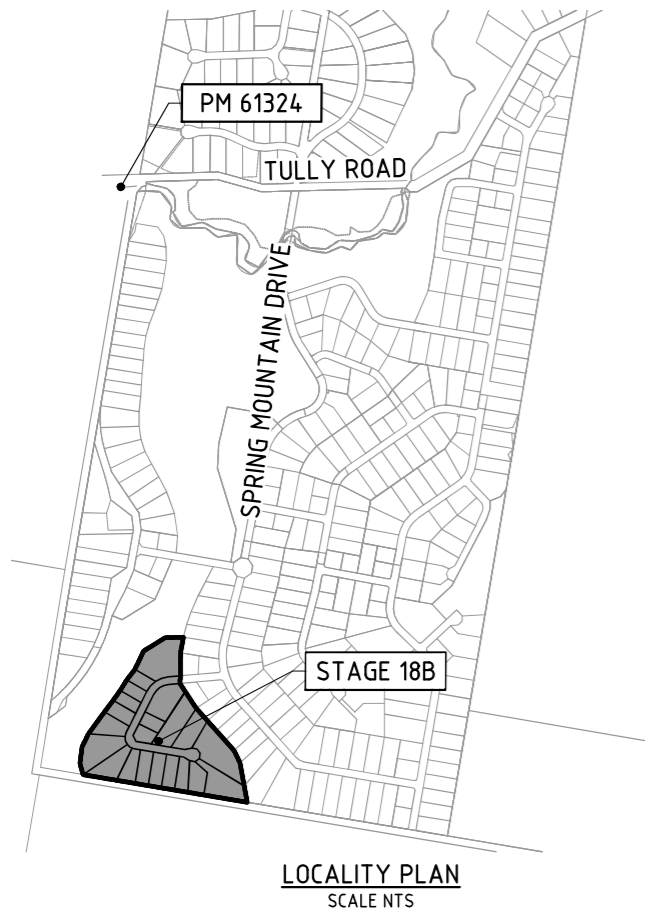

### GENERAL NOTES

- ALL WORK SHALL BE JOINED NEATLY TO EXISTING CONSTRUCTION.
- WHERE REFERENCE IS MADE ON THESE DRAWINGS TO A KERB LINE, IT SHALL BE TAKEN TO MEAN THE KERB INVERT LINE.
- LEVELS FOR KERB AND CHANNEL CONSTRUCTION ARE SHOWN AT LIP OF CHANNEL UNLESS SHOWN OTHERWISE.
- KERB AND CHANNEL AND SPOON DRAINS SHALL BE CONSTRUCTED IN ACCORDANCE WITH INSTITUTE OF PUBLIC WORKS ENGINEERING AUSTRALIA STANDARD DWG NO SEQ RS-80. SPOON DRAINS ACROSS ROAD INTERSECTIONS SHALL BE IN ACCORDANCE WITH INSTITUTE OF PUBLIC WORKS ENGINEERING AUSTRALIA STD DWG NO SEQ RS-80. THE CONCRETE SHALL BE CLASS N32 AND THE DEPTH INCREASED BY 50mm TO 175mm AT INVERT. FLUSH KERB TO BE INCREASED IN DEPTH BY 50mm TO 280mm.
- IF MACHINE MADE KERB AND CHANNEL IS USED, EXTRA FINES AND 20mm SLUMP IS REQUIRED.
- ALL DRAINAGE CENTRE LINES ARE 2m FROM INVERT OF KERB UNLESS OTHERWISE SHOWN.
- GULLY CONNECTIONS AND STORMWATER PIPES SHALL BE 375mm DIAMETER CLASS '2' R.C. PIPES UNLESS SHOWN OTHERWISE.
- THE CONTRACTOR SHALL INITIALLY EXCAVATE THE PAVEMENT BOX TO 280mm BELOW THE FINISHED PAVEMENT LEVEL SHOWN ON THE DRAWINGS. HE SHALL THEN NOTIFY THE ENGINEER WHO WILL FIX THE PAVEMENT THICKNESS TO BE CONSTRUCTED FOLLOWING THE RESULTS OF SUB-GRADE TESTING.
- NOTWITHSTANDING THE LIMITS OF CUTTING AND FILLING SHOWN ON THE DRAWINGS, THE ACTUAL LIMITS SHALL BE DETERMINED ON SITE BY THE ENGINEER AND SIMILARLY THE FINISHED SURFACE CONTOURS MAY BE ADJUSTED BY WRITTEN DIRECTION OF THE ENGINEER DURING CONSTRUCTION.
- THE MINIMUM CLEARANCE BETWEEN OUTER WALLS OF PIPES IN MANHOLES SHALL BE 150mm.
- SUBSURFACE DRAIN CLEANING POINTS SHALL BE INSTALLED IN ACCORDANCE WITH IPWEAQ STD DWG NO SEQ RS-142.
- CONSTRUCTION LOAD CONTROL ON THE INSTALLATION OF REINFORCED CONCRETE STORMWATER PIPE WORK SHALL BE UNDERTAKEN IN ACCORDANCE WITH THE RECOMMENDATIONS DEFINED IN THE CONCRETE PIPE ASSOCIATIONS OF AUSTRALASIA'S "THE INSTALLATIONS OF STEEL REINFORCED CONCRETE PIPES - MINIMUM PIPE COVER REQUIRED FOR VARIOUS COMPACTORS".
- PRIOR TO COMMENCEMENT OF CONSTRUCTION, THE CONTRACTOR SHALL ERECT A 2 STRAND WIRE FENCE INCLUDING SAFETY BARRIER MESH TO THE PERIMETER OF VEGETATION TO BE RETAINED AND/OR EXCLUSION ZONES.
- THE CONTRACTOR SHALL BE RESPONSIBLE FOR VERIFYING THE LOCATION AND DEPTH OF EXISTING SERVICES WITH RELEVANT AUTHORITIES/DIAL BEFORE YOU DIG PRIOR TO COMMENCING WORKS.
- THE CONTRACTOR SHALL NOTE THE PRESENCE OF EXISTING SERVICES ASSOCIATED WITH THE WORKS. SPECIAL CARE MUST BE TAKEN BY THE CONTRACTOR IN THE VICINITY OF ALL SERVICES.

### ROOFWATER

- THE ENDS OF 150mm ROOFWATER CONNECTIONS FROM LOT DIRECTLY TO GULLY PIT SHALL BE CAPPED AND LOCATED WITH NOT LESS THAN 300mm AND NOT MORE THAN 450mm COVER UNLESS OTHERWISE APPROVED.
- PROVIDE 1 x KERB ADAPTORS FOR ALL LOTS GRADING TO KERB AND CHANNEL AS PER LAYOUT PLAN. ALL KERB ADAPTORS SHALL BE CAST INTO KERB AND CHANNEL.
- ROOFWATER KERB ADAPTORS SHALL BE LOCATED IN THE KERB AND CHANNEL FOR EACH ALLOTMENT THAT DRAINS PREDOMINANTLY TO THE ROAD FRONTAGE. KERB ADAPTORS SHALL BE LOCATED 0.6 METERS OFF THE SIDE BOUNDARY POSITION OR IF THE ALLOTMENT DRAINS PREDOMINANTLY TO ONE SIDE BOUNDARY THEN LOCATE BOTH KERB ADAPTORS 0.3 METERS AND APART 0.5 METERS OFF THE LOWER BOUNDARY LINE.

### DRAWING INDEX



DRAWING NO.	DRAWING TITLE
18-201-01	GENERAL - LOCALITY PLAN, DRAWING INDEX AND NOTES
18-201-02	GENERAL - SETOUT PLAN
18-201-03	GENERAL - LAYOUT PLAN - SHEET 1
18-201-04	GENERAL - LAYOUT PLAN - SHEET 2
18-201-05	GENERAL - LAYOUT PLAN - SHEET 3
18-201-06	EARTHWORKS - CONTOUR PLAN - SHEET 1
18-201-07	EARTHWORKS - CONTOUR PLAN - SHEET 2
18-201-08	EARTHWORKS - CONTOUR PLAN - SHEET 3
18-201-09	EARTHWORKS - BUSHFIRE ACCESS TRAIL - TYPICAL SECTIONS
18-201-10	ROADWORKS - LONGITUDINAL SECTION - DAWSON CLOSE
18-201-11	ROADWORKS - CROSS SECTIONS - DAWSON CLOSE - SHEET 1
18-201-12	ROADWORKS - CROSS SECTIONS - DAWSON CLOSE - SHEET 2
18-201-13	ROADWORKS - CROSS SECTIONS - DAWSON CLOSE - SHEET 3
18-201-14	ROADWORKS - INTERSECTION DETAILS
18-201-15	STORMWATER - CATCHMENT PLAN
18-201-16	STORMWATER - CALCULATION TABLE
18-201-17	STORMWATER - LONGITUDINAL SECTIONS AND GULLY DETAIL
18-201-18	STORMWATER - CULVERT DETAIL
<del>18-201-19</del>	<del>EROSION AND SEDIMENT CONTROL - LAYOUT PLAN - CONSTRUCTION PHASE - SHEET 1</del>
<del>18-201-20</del>	<del>EROSION AND SEDIMENT CONTROL - LAYOUT PLAN - CONSTRUCTION PHASE - SHEET 2</del>
<del>18-201-21</del>	<del>EROSION AND SEDIMENT CONTROL - LAYOUT PLAN - CONSTRUCTION PHASE - SHEET 3</del>
18-201-22	EROSION AND SEDIMENT CONTROL - LAYOUT PLAN - POST CONSTRUCTION PHASE - SHEET 1
18-201-23	EROSION AND SEDIMENT CONTROL - LAYOUT PLAN - POST CONSTRUCTION PHASE - SHEET 2
18-201-24	EROSION AND SEDIMENT CONTROL - LAYOUT PLAN - POST CONSTRUCTION PHASE - SHEET 3
18-201-25	EROSION AND SEDIMENT CONTROL - NOTES
18-201-26	EROSION AND SEDIMENT CONTROL - DETAILS
18-201-27	WATER RETICULATION - LAYOUT PLAN - SHEET 1
18-201-28	WATER RETICULATION - LAYOUT PLAN - SHEET 2
18-201-29	WATER RETICULATION - LIVE CONNECTION DETAILS AND NOTES
<del>18-201-30</del>	<del>SAFETY IN DESIGN</del>
18-201-31	TARP EXTENTS - SHEET 1
18-201-32	TARP EXTENTS - SHEET 2
18-201-33	TARP EXTENTS - SHEET 3
18-201-34	EASEMENT PLAN

**MARK SHAW**  
I, ..... hereby certify that the As Constructed information shown on this plan is a true and correct record of the sizes, types, materials, classes etc., and it corresponds with the relevant approved Engineering Drawings.

*M. Shaw*  
Mark Andrew Shaw  
REG. CIVIL ENGINEER  
RPEQ 17044  
2021-05-04 12:52:24  
11000

Signed..... RPEQ No. 17544 Dated... 06.05.2021.....

**DATUM A.H.D.**  
P.M. No 61324  
E 491712.179  
N 6931003.529  
RL 69.322

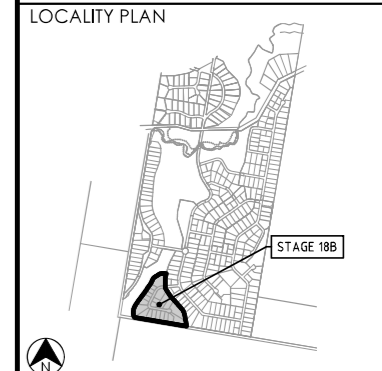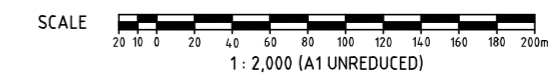

### REVISIONS

No	Description	Date	By
A	ISSUED FOR APPROVAL	11/06/20	DES
B	DRAWING 34 ADDED	20/06/20	DES
C	REVISED LOTS	23/09/20	DES
D	AS CONSTRUCTED WATER AND EWKS	04/03/21	LMS
E	AS CONSTRUCTED FINAL	06/05/21	LMS

Client

# PEET

Project

**SPRING MOUNTAIN  
ACREAGE ESTATE  
STAGE 18B**

OW/106/2020

Approved

Drawing Title

**GENERAL  
LOCALITY PLAN,  
DRAWING INDEX AND NOTES**

Drawn	Designed	Checked	Date
LMS	JB	GG	JUN 20

Scale	Sheet
AS SHOWN	01 of 33

Drawing No	Revision
18-201-01	E

DO NOT SCALE THIS DRAWING  
IF IN DOUBT - ASK!



LOCALITY PLAN



REVISIONS

No	Description	Date	By
A	ISSUED FOR APPROVAL	11/06/20	DES
B	REVISED LOTS / EASEMENT	23/09/20	DES
C	AS CONSTRUCTED FINAL	06/05/21	LMS

Client

**PEET**

Project

**SPRING MOUNTAIN  
ACREAGE ESTATE  
STAGE 18B**

OW/106/2020

**kn group**  
ABN 35 112 53 611  
L1, 62 Astor Terrace  
Spring Hill Q 4000  
07 3017 1900  
www.knigroup.com.au

Approved

Drawing Title  
**GENERAL  
SETOUT  
PLAN**

Drawn	Designed	Checked	Date
LMS	JB	GG	JUN 20
Scale AS SHOWN			Sheet 02 of 33
Drawing No A1 18-201-02		Revision C	



**SETOUT PLAN**  
SCALE 1:1000

**CONTROL LINE DETAILS - DAWSON CLOSE**

PT	CHAINAGE	EASTING	NORTHING	BEARING	RADIUS	TANGENT	DEF ANGLE	ARC-LEN
IP1	0.000	491986.296	6929712.643	253d34'49"	-	-	-	-
TC	11.430	491975.332	6929709.412	253d34'49"	-	-	-	-
IP2	12.848	491973.967	6929709.010	-	14.100	1.423	11d31'27"	2.836
CT	14.266	491972.550	6929708.889	265d06'17"	-	-	-	-
TC	149.103	491838.205	6929697.382	265d06'17"	-	-	-	-
IP3	179.792	491804.648	6929694.508	-	60.000	33.679	58d36'46"	61.379
CT	210.482	491789.625	6929664.365	206d29'31"	-	-	-	-
TC	332.188	491735.336	6929555.439	206d29'31"	-	-	-	-
IP4	350.854	491723.291	6929531.272	-	20.000	27.002	106d56'48"	37.331
CT	369.519	491749.919	6929526.794	99d32'42"	-	-	-	-
TC	502.160	491880.724	6929504.799	99d32'42"	-	-	-	-
IP5	508.987	491887.730	6929503.621	-	20.000	7.104	39d06'42"	13.653
CT	515.813	491892.422	6929498.287	138d39'25"	-	-	-	-
IP6	526.950	491899.779	6929489.926	138d39'25"	-	-	-	-

I, **MARK SHAW**

hereby certify that the As Constructed information shown on this plan is a true and correct record of the sizes, types, materials, classes etc., and it corresponds with the relevant approved Engineering Drawings.

Signed *M. Shaw* RPEQ No. 17544 Dated 06.05.2021

Mark Andrew Shaw  
RPEQ 17544  
2021.05.06 12:52:38  
+1800

**LEGEND**

--- CONSTRUCTION BOUNDARY  
--- PROPOSED ROAD CENTRELINE

SCALE 1: 1000 (A1 UNREDUCED)




**LEGEND**

- CONSTRUCTION BOUNDARY
- PROPOSED ROAD CENTRELINE
- KERB AND CHANNEL (TYPE M3)
- KERB AND CHANNEL (TYPE SM3)
- Q100 FLOOD POST CONSTRUCTION EXTENTS
- 300mm FREEBOARD EXTENTS
- STORMWATER DRAINAGE
- TARP BOUNDARY
- SW EXISTING STORMWATER DRAINAGE
- W WATER MAIN
- 36.0 FINISHED SURFACE CONTOURS
- 36.0 LIDAR CONTOURS
- 36.0 DTM SURVEY CONTOURS
- BATTER LINE - TOP
- BATTER LINE - BOTTOM
- EASEMENT
- × KERB ADAPTOR LOCATION
- SUBSURFACE DRAIN CLEANING POINT
- 150Ø uPVC ROOFWATER CONNECTION TO GULLY PIT/MH
- 14C STORMWATER MANHOLE TEXT
- G147 STORMWATER GULLY TEXT
- ▲ PROPOSED DRIVEWAY LOCATION
- ROCK SCOUR PROTECTION WITH IMPERMEABLE LINER BENEATH

**NOTE**  
ALL BATTERS TO BE 1(V) : 4(H) MAXIMUM.

**MARK SHAW**  
I, hereby certify that the As Constructed information shown on this plan is a true and correct record of the sizes, types, materials, classes etc., and it corresponds with the relevant approved Engineering Drawings.

Signed *M. Shaw* RPEQ No. 17544 Dated 06.05.2021

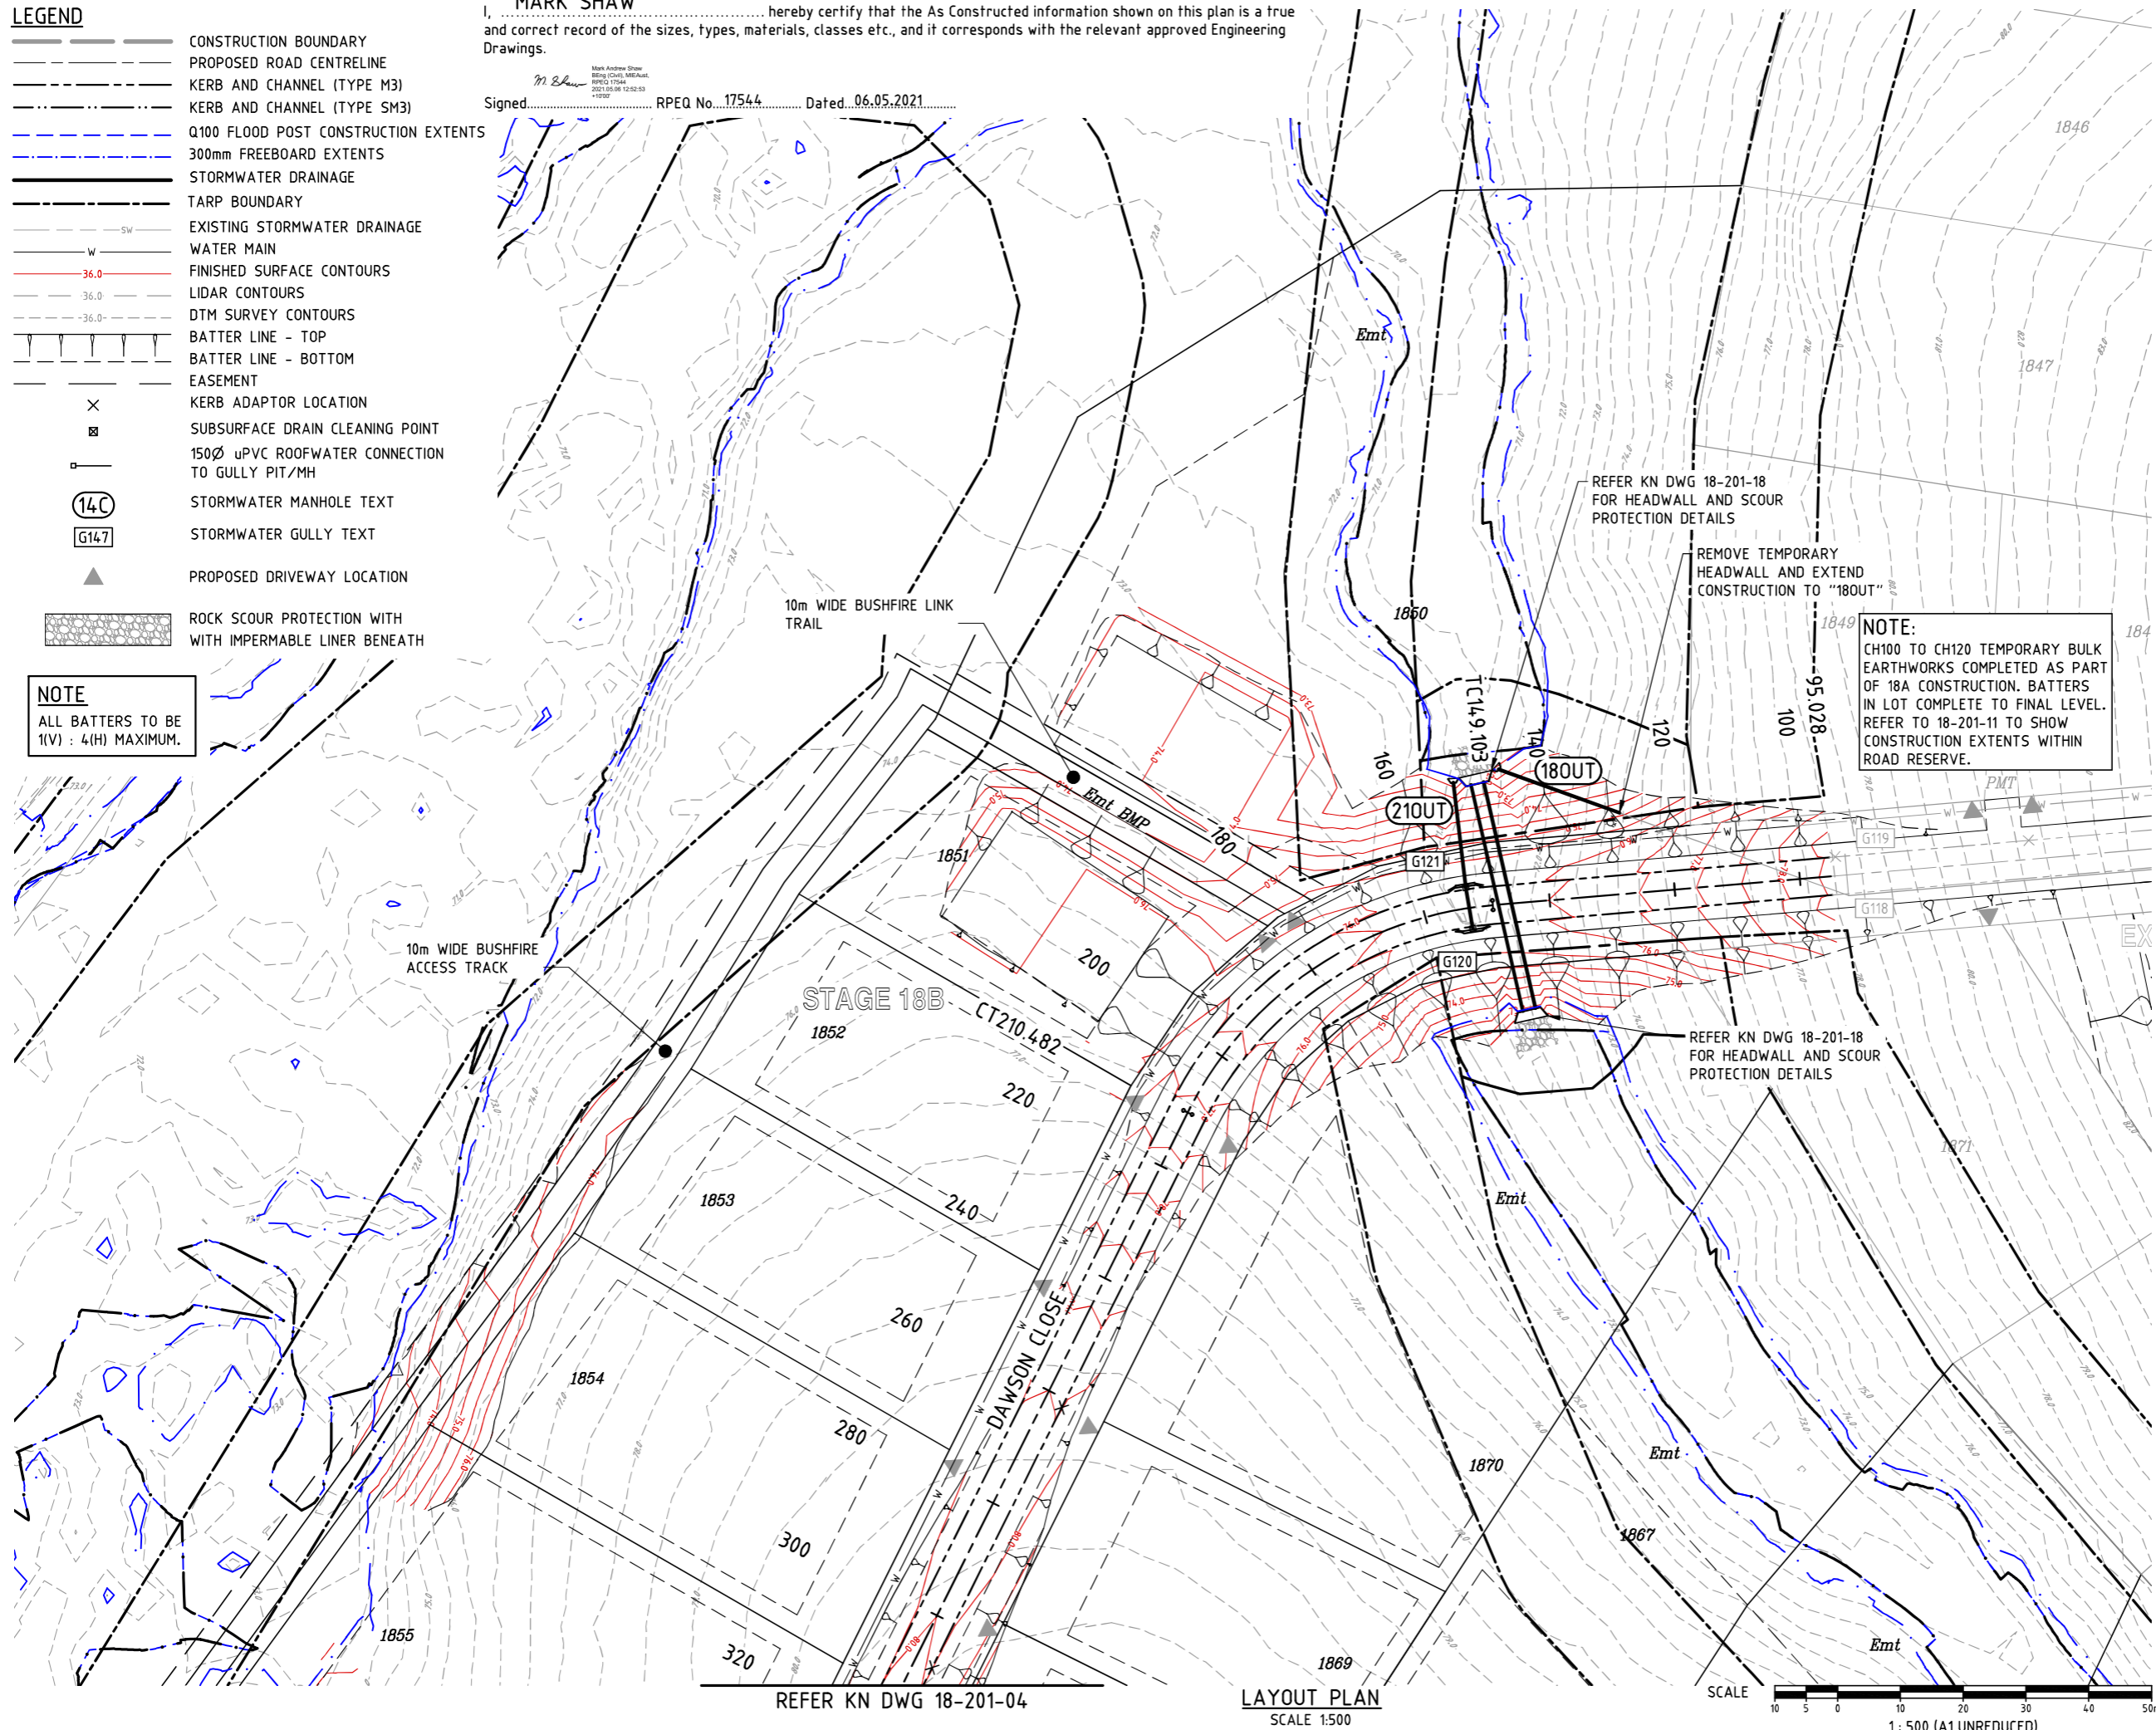

REFER KN DWG 18-201-04


LAYOUT PLAN  
SCALE 1:500

SCALE 1:500 (A1 UNREDUCED)

DO NOT SCALE THIS DRAWING  
IF IN DOUBT - ASK!



LOCALITY PLAN

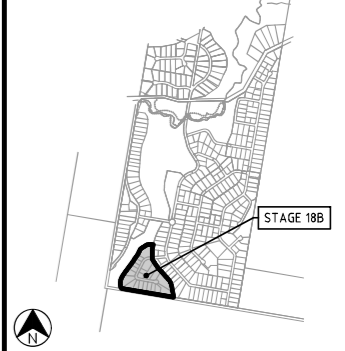

REVISIONS

No	Description	Date	By
A	ISSUED FOR APPROVAL	11/06/20	DES
B	REVISED EARTHWORKS	20/06/20	DES
C	REVISED LOTS / EASEMENT	23/09/20	DES
D	AS CONSTRUCTED FINAL	06/05/21	LMS

**NOTE:**  
CH100 TO CH120 TEMPORARY BULK EARTHWORKS COMPLETED AS PART OF 18A CONSTRUCTION. BATTERS IN LOT COMPLETE TO FINAL LEVEL. REFER TO 18-201-11 TO SHOW CONSTRUCTION EXTENTS WITHIN ROAD RESERVE.

REFER KN DWG 18-201-18 FOR HEADWALL AND SCOUR PROTECTION DETAILS

REMOVE TEMPORARY HEADWALL AND EXTEND CONSTRUCTION TO "180UT"

REFER KN DWG 18-201-18 FOR HEADWALL AND SCOUR PROTECTION DETAILS



Client

Project  
**SPRING MOUNTAIN  
ACREAGE ESTATE  
STAGE 18B**  
OW/106/2020



Approved


Drawing Title  
**GENERAL  
LAYOUT PLAN  
SHEET 1**

Drawn LMS	Designed JB	Checked GG	Date JUN 20
Scale AS SHOWN	Sheet 03 of 33		Revision D
A1	Drawing No 18-201-03		

M:\2018\201 Spring Mountain Stage 18B\Engineering\Ascon\18-201-03-05-05-LAYOUT.dwg Plotted by: DS on 6/05/2021 12:02:02 PM



14/2018/18201 Spring Mountain Stage 18B Engineering\Ascom\18-201-03-05-df-LAYOUT.dwg Plotted by: DS on 6/05/2021 12:02:06 PM

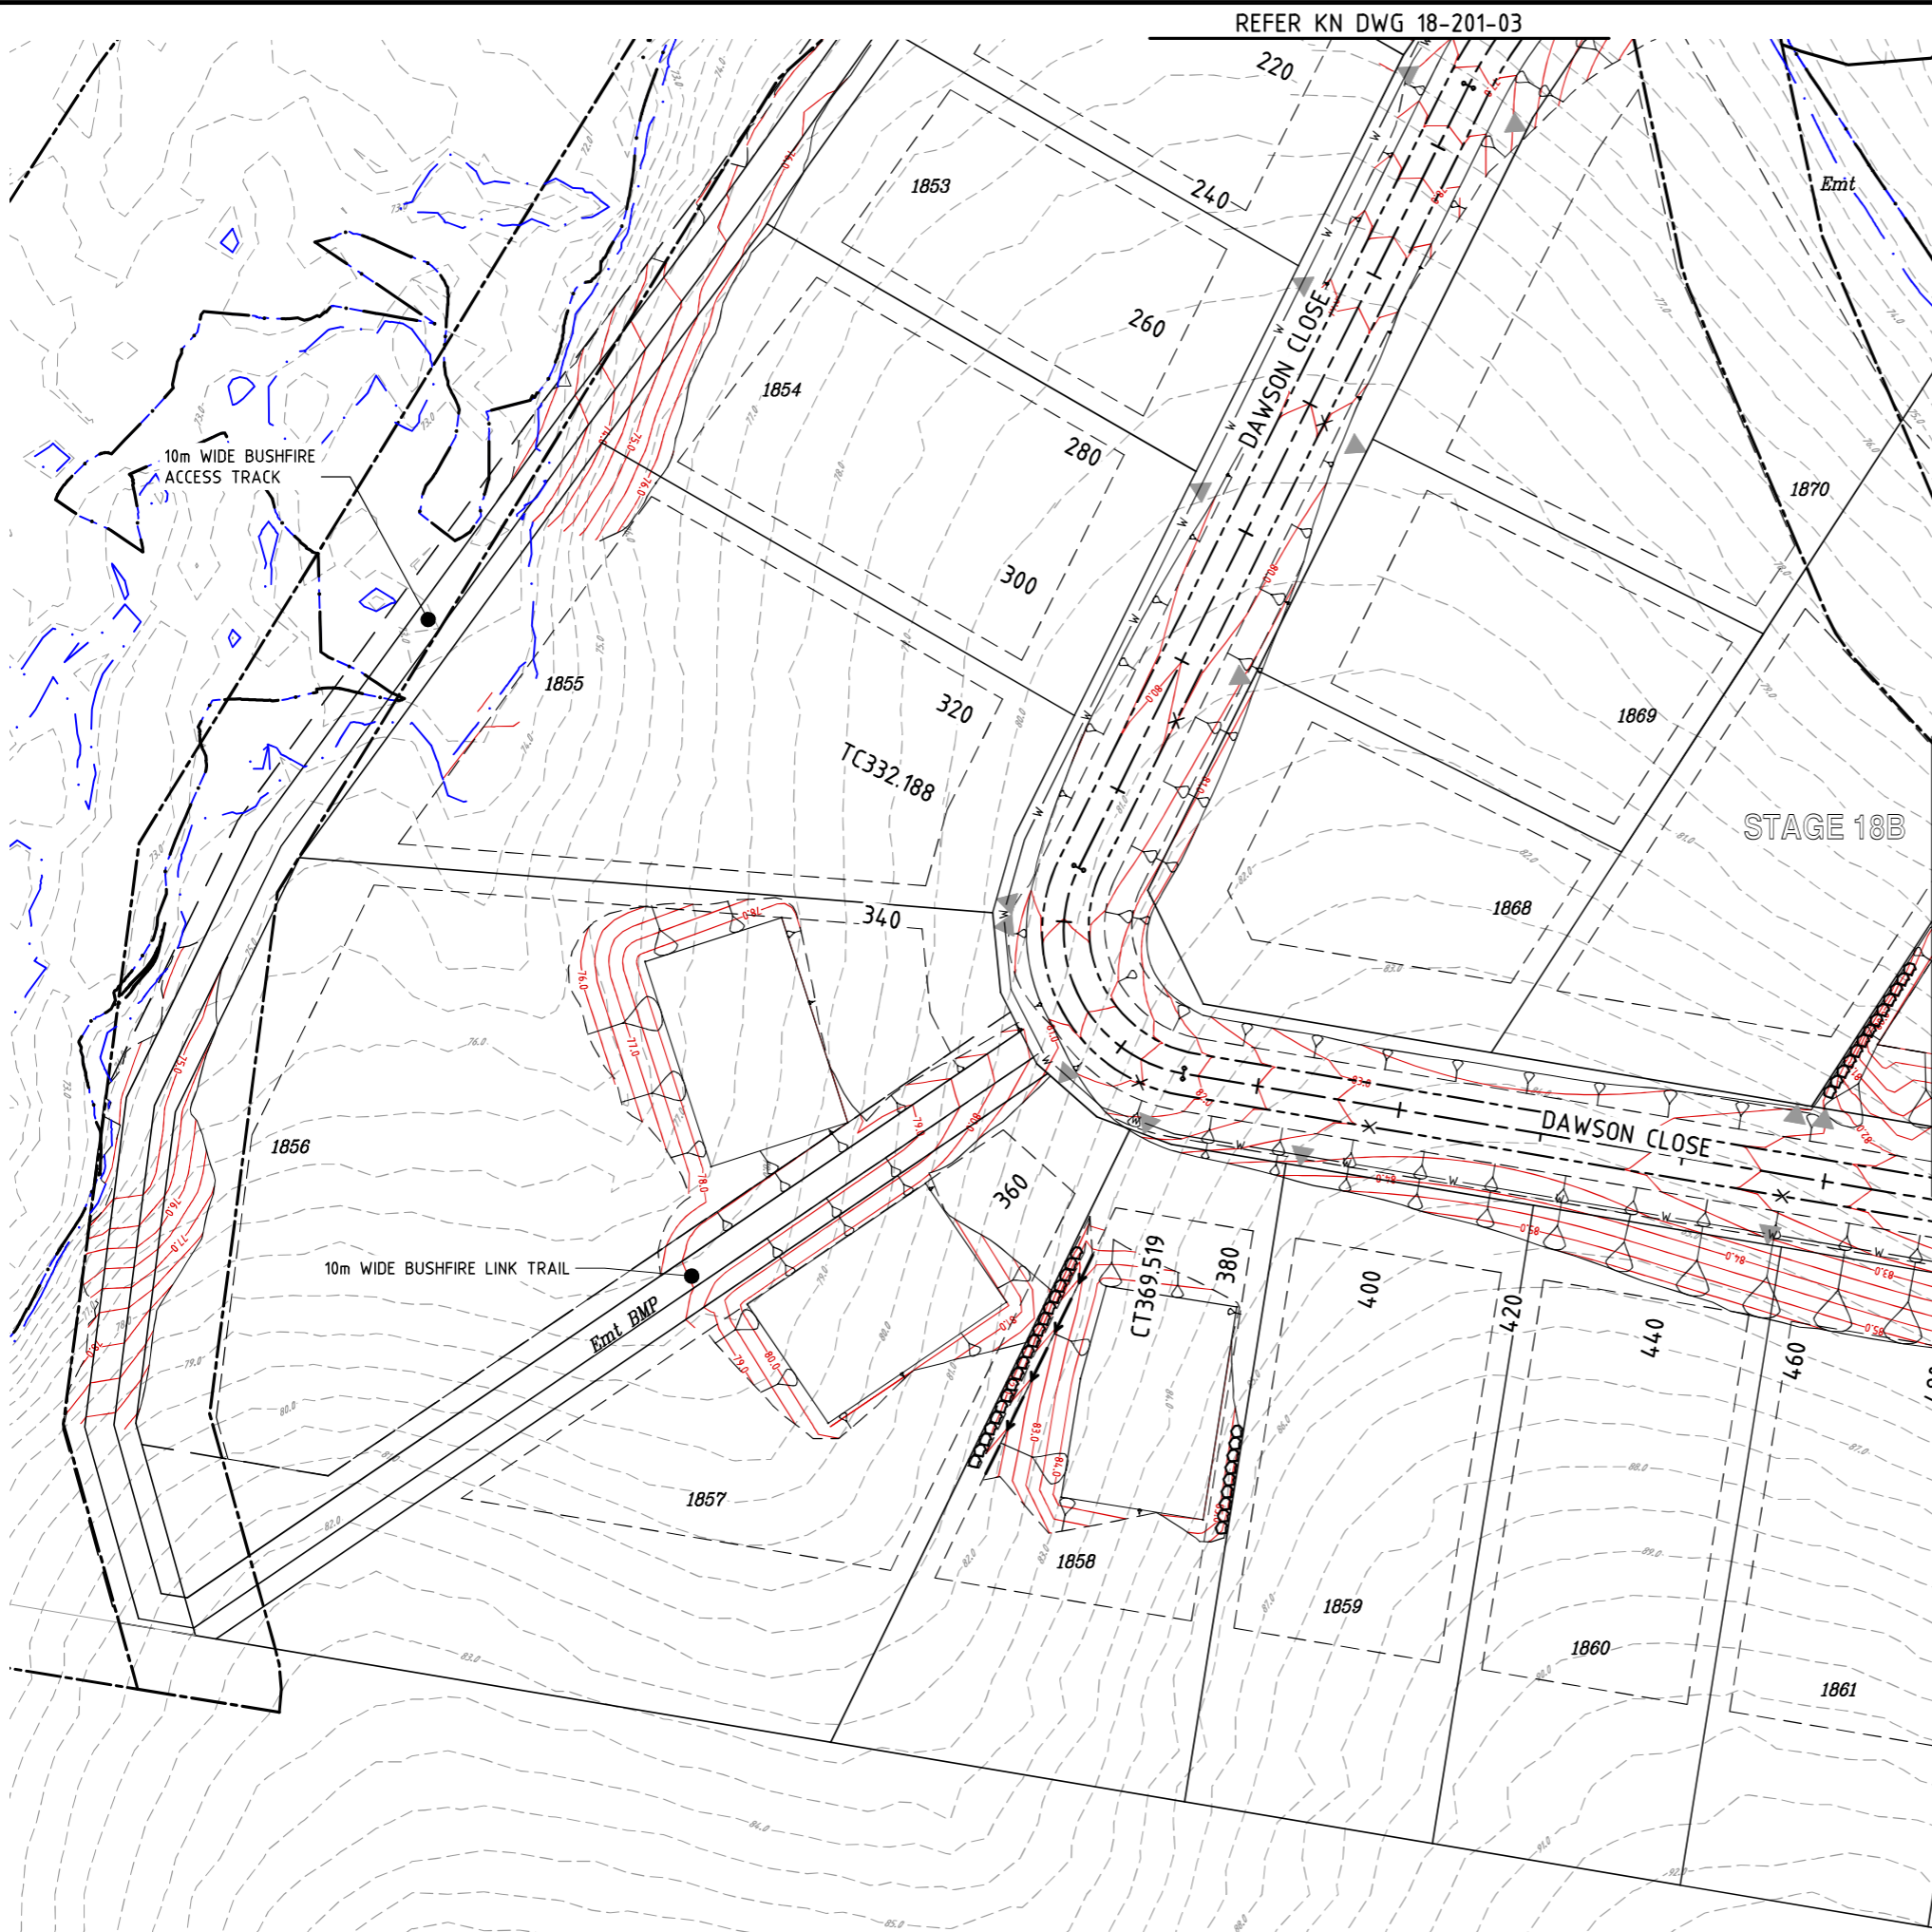

REFER KN DWG 18-201-03

REFER KN DWG 18-201-05

LAYOUT PLAN  
SCALE 1:500


I, **MARK SHAW**, hereby certify that the As Constructed information shown on this plan is a true and correct record of the sizes, types, materials, classes etc., and it corresponds with the relevant approved Engineering Drawings.

Signed: *Mark Shaw* RPECO No. 17544 Dated: 06.05.2021


Mark Andrew Shaw RPECO (Civil) No. 17544 2021.05.08 12:30:38 +10:00

**NOTE**  
ALL BATTERS TO BE 1(V) : 4(H) MAXIMUM.

- LEGEND**
- CONSTRUCTION BOUNDARY
  - PROPOSED ROAD CENTRELINE
  - KERB AND CHANNEL (TYPE M3)
  - KERB AND CHANNEL (TYPE SM3)
  - Q100 FLOOD POST CONSTRUCTION EXTENTS
  - 300mm FREEBOARD EXTENTS
  - STORMWATER DRAINAGE
  - TARP BOUNDARY
  - EXISTING STORMWATER DRAINAGE
  - WATER MAIN
  - FINISHED SURFACE CONTOURS
  - LIDAR CONTOURS
  - DTM SURVEY CONTOURS
  - BATTER LINE - TOP
  - BATTER LINE - BOTTOM
  - ROCK BOULDER RETAINING WALL
  - EASEMENT
  - SWALE
  - KERB ADAPTOR LOCATION
  - SUBSURFACE DRAIN CLEANING POINT
  - 150Ø uPVC ROOFWATER CONNECTION TO GULLY PIT/MH
  - (14C) STORMWATER MANHOLE TEXT
  - (G147) STORMWATER GULLY TEXT
  - PROPOSED DRIVEWAY LOCATION

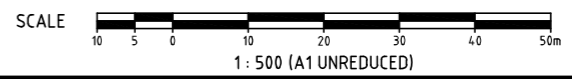

DO NOT SCALE THIS DRAWING IF IN DOUBT - ASK!

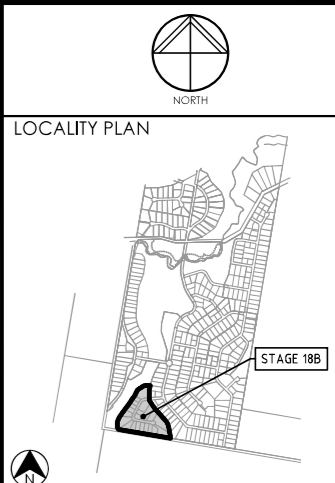

REVISIONS

No	Description	Date	By
A	ISSUED FOR APPROVAL	11/06/20	DES
B	REVISED EARTHWORKS	20/06/20	DES
C	REVISED LOTS / EASEMENT	23/09/20	DES
D	AS CONSTRUCTED FINAL	06/05/21	LMS

Client

# PEET

Project

**SPRING MOUNTAIN**  
ACREAGE ESTATE  
STAGE 18B

OW/106/2020

Approved


ABN 35 112 53 611  
L1, 62 Astor Tce  
Spring Hill Q 4000  
07 3017 1900  
www.kngroup.com.au

Drawing Title

**GENERAL LAYOUT PLAN SHEET 2**

Drawn LMS	Designed JB	Checked GG	Date JUN 20
Scale AS SHOWN	Drawing No 18-201-04	Sheet 04 of 33	Revision D



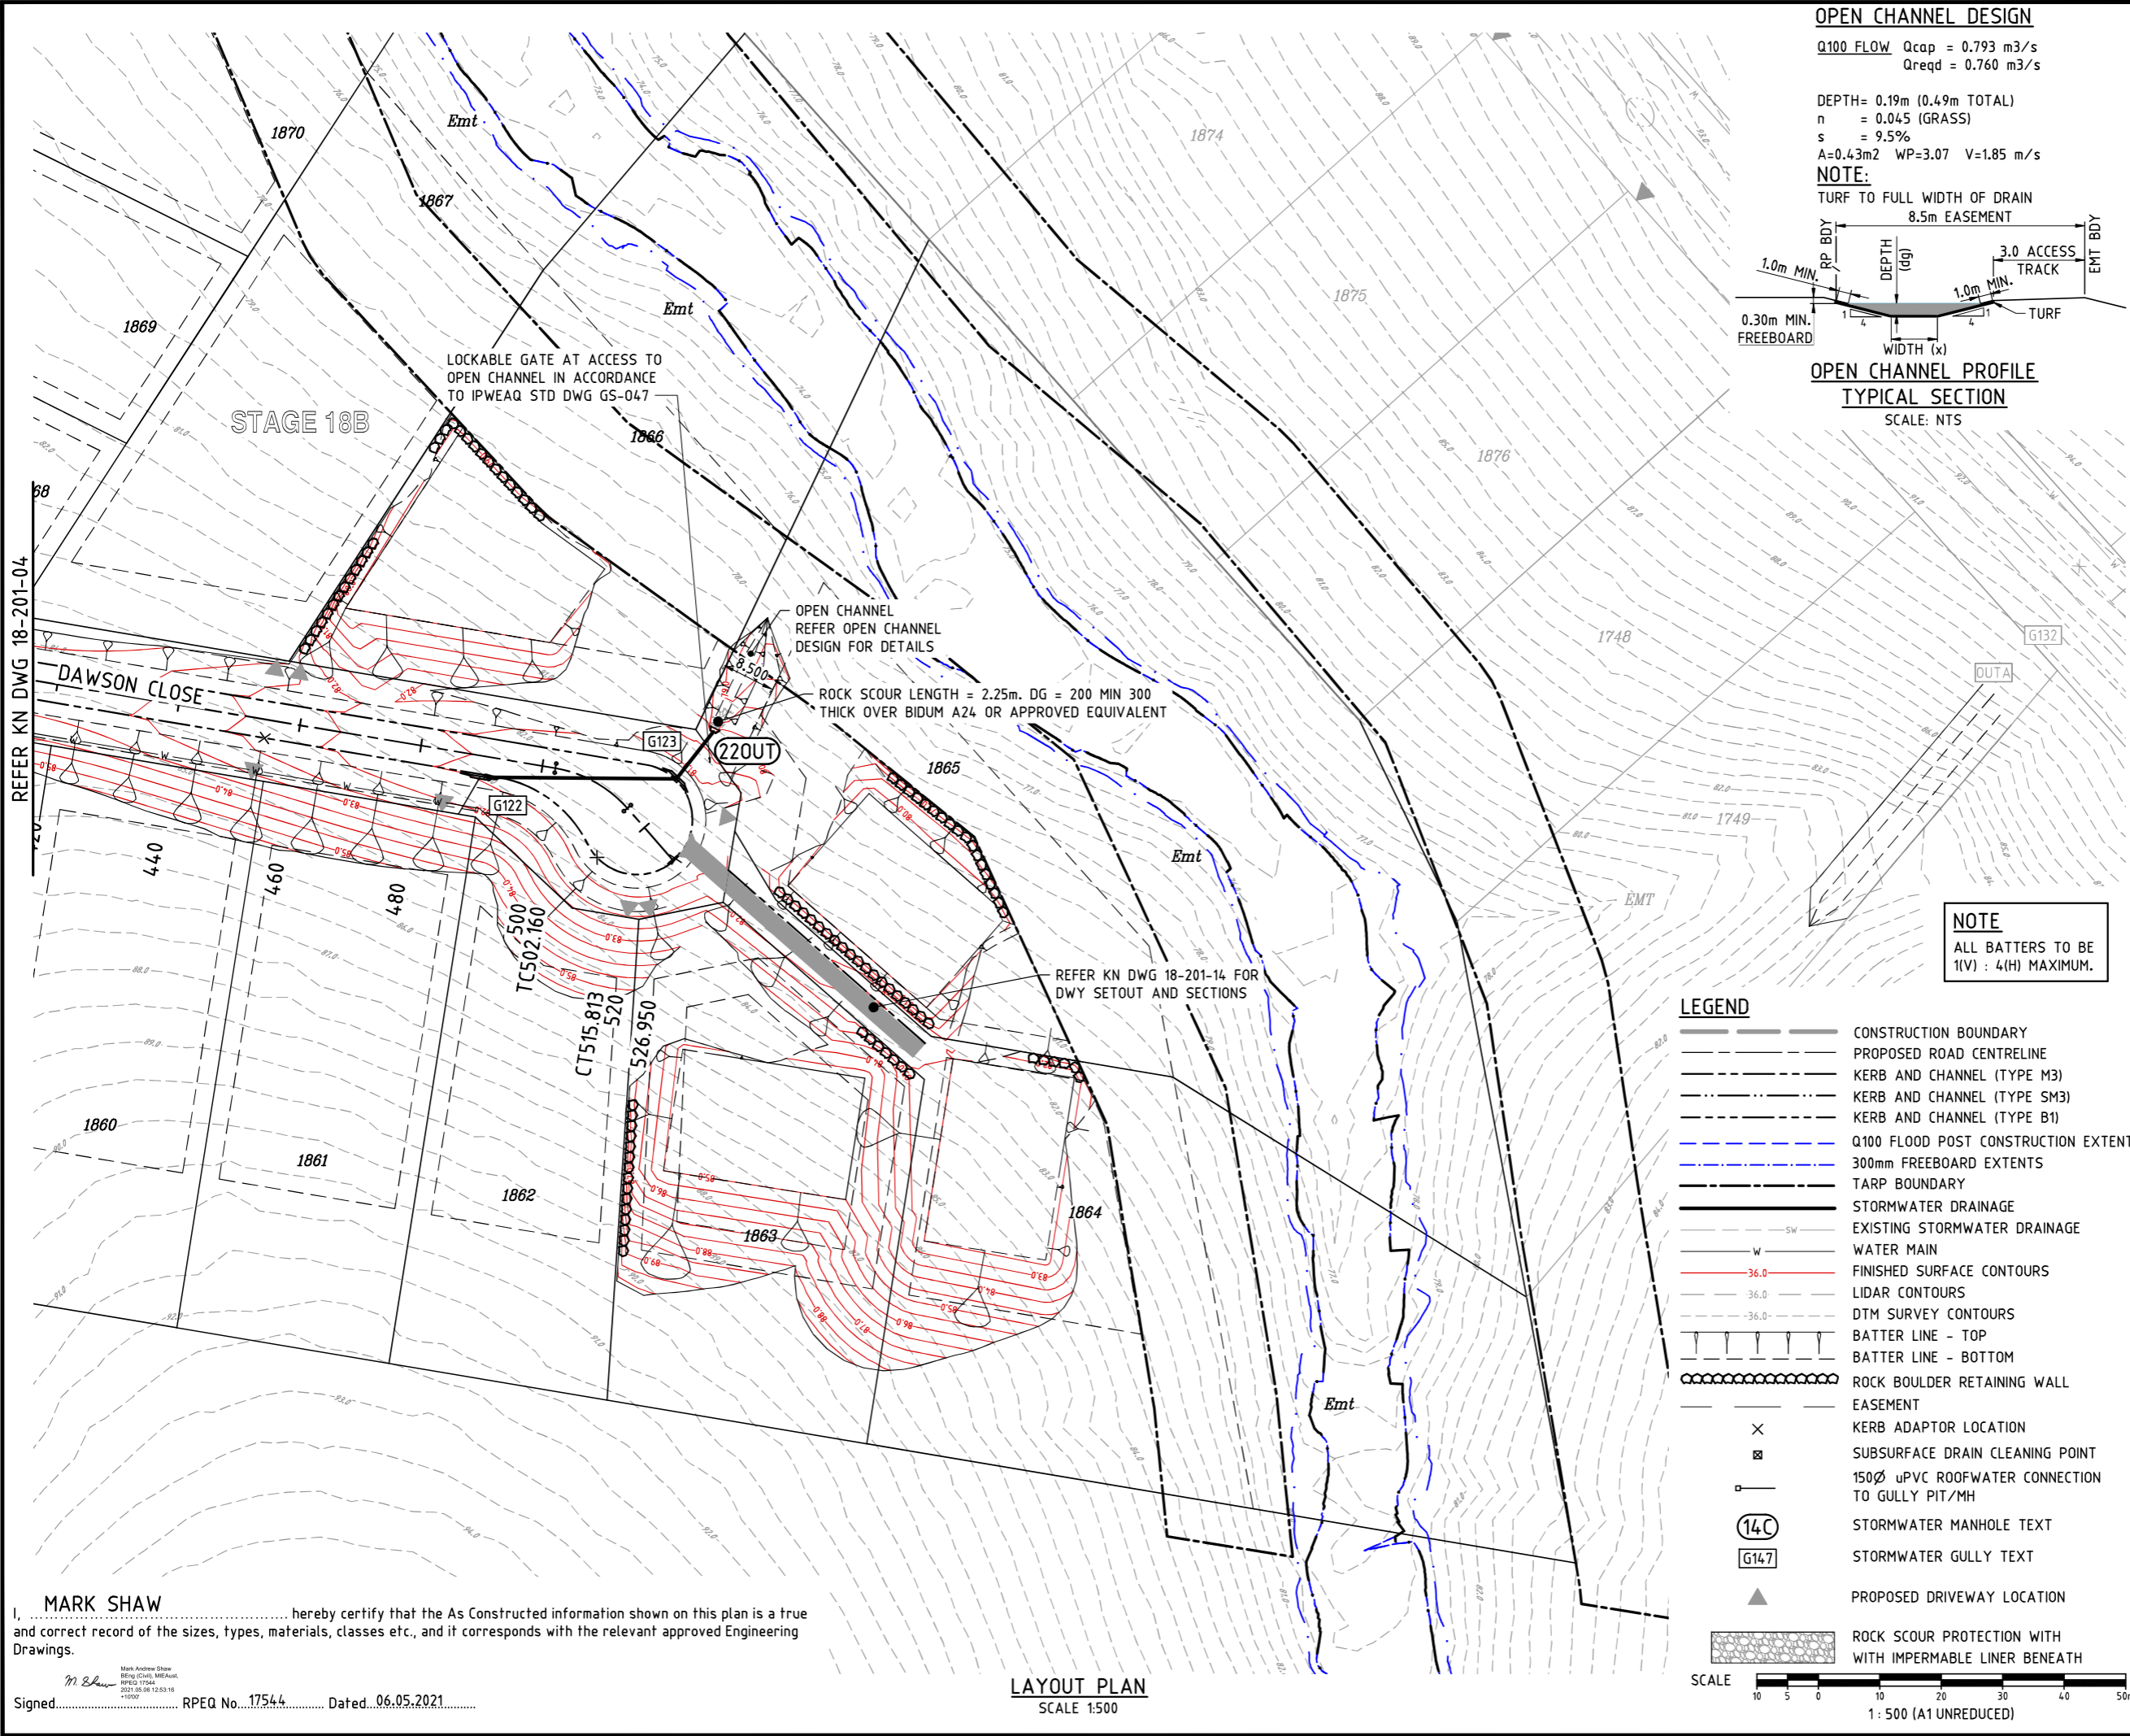


**OPEN CHANNEL DESIGN**

Q100 FLOW  $Q_{cap} = 0.793 \text{ m}^3/\text{s}$   
 $Q_{reqd} = 0.760 \text{ m}^3/\text{s}$

DEPTH = 0.19m (0.49m TOTAL)  
 $n = 0.045$  (GRASS)  
 $s = 9.5\%$   
 $A = 0.43 \text{ m}^2$   $WP = 3.07$   $V = 1.85 \text{ m/s}$

**NOTE:**

TURF TO FULL WIDTH OF DRAIN

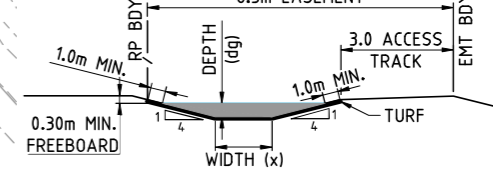


**OPEN CHANNEL PROFILE**  
**TYPICAL SECTION**

SCALE: NTS

DO NOT SCALE THIS DRAWING  
 IF IN DOUBT - ASK!



**LOCALITY PLAN**

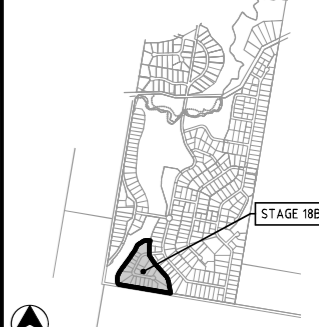

**REVISIONS**

No	Description	Date	By
A	ISSUED FOR APPROVAL	11/06/20	DES
B	REVISED EARTHWORKS	20/08/20	DES
C	AS CONSTRUCTED FINAL	06/05/21	LMS

No	Description	Date	By

Client



Project

**SPRING MOUNTAIN**  
 ACREAGE ESTATE  
 STAGE 18B

OW/106/2020




Approved

Drawing Title  
**GENERAL LAYOUT PLAN**  
**SHEET 3**

Drawn LMS	Designed JB	Checked GG	Date JUN 20
Scale AS SHOWN	Drawing No 18-201-05		Sheet 05 of 33
A1	Revision C		

**LEGEND**

- CONSTRUCTION BOUNDARY
- PROPOSED ROAD CENTRELINE
- KERB AND CHANNEL (TYPE M3)
- KERB AND CHANNEL (TYPE SM3)
- KERB AND CHANNEL (TYPE B1)
- Q100 FLOOD POST CONSTRUCTION EXTENTS
- 300mm FREEBOARD EXTENTS
- TARP BOUNDARY
- STORMWATER DRAINAGE
- EXISTING STORMWATER DRAINAGE
- WATER MAIN
- FINISHED SURFACE CONTOURS
- LIDAR CONTOURS
- DTM SURVEY CONTOURS
- BATTER LINE - TOP
- BATTER LINE - BOTTOM
- ROCK BOULDER RETAINING WALL
- EASEMENT
- KERB ADAPTOR LOCATION
- SUBSURFACE DRAIN CLEANING POINT
- 150Ø uPVC ROOFWATER CONNECTION TO GULLY PIT/MH
- (14) C STORMWATER MANHOLE TEXT
- (G147) STORMWATER GULLY TEXT
- PROPOSED DRIVEWAY LOCATION
- ROCK SCOUR PROTECTION WITH IMPERMEABLE LINER BENEATH

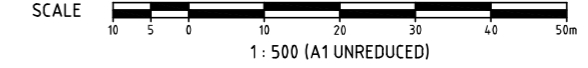

REFER KN DWG 18-201-04

I, **MARK SHAW** hereby certify that the As Constructed information shown on this plan is a true and correct record of the sizes, types, materials, classes etc., and it corresponds with the relevant approved Engineering Drawings.

Signed..... RPEQ No...17544..... Dated...06.05.2021.....

**LAYOUT PLAN**  
 SCALE 1:500

M:\2018\18201 Spring Mountain Stage 18B Engineering\Ascon\18-201-03-05-05-05-LAYOUT.dwg Plotted by: DS on 6/05/2021 12:02:10 PM



**NOTE**  
DTM SURVEY INFORMATION UTILISED FOR ROAD DESIGN WITH LIDAR SOURCED NATURAL SURFACE INFORMATION PROVIDED FOR INFORMATION PURPOSE ONLY.


MARK SHAW hereby certify that the As Constructed information shown on this plan is a true and correct record of the sizes, types, materials, classes etc., and it corresponds with the relevant approved Engineering Drawings.

Mark Andrew Shaw  
18093 (Civil, MEA Aust)  
18093 (17544)  
2017-09-08 12:53:29  
11000  
Signed..... RPEQ No. 17544 Dated... 06.05.2021


**LEGEND**

- CONSTRUCTION BOUNDARY
- PROPOSED ROAD CENTRELINE
- KERB AND CHANNEL (TYPE M3)
- KERB AND CHANNEL (TYPE SM3)
- KERB AND CHANNEL (TYPE B1)
- TARP BOUNDARY
- 37.0 FINISHED SURFACE CONTOURS
- 36.0 NATURAL SURFACE CONTOURS (DTM SURVEY INFORMATION)
- 36.0 NATURAL SURFACE CONTOURS (LIDAR SOURCED)
- ⊖ ROCK BOULDER RETAINING WALL REFER DETAIL ON DWG 18-201-07
- ⊖ BATTER LINE - TOP
- ⊖ BATTER LINE - BOTTOM
- EXTENT OF CUT
- EXTENT OF FILL

**NOTE**  
ALL BATTERS TO BE 1(V) : 4(H) MAXIMUM.

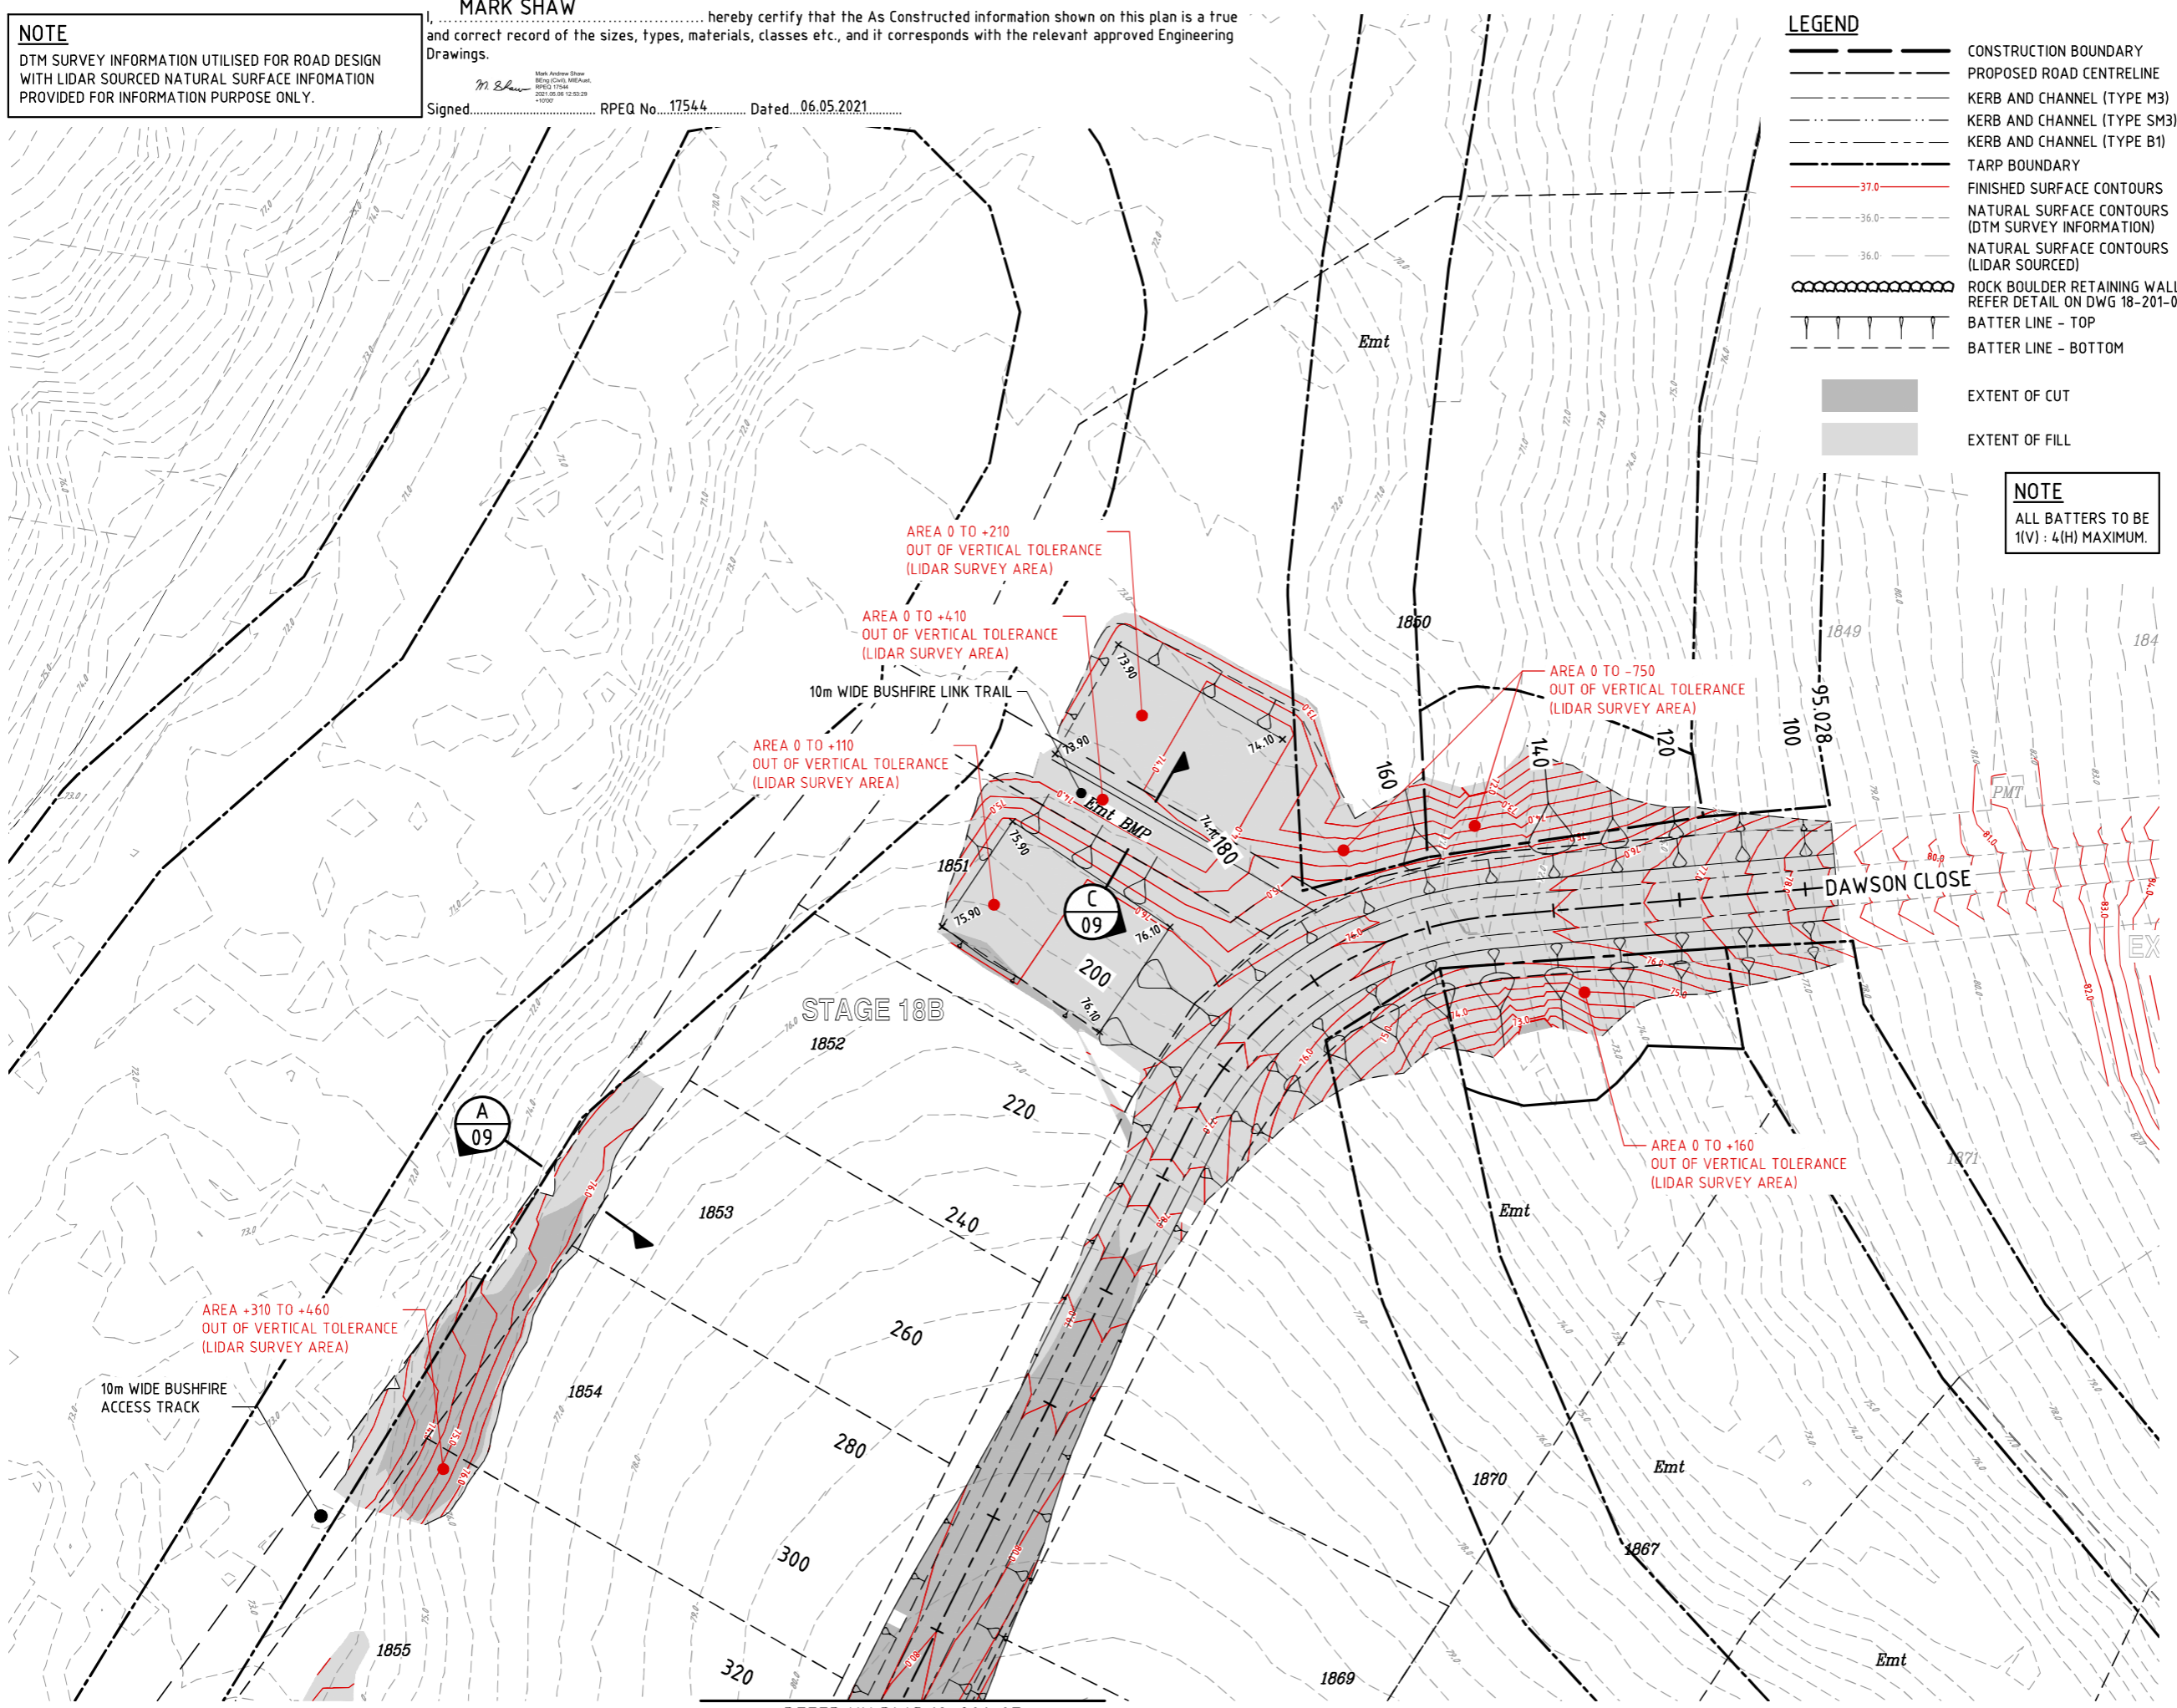

DO NOT SCALE THIS DRAWING IF IN DOUBT - ASK!

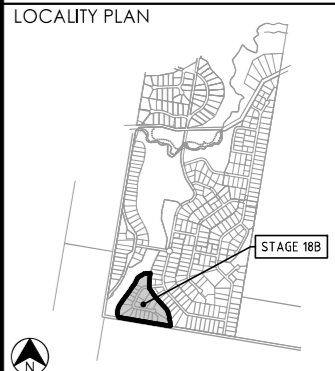

REVISIONS

No	Description	Date	By
A	ISSUED FOR APPROVAL	11/06/20	DES
B	REVISED EARTHWORKS	20/06/20	DES
C	REVISED LOTS / EASEMENT	23/09/20	DES
D	AS CONSTRUCTED WATER AND EWKS	04/03/21	LMS
E	AS CONSTRUCTED FINAL	06/05/21	LMS

Client

# PEET

Project

**SPRING MOUNTAIN**  
ACREAGE ESTATE  
STAGE 18B

OW/106/2020

Approved

ABN 35 112 53 611  
L1, 62 Astor Tee  
Spring Hill Q 4000  
07 3017 1900  
www.kngroup.com.au

Drawing Title

**EARTHWORKS**  
CONTOUR PLAN  
SHEET 1

Drawn LMS	Designed JB	Checked GG	Date JUN 20
Scale AS SHOWN	Sheet 06 of 33		Revision E
A1	Drawing No 18-201-06		

M:\2018\18201 Spring Mountain Stage 18B\Engineering\Ascon\18-201-06-09-EW-CONTOUR.dwg Plotted by DS on 6/05/2021 12:02:39 PM

REFER KN DWG 18-201-07 LAYOUT PLAN SCALE 1:500

SCALE 1:500 (A1 UNREDUCED)



**NOTE**  
DTM SURVEY INFORMATION UTILISED FOR ROAD DESIGN WITH LIDAR SOURCED NATURAL SURFACE INFORMATION PROVIDED FOR INFORMATION PURPOSE ONLY.


**LEGEND**

- CONSTRUCTION BOUNDARY
- PROPOSED ROAD CENTRELINE
- KERB AND CHANNEL (TYPE M3)
- KERB AND CHANNEL (TYPE SM3)
- KERB AND CHANNEL (TYPE B1)
- TARP BOUNDARY
- 37.0 FINISHED SURFACE CONTOURS
- 36.0 NATURAL SURFACE CONTOURS (DTM SURVEY INFORMATION)
- 36.0 NATURAL SURFACE CONTOURS (LIDAR SOURCED)
- ROCK BOULDER RETAINING WALL REFER DETAIL
- BATTER LINE - TOP
- BATTER LINE - BOTTOM
- SWALE



EXTENT OF CUT

EXTENT OF FILL

**NOTE**  
ALL BATTERS TO BE 1(V) : 4(H) MAXIMUM.

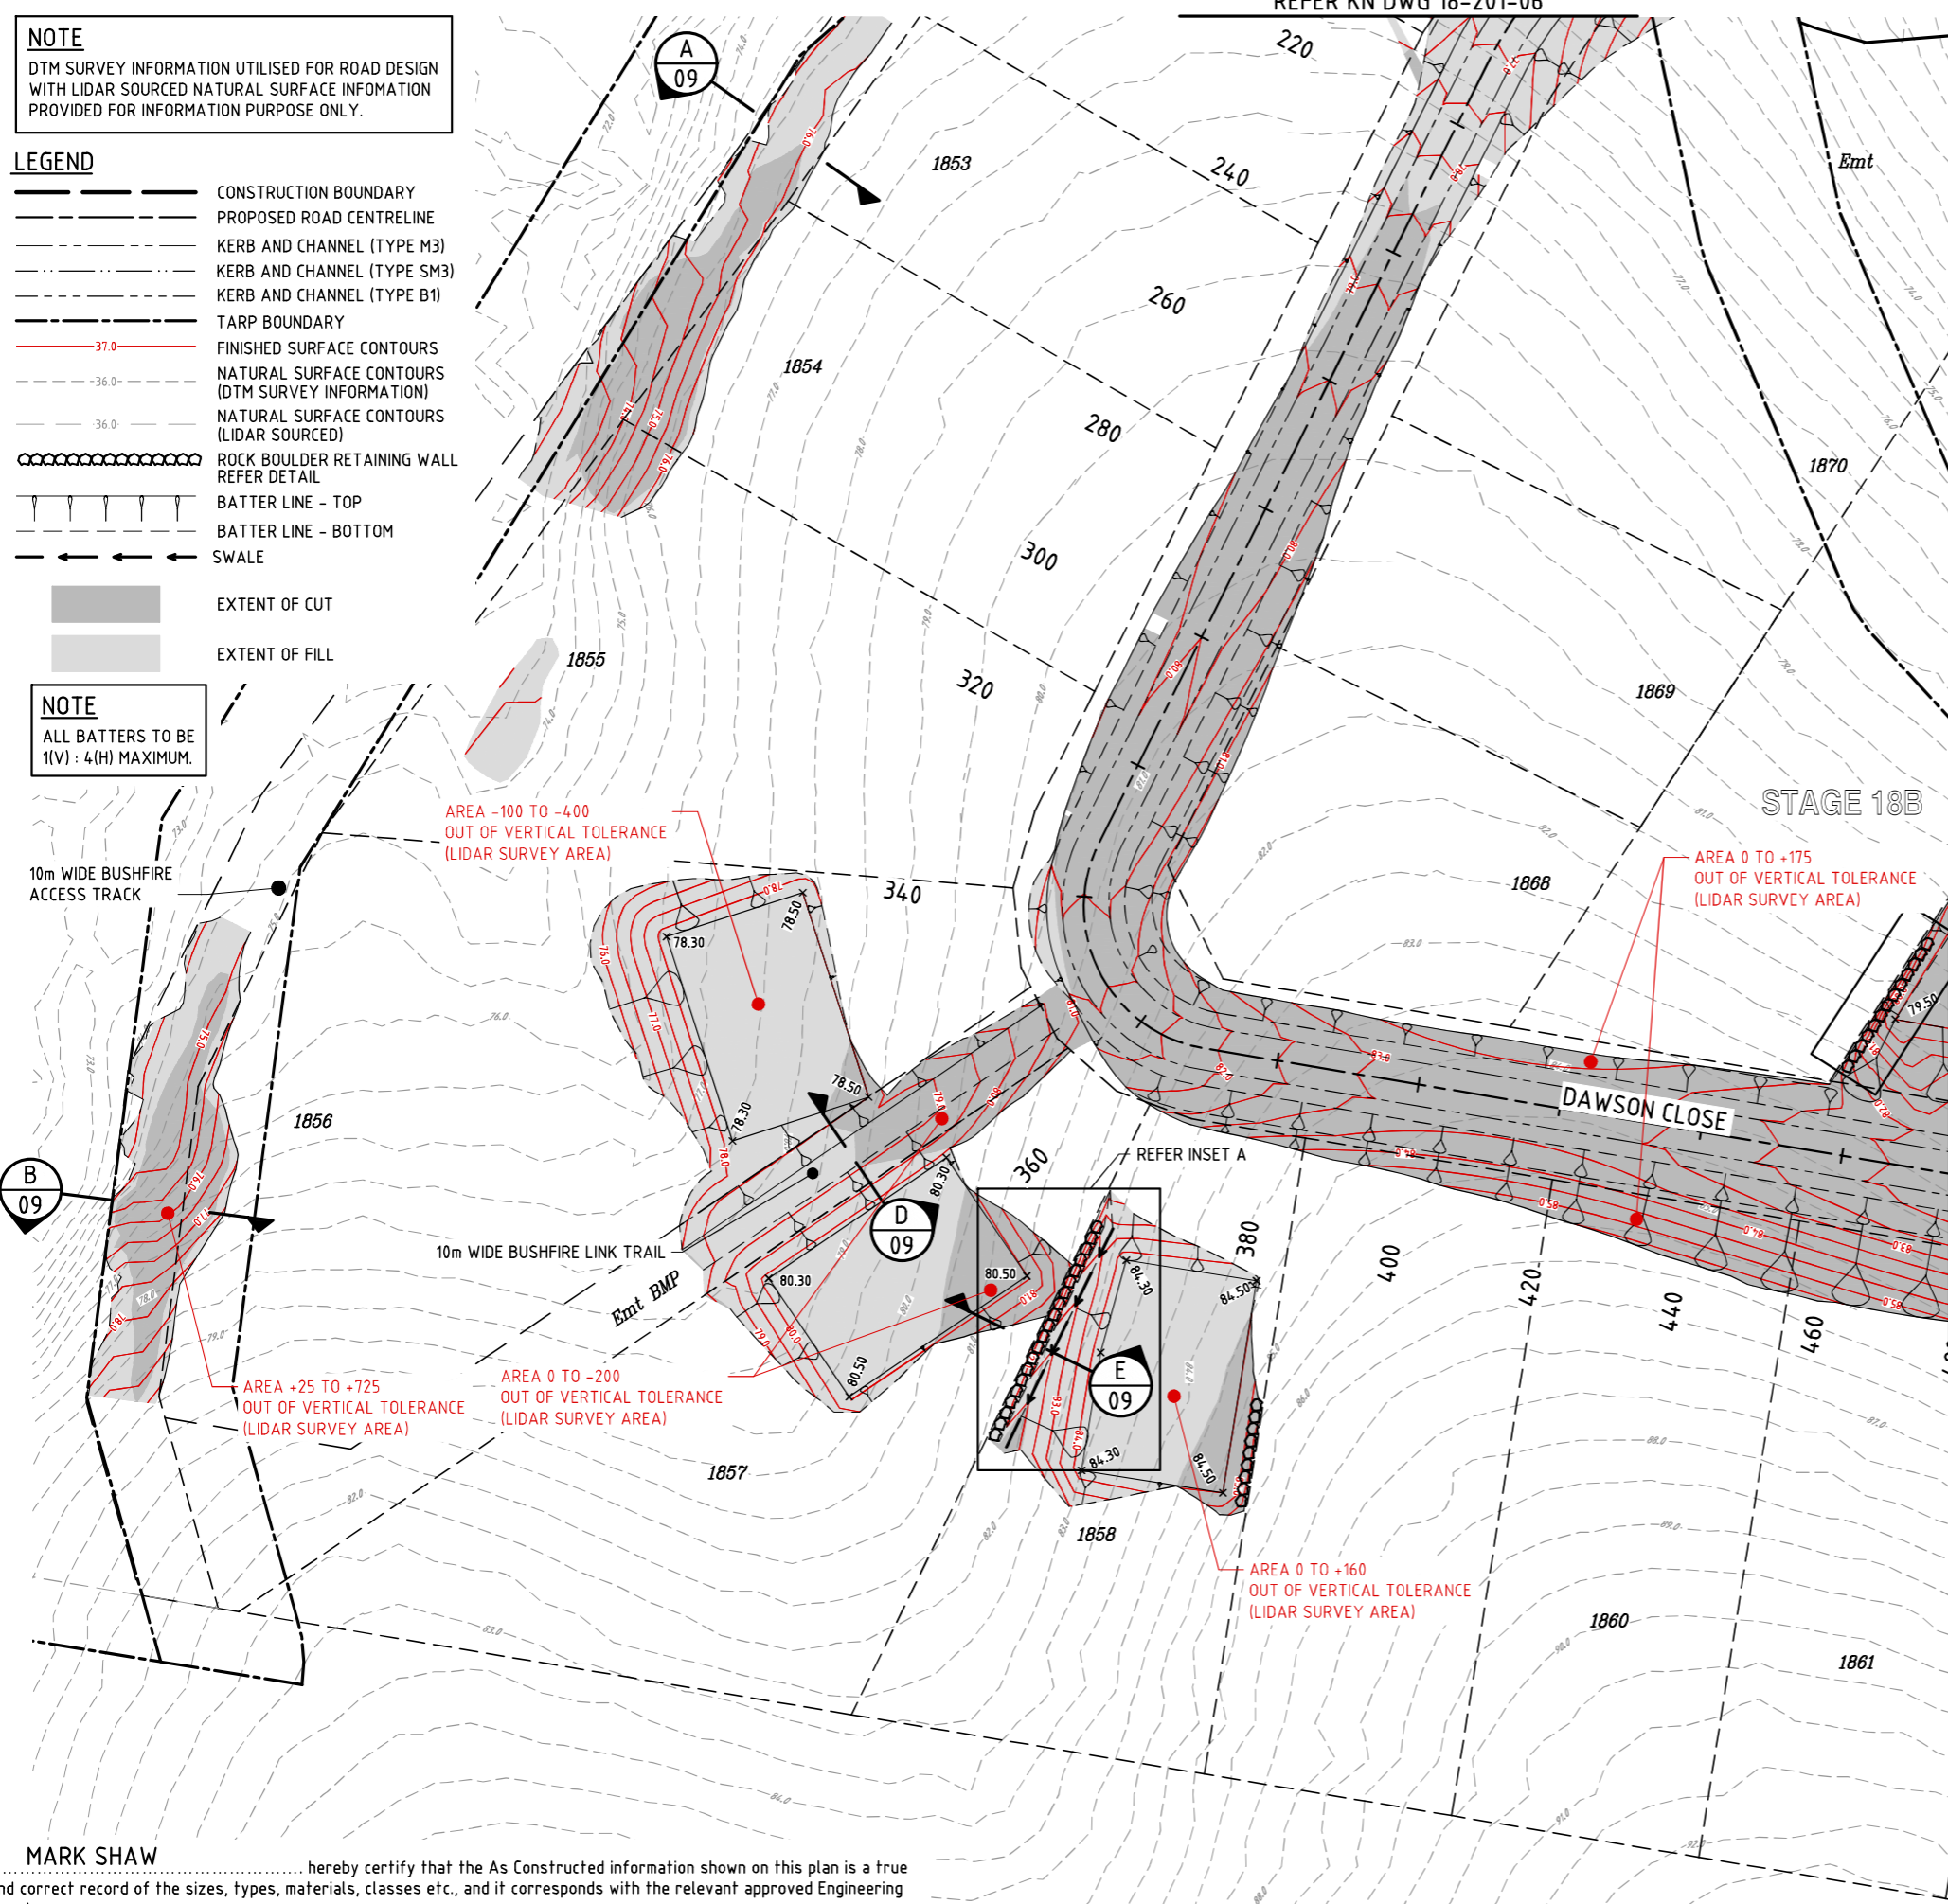


**LAYOUT PLAN**  
SCALE 1:500

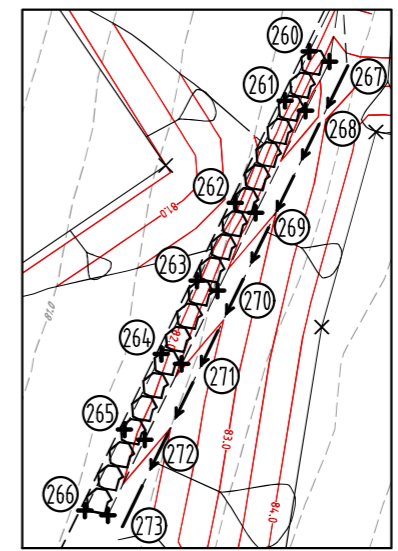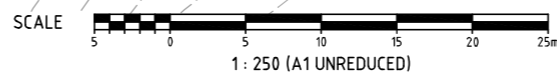

**INSET A**  
SCALE 1:250

**INSET A - SETOUT TABLE**

PT No.	EASTING	NORTHING	LEVEL
260	491734.749	6929502.500	82.193
261	491733.158	6929499.244	82.122
262	491729.862	6929492.500	81.998
263	491727.341	6929487.341	81.887
264	491724.976	6929482.500	81.747
265	491722.532	6929477.500	81.693
266	491719.917	6929472.148	81.590
267	491736.097	6929501.841	83.350
268	491734.506	6929498.585	83.735
269	491731.210	6929491.841	83.261
270	491728.689	6929486.683	82.899
271	491726.323	6929481.841	82.558
272	491723.880	6929476.841	82.207
273	491721.436	6929471.841	81.856

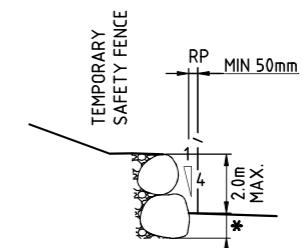


\* TOE OF ROCK BOULDER WALL TO BE FOUNDED 300mm MINIMUM BELOW PREFERRED BENCH LEVEL FOR EACH ALLOTMENT

**TYPICAL ROCK BOULDER RETAINING WALL DETAIL**

**PERFORMANCE REQUIREMENTS FOR RETAINING WALLS**


THE CONTRACTOR IS TO PROVIDE CERTIFICATION, FROM AN APPROVED STRUCTURAL / GEOTECHNICAL ENGINEER FOLLOWING COMPLETION OF THE RETAINING WALL CONSTRUCTION, THAT THE WALLS ARE STRUCTURALLY ADEQUATE FOR ALL RELEVANT LOADING CONDITIONS (INCLUDING LCC REQUIREMENTS & MIN 10 kPa SURCHARGE LOADING).

- AS A MINIMUM THE FOLLOWING CONSTRUCTION STANDARD IS REQUIRED:
- AS1726, AS4678 AND AS1170;
  - 10 kPa SURCHARGE LOADING;
  - MINIMUM 300mm EMBEDMENT OF FIRST COURSE BOULDER (WHERE APPLICABLE);
  - IMPERVIOUS BACKFILL TO EMBEDMENT TRENCH;
  - PROVIDE GEOFABRIC LAYER TO REAR OF BOULDERS (WHERE APPLICABLE) AND FREE DRAINING BACKFILL BEHIND;
  - A MINIMUM 100mm DIAMETER SLOTTED PVC DRAINAGE PIPE FULL LENGTH OF WALL, INSTALLED ABOVE IMPERVIOUS BACKFILL WITH CONNECTION TO DRAINAGE OUTLET;
  - SELECT AND PLACE BOULDERS IN A MANNER TO ENSURE THAT THEY ARE SECURELY INTERLOCKED (WHERE APPLICABLE).

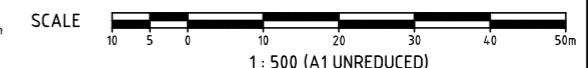

DO NOT SCALE THIS DRAWING IF IN DOUBT - ASK!

**LOCALITY PLAN**

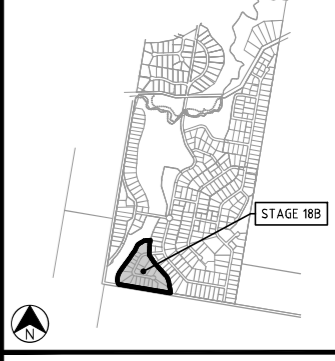

**REVISIONS**

No	Description	Date	By
A	ISSUED FOR APPROVAL	11/06/20	DES
B	REVISED EARTHWORKS	20/06/20	DES
C	REVISED LOTS / EASEMENT	23/09/20	DES
D	AS CONSTRUCTED WATER AND EWKS	04/03/21	LMS
E	AS CONSTRUCTED FINAL	06/05/21	LMS

Client

**PEET**

Project  
**SPRING MOUNTAIN**  
ACREAGE ESTATE  
STAGE 18B

OW/106/2020

**kn group**  
ABN 35 112 53 611  
L1, 62 Astor Tee  
Spring Hill Q 4000  
07 3017 1900  
www.knigroup.com.au

Approved

Drawing Title  
**EARTHWORKS**  
CONTOUR PLAN  
SHEET 2

Drawn	Designed	Checked	Date
LMS	JB	GG	JUN 20
Scale	AS SHOWN		Sheet
A1	Drawing No	18-201-07	07 of 33
	Revision	E	

M:\2018\18201 Spring Mountain Stage 18B\Engineering\Ascon\18-201-06-09-EW-CONTOUR.dwg Plotted by DS on 6/05/2021 12:02:26 PM


**MARK SHAW**  
I, Mark Andrew Shaw, hereby certify that the As Constructed information shown on this plan is a true and correct record of the sizes, types, materials, classes etc., and it corresponds with the relevant approved Engineering Drawings.

Signed: *M Shaw* RPEQ No. 17544 Dated: 06.05.2021



DO NOT SCALE THIS DRAWING  
IF IN DOUBT - ASK!

LOCALITY PLAN

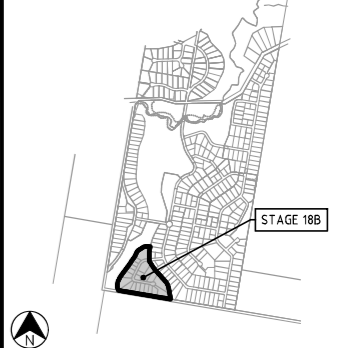

REVISIONS

No	Description	Date	By
A	ISSUED FOR APPROVAL	11/06/20	DES
B	REVISED EARTHWORKS	20/08/20	DES
C	AS CONSTRUCTED WATER AND EWKS	04/03/21	LMS
D	AS CONSTRUCTED FINAL	06/05/21	LMS

Client

**PEET**

Project  
**SPRING MOUNTAIN**  
ACREAGE ESTATE  
STAGE 18B

OW/106/2020

**kn group**  
ABN 35 112 53 611  
L1, 62 Astor Tce  
Spring Hill Q 4000  
07 3017 1900  
www.kngroup.com.au


Approved

Drawing Title  
**EARTHWORKS  
CONTOUR PLAN  
SHEET 3**

Drawn	Designed	Checked	Date
LMS	JB	GG	JUN 20
Scale AS SHOWN			Sheet 08 of 33
Drawing No A1 18-201-08		Revision D	

**INSET B - SETOUT TABLE**


PT No.	EASTING	NORTHING	LEVEL
245	491862.500	6929560.298	78.626
246	491863.885	6929562.430	78.397
247	491864.823	6929561.417	78.437
248	491866.035	6929560.108	78.488
249	491873.084	6929552.500	78.586
250	491878.497	6929546.757	78.925
251	491877.463	6929545.671	79.300
252	491871.983	6929551.481	79.300
253	491864.935	6929559.089	79.300
254	491864.094	6929559.997	79.000
255	491863.758	6929559.481	79.003

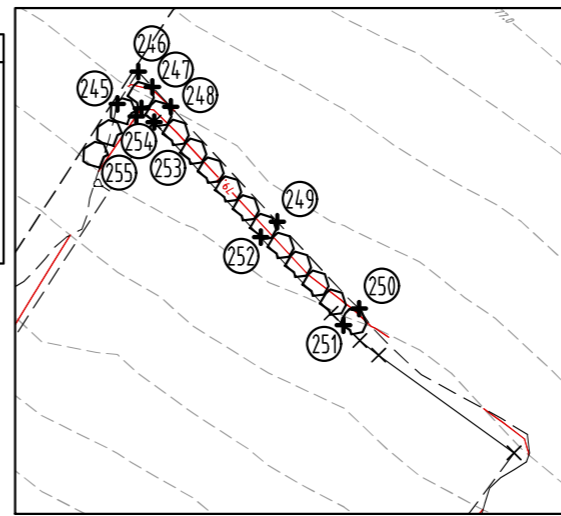

**INSET B**  
SCALE 1:250

**INSET C - SETOUT TABLE**


PT No.	EASTING	NORTHING	LEVEL
229	491935.193	6929504.668	78.231
230	491938.544	6929501.955	78.198
231	49194.1895	69294.99.242	78.377
232	49194.5.247	69294.96.529	78.537
233	49194.8.870	69294.93.596	78.703
234	49195.1.326	69294.88.275	79.227
235	49195.3.636	69294.83.270	79.613
236	49195.4.869	69294.80.600	79.751
237	491934.249	6929503.502	79.358
238	491937.600	6929500.789	79.358
239	49194.0.952	69294.98.076	79.358
240	49194.4.303	69294.95.363	79.358
241	49194.7.655	69294.92.650	79.358
242	49194.9.964	69294.87.646	79.742
243	49195.2.274	69294.82.642	80.300
244	49195.3.507	69294.79.971	80.300

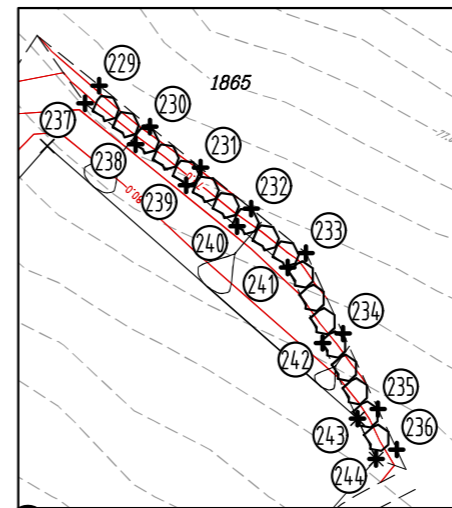

**INSET C**  
SCALE 1:250

**INSET D - SETOUT TABLE**


PT No.	EASTING	NORTHING	LEVEL
213	491931.748	6929461.947	82.290
214	491935.123	6929458.977	82.346
215	491937.837	6929456.589	82.489
216	491939.263	6929455.334	82.624
217	491938.272	6929454.208	83.000
218	491936.846	6929455.463	83.350
219	491934.132	6929457.851	83.650
220	491930.758	6929460.820	83.220

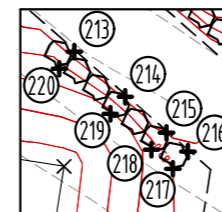

**INSET D**  
SCALE 1:250

**INSET E - SETOUT TABLE**

PT No.	EASTING	NORTHING	LEVEL
349	491962.262	6929457.738	81.216
350	491962.013	6929456.259	82.000
351	491965.703	6929457.160	81.030
352	491964.674	6929455.812	81.978
353	491966.663	6929455.085	81.135
354	491965.301	6929454.456	82.300

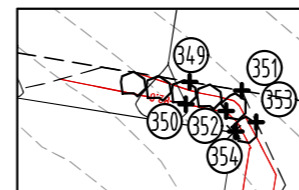


**INSET E**  
SCALE 1:250

**NOTE**  
ALL BATTERS TO BE  
1(V) : 4(H) MAXIMUM.

**MARK SHAW**


I, ..... hereby certify that the As Constructed information shown on this plan is a true and correct record of the sizes, types, materials, classes etc., and it corresponds with the relevant approved Engineering Drawings.

Signed: ..... RPEQ No. 17544 ..... Dated: 06.05.2021

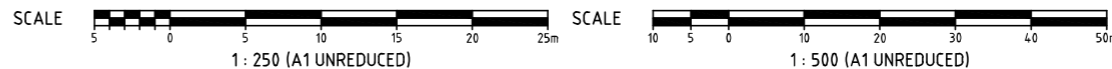

**INSET G - SETOUT TABLE**


PT No.	EASTING	NORTHING	LEVEL
361	491916.771	6929483.653	81.767
362	491917.777	6929484.766	80.795
363	491928.047	6929473.731	81.955
364	491929.038	6929474.857	80.797
365	491939.293	6929463.834	82.142
366	491940.298	6929464.947	80.799
367	491941.314	6929462.055	82.176
368	491943.521	6929461.896	81.660

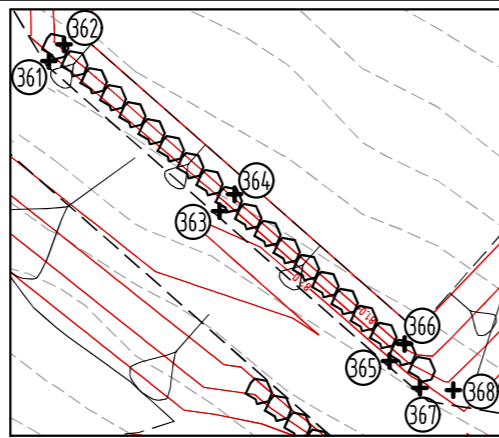


**INSET G**  
SCALE 1:250

**INSET H - SETOUT TABLE**

PT No.	EASTING	NORTHING	LEVEL
355	491839.742	6929525.258	82.601
356	491840.999	6929524.441	81.900
357	491844.311	6929532.293	81.868
358	491845.568	6929531.476	79.800
359	491850.940	6929542.500	80.707
360	491852.198	6929541.683	79.730

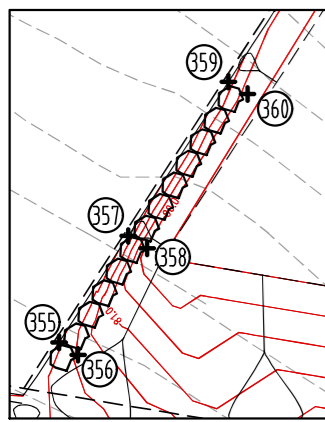

**INSET H**  
SCALE 1:250

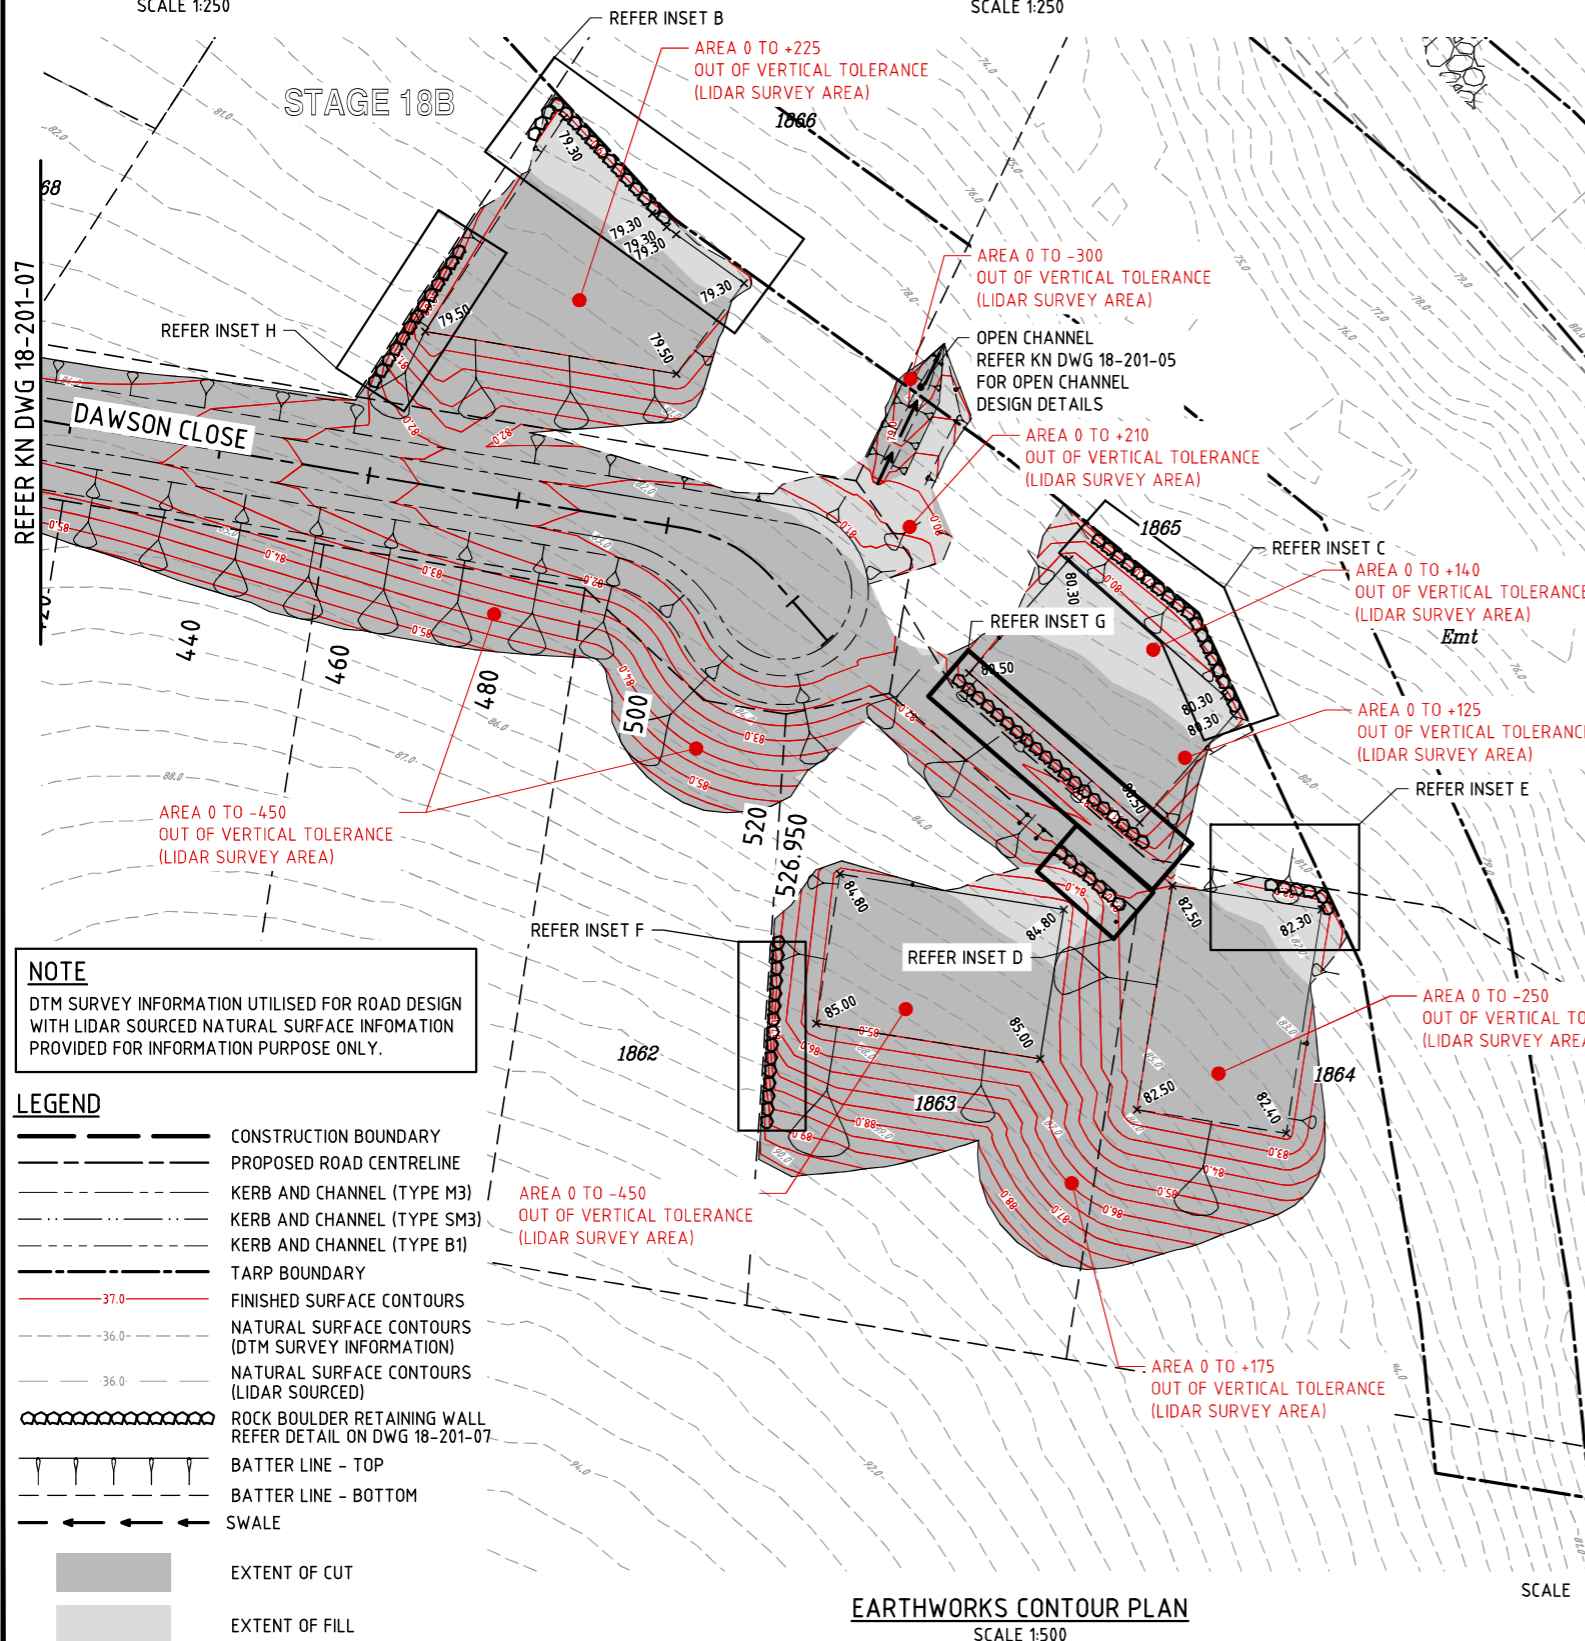

**NOTE**  
DTM SURVEY INFORMATION UTILISED FOR ROAD DESIGN WITH LIDAR SOURCED NATURAL SURFACE INFORMATION PROVIDED FOR INFORMATION PURPOSE ONLY.

**LEGEND**


	CONSTRUCTION BOUNDARY
	PROPOSED ROAD CENTRELINE
	KERB AND CHANNEL (TYPE M3)
	KERB AND CHANNEL (TYPE SM3)
	KERB AND CHANNEL (TYPE B1)
	TARP BOUNDARY
	FINISHED SURFACE CONTOURS
	NATURAL SURFACE CONTOURS (DTM SURVEY INFORMATION)
	NATURAL SURFACE CONTOURS (LIDAR SOURCED)
	ROCK BOULDER RETAINING WALL REFER DETAIL ON DWG 18-201-07
	BATTER LINE - TOP
	BATTER LINE - BOTTOM
	SWALE
	EXTENT OF CUT
	EXTENT OF FILL

M:\2018\18201 Spring Mountain Stage 18B\Engineering\Ascon\18-201-06-09-EW-CONTOUR.dwg Plotted by: DS on 6/05/2021 12:02:49 PM




DO NOT SCALE THIS DRAWING  
IF IN DOUBT - ASK!

LOCALITY PLAN

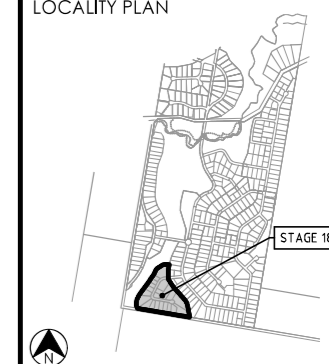

REVISIONS


No	Description	Date	By
A	ISSUED FOR APPROVAL	11/06/20	DES
B	NOTE ADDED	20/08/20	DES
C	REVISED SECTIONS	23/09/20	DES
D	AS CONSTRUCTED WATER AND EWKS	04/03/21	LMS
E	AS CONSTRUCTED FINAL	06/05/21	LMS

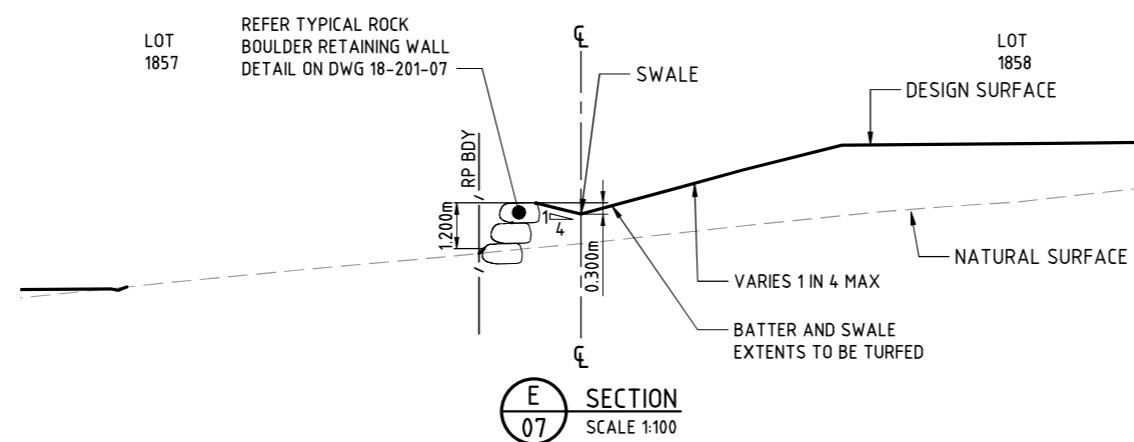


**E** SECTION  
07 SCALE 1:100

I, **MARK SHAW** hereby certify that the As Constructed information shown on this plan is a true and correct record of the sizes, types, materials, classes etc., and it corresponds with the relevant approved Engineering Drawings.


Signed *M. Shaw* Mark Andrew Shaw  
18/09/2021, 12:25:40  
RPEQ No. 17544 Dated 06.05.2021

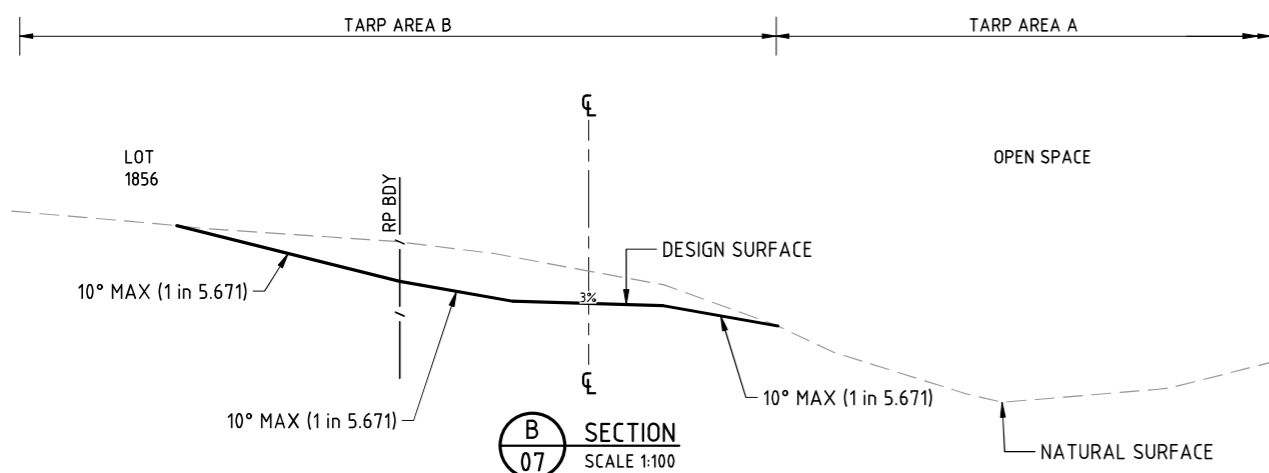


**B** SECTION  
07 SCALE 1:100

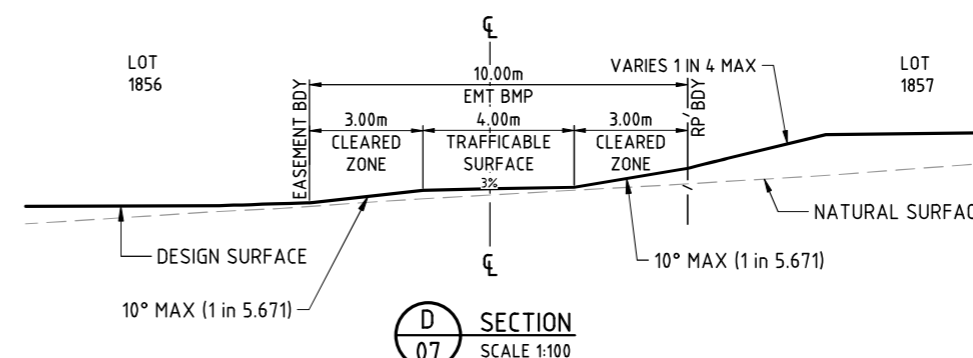


**D** SECTION  
07 SCALE 1:100

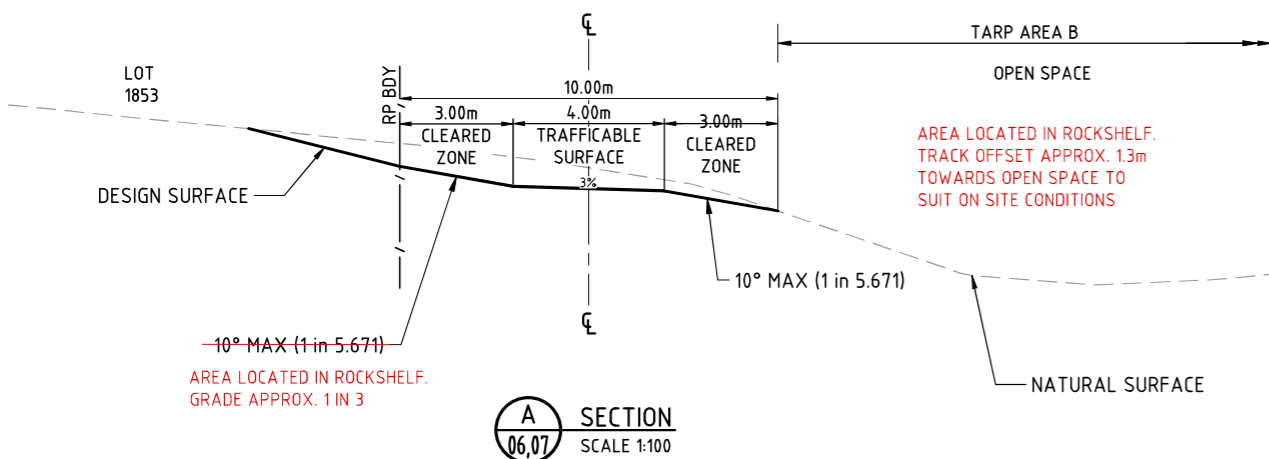

**A** SECTION  
06,07 SCALE 1:100

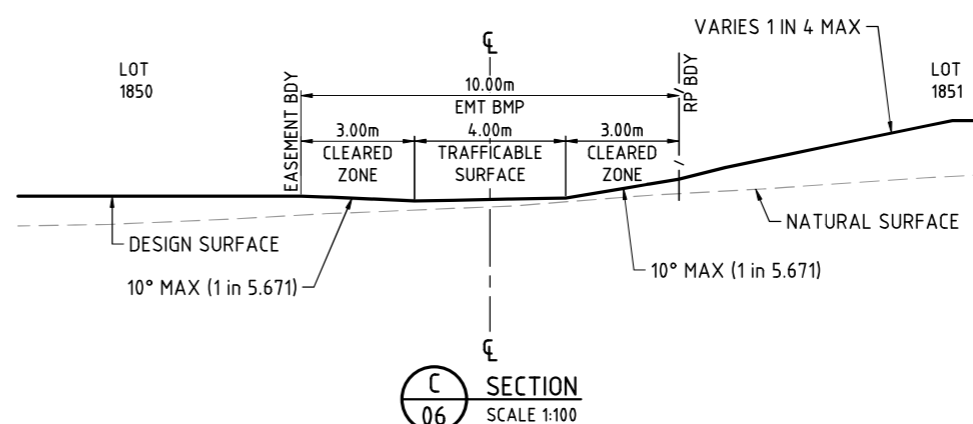

**C** SECTION  
06 SCALE 1:100

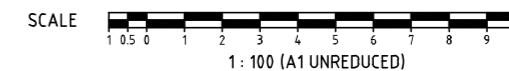

**PEET**

Project  
**SPRING MOUNTAIN**  
ACREAGE ESTATE  
STAGE 18B

OW/106/2020

**kn** group  
ABN 35 112 53 611  
L1, 62 Astor Tce  
Spring Hill Q 4000  
07 3017 1900  
www.knigroup.com.au

Approved  
Drawing Title  
**EARTHWORKS**  
**BUSHFIRE ACCESS TRAIL**  
**TYPICAL SECTIONS**


Drawn LMS	Designed JB	Checked GG	Date JUN 20
Scale AS SHOWN	Drawing No 18-201-09		Sheet 09 of 33
Revision No A1		Revision E	

DO NOT SCALE THIS DRAWING  
IF IN DOUBT - ASK!

**NOMINAL PAVEMENT DETAILS**  
ACCESS ROAD


30mm ASPHALTIC CONCRETE  
7mm PRIMER SEAL AMC 6 BINDER  
100mm BASE COURSE (TYPE 2.1, CBR 80)  
100mm SUB-BASE COURSE (TYPE 2.3, CBR 45)  
SUBGRADE REPLACEMENT AS REQUIRED (TYPE 2.5, CBR 15)  
DESIGN ESA = 1.0x10<sup>5</sup>

LOCALITY PLAN

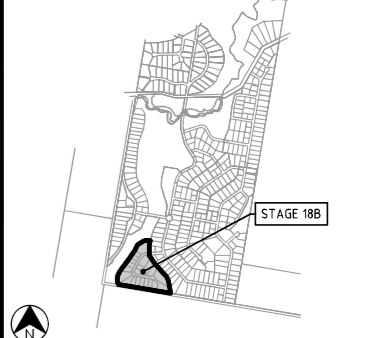


REVISIONS

No	Description	Date	By
A	ISSUED FOR APPROVAL	11/06/20	DES
B	REVISED LONGSECTION	20/06/20	DES
C	AS CONSTRUCTED FINAL	06/05/21	LMS

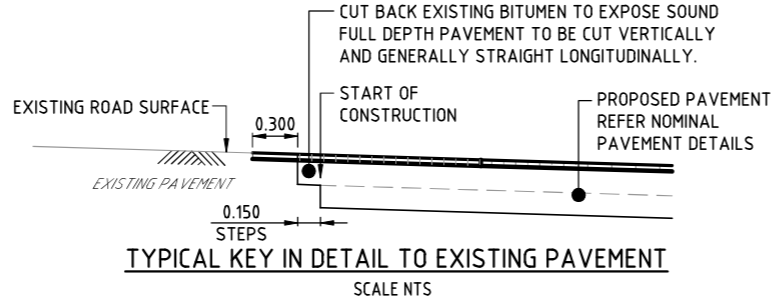

**MARK SHAW**  
I, **MARK SHAW** hereby certify that the As Constructed information shown on this plan is a true and correct record of the sizes, types, materials, classes etc., and it corresponds with the relevant approved Engineering Drawings.

Signed: *M. Shaw*  
RPEQ No. 17544 Dated 06.05.2021

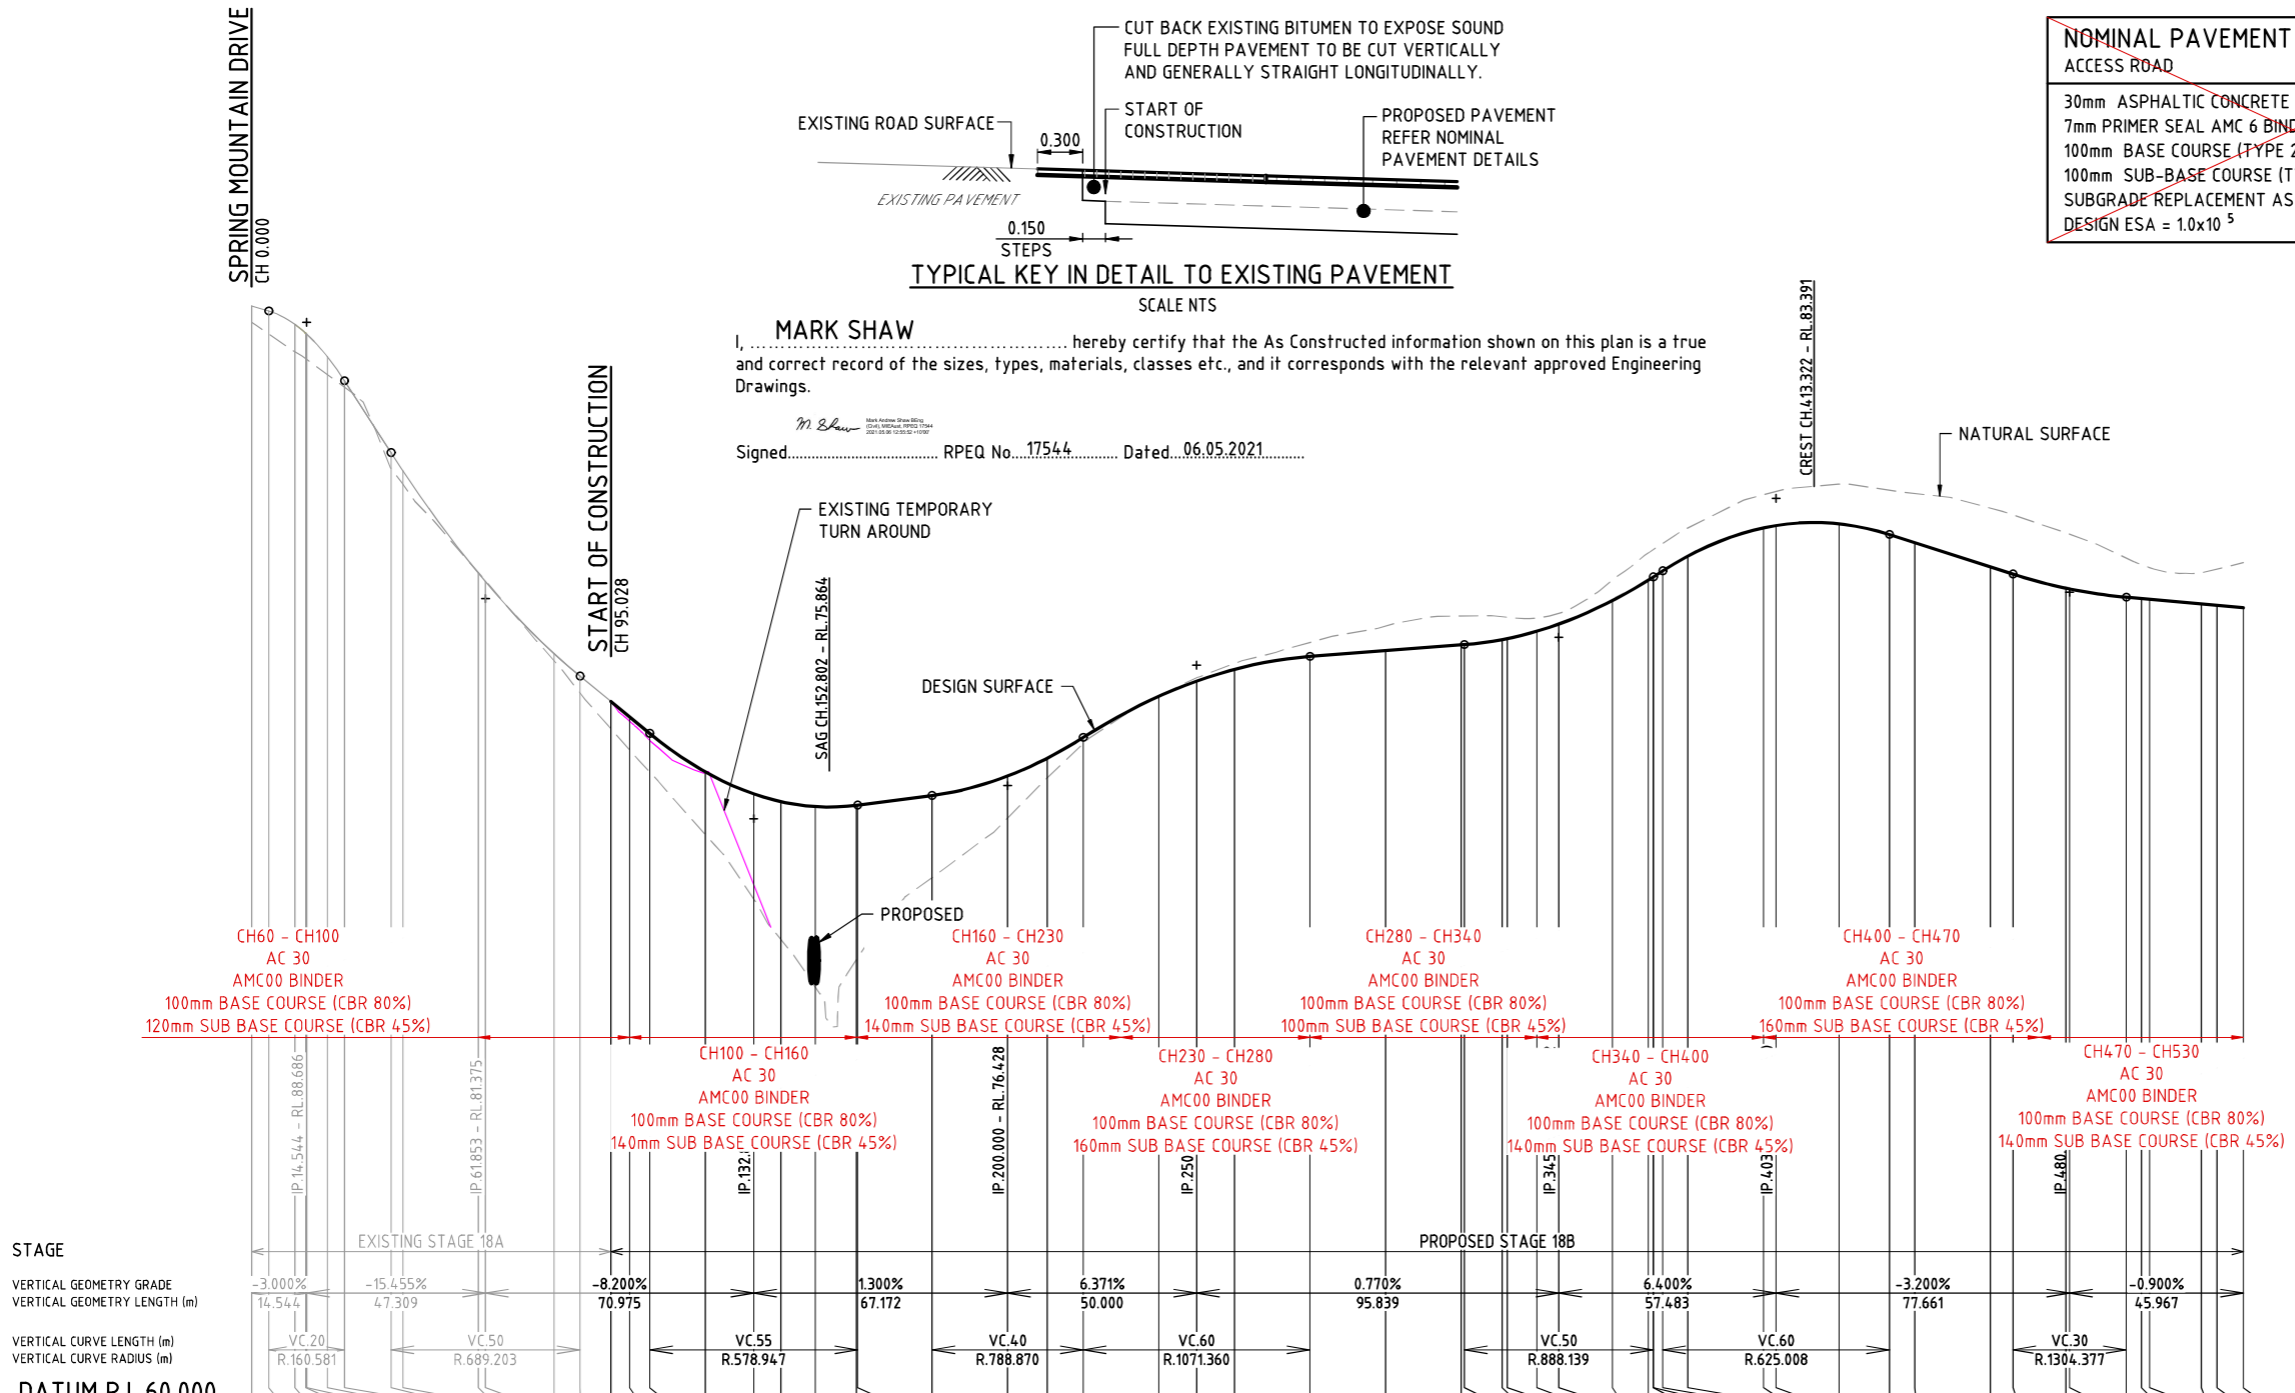

VOLUMES	CUT	STAGE																																																											
		0	7	2	5	0	0	0	0	0	0	3	21	58	152	244	140	22	162	271	339	472	650	671	403	0																																			
FILL	16	38	34	17	175	504	1214	1920	1369	660	202	19	1	0	0	0	2	0	0	0	0	0	0	0	0	0																																			
LIP OF KERB RHS																																																													
LIP OF KERB LHS																																																													
NATURAL SURFACE	88.689	88.376	87.904	87.711	87.059	85.157	84.678	81.968	81.747	79.839	78.573	78.165	77.728	76.711	73.431	72.358	71.100	71.821	71.871	73.994	75.568	76.600	77.072	77.620	78.708	79.112	79.422	79.656	80.218	80.653	80.917	80.918	80.900	80.886	80.859	80.984	81.242	81.786	81.870	82.673	82.834	83.247	84.124	84.211	83.228	83.273	83.273	84.407	84.245	82.989	82.775	82.135	81.943	81.570	81.550	82.450	82.277	82.197	82.061	82.157	82.333
CUT/FILL DEPTH	0.433	0.611	0.728	0.664	0.169	0.420	0.351	-0.014	-0.020	0.187	0.441	0.722	0.876	1.023	1.658	2.777	4.776	4.087	4.041	2.174	1.114	0.521	0.164	-0.022	-0.084	-0.152	-0.373	-0.654	-0.764	-0.759	-0.608	-0.566	-0.345	-0.281	-0.542	-0.718	-0.721	-0.724	-0.745	-0.876	-0.901	-1.052	-1.174	-1.302	-1.554	-1.566	-1.466	-1.450	-1.039	-0.903	-0.842	-0.829	-0.963	-1.201							
DESIGN SURFACE	89.123	88.986	88.632	88.375	87.141	85.239	84.759	82.050	81.828	79.921	78.655	78.370	77.932	76.915	73.634	72.561	71.303	72.024	72.074	73.994	75.568	76.600	77.072	77.620	78.708	79.112	79.422	79.656	80.218	80.653	80.917	80.918	80.900	80.886	80.859	80.984	81.242	81.786	81.870	82.673	82.834	83.247	84.124	84.211	83.228	83.273	83.273	84.407	84.245	82.989	82.775	82.135	81.943	81.570	81.550	82.450	82.277	82.197	82.061	82.157	82.333
PEGGED CHAINAGE	0.000	4.544	11.430	14.266	20.000	24.544	36.853	40.000	60.000	61.853	80.000	80.000	86.853	95.028	100.000	108.247	117.796	120.000	132.828	140.000	149.103	160.000	160.328	180.000	200.000	210.482	220.000	240.000	250.000	260.000	300.000	320.000	320.839	330.814	332.188	340.000	345.839	360.000	369.519	370.839	373.322	380.000	400.000	403.322	420.000	433.322	440.000	460.000	465.983	480.000	480.983	495.983	500.000	502.160	515.813	520.000	526.950				



**LONGITUDINAL SECTION - DAWSON CLOSE**  
SCALE - 1:1000 (H)  
1:100 (V)

**SPRING MOUNTAIN**  
ACREAGE ESTATE  
STAGE 18B

OW/106/2020

Approved

Drawing Title  
**ROADWORKS**  
LONGITUDINAL SECTION  
DAWSON CLOSE


Drawn LMS	Designed JB	Checked GG	Date JUN 20
Scale AS SHOWN	Drawing No 18-201-10		Sheet 10 of 33
A1		Revision C	

K:\2018\2020 Spring Mountain Stage 18B\Engineering\Ascon\18-201-10-18B-LONG-CROSS.dwg Plotted by: DS on 6/05/2021 10:33:00 PM

M:\2018\18201 Spring Mountain Stage 18B-201-10-13-RD-ONG-CROSS.dwg Plotted by: DS on 6/05/2021 12:03:02 PM

**MARK SHAW**  
 I, ..... hereby certify that the As Constructed information shown on this plan is a true and correct record of the sizes, types, materials, classes etc., and it corresponds with the relevant approved Engineering Drawings.  
 Signed..... *M. Shaw* RPEQ No. 17544 Dated 06.05.2021

DO NOT SCALE THIS DRAWING  
 IF IN DOUBT - ASK!

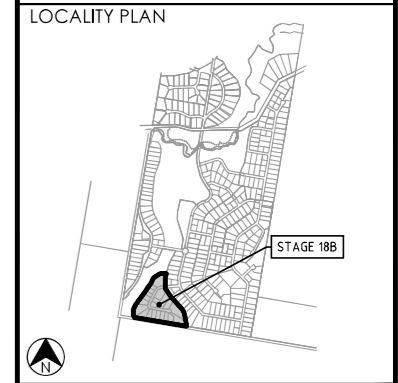

REVISIONS

No	Description	Date	By
A	ISSUED FOR APPROVAL	11/06/20	DES
B	REVISED CROSS SECTIONS	20/08/20	DES
C	AS CONSTRUCTED FINAL	06/05/21	LMS




Project  
**SPRING MOUNTAIN**  
 ACREAGE ESTATE  
 STAGE 18B  
 OW/106/2020



Approved

Drawing Title  
**ROADWORKS**  
**CROSS SECTIONS**  
**DAWSON CLOSE - SHEET 1**

Drawn LMS	Designed JB	Checked GG	Date JUN 20
Scale AS SHOWN	Drawing No 18-201-11		Sheet 11 of 33
A1	Revision C		

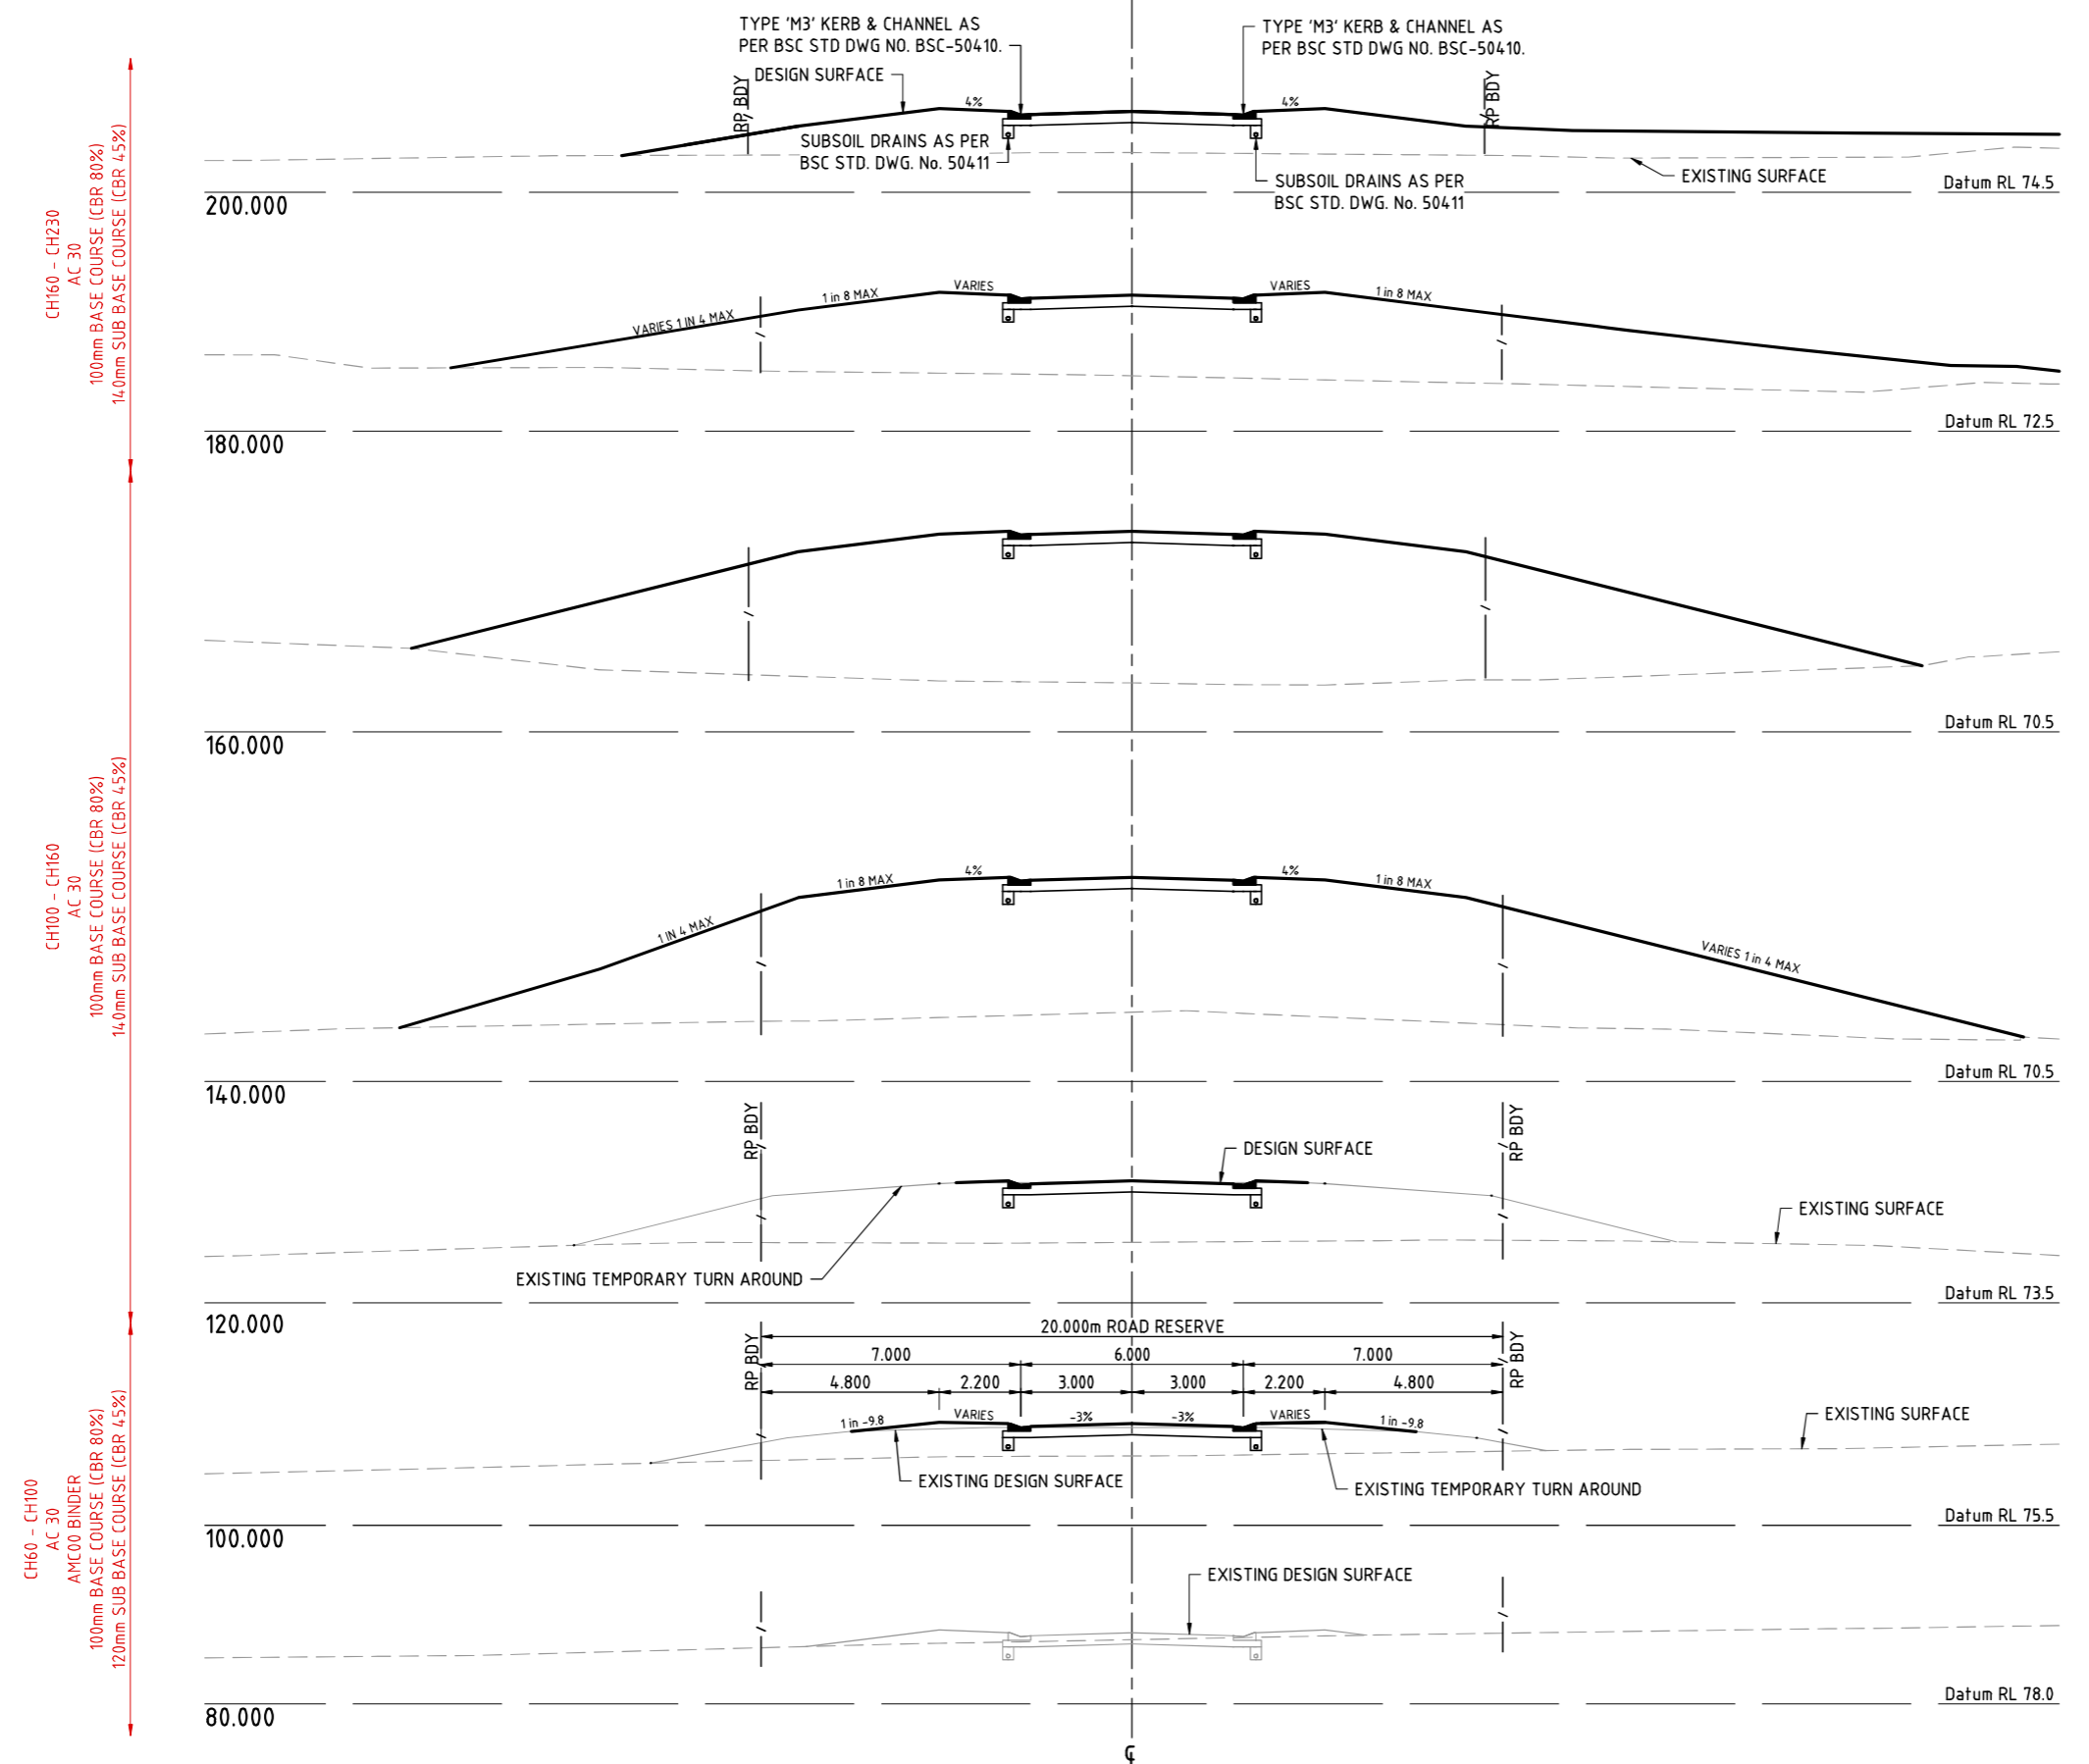

**CROSS SECTIONS - DAWSON CLOSE**  
 SCALE 1:100





M:\2018\18201 Spring Mountain Stage 18B-18-01-10-13-RD-LONG-CROSS.dwg Plotted by: DS on 6/05/2021 10:29:03 PM


**MARK SHAW**  
 I, ..... hereby certify that the As Constructed information shown on this plan is a true and correct record of the sizes, types, materials, classes etc., and it corresponds with the relevant approved Engineering Drawings.  
 Signed: ..... RPEQ No. 17544 ..... Dated: 06.05.2021 .....

CH340 - CH400  
 AC 30  
 100mm BASE COURSE (CBR 80%)  
 140mm SUB BASE COURSE (CBR 4.5%)


CH280 - CH340  
 AC 30  
 100mm BASE COURSE (CBR 80%)  
 100mm SUB BASE COURSE (CBR 4.5%)

CH230 - CH280  
 AC 30  
 100mm BASE COURSE (CBR 80%)  
 160mm SUB BASE COURSE (CBR 4.5%)


CH160 - CH230  
 AC 30  
 100mm BASE COURSE (CBR 80%)  
 140mm SUB BASE COURSE (CBR 4.5%)

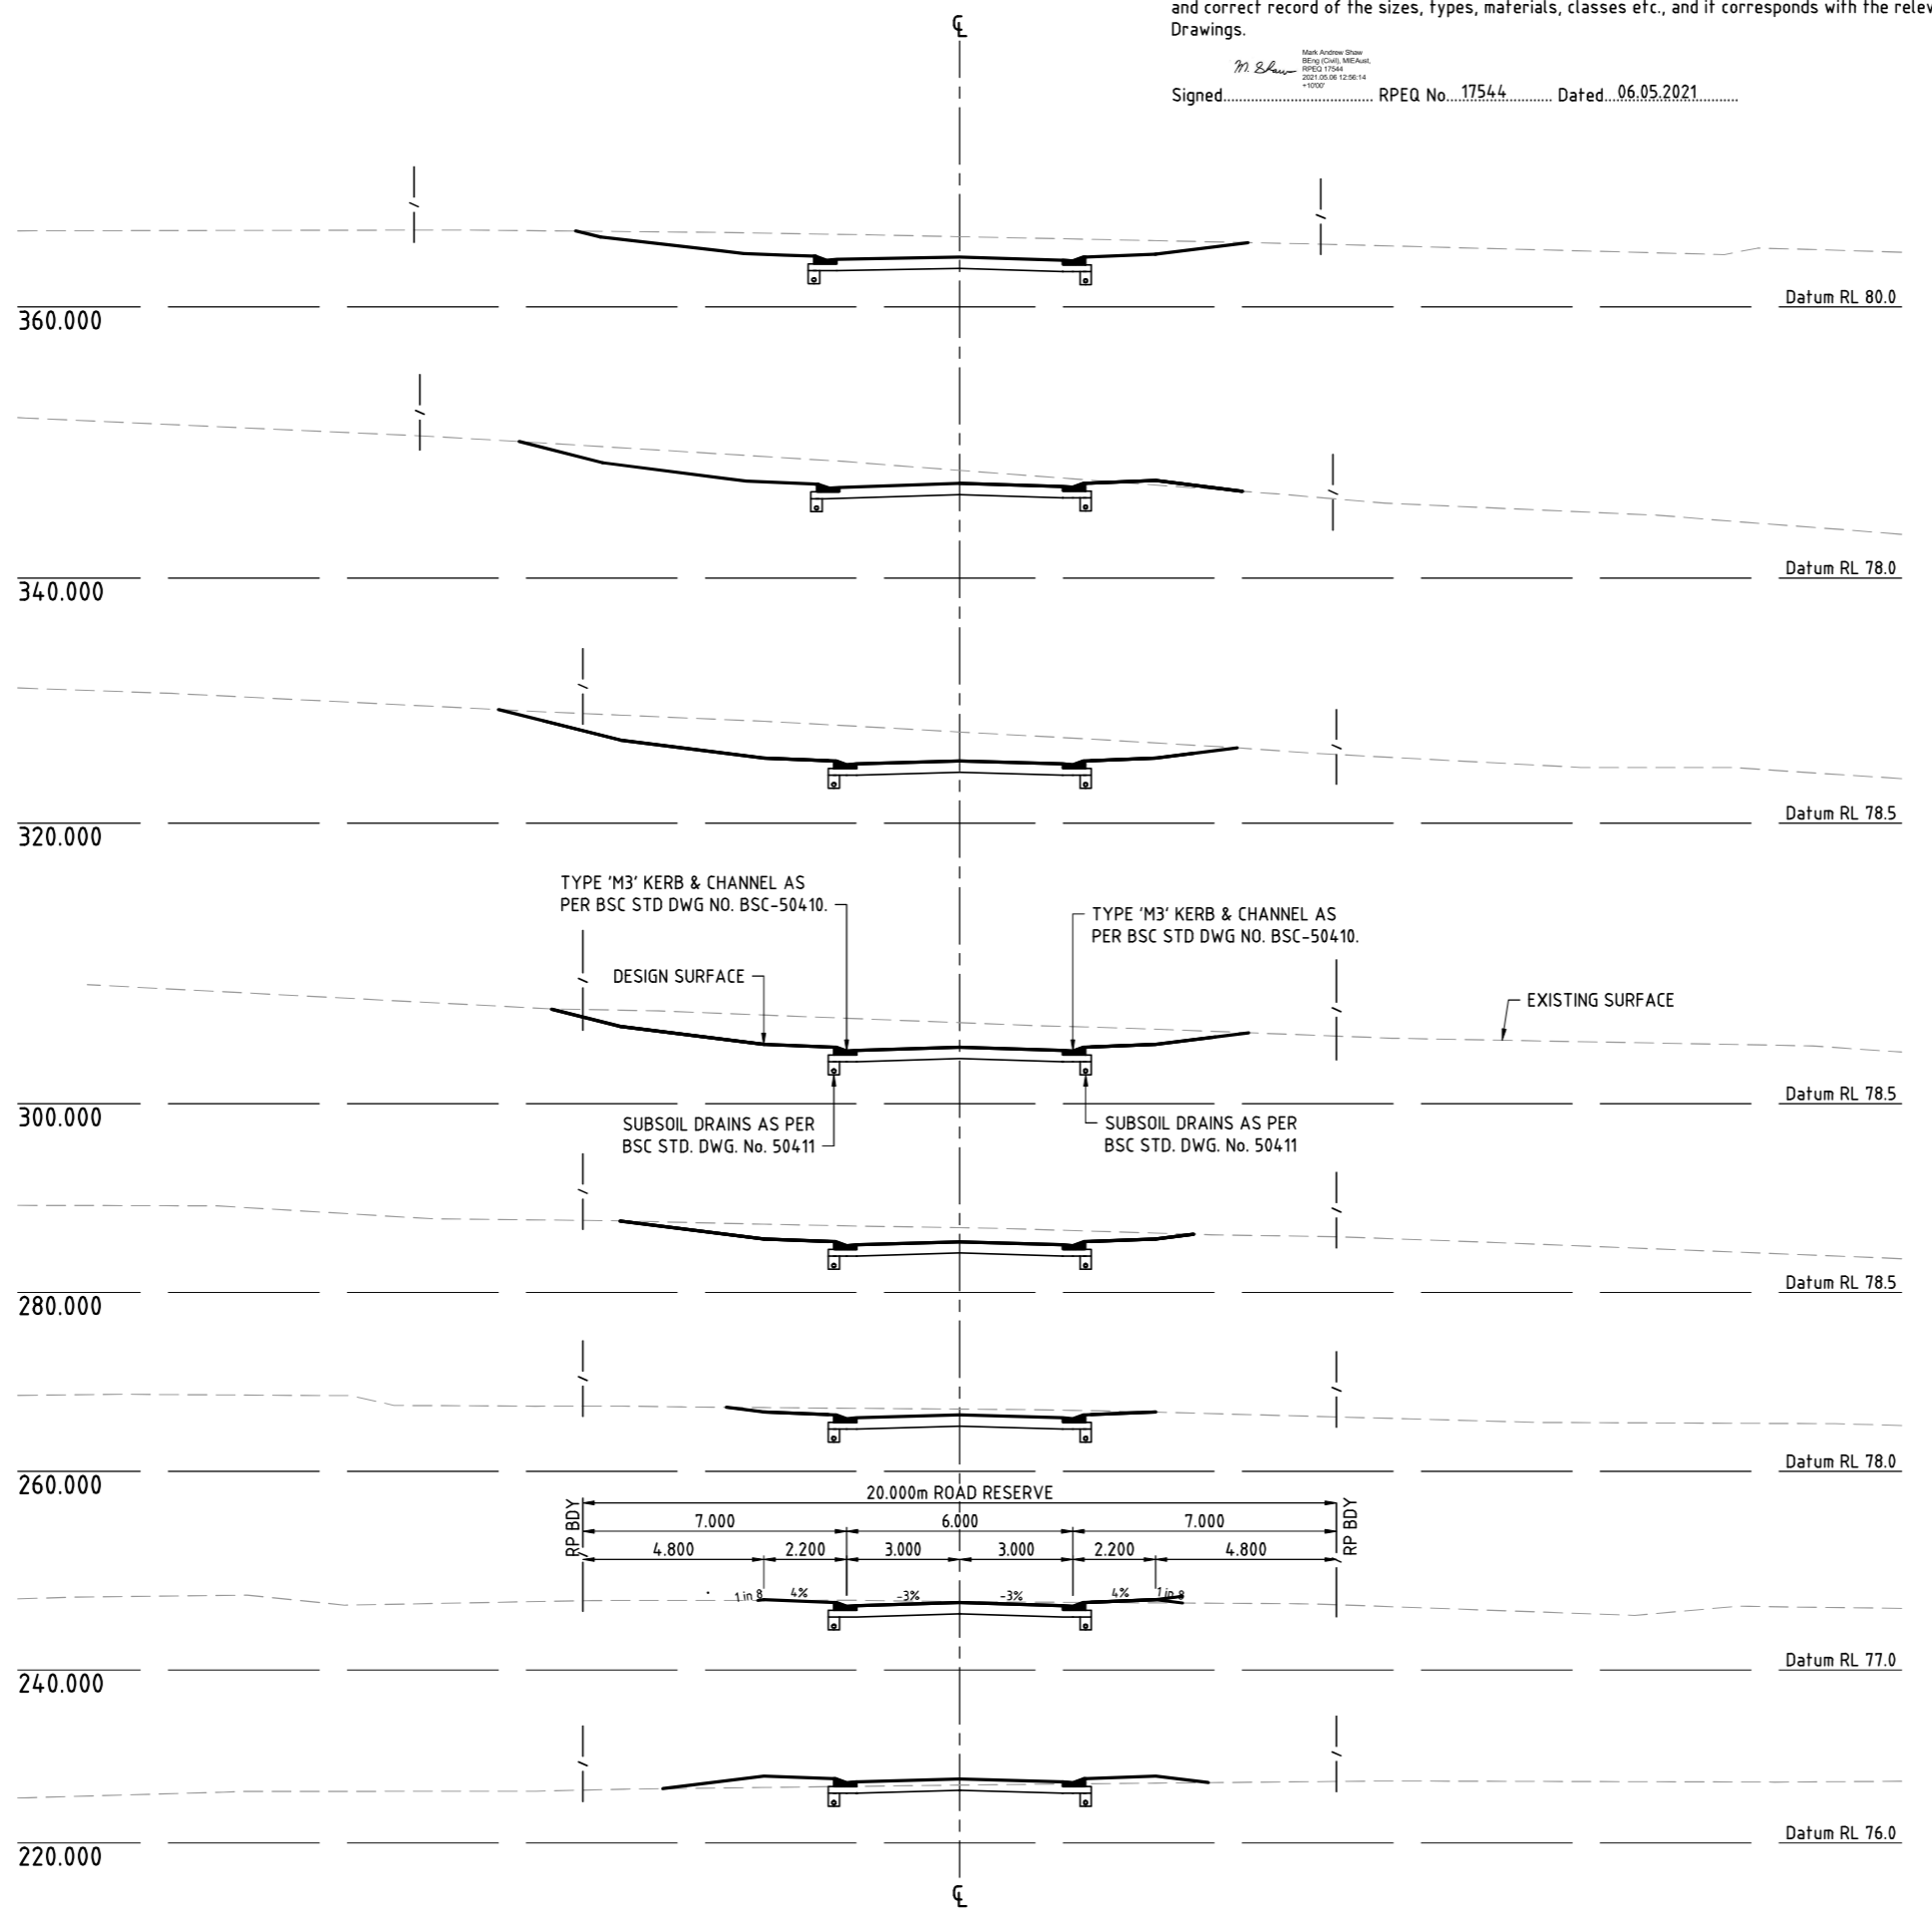

**CROSS SECTIONS - DAWSON CLOSE**  
 SCALE 1:100

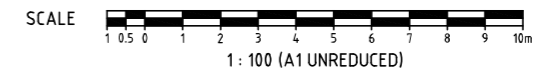

DO NOT SCALE THIS DRAWING  
 IF IN DOUBT - ASK!

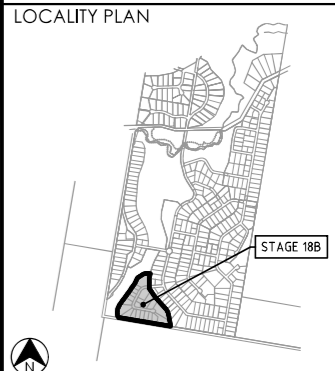

REVISIONS

No	Description	Date	By
A	ISSUED FOR APPROVAL	11/06/20	DES
B	REVISED CROSS SECTIONS	20/06/20	DES
C	AS CONSTRUCTED FINAL	06/05/21	LMS



**SPRING MOUNTAIN**  
 ACREAGE ESTATE  
 STAGE 18B

OW/106/2020



Drawing Title  
**ROADWORKS  
 CROSS SECTIONS  
 DAWSON CLOSE - SHEET 2**


Drawn LMS	Designed JB	Checked GG	Date JUN 20
Scale AS SHOWN	Sheet 12 of 33		Revision
A1	Drawing No 18-201-12	Revision C	

DO NOT SCALE THIS DRAWING  
IF IN DOUBT - ASK!

**MARK SHAW**  
I, ..... hereby certify that the As Constructed information shown on this plan is a true  
and correct record of the sizes, types, materials, classes etc., and it corresponds with the relevant approved Engineering  
Drawings.

Signed *M Shaw* Mark Andrew Shaw  
RPEQ No. 17544  
Dated 06.05.2021

LOCALITY PLAN

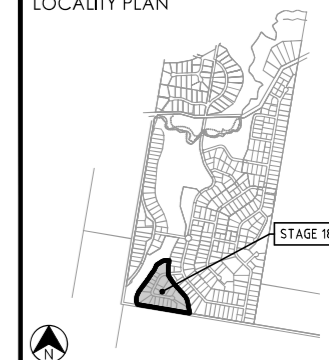

REVISIONS

No	Description	Date	By
A	ISSUED FOR APPROVAL	11/06/20	DES
B	REVISED CROSS SECTIONS	20/08/20	DES
C	AS CONSTRUCTED FINAL	06/05/21	LMS

Client

**PEET**

Project

**SPRING MOUNTAIN  
ACREAGE ESTATE  
STAGE 18B**

OW/106/2020

**kn group**  
ABN 35 112 53 611  
L1, 62 Astor Tee  
Spring Hill Q 4000  
07 3017 1900  
www.knigroup.com.au

Approved


Drawing Title  
**ROADWORKS  
CROSS SECTIONS  
DAWSON CLOSE - SHEET 3**

Drawn LMS	Designed JB	Checked GG	Date JUN 20
Scale AS SHOWN	Sheet 13 of 33		Revision C
A1	18-201-13		

CH470 - CH530  
AC 30  
100mm BASE COURSE (CBR 80%)  
140mm SUB BASE COURSE (CBR 45%)


CH400 - CH470  
AC 30  
100mm BASE COURSE (CBR 80%)  
160mm SUB BASE COURSE (CBR 45%)

CH340 - CH400  
AC 30  
100mm BASE COURSE (CBR 80%)  
140mm SUB BASE COURSE (CBR 45%)

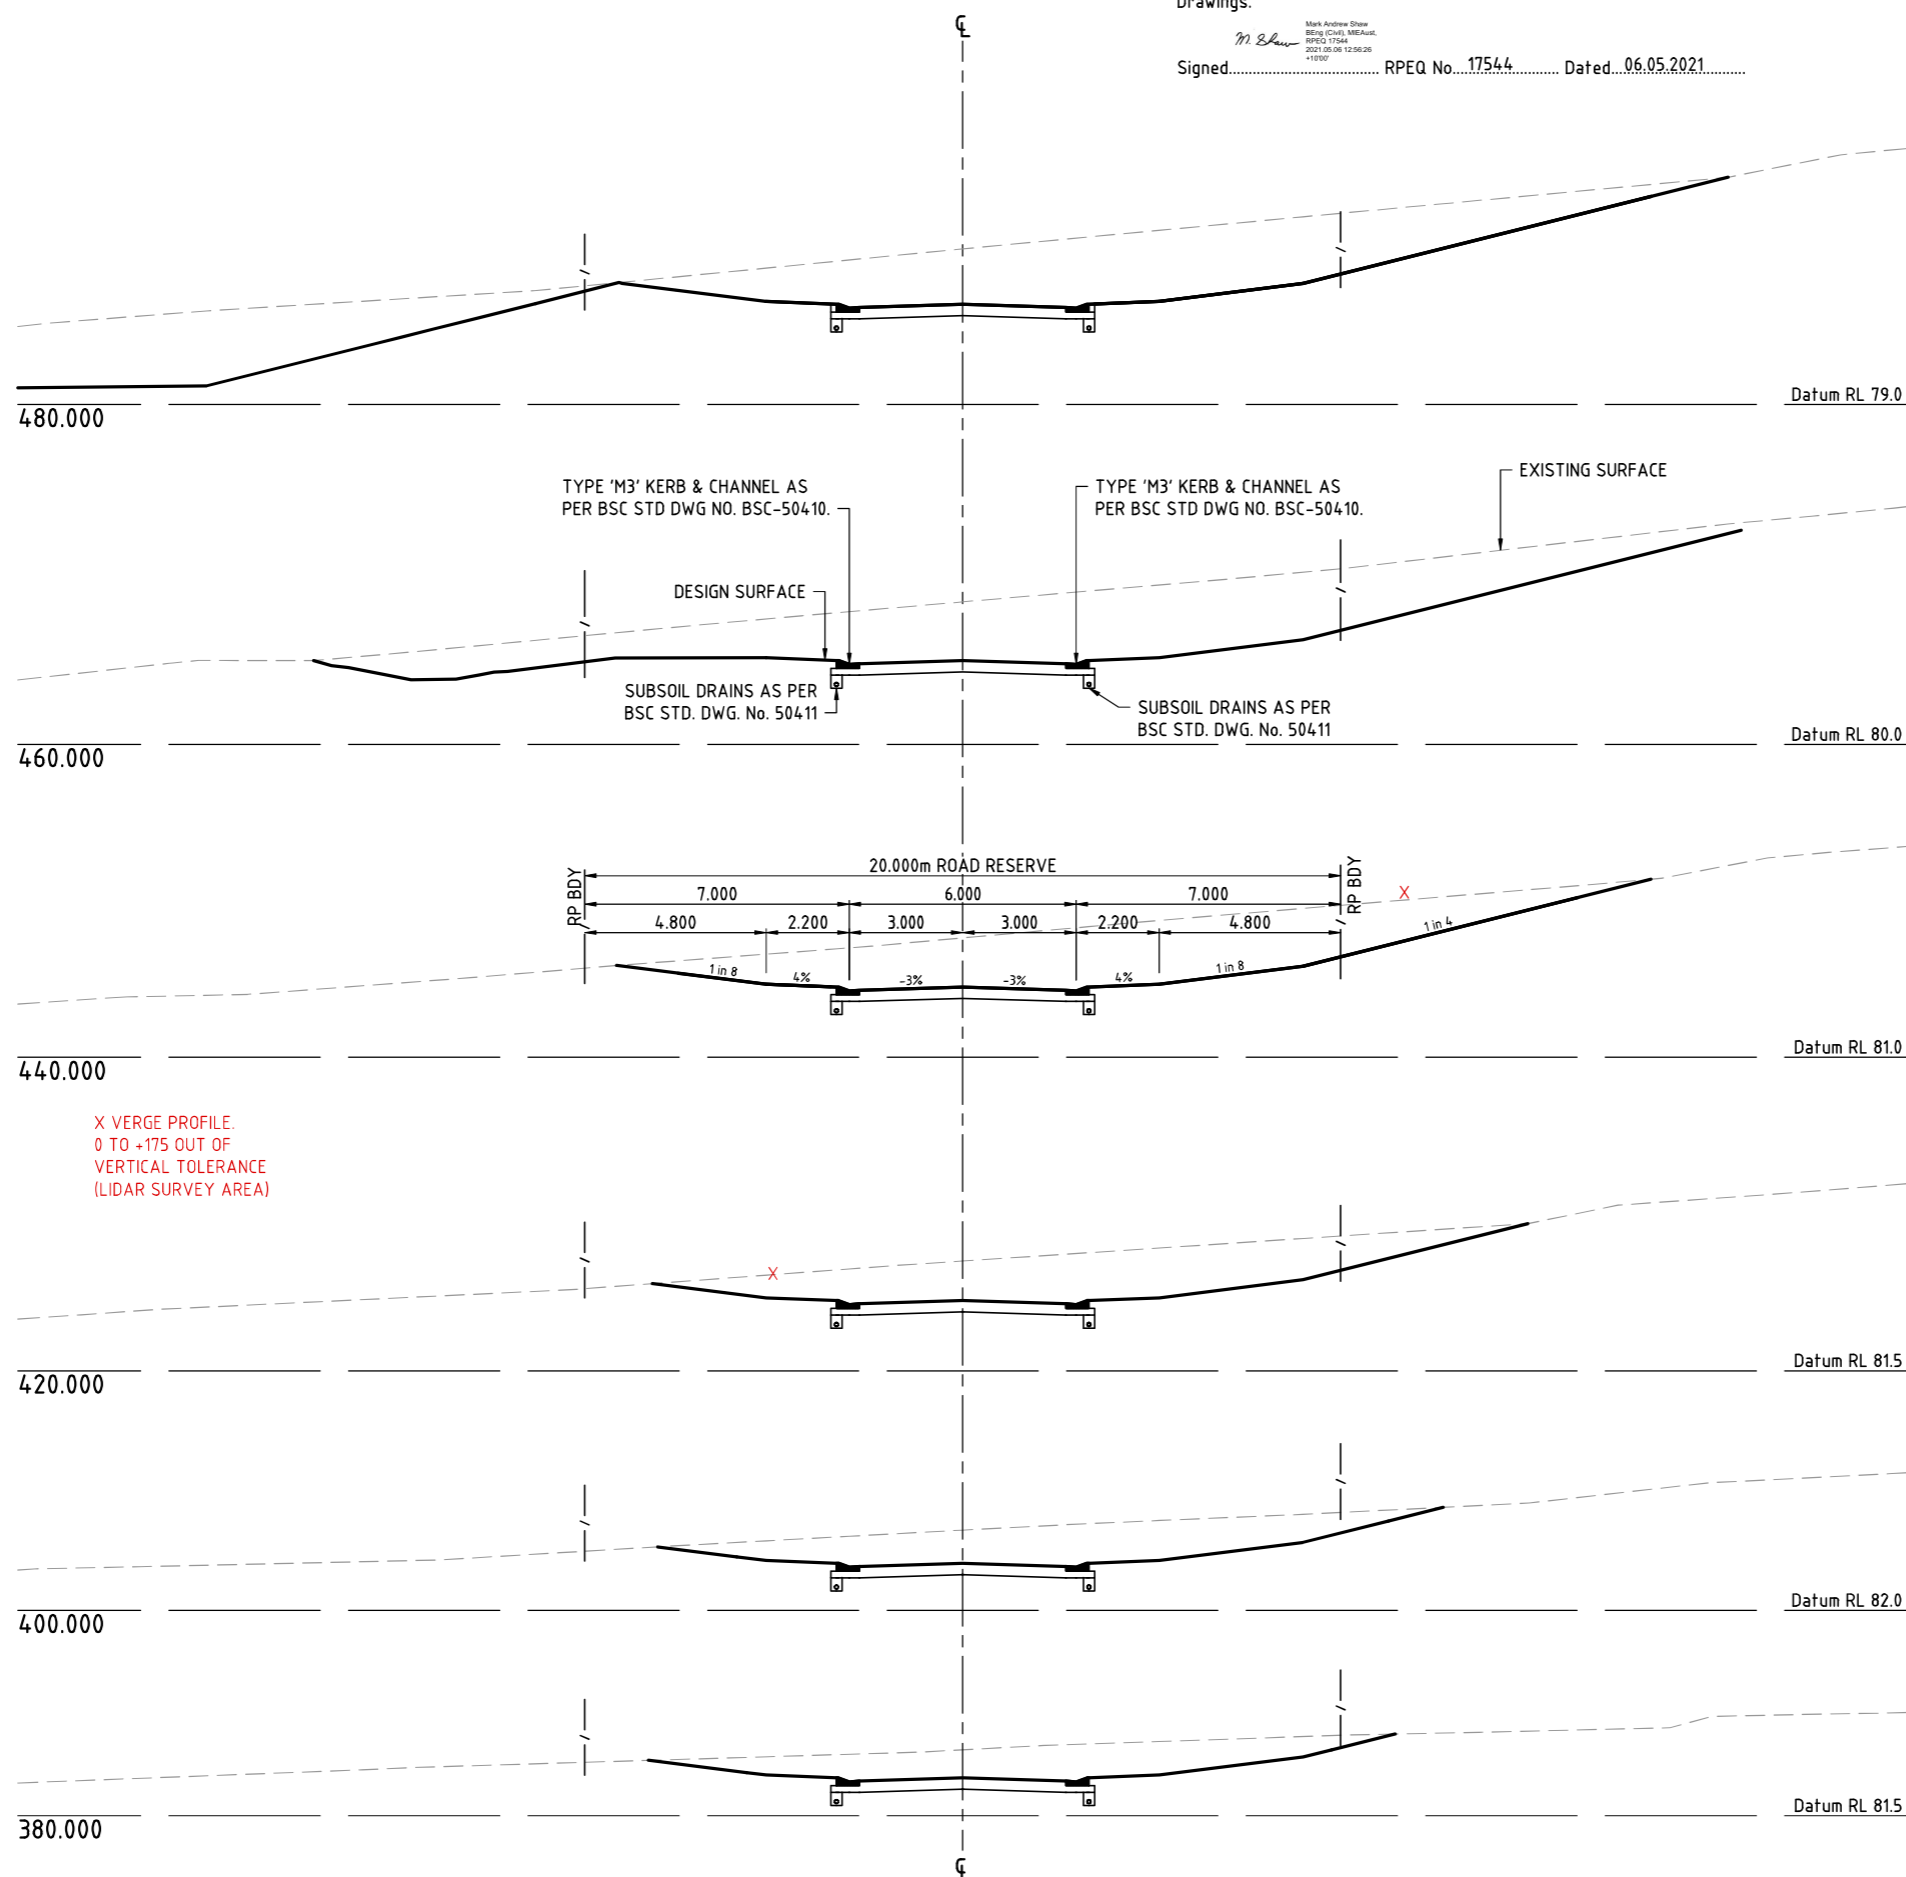

X VERGE PROFILE.  
0 TO +175 OUT OF  
VERTICAL TOLERANCE  
(LIDAR SURVEY AREA)

**CROSS SECTIONS - DAWSON CLOSE**  
SCALE 1:100

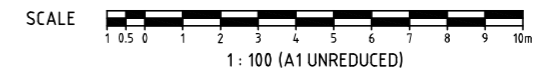


M:\2018\18201 Spring Mountain Stage 18B\Engineering\Ascon\18-201-10-13-RD-LONG-CROSS.dwg Plotted by: DS on 6/05/2021 10:33:05 PM

DO NOT SCALE THIS DRAWING  
IF IN DOUBT - ASK!



LOCALITY PLAN

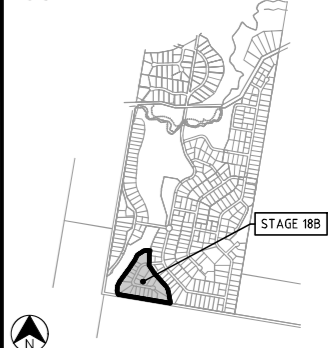

REVISIONS

No	Description	Date	By
A	ISSUED FOR APPROVAL	11/06/20	DES
B	REVISED TABLES/DETAILS	20/06/20	DES
C	AS CONSTRUCTED FINAL	06/05/21	LMS

Client

# PEET

Project

**SPRING MOUNTAIN**  
ACREAGE ESTATE  
STAGE 18B

OW/106/2020

**kn group**  
ABN 35 112 53 611  
L1, 62 Astor Terrace  
Spring Hill Q 4000  
07 3017 1900  
www.knigroup.com.au


Approved

Drawing Title  
**ROADWORKS  
INTERSECTION DETAILS**

Drawn LMS	Designed JB	Checked GG	Date JUN 20
Scale AS SHOWN	Sheet 14 of 33		Revision C
A1	Drawing No 18-201-14		


**LEGEND**

- ROAD CENTRELINE
- KERB AND CHANNEL (TYPE M3)
- KERB AND CHANNEL (TYPE B1)
- STORMWATER DRAINAGE
- FINISHED SURFACE CONTOURS  
OFFSET TO KERB FACE
- DOWEL JOINT (D.J.)
- CUT JOINT (C.J.)

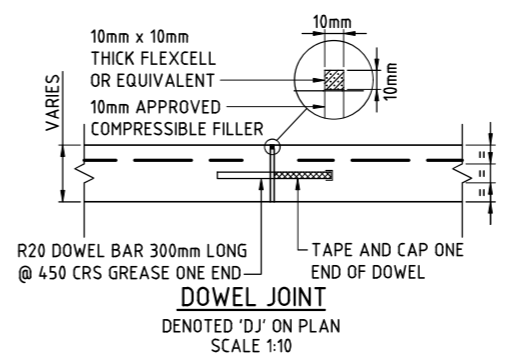


**SETOUT TABLE**

PT No.	EASTING	NORTHING	LEVEL
160	491738.381	6929555.429	80.210
161	491736.463	6929547.202	80.431
162	491738.451	6929538.990	80.817
163	491743.921	6929532.552	81.302
164	491751.703	6929529.263	81.872

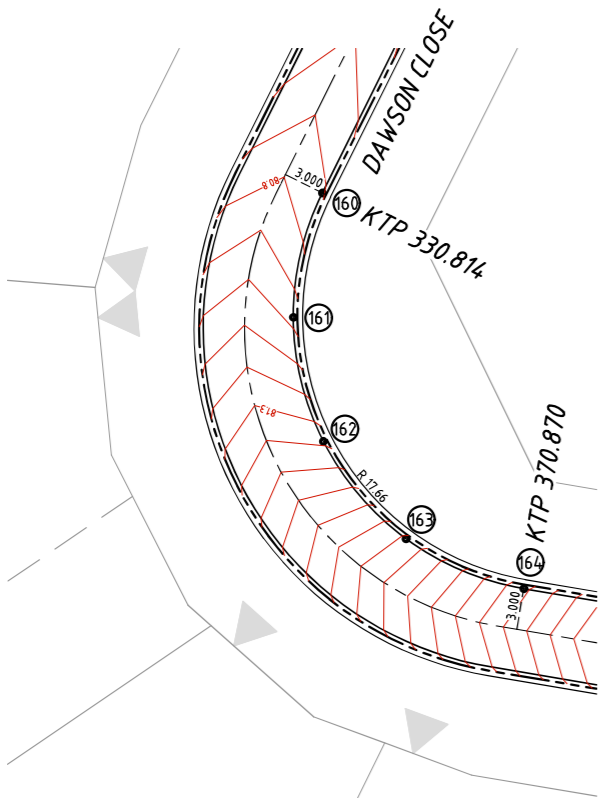

**KERB WIDENING DETAIL - DAWSON CLOSE**  
SCALE 1:250

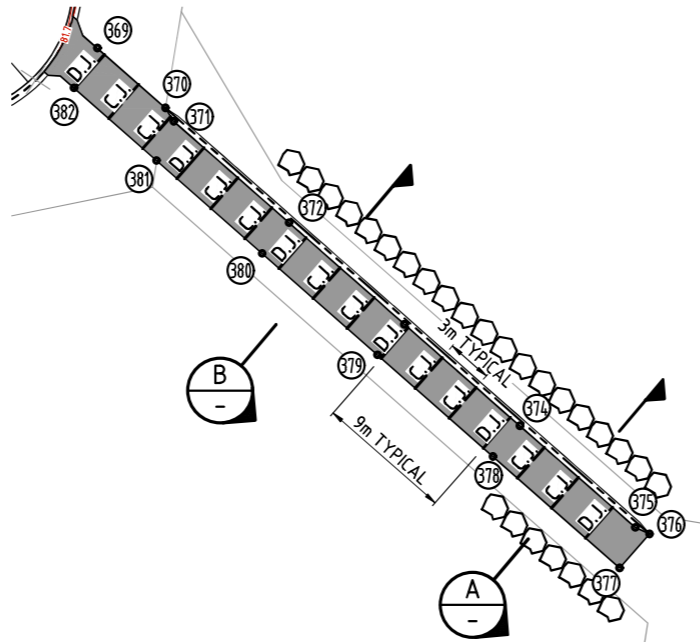


**DRIVEWAY SETOUT DETAIL - LOT 1864**  
SCALE 1:250

**DRIVEWAY - SETOUT TABLE**

PT No.	EASTING	NORTHING	LEVEL
369	491904.355	6929492.182	81.273
370	491908.850	6929488.227	81.513
371	491909.402	6929487.341	81.552
372	491917.033	6929480.625	81.736
373	491924.665	6929473.910	81.863
374	491932.296	6929467.194	81.990
375	491939.927	6929460.478	82.117
376	491940.876	6929460.043	82.130
377	491938.894	6929457.791	82.220
378	491930.512	6929465.167	82.071
379	491922.881	6929471.883	81.944
380	491915.250	6929478.598	81.817
381	491908.264	6929484.745	81.661
382	491902.808	6929489.547	81.282

**MARK SHAW**  
I, Mark Shaw hereby certify that the As Constructed information shown on this plan is a true and correct record of the sizes, types, materials, classes etc., and it corresponds with the relevant approved Engineering Drawings.  
Signed: [Signature] RPEQ No. 17544 Dated: 06.05.2021


**DRIVEWAY AND CROSSOVER 'TYPE 3'**  
N40 CONCRETE (f'cf=4.0MPa)  
125mm THICK SL72 FABRIC  
40 COVER OVER 50mm SAND BEDDING  
AS PER BSC STD DWG 50413

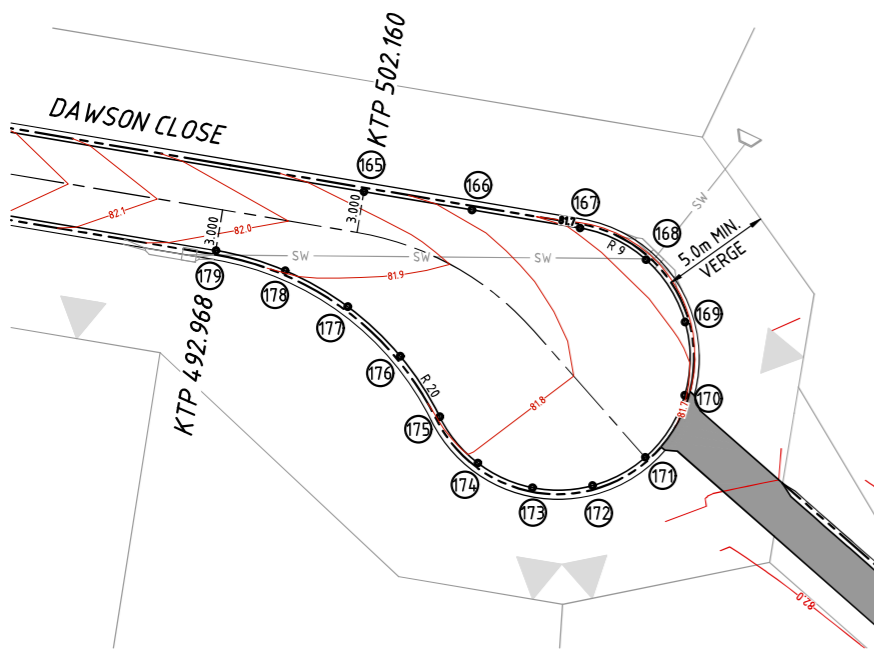


**CUL-DE-SAC DETAIL - DAWSON CLOSE**  
SCALE 1:250

**SETOUT TABLE**

PT No.	EASTING	NORTHING	LEVEL
165	491881.176	6929507.491	81.252
166	491888.318	6929506.290	81.168
167	491895.460	6929505.089	81.087
168	491899.834	6929502.986	81.066
169	491902.408	6929498.872	81.083
170	491902.388	6929494.019	81.107
171	491899.779	6929489.926	81.132
172	491896.286	6929488.052	81.151
173	491892.323	6929487.915	81.171
174	491888.709	6929489.546	81.191
175	491886.189	6929492.606	81.212
176	491883.581	6929496.606	81.236
177	491880.110	6929499.885	81.264
178	491875.968	6929502.260	81.305
179	491871.385	6929503.601	81.357

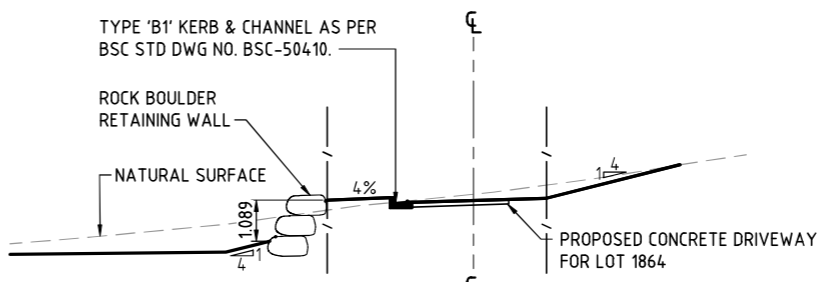


**SECTION B**  
SCALE 1:100

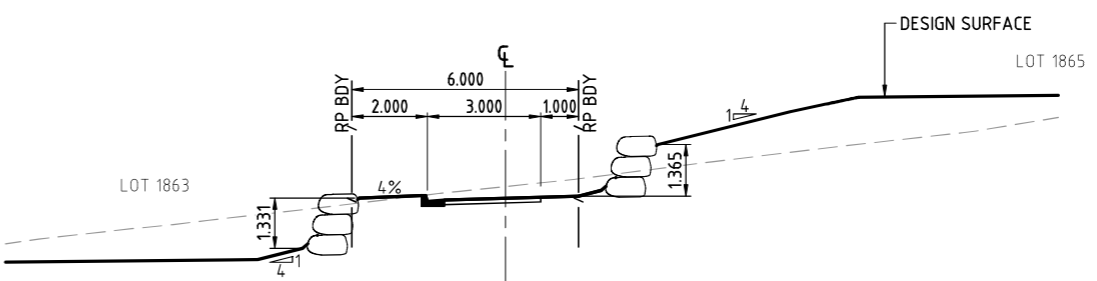


**SECTION A**  
SCALE 1:100




**DRIVEWAY CROSS SECTION**  
SCALE 1:100

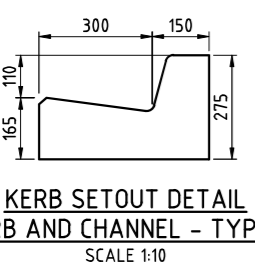

**KERB SETOUT DETAIL  
KERB AND CHANNEL - TYPE B1**  
SCALE 1:10

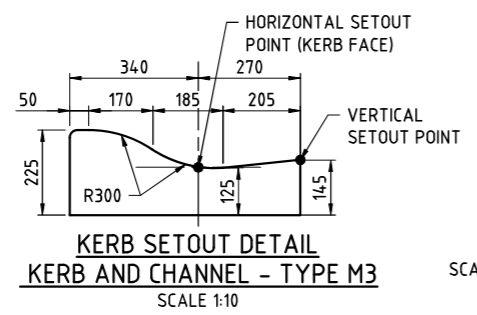


**KERB SETOUT DETAIL  
KERB AND CHANNEL - TYPE M3**  
SCALE 1:10

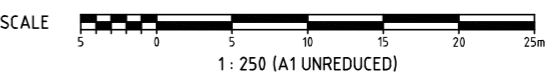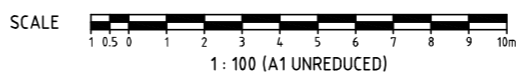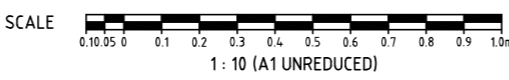

M:\2018\18201 Spring Mountain Stage 18B\Engineering\Ascon\18-201-14-RD-DETAIL.dwg Plotfiled by: DS on 05/05/2021 12:03:10 PM



CATCHMENT NAME	CATCHMENT AREA (ha)	RUNOFF COEFF MINOR	RUNOFF COEFF MAJOR	IMPERVIOUS CATCHMENT AREA MINOR (ha)	IMPERVIOUS CATCHMENT AREA MAJOR (ha)
120	0.384	0.62	0.88	0.238	0.338
121	0.249	0.62	0.88	0.154	0.219
122	0.641	0.62	0.88	0.397	0.564
123	0.982	0.62	0.88	0.609	0.864

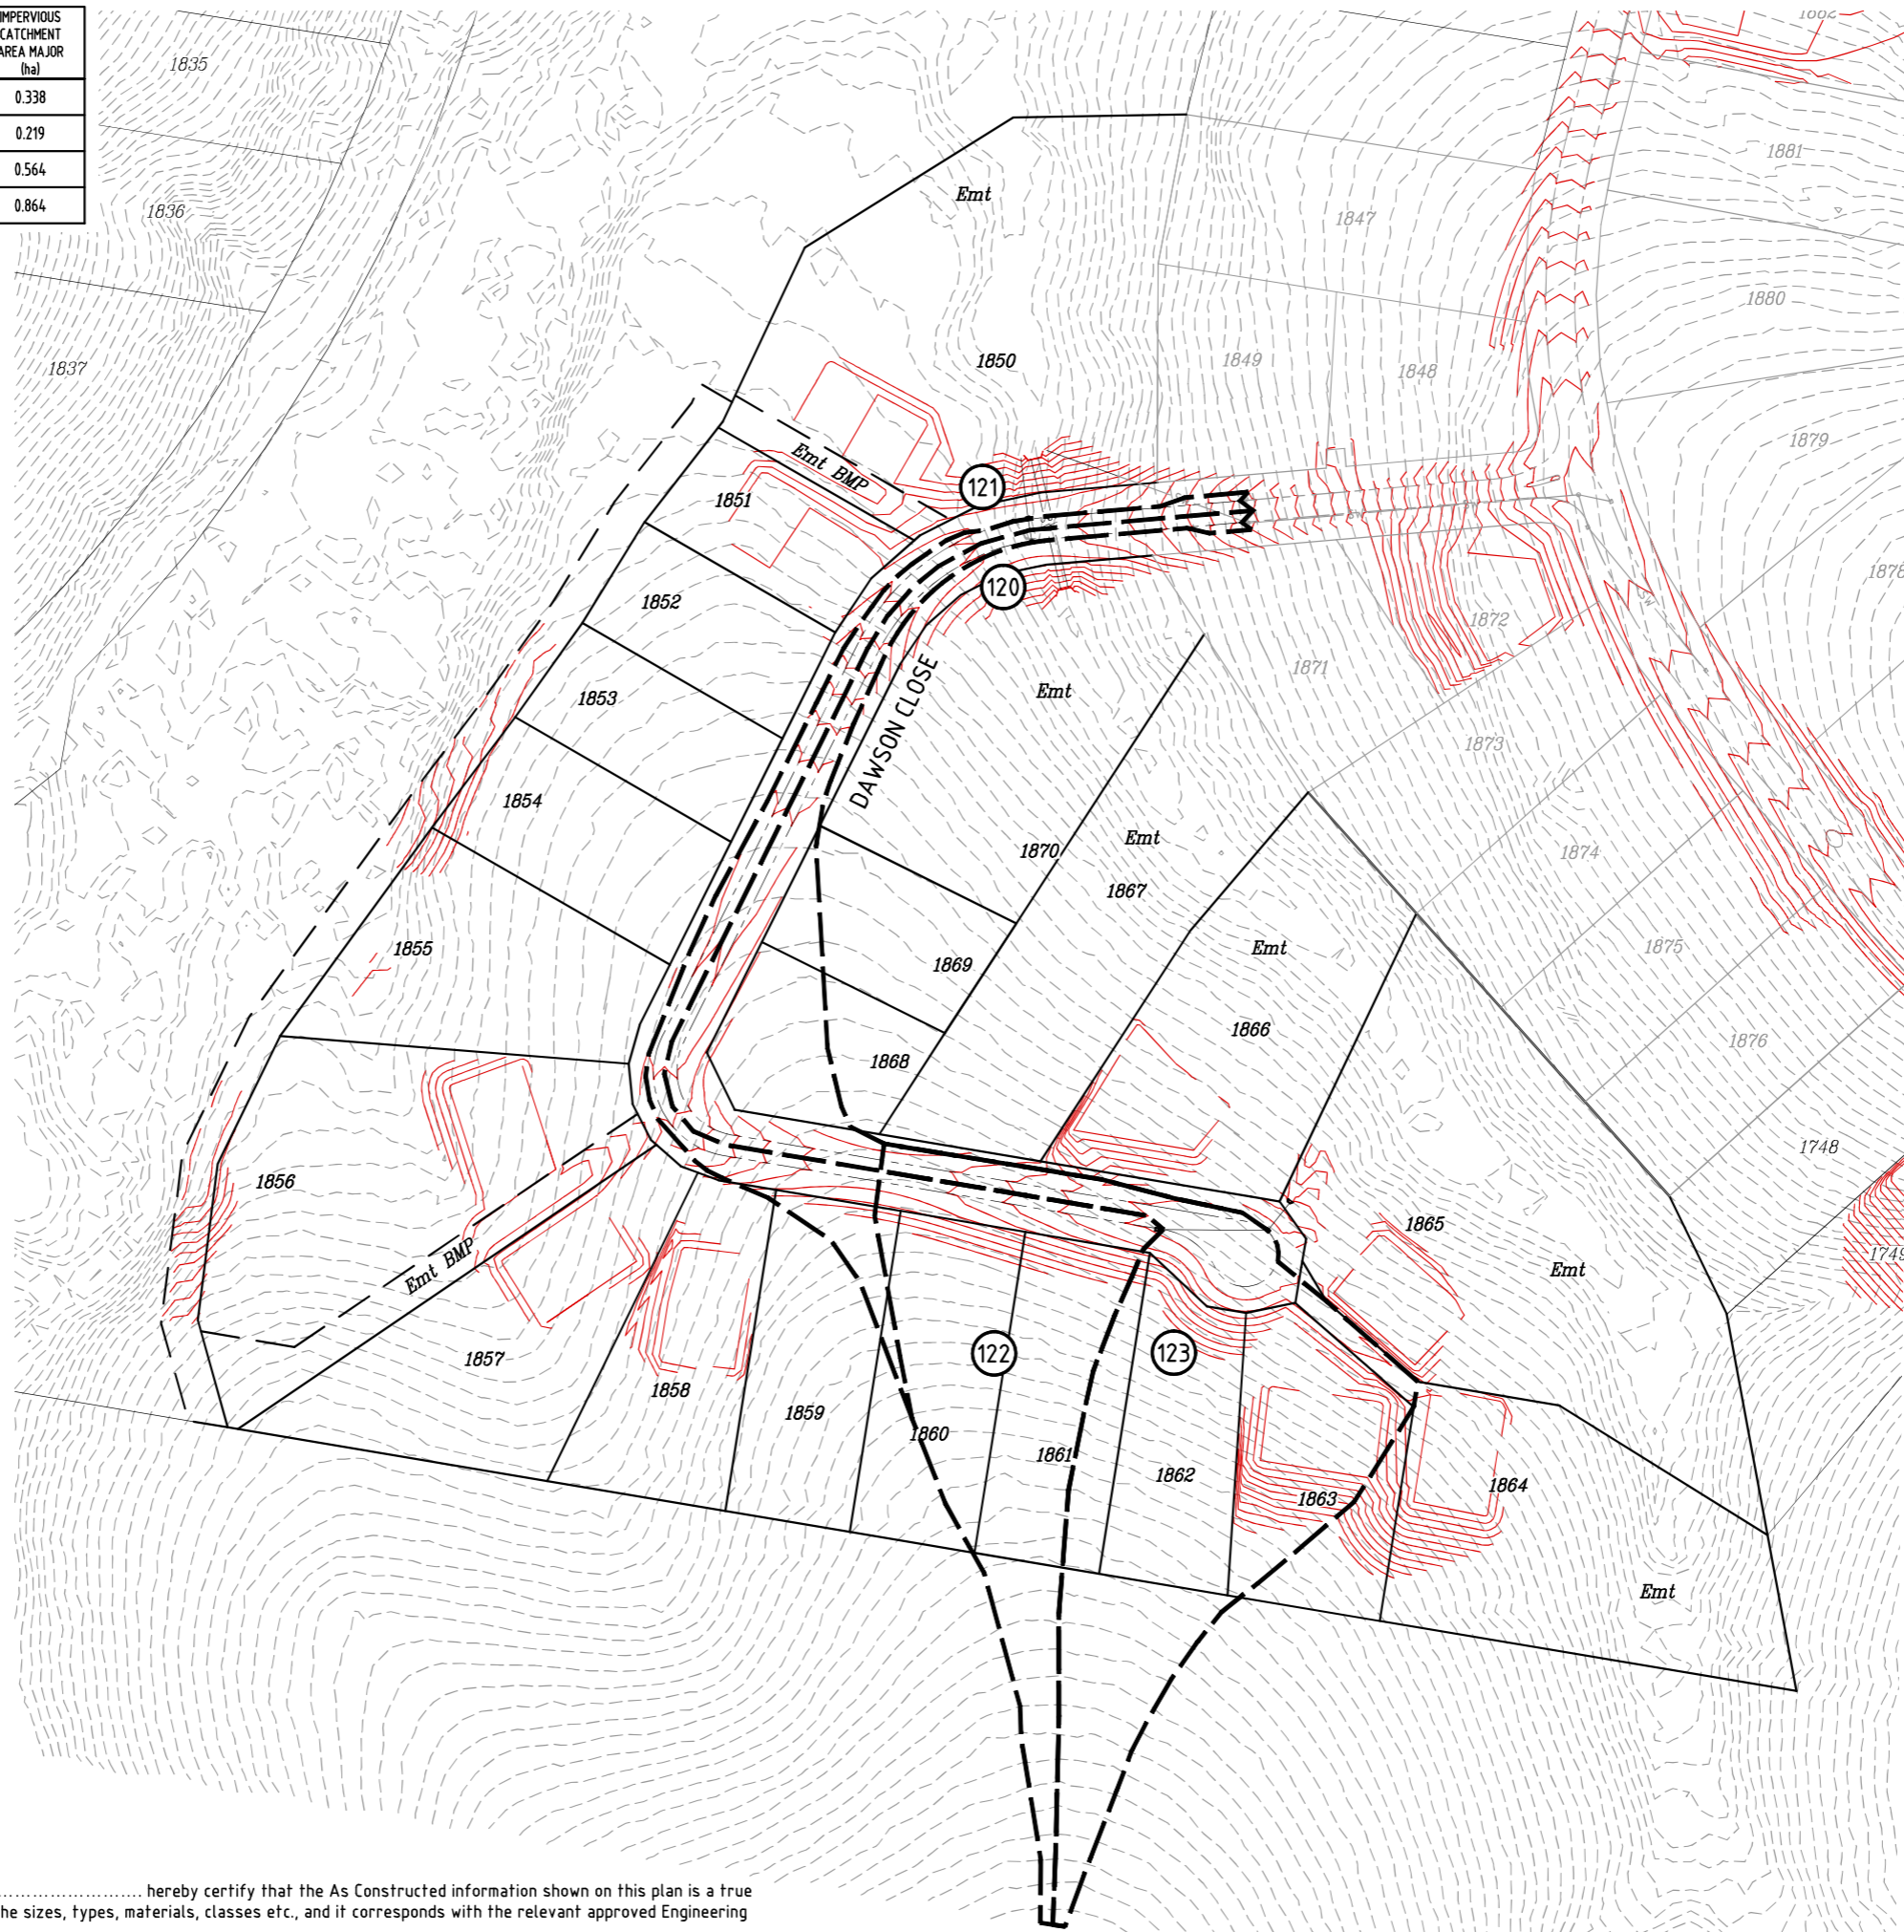


- LEGEND**
- CONSTRUCTION BOUNDARY
  - PROPOSED CATCHMENT BOUNDARY
  - CATCHMENT NUMBER
  - KERB AND CHANNEL
  - PROPOSED STORMWATER DRAINAGE
  - FINISHED SURFACE CONTOURS
  - DTM SURVEY CONTOURS
  - LIDAR CONTOURS

I, **MARK SHAW** hereby certify that the As Constructed information shown on this plan is a true and correct record of the sizes, types, materials, classes etc., and it corresponds with the relevant approved Engineering Drawings.

Signed *M. Shaw* RPEQ No. 17544 Dated 06.05.2021


**CATCHMENT PLAN**  
SCALE 1:1000

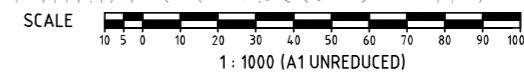

DO NOT SCALE THIS DRAWING IF IN DOUBT - ASK!



LOCALITY PLAN

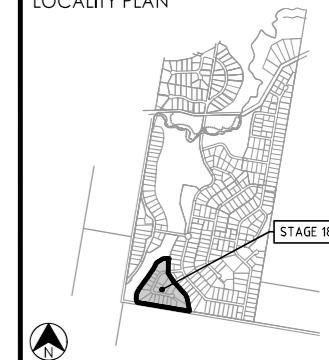

REVISIONS

No	Description	Date	By
A	ISSUED FOR APPROVAL	11/06/20	DES
B	REVISED LOTS / EASEMENT	23/09/20	DES
C	AS CONSTRUCTED FINAL	06/05/21	LMS

Client

**PEET**

Project

**SPRING MOUNTAIN**  
ACREAGE ESTATE  
STAGE 18B

OW/106/2020

**kn group**  
ABN 35 112 53 611  
L1, 62 Astor Tce  
Spring Hill Q 4000  
07 3017 1900  
www.kngroup.com.au


Approved

Drawing Title  
**STORMWATER**  
CATCHMENT PLAN

Drawn	Designed	Checked	Date
LMS	BK	GG	JUN 20
Scale AS SHOWN			Sheet 15 of 33
Drawing No A1 18-201-15		Revision C	

DO NOT SCALE THIS DRAWING  
IF IN DOUBT - ASK!

LOCALITY PLAN

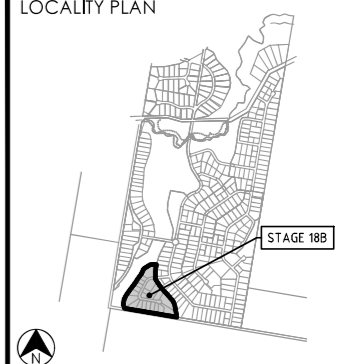

REVISIONS

No	Description	Date	By
A	ISSUED FOR APPROVAL	11/06/20	DES
B	REVISED CALCS SHEET	20/08/20	DES
C	AS CONSTRUCTED FINAL	06/05/21	LMS

Client

# PEET

Project

## SPRING MOUNTAIN ACREAGE ESTATE STAGE 18B

OW/106/2020



ABN 35 112 53 611  
L1, 62 Astor Tee  
Spring Hill Q 4000  
07 3017 1900  
[www.kngroup.com.au](http://www.kngroup.com.au)

Approved

### Drawing Title

#### STORMWATER CALCULATION TABLE

Drawn LMS	Designed BK	Checked GG	Date JUN 20
Scale AS SHOWN			Sheet 16 of 33
Drawing No A1		Revision C	

LOCATION				TIME				SUB-CATCHMENT RUNOFF				INLET DESIGN				DRAIN DESIGN						HEADLOSSES								PART FULL				DESIGN LEVELS																										
DESIGN ARI	STRUCTURE No.	DRAIN SECTION	SUB-CATCHMENTS CONTRIBUTING	LAND USE	SLOPE OF CATCHMENT		10yr RAINFALL INTENSITY	10yr C10	CO-EFFICIENT OF RUNOFF	SUB-CATCHMENT AREA	EQUIVALENT AREA	SUM OF (C x A)	SUB-CATCHMENT DISCHARGE	FLOW IN KB/C (INC. BYPASS)	ROAD GRADE AT INLET	MINOR FLOW ROAD CAPACITY	INLET TYPE	FLOW INTO INLET	BYPASS FLOW	BYPASS STRUCTURE No.	CRITICAL TIME OF CONC.	RAINFALL INTENSITY	TOTAL (C x A)	MAJOR TOTAL FLOW	MAJOR SURFACE FLOW CAPACITY	MAJOR SURFACE FLOW	PIPE FLOW	REACH LENGTH	PIPE GRADE	PIPE / BOX DIMENSIONS (CLASS)	FLOW VELOCITY FULL (PIPE GRADE VELOCITY)	TIME OF FLOW IN REACH	STRUCTURE CHART No.	STRUCTURE RATIOS FOR 'K' VALUE CALCULATIONS	VELOCITY HEAD	U/S HEADLOSS COEFFICIENT	U/S PIPE STRUCT. HEADLOSS	L.A.T. HEADLOSS CO-EFFICIENT	L.A.T. PIPE STRUCT. HEADLOSS	W.S.E. CO-EFFICIENT	CHANGE IN W.S.E	PIPE FRICTION SLOPE	PIPE FRICTION HEADLOSS (L x Sf)	DEPTH	VELOCITY	OBVERT LEVELS	DRAIN SECTION H.G.L.	UPSTREAM H.G.L.	L.A.T. H.G.L.	W.S.E.	SURFACE OR K&C INVERT LEVEL	STRUCTURE No.								
					min	mm/h																																															ha	ha	ha	l/s	l/s	%	l/s	l/s
2 100	G101	G101 to G102	101		15.00	15.00	192	0.88	0.425	0.264	0.264	70	2.47	2.47	2.47	2.47	61	9	G103	15.00	192	0.374	199	1579	139	61	51.18	1.95	375120	55(0.47) 1y	0.86							0.015	5.90	0.091																				G101
2 100	G102	G102 to 18A	101,102		5.00	5.00	295	0.75	0.090	0.068	0.068	28	28	28	28	28	0	G118	15.86	188	0.332	24.2	911	165	77	9.346	0.60	375120	70(10.59) 1y	0.16						Part full downstream pipe Upstream HGL 88.090 below outlet pipe obv 88.132 Set Kp to 16	0.025	1.60	0.131								0.127	1.84	89.154	88.152	89.245		89.245	90.194		G102				
2 100	G103	G103 to 18A	103		15.00	15.00	192	0.62	0.457	0.283	0.283	75	83	1.00	14.2	2	69	15	G104A	15.00	192	0.464	214	911	146	69	9.204	2.00	375120	62(10.50) 1y	0.15						0.020	7.90	0.155								0.135	1.92	88.160	88.160	88.315		88.315	89.125		G103				
2 100	18A	18A to G118	18A -Maj; 101; 102; 103		5.00	5.00	295	0.75	0.054	0.041	0.041	17	17	8.20	4.08	2	17	0	G121	5.00	295	0.054	44	2488	28	17	6.639	3.69	375120	15(10.12) 1y	0.11						Part full downstream pipe Upstream HGL 77.781 below outlet pipe obv 77.937 Set Kp to 19	0.001	7.90	0.043							0.057	1.59	77.937	77.737	77.781		77.781	78.781		G119				
2 100	G118	G118 to 18OUT	18A -Maj; 101; 102; 103, 119, 118		5.00	5.00	295	0.75	0.058	0.044	0.044	18	18	8.20	4.08	2	18	0	G120	17.21	181	0.700	4.92	2488	333	159	59.271	10.84	375120	14(11.9) 1y	0.69						Og 0.011 Qo 0.159 Do 375 Routine 2.24 Join Pipes: 18A and G119 Vel 1.251 Vel2 0.092 Eq Dia 481 Angle 148 Flow 0.148	0.106	0.62	0.066	0.62	0.066	0.83	0.489	0.135	4.46	77.671	77.671	77.737		77.737	78.781		G118						
2 100	G120	G120 to G121	120		15.00	15.00	192	0.62	0.384	0.238	0.238	63	63	0.00	192	1850.08	63	0	G121	15.00	192	0.338	180	0	117	63	6.597	4.00	375120	0.5(10.44) 1y	0.11						0.017	7.90	0.131							0.108	2.40	74.745	74.745	74.876		74.876	75.782		G120					
2 100	G121	G121 to 210UT	120; 121		15.00	15.00	192	0.62	0.249	0.154	0.154	41	41	0.00	192	1850.08	41	0	G121	15.11	192	0.392	297	0	194	103	16.933	14.33	375120	0.4(10.73) 1y	0.28						0.045	7.53	0.339							0.100	4.37	73.657	73.657	73.996		73.996	75.782		G121					
2 100	G122	G122 to G123	122		15.00	15.00	192	0.62	0.616	0.382	0.382	101	101	1.30	162	2	78	23	G123	15.00	192	0.542	289	991	211	78	30.745	1.41	375120	7(10.60) 1y	0.51						0.026	5.90	0.152							0.160	1.75	80.525	80.525	80.676		80.676	81.377		G122					
2 100	G123	G123 to 220UT	122; 123		15.00	15.00	192	0.62	0.572	0.355	0.355	94	116	0.00	192	1850.08	116	0	G123	15.51	190	0.737	552	0	357	194	9.754	2.00	375120	7(10.37) 1y	0.09						0.158	2.11	0.333							0.250	2.48	80.070	80.070	80.403		80.403	81.066		G123					

CALCULATIONS TABLE

MARK SHAW



I, MARK SHAW hereby certify that the As Constructed information shown on this plan is a true and correct record of the sizes, types, materials, classes etc., and it corresponds with the relevant approved Engineering Drawings.

Signed..... RPEQ No. 17544 Dated ..06.05.2021.....

Mark Andrew Shaw  
RPEQ No. 17544  
20/05/20 12:57:01




STRUCTURE NAME
STRUCTURE DESCRIPTION

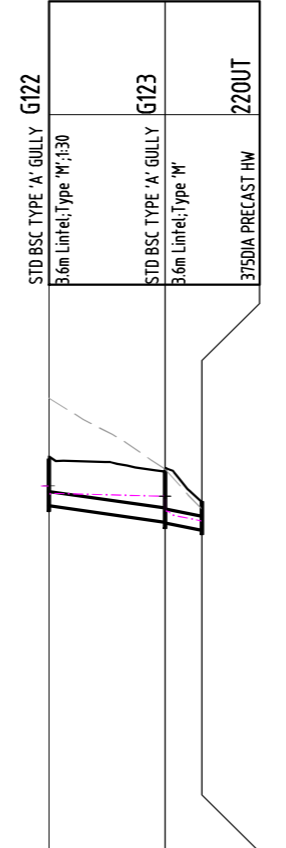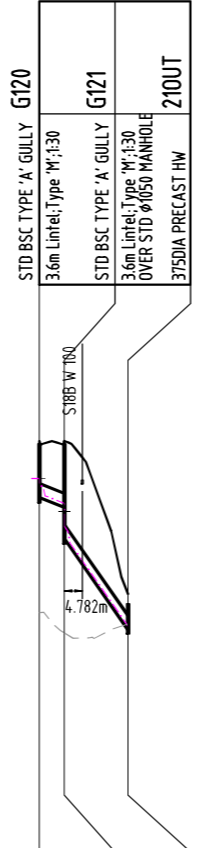

STAGE	EXISTING STAGE 18A		STAGE 18B	
PIPE SIZE <sub>mm</sub> (Class)	375(2)	375(2)	375(2)	375(2)
PIPE GRADE %	1.95%	0.60%	10.63%	10.84%
PIPE SLOPE 1 in X	51.32	166.87	9.41	9.22
FULL PIPE FLOW VELOCITY (m/s)			1.29(1.07 1y)	4.46 (4.23 1y)
PART FULL FLOW VELOCITY (m/s)	1.84 (1.76 1y)	1.27 (1.22 1y)	4.30 (4.08 1y)	
DATUM	RL 72.0		70.0	60.0
WATER LEVEL IN STRUCTURE	89.245	88.090	77.737	71.005
HYDRAULIC GRADE LEVEL	89.245	88.090	77.737	71.005
PIPE FLOW (Cumecs)	0.061	0.077	0.143	0.159
PIPE CAPACITY AT GRADE (Cumecs)	0.245	0.136	0.571	0.577
DEPTH TO INVERT	1.415	1.392	1.465	0.680
INVERT LEVEL OF DRAIN	88.779	87.757	77.316	70.870
DESIGN SURFACE LEVEL	90.194	89.169	78.781	71.550
SETOUT CO-ORDINATE	E:492021.668 N:6929658.087	E:491988.989 N:6929691.705	E:491894.890 N:6929698.926	E:491839.134 N:6929719.033
RUNNING CHAINAGE	0.000	51.418	91.837	211.872

STAGE	STAGE 18B	
PIPE SIZE <sub>mm</sub> (Class)	375(2)	375(2)
PIPE GRADE %	5.699%	14.069%
PIPE SLOPE 1 in X	25.00	6.98
FULL PIPE FLOW VELOCITY (m/s)	2.40 (2.23 1y)	4.37 (4.06 1y)
PART FULL FLOW VELOCITY (m/s)		
DATUM	74.876	70.970
WATER LEVEL IN STRUCTURE	74.876	73.996
HYDRAULIC GRADE LEVEL	74.876	73.996
PIPE FLOW (Cumecs)	0.063	0.103
PIPE CAPACITY AT GRADE (Cumecs)	0.350	0.663
DEPTH TO INVERT	1.447	2.500
INVERT LEVEL OF DRAIN	73.429	71.470
DESIGN SURFACE LEVEL	75.182	71.550
SETOUT CO-ORDINATE	E:491835.035 N:6929693.694	E:491833.902 N:6929700.193
RUNNING CHAINAGE	6.597	16.833

STAGE	STAGE 18B	
PIPE SIZE <sub>mm</sub> (Class)	375(2)	375(2)
PIPE GRADE %	1.476%	2.819%
PIPE SLOPE 1 in X	70.77	50.00
FULL PIPE FLOW VELOCITY (m/s)	0.71(0.60 1y)	2.48 (2.35 1y)
PART FULL FLOW VELOCITY (m/s)	1.75 (1.67 1y)	
DATUM	80.676	79.750
WATER LEVEL IN STRUCTURE	80.676	80.403
HYDRAULIC GRADE LEVEL	80.676	80.403
PIPE FLOW (Cumecs)	0.078	0.194
PIPE CAPACITY AT GRADE (Cumecs)	0.208	0.248
DEPTH TO INVERT	1.478	1.351
INVERT LEVEL OF DRAIN	79.198	78.053
DESIGN SURFACE LEVEL	81.137	80.250
SETOUT CO-ORDINATE	E:491869.634 N:6929503.319	E:491900.378 N:6929503.050
RUNNING CHAINAGE	30.745	40.439

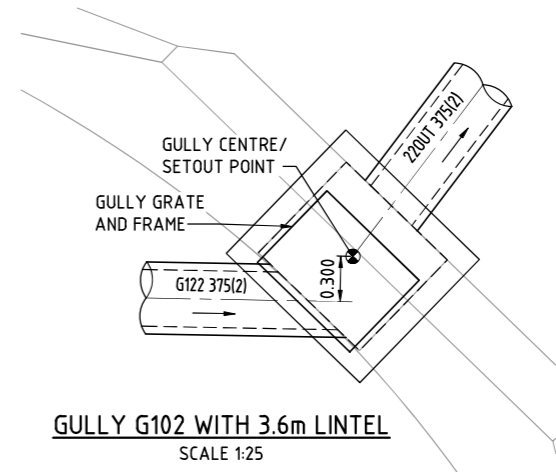


LINE 1, MARK SHAW hereby certify that the As Constructed information shown on this plan is a true and correct record of the sizes, types, materials, classes etc., and it corresponds with the relevant approved Engineering Drawings.

Signed: *M. Shaw* RPEQ No. 17544 Dated: 06.05.2021



DO NOT SCALE THIS DRAWING IF IN DOUBT - ASK!

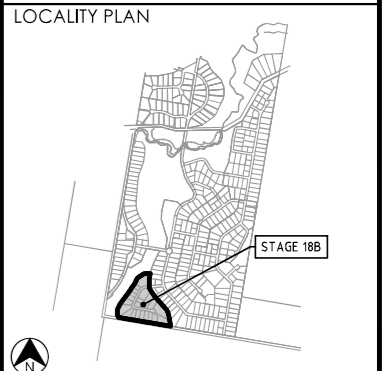

REVISIONS			
No	Description	Date	By
A	ISSUED FOR APPROVAL	11/06/20	DES
B	REVISED LONG SECTION	20/08/20	DES
C	AS CONSTRUCTED FINAL	06/05/21	LMS




Project  
**SPRING MOUNTAIN**  
 ACREAGE ESTATE  
 STAGE 18B  
 OW/106/2020



Approved			
Drawing Title STORMWATER LONGITUDINAL SECTIONS AND GULLY DETAIL			
Drawn LMS	Designed BK	Checked GG	Date JUN 20
Scale AS SHOWN		Sheet 17 of 33	
A1	Drawing No 18-201-17	Revision C	

M:\2018\18201 Spring Mountain Stage 18B\Engineering\Ascon\18-201-17-SW-LONGS.dwg Plotted by: DS on 6/05/2021 10:03:28 PM

M:\2018\18201 Spring Mountain Stage 18B Engineering\Ascon\18-201-18-SW-CULV-DET.dwg Plotted by: DS on 6/05/2021 12:03:34 PM

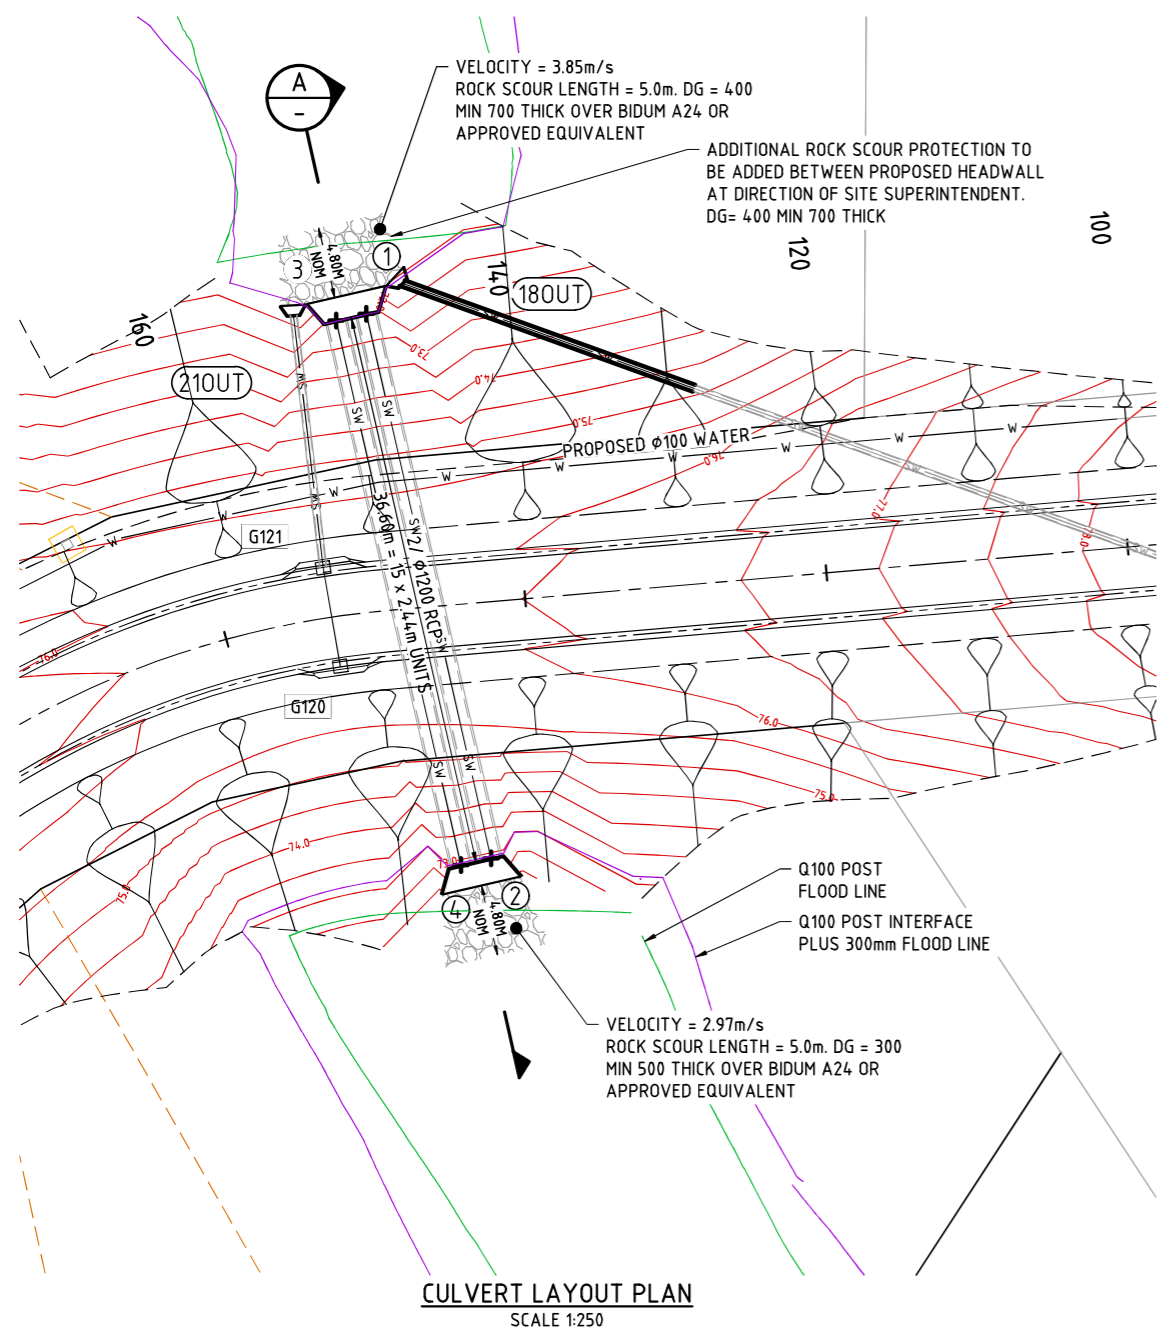

**CULVERT LAYOUT PLAN**  
SCALE 1:250

**MARK SHAW**  
I, ..... hereby certify that the As Constructed information shown on this plan is a true and correct record of the sizes, types, materials, classes etc., and it corresponds with the relevant approved Engineering Drawings.  
Signed..... RPEQ No.....17544..... Dated...06.05.2021.....

**LEGEND**

- ROAD CENTRELINE
- BARRIER KERB AND CHANNEL (TYPE B1)
- SEMI - MOUNTABLE KERB (TYPE SM5 - MODIFIED)
- S --- SEWERAGE
- W --- WATER
- TW --- TRUNK WATER
- (2A) --- STORMWATER MANHOLE NUMBER
- G001 --- STORMWATER GULLY PIT NUMBER
- SAFETY FENCE
- BATTER LINE - TOP
- BATTER LINE - BOTTOM
- [Pattern] --- ROCK SCOUR PROTECTION WITH IMPERMEABLE LINER BENEATH

POINT	DESCRIPTION	EASTING	NORTHING	LEVEL
1	CTR OF D/S PIPE	491836.755	6929717.008	70.870
2	CTR OF U/S PIPE	491845.009	6929680.992	71.320
3	CTR OF D/S PIPE	491834.757	6929716.550	70.870
4	CTR OF U/S PIPE	491843.011	6929680.535	71.320

- NOTE**
- THIS DWG IS TO BE READ IN CONJUNCTION WITH DMR STD DWG 1303 and 1312 to 1320
  - DIMENSIONS OF CULVERT CELLS TO BE CONFIRMED PRIOR TO COMMENCEMENT OF CONSTRUCTION
  - FINAL SETOUT OF CULVERT SCOUR PROTECTION TO BE AS DIRECTED ON SITE BY SUPERINTENDENTS REP.

DO NOT SCALE THIS DRAWING IF IN DOUBT - ASK!

NORTH

LOCALITY PLAN

**REVISIONS**

No	Description	Date	By
A	ISSUED FOR APPROVAL	11/06/20	DES
B	REVISED CULVERT DETAILS	20/08/20	DES
C	AS CONSTRUCTED FINAL	06/05/21	LMS


Client

Project

**SPRING MOUNTAIN**  
ACREAGE ESTATE  
STAGE 18B

OW/106/2020

ABN 35 112 53 611  
L1, 62 Astor Terrace  
Spring Hill Q 4000  
07 3017 1900  
www.kngroup.com.au

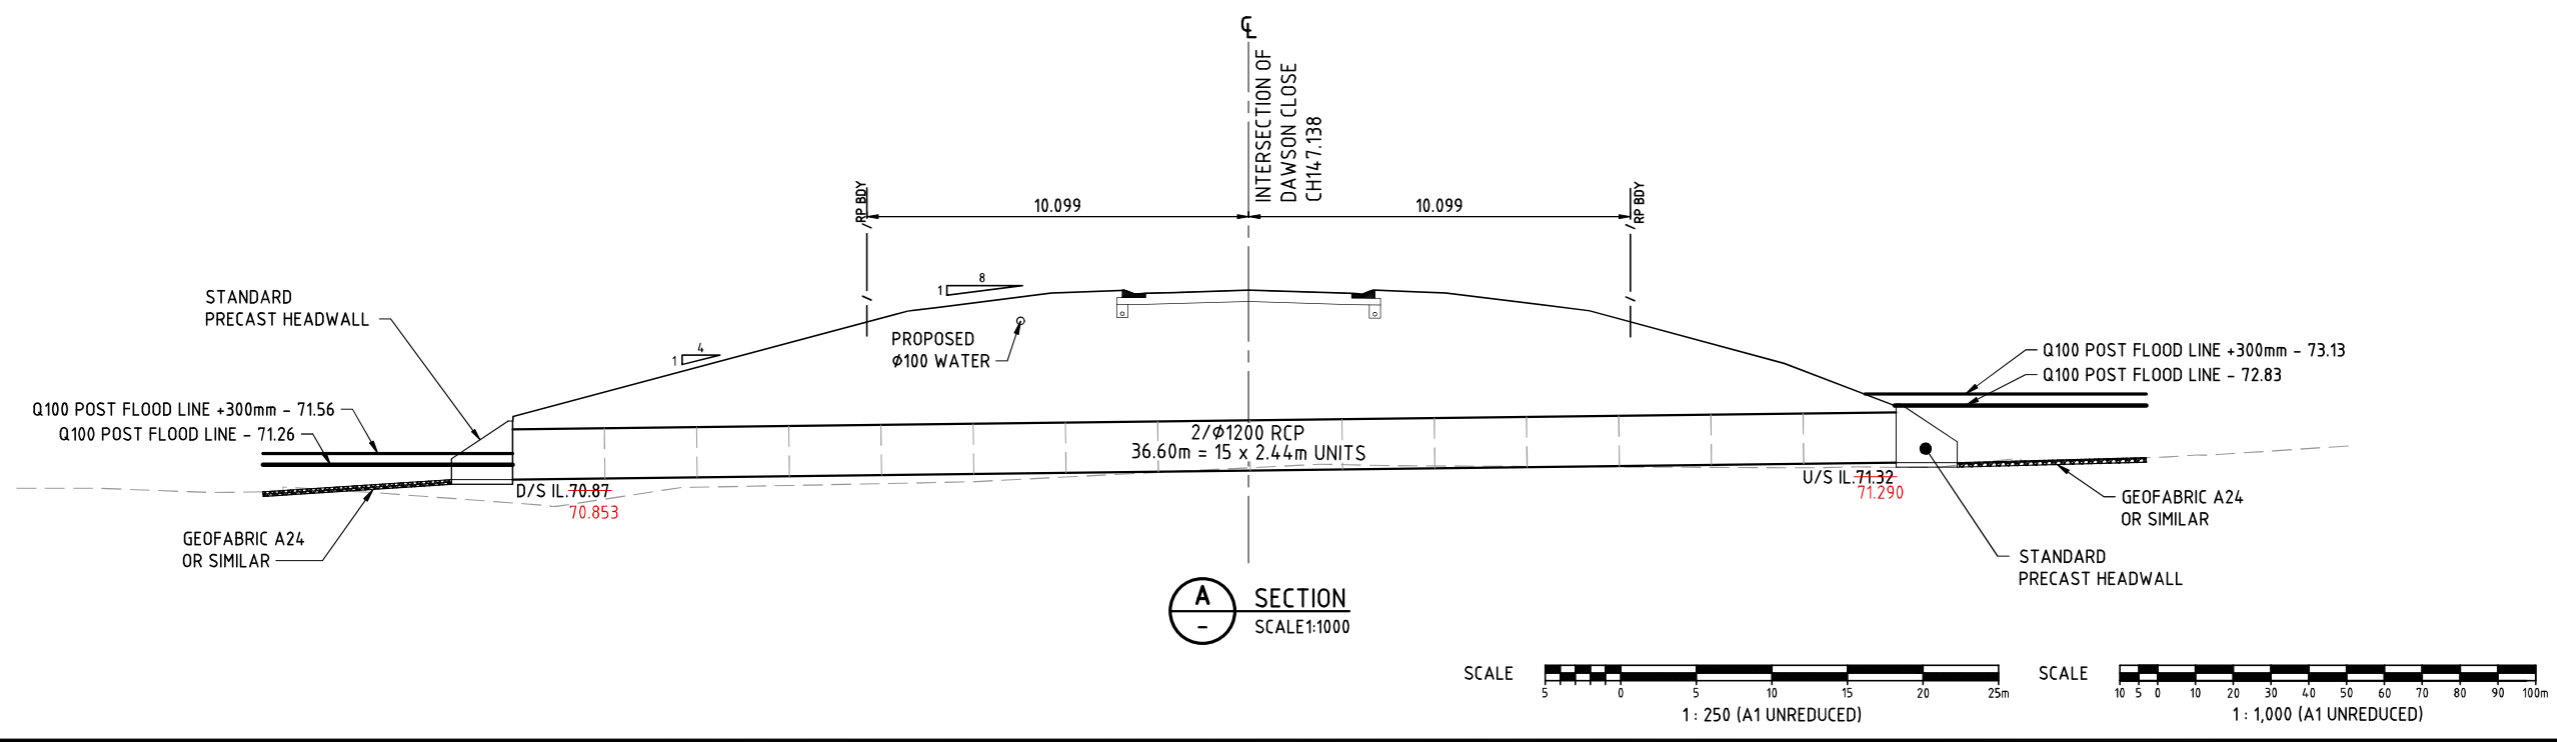

**SECTION A**  
SCALE 1:1000

SCALE 1: 250 (A1 UNREDUCED)

SCALE 1: 1,000 (A1 UNREDUCED)

Approved

Drawing Title  
**STORMWATER CULVERT DETAIL**

Drawn	Designed	Checked	Date
LMS	BK	GG	JUN 20

Scale	Sheet
AS SHOWN	18 of 33

Drawing No	Revision
A1 18-201-18	C




**LEGEND**

- CONSTRUCTION BOUNDARY
- - - KERB AND CHANNEL (TYPE M3)
- - - KERB AND CHANNEL (TYPE SM3)
- SW PROPOSED STORMWATER DRAINAGE
- 36.0 FINISHED SURFACE CONTOURS
- Q100 FLOOD POST CONSTRUCTION EXTENTS
- 300mm FREEBOARD EXTENTS
- - - 36.0 DTM SURVEY CONTOURS
- - - 36.0 LIDAR CONTOURS
- BATTER LINE - TOP
- BATTER LINE - BOTTOM
- GULLY BAGS
- SEDIMENT AND DIVERSION FENCE (TEMP)

**NOTE**  
 EROSION AND SEDIMENT CONTROL REQUIREMENTS TO BE CERTIFIED ON SITE BY A RECOGNISED SPECIALIST IN THE SOIL AND EROSION AND SEDIMENT CONTROL - CPESC.

**MARK SHAW**  
 I, ..... hereby certify that the As Constructed information shown on this plan is a true and correct record of the sizes, types, materials, classes etc., and it corresponds with the relevant approved Engineering Drawings.


Signed *M. Shaw* RPEQ No. 17544 Dated 06.05.2021

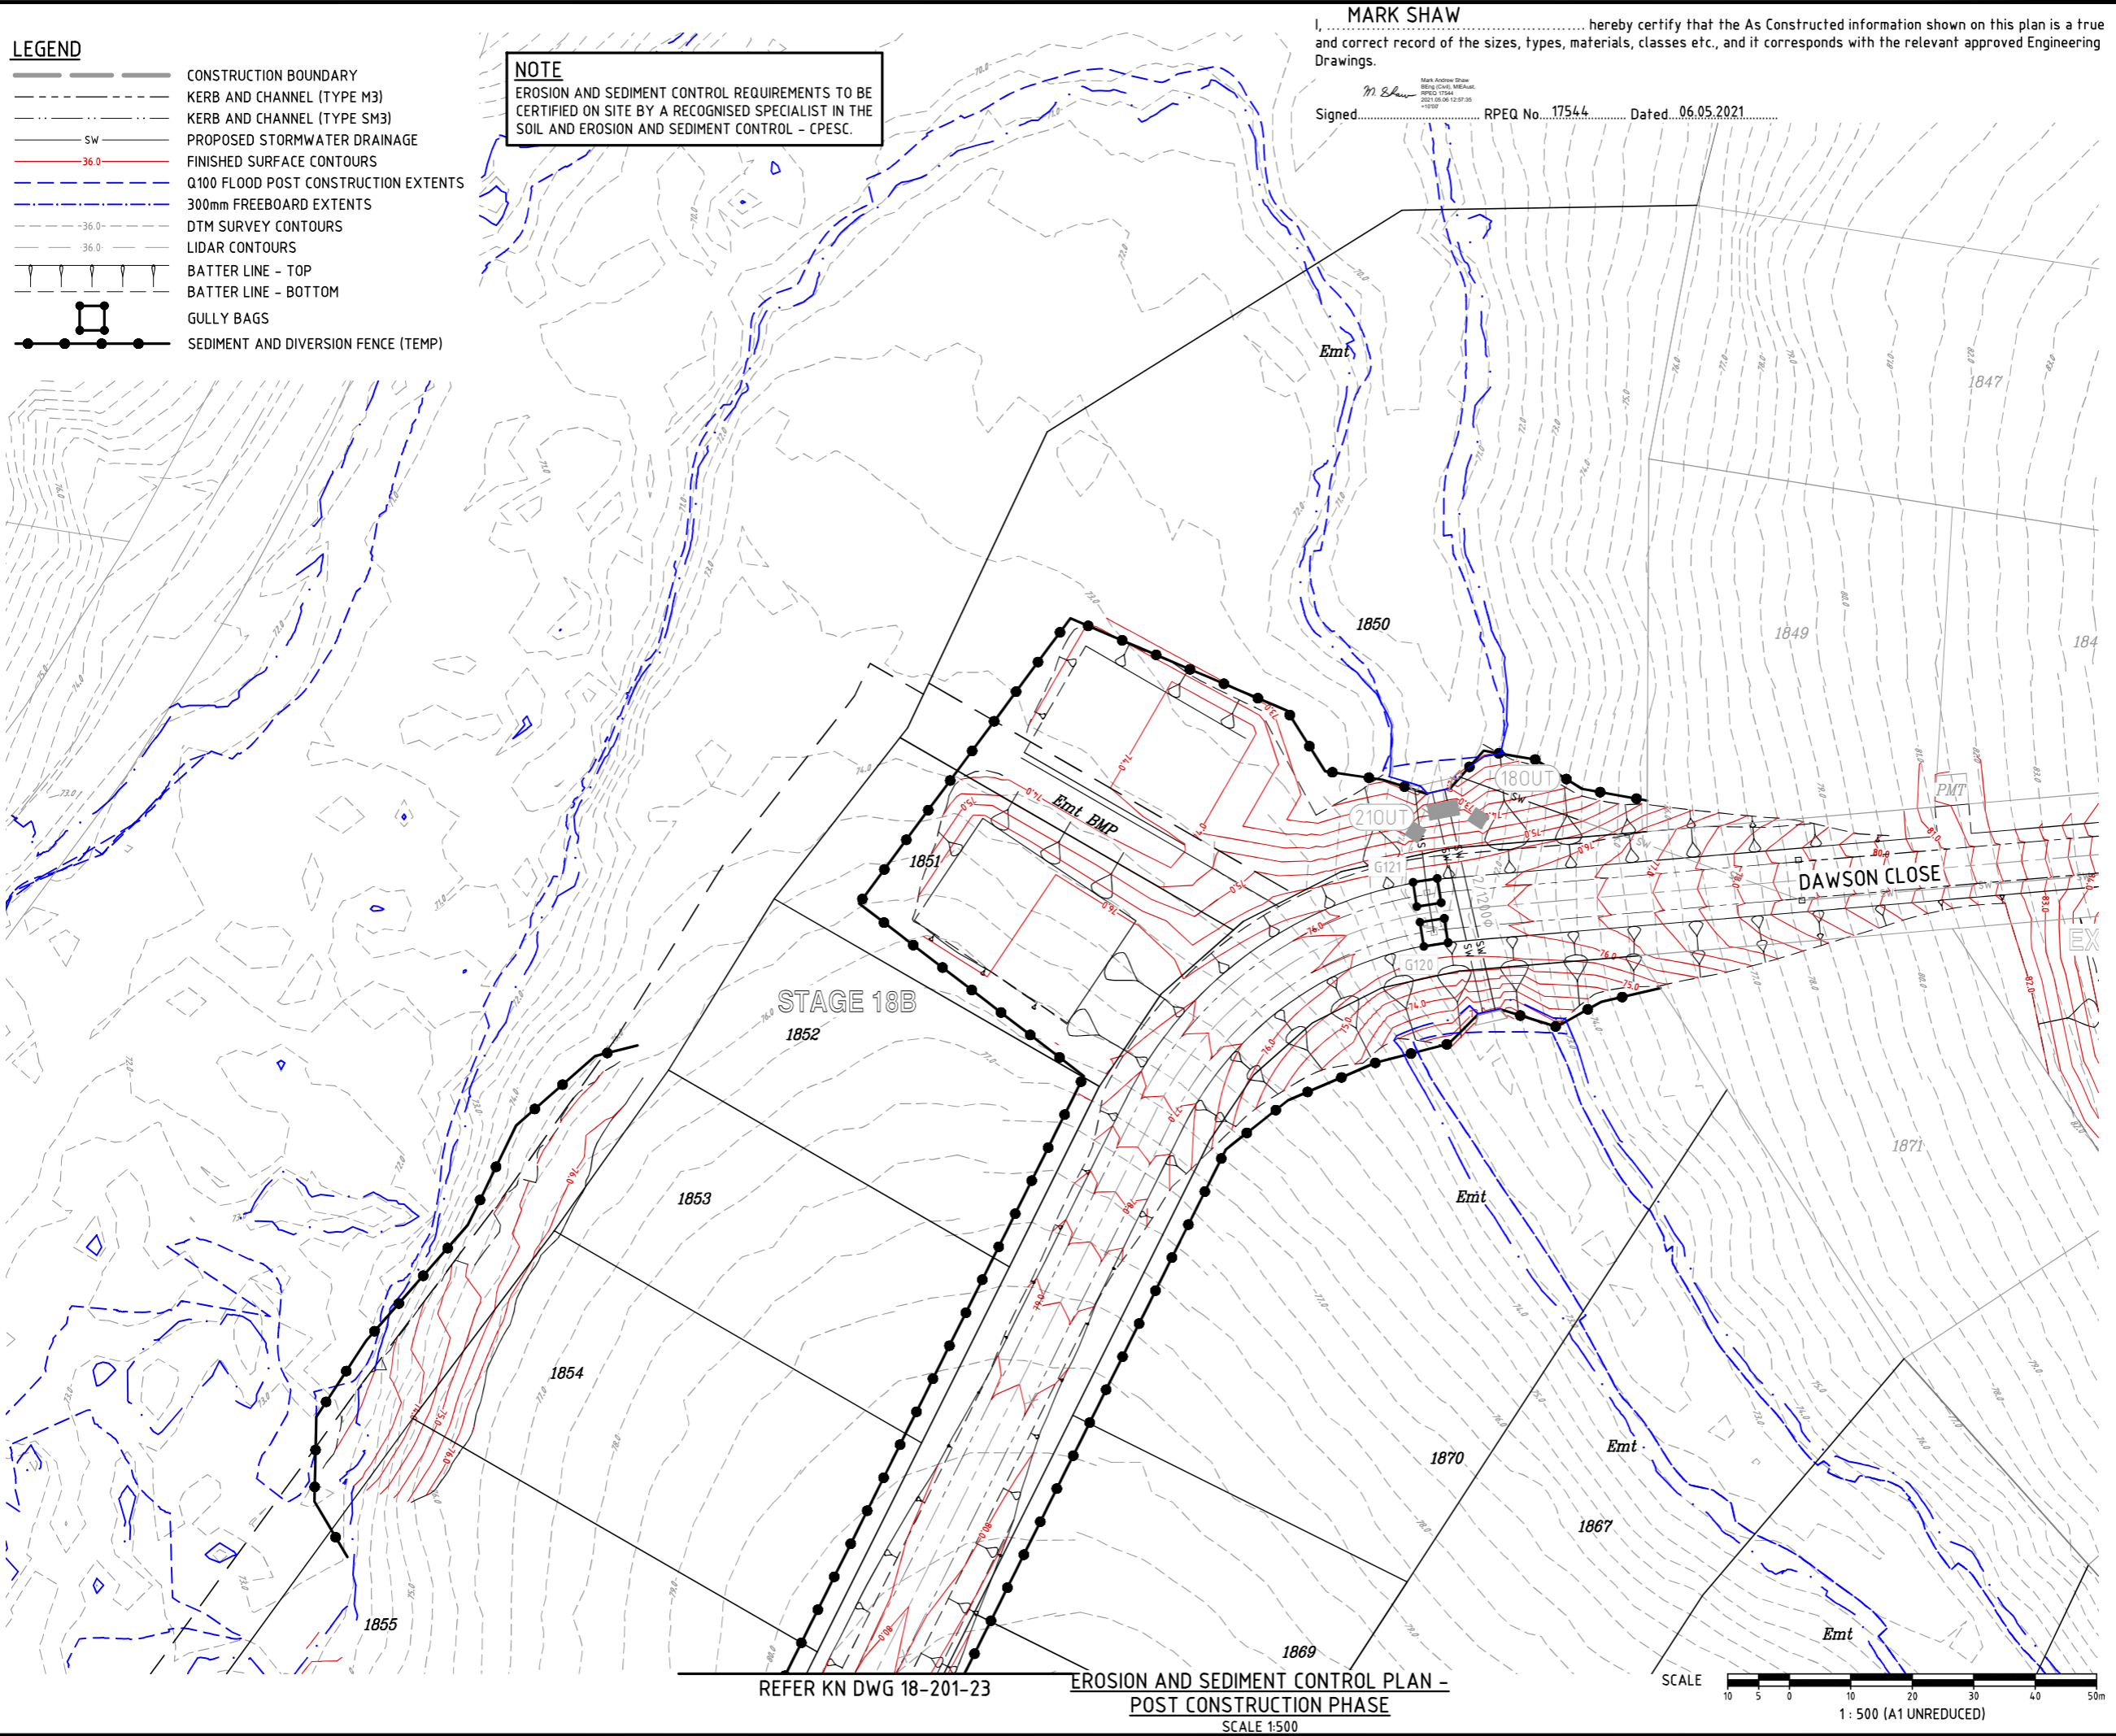

DO NOT SCALE THIS DRAWING IF IN DOUBT - ASK!



**LOCALITY PLAN**

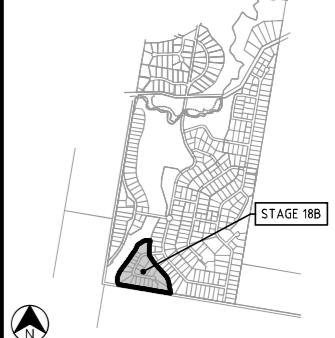

**REVISIONS**

No	Description	Date	By
A	ISSUED FOR APPROVAL	11/06/20	DES
B	NOTE ADDED	20/08/20	DES
C	REVISED LOTS / EASEMENT	23/09/20	DES
D	AS CONSTRUCTED FINAL	06/05/21	LMS

Client

**PEET**

Project

**SPRING MOUNTAIN  
 ACREAGE ESTATE  
 STAGE 18B**

OW/106/2020



ABN 35 112 53 611  
 L1, 62 Astor Tce  
 Spring Hill Q 4000  
 07 3017 1900  
[www.knigroup.com.au](http://www.knigroup.com.au)

Approved

Drawing Title  
**EROSION AND SEDIMENT CONTROL  
 LAYOUT PLAN  
 POST CONSTRUCTION PHASE - SHEET 1**

Drawn	Designed	Checked	Date
LMS	TE	GG	JUN 20
Scale	AS SHOWN		Sheet 22 of 33
A1	Drawing No 18-201-22	Revision D	


M:\2018\201 Spring Mountain Stage 18B\Engineering\Ascon\18-201-19-26-ES-GENERAL.dwg Printed by: DS on 6/05/2021 12:03:42 PM

REFER KN DWG 18-201-23  
**EROSION AND SEDIMENT CONTROL PLAN -  
 POST CONSTRUCTION PHASE**  
 SCALE 1:500

SCALE 1:500 (A1 UNREDUCED)

14/2018/18201 Spring Mountain Stage 18B Engineering\Ascon\18-201-19-26-ES-GENERAL.dwg Printed by: DS on 6/05/2021 12:03:46 PM


REFER KN DWG 18-201-22

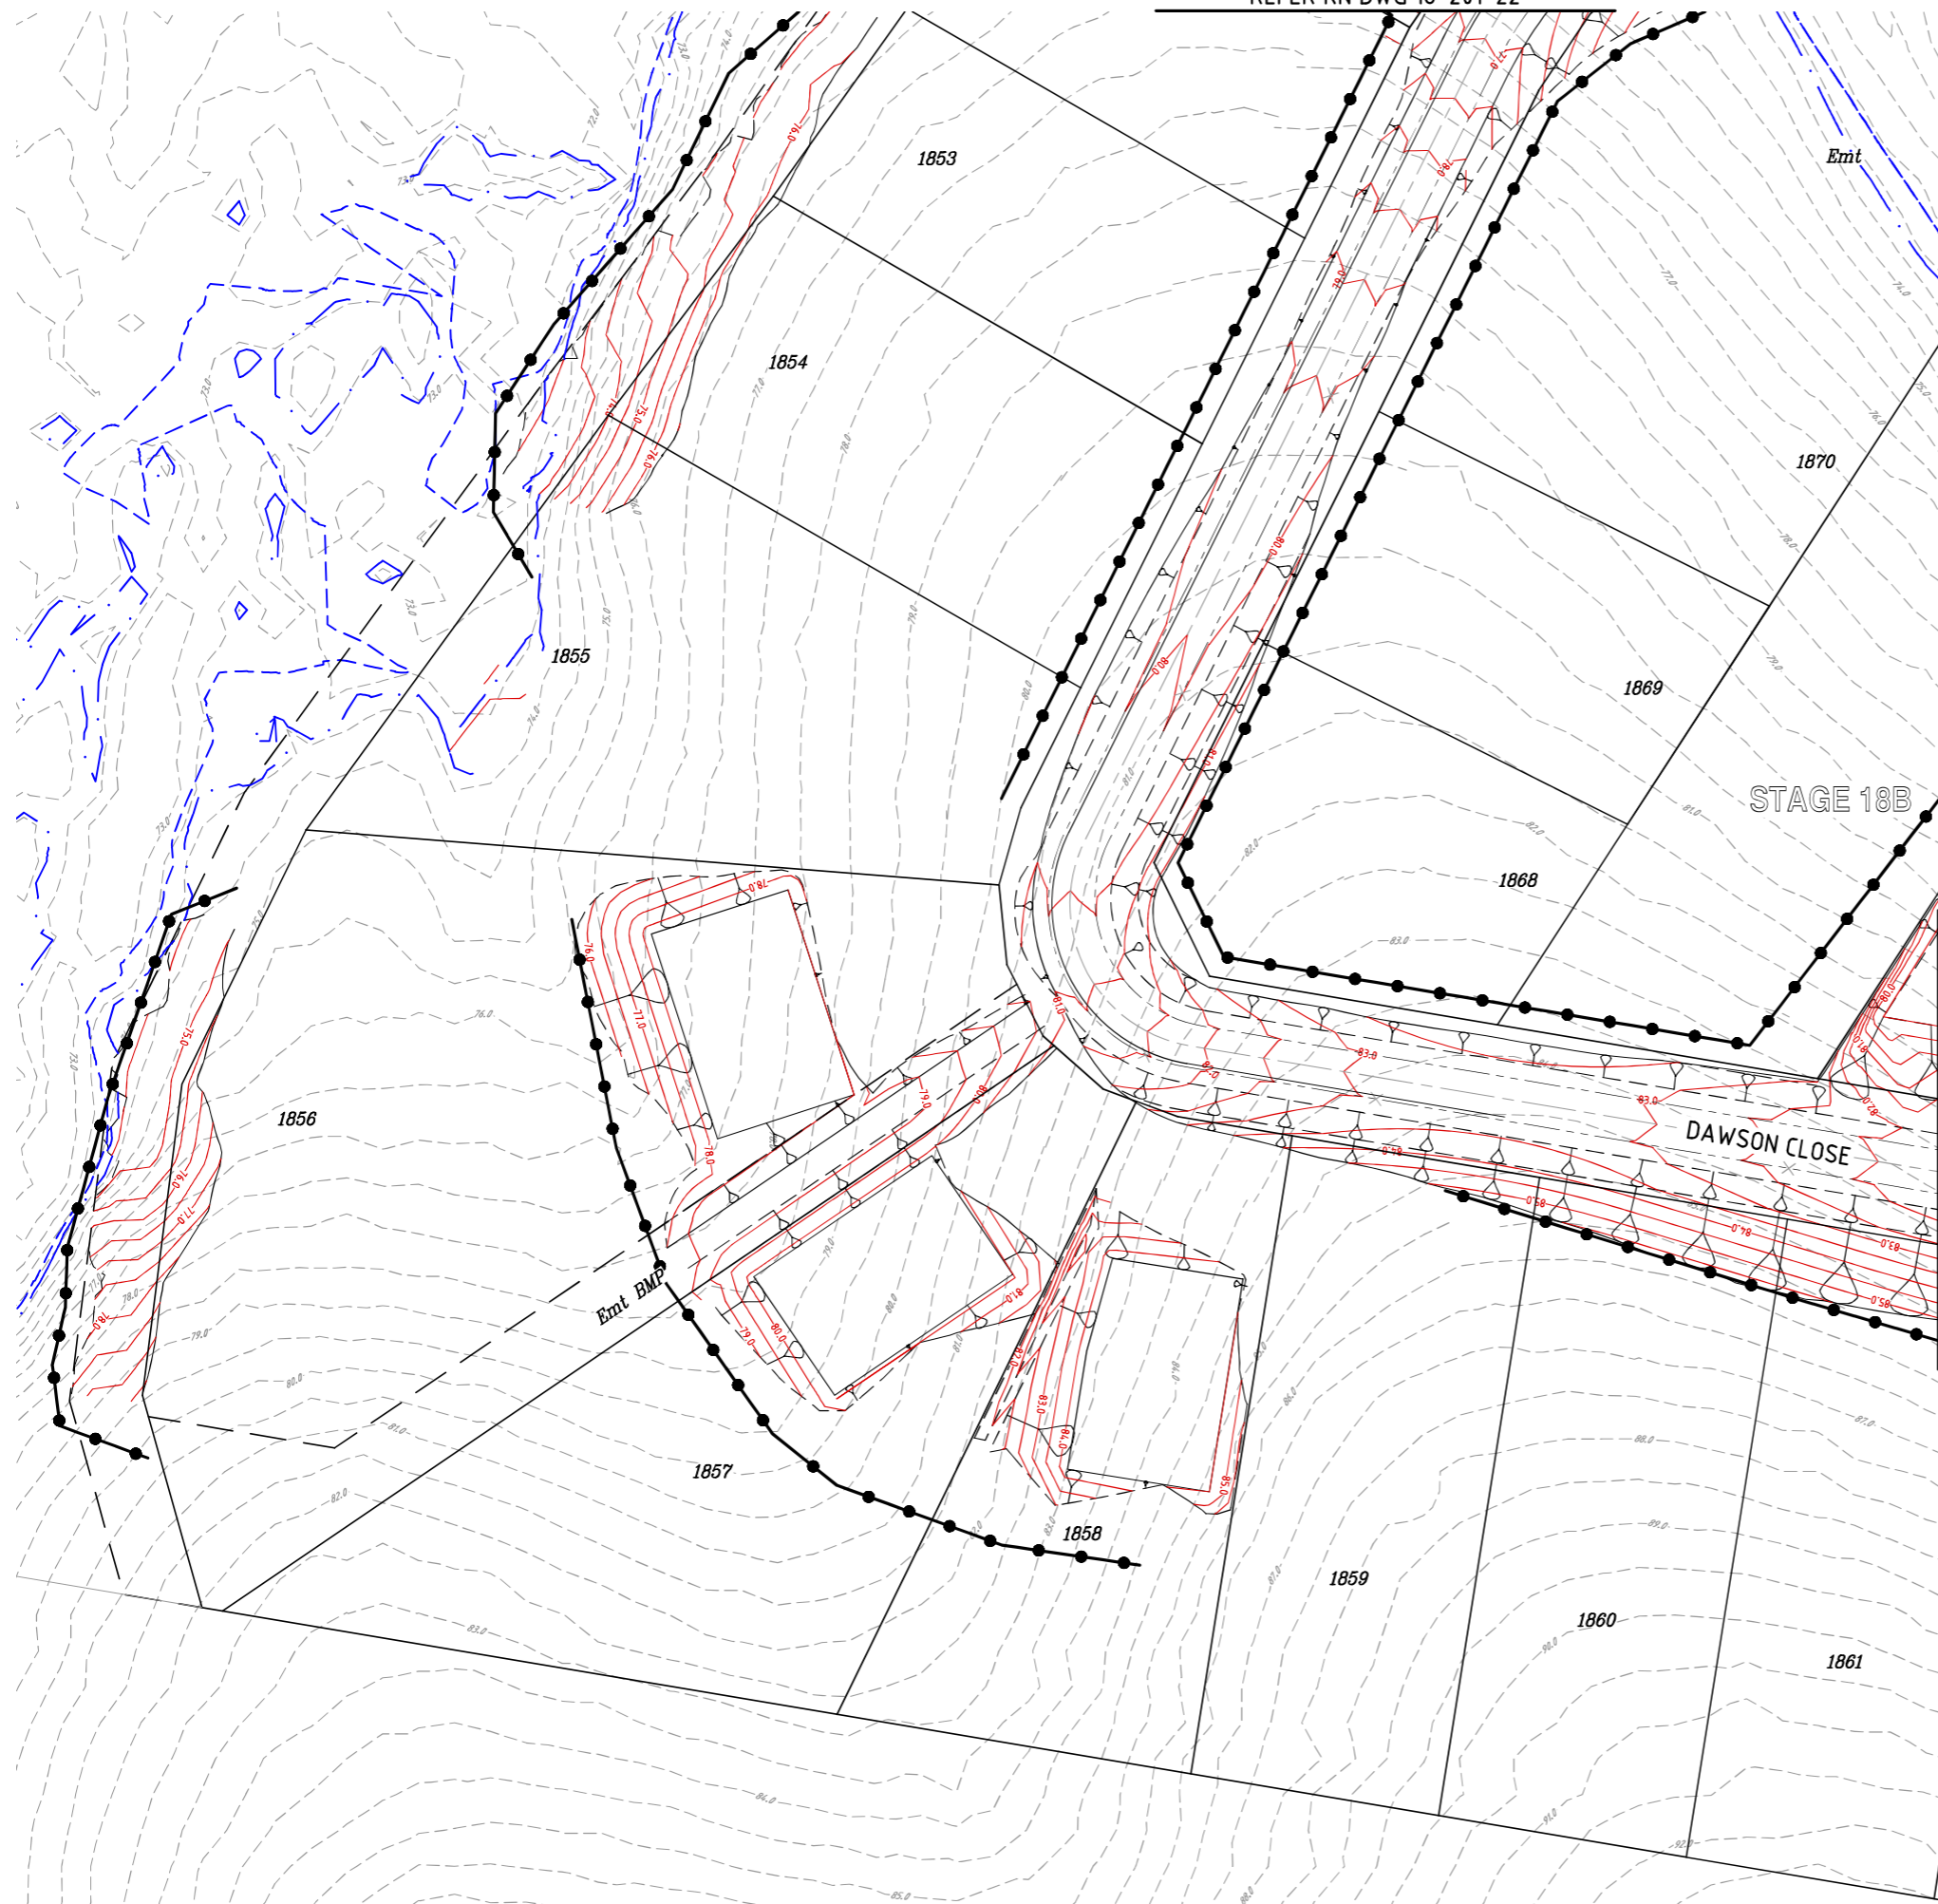

**EROSION AND SEDIMENT CONTROL PLAN -  
POST CONSTRUCTION PHASE**  
SCALE 1:500

**NOTE**  
EROSION AND SEDIMENT CONTROL REQUIREMENTS TO BE CERTIFIED ON SITE BY A RECOGNISED SPECIALIST IN THE SOIL AND EROSION AND SEDIMENT CONTROL - CPESC.

- LEGEND**
- CONSTRUCTION BOUNDARY
  - - - KERB AND CHANNEL (TYPE M3)
  - - - KERB AND CHANNEL (TYPE SM3)
  - Sw --- PROPOSED STORMWATER DRAINAGE
  - 36.0--- FINISHED SURFACE CONTOURS
  - 36.0--- Q100 FLOOD POST CONSTRUCTION EXTENTS
  - 36.0--- 300mm FREEBOARD EXTENTS
  - 36.0--- DTM SURVEY CONTOURS
  - 36.0--- LIDAR CONTOURS
  - BATTER LINE - TOP
  - BATTER LINE - BOTTOM
  - GULLY BAGS
  - SEDIMENT AND DIVERSION FENCE (TEMP)

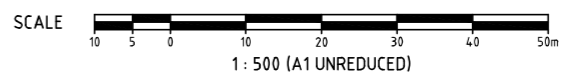


I, **MARK SHAW**, hereby certify that the As Constructed information shown on this plan is a true and correct record of the sizes, types, materials, classes etc., and it corresponds with the relevant approved Engineering Drawings.  
Signed..... RPEQ No. 17544..... Dated 06.05.2021.....

DO NOT SCALE THIS DRAWING  
IF IN DOUBT - ASK!




LOCALITY PLAN

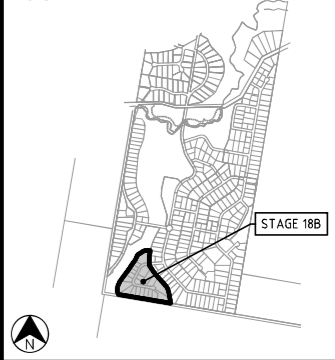

REVISIONS

No	Description	Date	By
A	ISSUED FOR APPROVAL	11/06/20	DES
B	NOTE ADDED	20/08/20	DES
C	REVISED LOTS / EASEMENT	23/09/20	DES
D	AS CONSTRUCTED FINAL	06/05/21	LMS

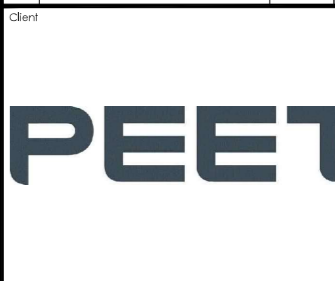

Project

**SPRING MOUNTAIN  
ACREAGE ESTATE  
STAGE 18B**

OW/106/2020



Approved

Drawing Title  
**EROSION AND SEDIMENT CONTROL  
LAYOUT PLAN  
POST CONSTRUCTION PHASE - SHEET 2**


Drawn LMS	Designed TE	Checked GG	Date JUN 20
Scale AS SHOWN	Drawing No 18-201-23	Sheet 23 of 33	Revision D



DO NOT SCALE THIS DRAWING  
IF IN DOUBT - ASK!



LOCALITY PLAN

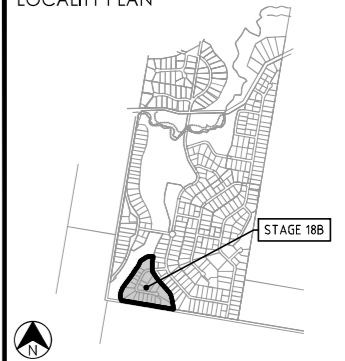

REVISIONS

No	Description	Date	By
A	ISSUED FOR APPROVAL	11/06/20	DES
B	NOTE ADDED	20/08/20	DES
C	AS CONSTRUCTED FINAL	06/05/21	LMS

Client

**PEET**

Project

**SPRING MOUNTAIN  
ACREAGE ESTATE  
STAGE 18B**


OW/106/2020



Approved

Drawing Title  
**EROSION AND SEDIMENT CONTROL  
LAYOUT PLAN  
POST CONSTRUCTION PHASE - SHEET 3**


Drawn LMS	Designed TE	Checked GG	Date JUN 20
Scale AS SHOWN	Drawing No 18-201-24		Sheet 24 of 33
A1		Revision C	

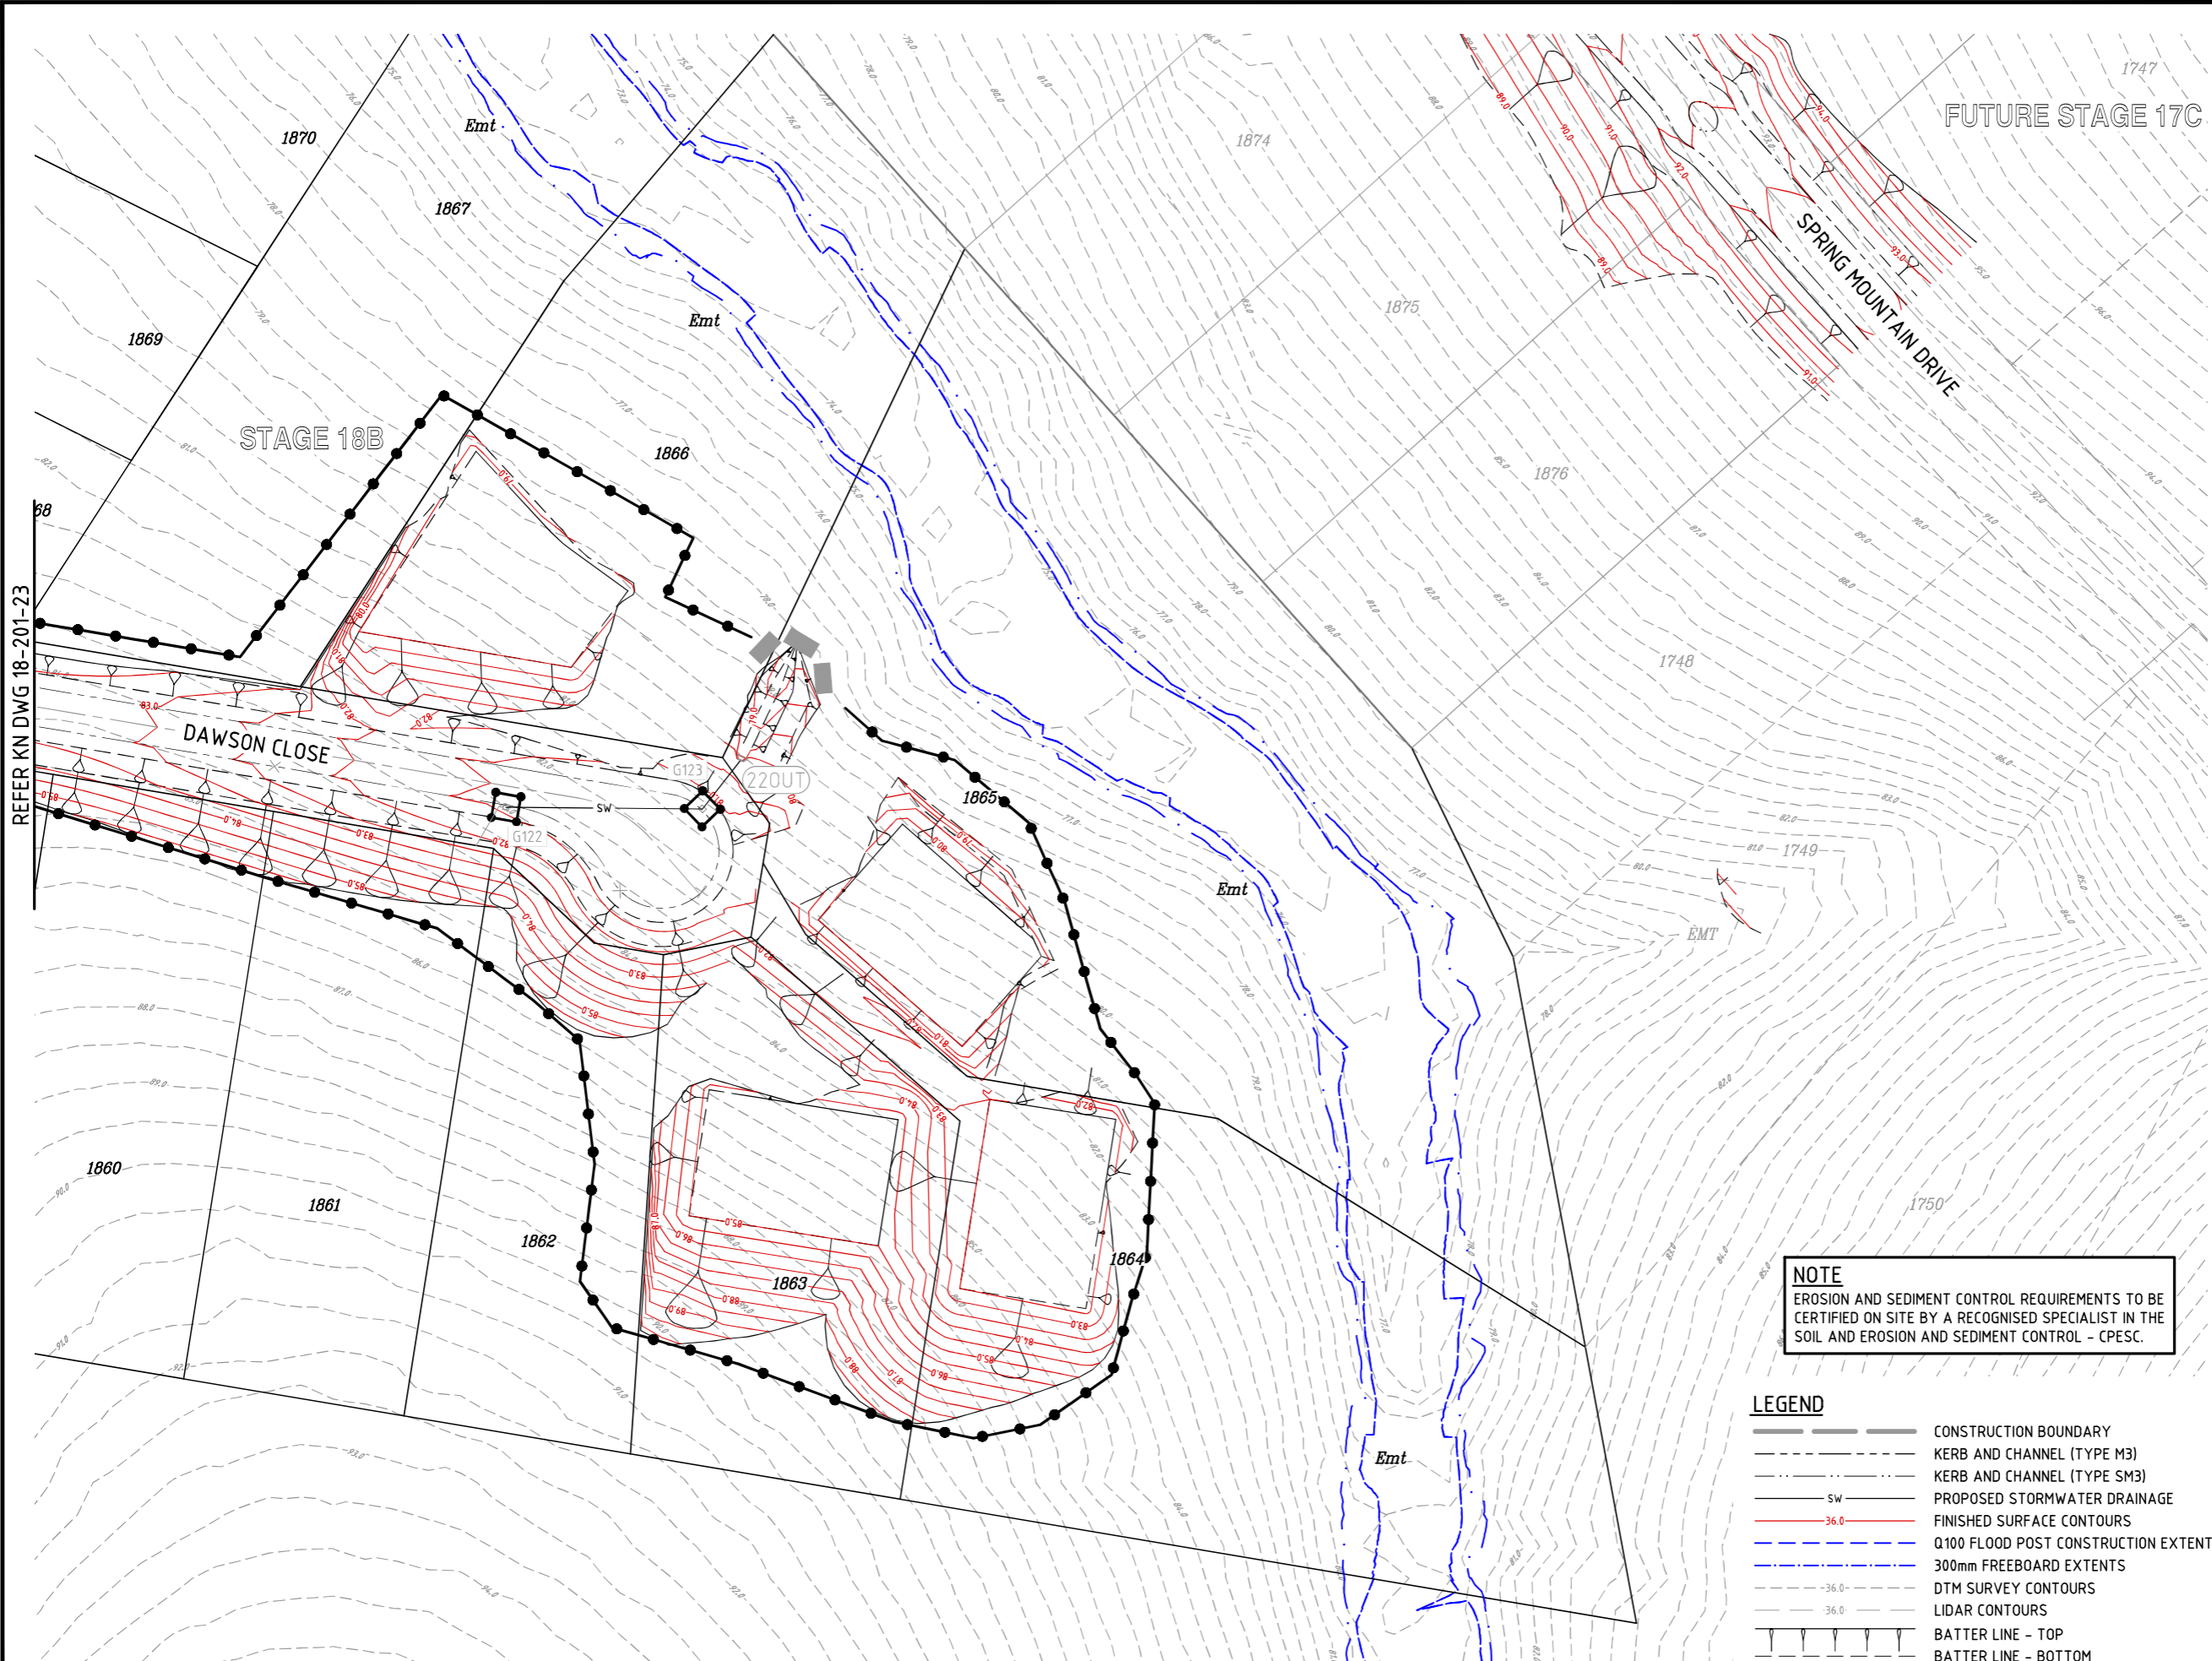

**NOTE**  
EROSION AND SEDIMENT CONTROL REQUIREMENTS TO BE  
CERTIFIED ON SITE BY A RECOGNISED SPECIALIST IN THE  
SOIL AND EROSION AND SEDIMENT CONTROL - CPESC.

**LEGEND**

- CONSTRUCTION BOUNDARY
- KERB AND CHANNEL (TYPE M3)
- KERB AND CHANNEL (TYPE SM3)
- SW PROPOSED STORMWATER DRAINAGE
- 36.0 FINISHED SURFACE CONTOURS
- Q100 FLOOD POST CONSTRUCTION EXTENTS
- 300mm FREEBOARD EXTENTS
- DTM SURVEY CONTOURS
- 36.0 LIDAR CONTOURS
- BATTER LINE - TOP
- BATTER LINE - BOTTOM
- GULLY BAGS
- SEDIMENT AND DIVERSION FENCE (TEMP)

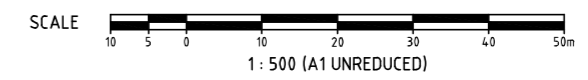

REFER KN DWG 18-201-23

11/20/18 18:20 Spring Mountain Stage 18B Engineering\Ascon\18-201-19-26-ES-GENERAL.dwg Plotted by: DS on 6/05/2021 12:03:59 PM

I, **MARK SHAW** hereby certify that the As Constructed information shown on this plan is a true and correct record of the sizes, types, materials, classes etc., and it corresponds with the relevant approved Engineering Drawings.

Signed *M. Shaw* RPEQ No. 17544 Dated 06.05.2021

**EROSION AND SEDIMENT CONTROL PLAN - POST CONSTRUCTION PHASE**  
SCALE 1:500



**EROSION AND SEDIMENT CONTROL PROGRAM**

- THIS PROGRAM AND ASSOCIATED PLANS SHOULD BE READ IN CONJUNCTION WITH THE SITE MANAGEMENT SPECIFICATION INCORPORATED IN THE CONTRACT DOCUMENTS. THE PROVISIONS OF THE SPECIFICATION ARE TO BE STRICTLY ADHERED TO.
- THE BASIC OBJECTIVES OF THE EROSION AND SEDIMENT CONTROL ARE:
  - IDENTIFY CRITICAL AREAS AND PROVIDE APPROPRIATE ATTENTION TO THOSE AREAS.
  - PLAN SITE LAYOUTS SO THAT ACCESS TO ALL REQUIRED DRAINAGE EROSION AND SEDIMENT CONTROL MEASURE IS MAINTAINED.
  - LIMIT EXPOSURE TIME BY PROGRAMMING TO MINIMISE THE AREA OF LAND EXPOSED TO POTENTIALLY ADVERSE WEATHER CONDITIONS AT ANY ONE TIME. I.E. PROGRESSIVELY CLEAR AND REVEGETATE.
  - PROVIDE CONTROL MEASURES INCLUDING TEMPORARY AND PERMANENT DRAINAGE, EROSION AND SEDIMENT CONTROLS.
- THE EROSION AND SEDIMENT CONTROL SHALL COMPLY WITH BEST PRACTICE FOR EROSION AND SEDIMENT CONTROL, THE POLLUTION CONTROL MANUAL FOR URBAN STORMWATER MANAGEMENT, THE QUEENSLAND URBAN DRAINAGE MANUAL, AND THE SOIL EROSION AND SEDIMENT CONTROL - ENGINEERING GUIDELINES FOR QUEENSLAND (CURRENT EDITIONS).
- CONSTRUCTION SEQUENCE THE CONSTRUCTION SEQUENCE WILL GENERALLY BE:
  - OBTAIN ALL NECESSARY PERMITS AND APPROVALS BEFORE SITE ESTABLISHMENTS.
  - HOLD A PRE-CONSTRUCTION CONFERENCE.
  - STABILISE ALL CONSTRUCTION ACCESS ROUTES AND ENTRY/EXIT POINTS.
  - ESTABLISH SEDIMENT CONTROL STRUCTURES AND TEMPORARY DRAINAGE CONTROL MEASURES AS NECESSARY.
  - CARRY OUT BULK EARTHWORKS.
  - MAINTAIN AND REPAIR DRAINAGE, EROSION AND SEDIMENT CONTROL MEASURES.
  - REMOVE SEDIMENT CONTROL MEASURES WHEN THE SITE IS STABILISED. I.E. >70% GROUND COVER
  - THE CONTRACTOR SHALL PREPARE A SUPPLEMENTARY EROSION AND SEDIMENT CONTROL PLAN TO SUIT HIS/HER CONSTRUCTION METHODOLOGY, AND SUBMIT THIS PLAN FOR APPROVAL TO THE SUPERINTENDENT. IT SHOULD BE NOTED THAT ANY SIGNIFICANT VARIATION TO THIS PLAN MAY REQUIRE RESUBMISSION TO COUNCIL FOR APPROVAL. THE CLIENT SHALL NOT BE RESPONSIBLE FOR ANY SUCH ASSOCIATED DELAY.
- ALL ESC DEVICES ARE TO BE INSPECTED WEEKLY, PRIOR TO EXPECTED AND AFTER RAINFALL ANY DAMAGE IS TO BE REPAIRED AS REQUIRED TO MAINTAIN THEIR EFFICACY.
- ALL TEMPORARY EROSION AND SEDIMENT CONTROL (ESC) MEASURE TO BE MAINTAINED AND FULLY OPERATIONAL DURING THE MAINTENANCE PERIOD AND ARE TO BE REMOVED AFTER THE SATISFACTORY COMPLETION OF AN OFF-MAINTENANCE INSPECTION BY COUNCIL AND PRIOR TO FORMAL ACCEPTANCE "OFF MAINTENANCE" BY COUNCIL.
- PRIOR TO THE COMMENCEMENT OF CONSTRUCTION, THE CONTRACTOR IS TO PROVIDE A DETAILED PROGRAM TO THE SUPERINTENDENT SHOWING THE TIMING FOR ALL WORKS ASSOCIATED WITH THE PROJECT, NOMINATING, IN PARTICULAR, THE PROGRAM FOR INSTALLATION OF SOIL AND EROSION CONTROL SYSTEMS.
- EARTHWORKS SHALL BE CARRIED OUT IN SUCH A MANNER THAT THE SITE IS MAINTAINED IN A WELL DRAINED CONDITION, AREAS OF LOOSE SOIL ARE MINIMISED AND CONCENTRATIONS OF STORMWATER ARE MINIMISED. BULK EARTHWORKS WILL BE CARRIED OUT OVER THE ENTIRE SITE IN ONE STAGE.
- A SHAKE DOWN AS DETAILED ON THE PLAN COMPRISING FREE DRAINAGE GRAVEL SHALL BE LOCATED ADJACENT TO THE POINT OF ACCESS WHERE VEHICLES CAN BE WASHED DOWN PRIOR TO EXIT TO THE STREET SYSTEM IF REQUIRED. THE WASH DOWN AREA SHALL BE KEPT FREE OF MUD.
- FOR DETAILS OF ENTRY/EXIT SEDIMENT PAD REFER TO BEST PRACTICE EROSION & SEDIMENT CONTROL BOOK 1, PAGE 2.48, FIGURE 2.6.
- SUPPLEMENTARY EROSION AND SEDIMENT CONTROL DEVICES MAY BE REQUIRED AT THE DISCRETION OF THE SUPERINTENDENT.
- SEDIMENTATION FENCES TO BE PLACED AS SHOWN. FOR DETAILS OF SEDIMENT FENCE REFER BEST PRACTICE EROSION & SEDIMENT CONTROL BOOK 1, PAGE 2.50, FIGURE 2.8.
- WHERE SEDIMENT FENCES ARE SHOWN TO BE CONSTRUCTED IN AREAS OF SIGNIFICANT EARTHWORKS, ERECTION OF THE FENCE MAY BE DEFERRED UNTIL COMPLETION OF THE BULK EARTHWORKS, SUBJECT TO ABSENCE OF RAIN.

**TREES**

- ENSURE COMPLIANCE WITH THE REQUIREMENTS OF AS4970 - TREES ON CONSTRUCTION SITES. THIS MAY REQUIRE CONSULTATION AND GUIDANCE FROM A CLASS V CERTIFIED ARBORIST AS TREES OUTSIDE THE IMMEDIATE WORK AREA MAY BE AFFECTED.

**MARK SHAW**

I, **MARK SHAW** hereby certify that the As Constructed information shown on this plan is a true and correct record of the sizes, types, materials, classes etc., and it corresponds with the relevant approved Engineering Drawings.

Signed: *M. Shaw* Mark Andrew Shaw  
 18EGD 17544  
 2021/05/06 12:58:10  
 +1050 RPEQ No. 17544 Dated. 06.05.2021

**EROSION AND SEDIMENT CONTROL NOTES**

- NO DISTURBED AREA IS TO REMAIN DENUDED LONGER THAN 60 DAYS.
- ALL EROSION AND SILTATION CONTROL MEASURES ARE TO BE PLACED PRIOR TO OR AS THE FIRST STEP IN CLEARING AND GRUBBING OR ANY OTHER EARTHWORKS OR TRENCHING.
- ALL STORMWATER, SEWER LINE AND SERVICES TRENCHES NOT IN STREETS ARE TO BE MULCHED AND SEEDED WITHIN 15 DAYS AFTER BACKFILL, NO MORE THAN 150 METRES ARE TO BE OPEN AT ANY ONE TIME.
- ALL TEMPORARY EARTH BANKS, DIVERSIONS AND SEDIMENT DAM EMBANKMENTS ARE TO BE MACHINE-COMPACTED, SEEDED AND MULCHED FOR TEMPORARY VEGETATIVE COVER WITHIN 10 DAYS AFTER GRADING. STRAW OR HAY MULCH IS REQUIRED.
- ALL FILL EMBANKMENTS ARE TO BE LEFT WITH A LIP AT THE TOP OF THE SLOPE AT THE END OF EACH DAYS OPERATION.
- ALL CUT AND FILL BATTERS ARE TO BE SEEDED AND MULCHED WITHIN 10 DAYS OF COMPLETION OF GRADING.
- ADDITIONAL SILT AND EROSION CONTROLS MAY BE REQUIRED AS ORDERED ON SITE BY THE SUPERVISING ENGINEER.
- ALL CONTROLS ARE TO BE INSPECTED AFTER EACH STORM EVENT AND MAINTAINED AS REQUIRED. CONTROLS ARE TO BE MAINTAINED UNTIL THE DISTURBED AREAS ARE PERMANENTLY STABILIZED OR UNTIL NO LONGER REQUIRED.

**PHASE 1 - CLEARING AND BULK EARTHWORKS**

CONSTRUCT AND MAINTAIN SILT FENCES, STRAW BALE TRAPS, ALLOTMENT DRAINAGE BANKS, CATCH DRAINS AND HYDROMULCHING WHICH CONTROL SEDIMENT AND EROSION DURING CLEARING AND BULK EARTHWORKS.

**PHASE 2 - TRENCH EXCAVATION**

CONSTRUCT AND MAINTAIN SILT FENCES, STRAW BALE TRAPS, ALLOTMENT DRAINAGE BANKS AND CATCH DRAINS WHICH CONTROL SEDIMENTATION AND EROSION DURING TRENCHING WORK.

**PHASE 3 - PAVEMENT CONSTRUCTION**

CONSTRUCT AND MAINTAIN SILT FENCES, STRAW BALE TRAPS, ALLOTMENT DRAINAGE BANKS, GULLY INLET PROTECTION, AND PIPE INLET/OUTLET PROTECTION WHICH CONTROL SEDIMENTATION AND EROSION DURING PAVEMENT CONSTRUCTION. SAND BAGGING TO BE PLACED ACROSS PAVEMENT TO CONTROL RUNOFF IN PAVEMENT BOXING AS DIRECTED ON SITE.

**PHASE 4 - MAINTENANCE PERIOD**

CONSTRUCT AND MAINTAIN CONTROLS AND VEGETATIVE TREATMENTS WHICH CONTROL SEDIMENTATION AND EROSION PRIOR TO THE ESTABLISHMENT OF GRASS COVER. PROVIDE 600mm WIDE GRASS FILTER STRIPS BEHIND KERB AND CHANNEL.

NOTE: TURF TREATMENT IN CERTAIN AREAS BY LANDSCAPER. REFER TO LANDSCAPE DRAWING.

**NOTE**

ALL VEHICLES EXITING FROM THE SITE ARE TO BE CLEANED AND TREATED TO PREVENT MATERIAL BEING TRACKED OR DEPOSITED ONTO PUBLIC ROADS. IF MATERIAL IS ACCIDENTLY DEPOSITED ONTO PUBLIC ROADS IT SHALL BE REMOVED WITHOUT DELAY. IF THE SHAKEDOWN DEVICE PROVES TO BE INEFFECTIVE THE CONTRACTOR IS TO USE OTHERS MEANS TO PREVENT MATERIAL BEING DEPOSITED ONTO PUBLIC ROADS.

**TOPSOIL**

- STRIP AND STOCKPILE AVAILABLE TOPSOIL (ASSUMED AVERAGE DEPTH 150mm) FROM ALL DISTURBED AREAS PRIOR TO BULK EARTHWORKS. GRADE EVENLY BETWEEN ALLOTMENT FINISHED SURFACE LEVELS AND ENSURE LOTS ARE FREE DRAINING.
- MINIMUM SLOPE ACROSS ALLOTMENTS TO BE 1%.
- ALL FOOTPATHS, BATTERS, AND EARTHWORKS AFFECTED ALLOTMENTS ARE TO BE TOPSOILED TO A MINIMUM DEPTH OF 150mm (LIGHTLY COMPACTED) AND TURFED WHERE SPECIFIED.

**SEDIMENT FENCES**

- SEDIMENT FENCES TO BE PLACED AS SHOWN. SEDIMENT FENCED TO BE REPAIRED AND EXCESSIVE SEDIMENT DEPOSITS SHALL BE REMOVED ONCE CAPACITY FALLS BELOW 75%.
- FOR DETAILS OF SEDIMENT FENCE REFER BEST PRACTICE EROSION & SEDIMENT CONTROL BOOK 1, PAGE 2.50, FIGURE 2.8.
- SEDIMENT FENCES TO BE REPAIRED AS REQUIRED AND EXCESSIVE SEDIMENT DEPOSITS SHOULD BE REMOVED.
- INSTALL KERB INLETS WITH GRAVEL RANGING FROM 50mm TO 75mm IN SIZE SHALL BE INSTALLED AT ALL COMPLETED INLETS. REFER IPWEAQ STANDARD DRAWING D-004.1. THESE SHALL BE MAINTAINED IN A CLEAN CONDITION. IN THE EVENT OF HEAVY RAIN THEY SHALL BE REMOVED TO MINIMISE THE POTENTIAL FOR FLOODING.
- CHECKS OF SILT CONTROL DEVICES ARE TO BE MADE WEEKLY, OR AFTER ANY SIGNIFICANT STORM EVENT TO ENSURE INTEGRITY AND PERFORMANCE.

**TURFING**

- PROVIDE TURFING TO ENTIRE WIDTH OF ALL SWALES, FOOTPATHS AND 1 IN 4 CUT AND FILL BATTERS.
- FOOTPATH BATTERS ARE TO BE STABILISED WITH TOPSOIL (AND TURFED) AS SOON AS PRACTICAL AFTER THE BATTERS HAVE BEEN COMPLETED.

**DURING CONSTRUCTION SEQUENCE:**

- TOPSOIL STOCKPILES SHALL BE LESS THAN 1m DEEP AND UNCOMPACTED. A SEDIMENTATION FENCE SHALL BE CONSTRUCTED ON THE D/S SIDE, OR THE STOCKPILE STABILISED WITH VEGETATION, MULCH, OR A SOIL STABILISER.
- SEDIMENTATION FENCES TO BE PLACED AS SHOWN.
- REGULARLY INSPECT BANKS AND REPAIR ANY SLUMPS, WHEEL TRACK DAMAGE OR LOSS OF FREEBOARD.
- REMOVE SEDIMENT TO AVOID PONDING FROM CATCH DRAINS.
- REMOVE EXCESSIVE SEDIMENT FROM UPSTREAM OF CHECK DAM.
- ROAD RESERVE TO BE USED AS HAUL ROAD.
- A CATCH DRAIN OR DIVERSION BANK IS TO BE PROVIDED ON THE TOP SIDE OF ALL CUTS, WITH DISCHARGE EITHER TO UNDISTURBED GRASS LANDS OR TO THE CROSS ROAD DRAINAGE.
- SUPPLEMENTARY EROSION AND SEDIMENT CONTROL DEVICES MAY BE REQUIRED AT THE DISCRETION OF THE ENGINEER.
- WATER QUALITY SAMPLES MUST BE TAKEN AND ANALYSED PRIOR TO THE RELEASE OF ANY WATER FROM THE SEDIMENT POND. WATER QUALITY MUST SATISFY THE FOLLOWING CRITERIA: TSS-50MG/L PH BETWEEN 6.5 AND 8.5.
- ALL WATER QUALITY DATA INCLUDING DATES OF RAINFALL, TESTING AND WATER RELEASE MUST BE MAINTAINED IN AN ON-SITE REGISTER. THIS REGISTER IS TO BE MAINTAINED FOR THE DURATION OF THE APPROVED WORKS AND BE AVAILABLE ON SITE FOR INSPECTION BY COUNCIL OFFICERS ON REQUEST.
- EXPOSED AREAS ON LOTS ARE TO BE SEEDED AND MULCHED (E.G. HYDROMULCHED). MULCH SHALL BE APPLIED AT A MINIMUM RATE OF 2.5T/HA. ALTERNATIVELY THEY SHALL BE DRILL-SEEDED AND IRRIGATED SO AS TO ENSURE >70% GROUND COVER WITHIN 14 DAYS FROM NOVEMBER TO APRIL, OR 30 DAYS FROM MAY TO OCTOBER.

**FOLLOWING CONSTRUCTION:**


- SEDIMENTATION FENCES TO BE MAINTAINED UNTIL TURFING IS COMPLETED.
- SEDIMENT BASINS TO BE CHECKED AFTER EVERY SIGNIFICANT STORM AND DESILTED ONCE THE SETTLEMENT LIMIT HAS BEEN REACHED.

**STABILISATION:**

- THE AMOUNT OF AREA EXPOSED AT ANY ONE TIME TO BE MINIMISED BY STAGING THE WORKS WHEREVER POSSIBLE AND AIMING TO ACHIEVE FINISHED LEVEL IN EACH AREA AS QUICKLY AS POSSIBLE BEFORE OPENING NEW AREAS.
- TOPSOIL TO BE STRIPPED AND STOCKPILED SEPARATELY TO SUB-SOILS.
- STOCKPILES TO BE PROVIDED WITH SURFACE COVER USING A CHEMICAL SURFACE STABILISER SUCH AS VITAL CHEMICALS VITAL-BON MATT STONEWALL.
- IF WORKS ARE DELAYED OR PUT ON HOLD THEN TEMPORARY EROSION CONTROL COVERING TO BE PROVIDED USING VITAL CHEMICALS VITAL-BON MATT P47-VR1 OR EQUIVALENT.
- ONCE AREAS REACH FINISHED LEVEL:
  - TOPSOIL TO BE SPREAD TO CAP/BURY THE DISPERSIVE SUBSOILS.
  - TOPSOIL TO BE DRILL-SEEDED WITH A MIXTURE OF ANNUAL AND PERENIAL GRASS SPECIES (REFER TABLE) AND FERTILISER WITH CROP-KING 88 (0.3t/Ha).
  - TEMPORARY SOIL COVER TO BE APPLIED CONSISTING OF VITAL CHEMICALS VITAL-BON MATT P47-VR1 OR EQUIVALENT.
  - WATERING UNDERTAKEN AS NECESSARY UNTIL STABLE GRASS SURFACE COVER IS ESTABLISHED.

SEED MIXES			
	SUMMER BLEND (APPLICATIONS NOVEMBER - DECEMBER)	MID SEASON BLEND (APPLICATIONS MARCH/APRIL & SEPTEMBER/OCTOBER)	WINTER BLEND (APPLICATIONS MAY AUGUST)
UNHULLED GREEN COUCH (CYNODON DACTYLON) OR BLUE COACH (DIGITARIA DIDACYLA)	25%	25%	25%
HULLED GREEN COUCH (CYNODON DACTYLON) OR BLUE COACH (DIGITARIA DIDACYLA)	25%	25%	25%
JAPANESE MILLET	30%	15%	N/A
RYE GRASS	N/A	15%	30%
CARPET GRASS (AXONOPUS AFFINIS)	20%	20%	20%

LOCALITY PLAN

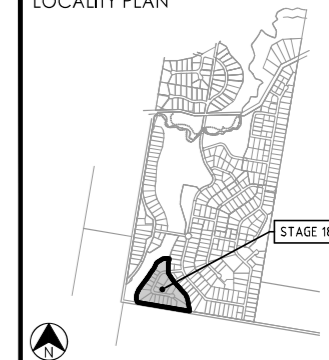

REVISIONS

No	Description	Date	By
A	ISSUED FOR APPROVAL	11/06/20	DES
B	AS CONSTRUCTED FINAL	06/05/21	LMS

Client

**PEET**

Project

**SPRING MOUNTAIN**  
ACREAGE ESTATE  
STAGE 18B

OW/106/2020

**kn group**  
 ABN 35 112 53 611  
 L1, 62 Astor Tce  
 Spring Hill Q 4000  
 07 3017 1900  
 www.knigroup.com.au

Approved












Drawing Title  
**EROSION AND SEDIMENT CONTROL  
NOTES**

Drawn LMS	Designed TE	Checked GG	Date JUN 20
Scale AS SHOWN	Sheet 25 of 33		Revision B
Drawing No 18-201-25			

M:\2018\18201 Spring Mountain Stage 18B\Engineering\Ascon\18-201-19-26-ES-GENERAL.dwg Plotted by: DS on 6/05/2021 12:03:51 PM



DO NOT SCALE THIS DRAWING  
IF IN DOUBT - ASK!

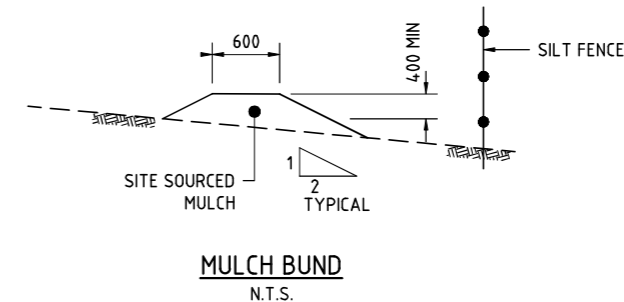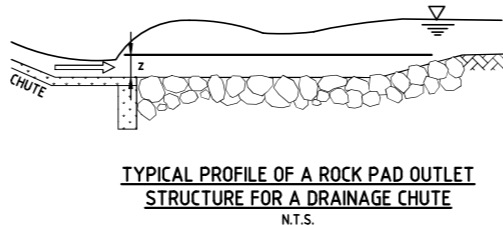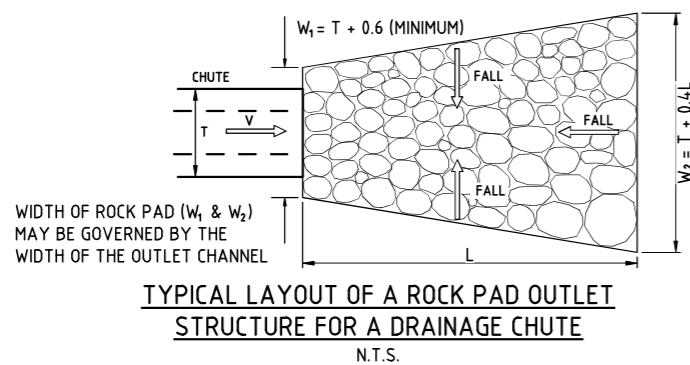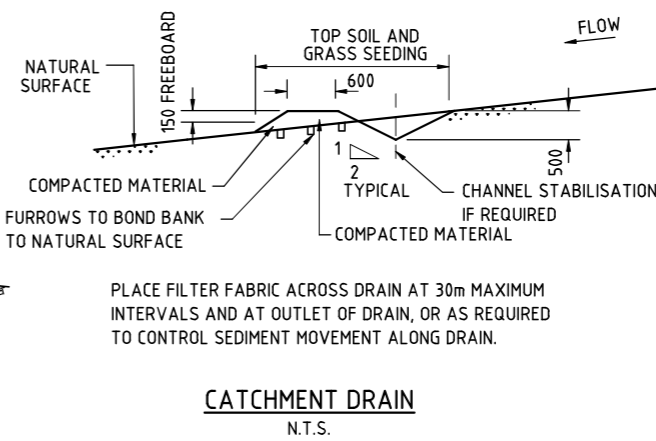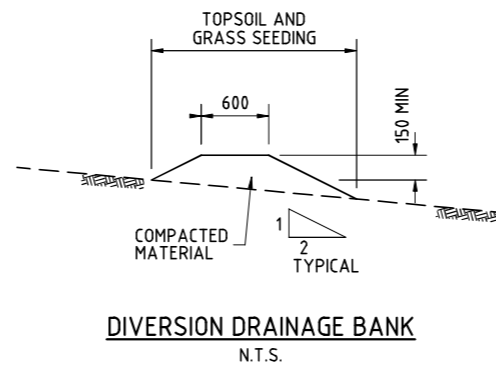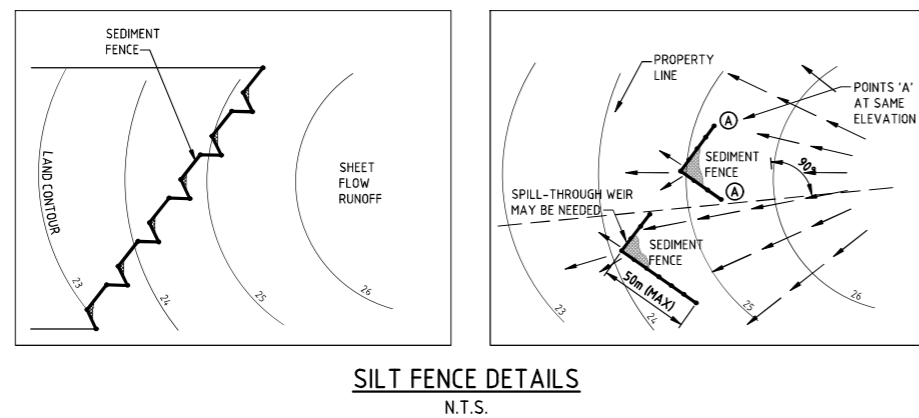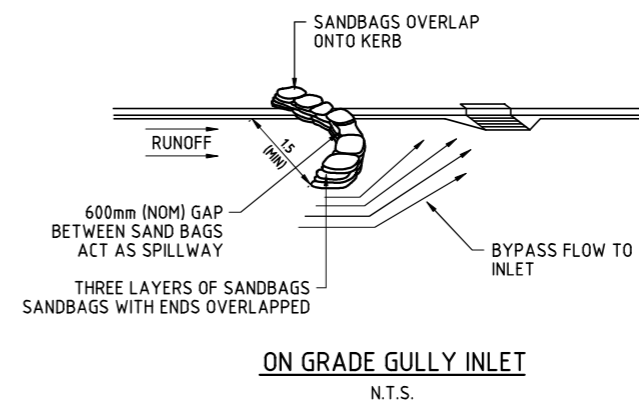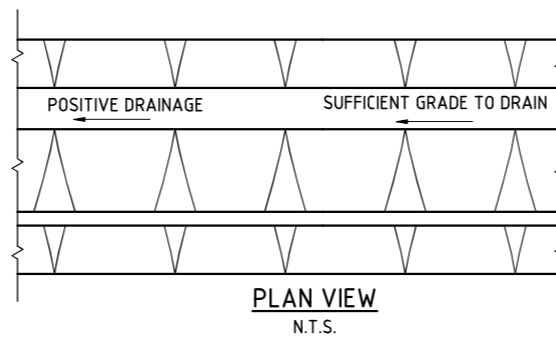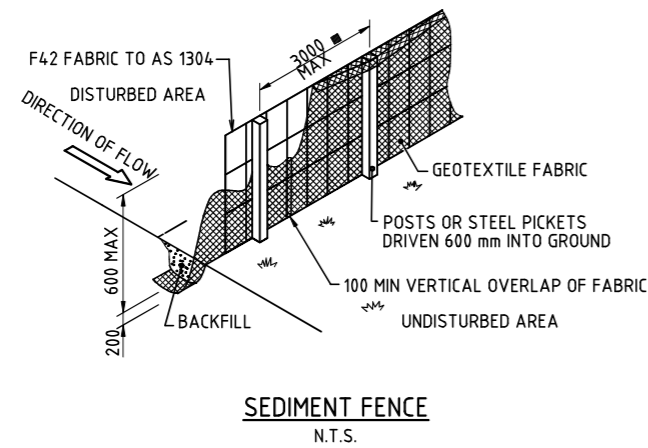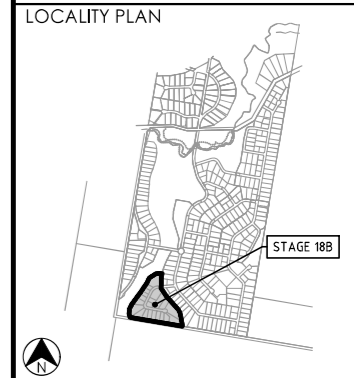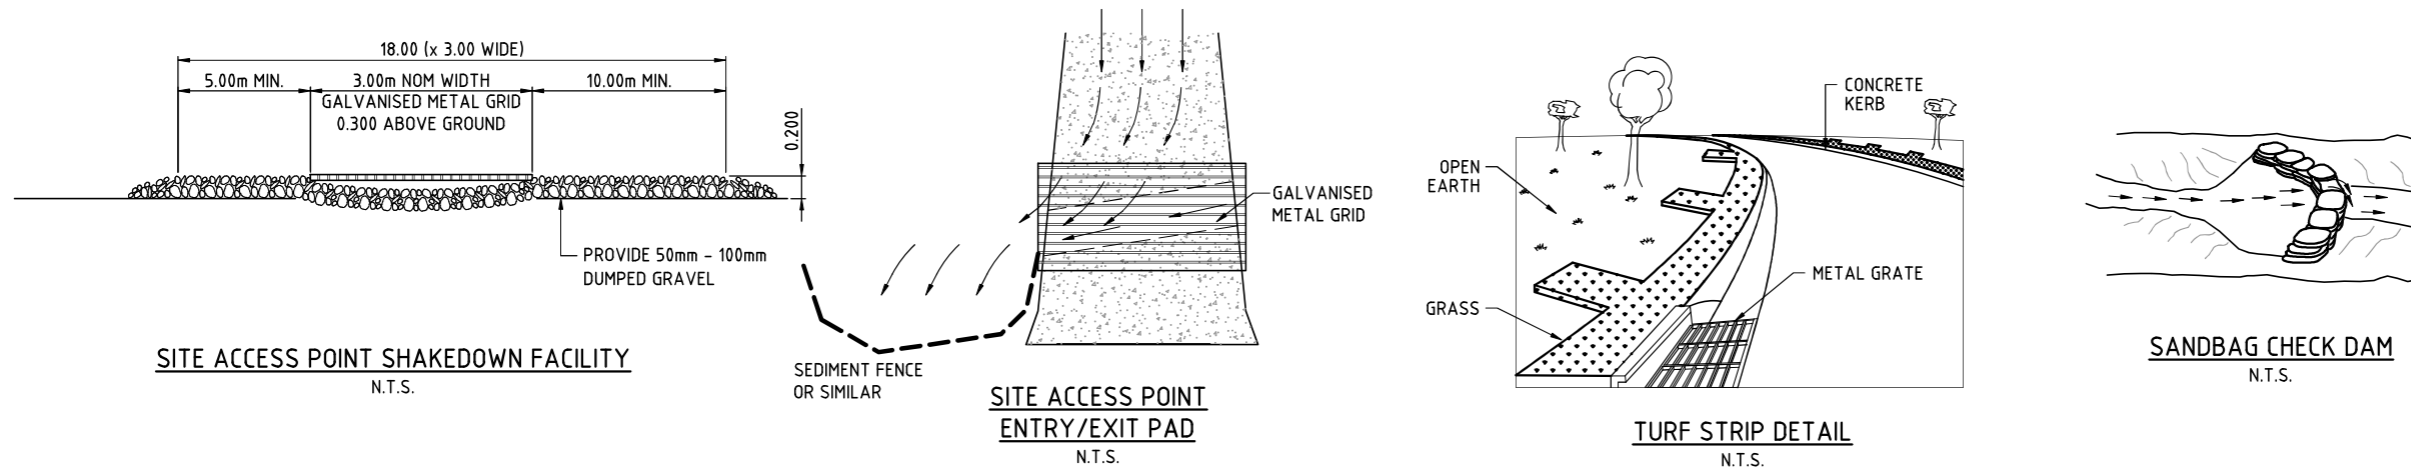

REVISIONS

No	Description	Date	By
A	ISSUED FOR APPROVAL	11/06/20	DES
B	AS CONSTRUCTED FINAL	06/05/21	LMS

Client

# PEET

Project

**SPRING MOUNTAIN  
ACREAGE ESTATE  
STAGE 18B**

OW/106/2020

Approved

ABN 35 112 53 611  
L1, 62 Astor Tce  
Spring Hill Q 4000  
07 3017 1900  
www.kngroup.com.au

Drawing Title

**EROSION AND SEDIMENT CONTROL  
DETAILS**

Drawn	Designed	Checked	Date
LMS	TE	GG	JUN 20

Scale	Sheet
AS SHOWN	26 of 33

Revision No	Revision
A1	B

I, **MARK SHAW** hereby certify that the As Constructed information shown on this plan is a true and correct record of the sizes, types, materials, classes etc., and it corresponds with the relevant approved Engineering Drawings.

Signed: RPEQ No. 17544 Dated: 06.05.2021

M:\2018\18201 Spring Mountain Stage 18B Engineering\Ascon\18-201-19-26-ES-GENERAL.dwg Printed by: DS on 6/05/2021 12:03:51 PM

**NOTE**

- ALL LIVE CONNECTIONS TO EXISTING MAINS TO BE UNDERTAKEN BY LOGAN WATER AT DEVELOPERS COST
- WATER SERVICE CONDUITS MUST MAINTAIN MINIMUM CLEARANCES AS PER TABLE 5.5 OF THE SEQ D&C CODE

**LEGEND**

	CONSTRUCTION BOUNDARY
	PROPOSED Ø100 WATER MAIN
	PROPOSED DN63 PE WATER MAIN
	PROPOSED CONDUIT
	EXISTING WATER MAIN
	STORMWATER DRAINAGE
	WATER SERVICE LOCATION
	FIRE HYDRANT
	TEMPORARY FIRE HYDRANT
	VALVE
	CONNECTION REQUIRED BY LOGAN WATER
	ELECTRICAL PILLAR (BY OTHERS)


**LOGAN WATER LIVE WATER CONNECTION TABLE**

LOCATION	DIAMETER
DAWSON CLOSE ADJACENT LOT 1849	Ø100

I, **MARK SHAW** hereby certify that the As Constructed information shown on this plan is a true and correct record of the sizes, types, materials, classes etc., and it corresponds with the relevant approved Engineering Drawings.


*M. Shaw*  
 Mark Andrew Shaw  
 2879 CAVILL, MELBOURNE VIC 3048  
 2017 03 09 13:04:08  
 110107

Signed..... RPEQ No...17544..... Dated...04.03.2021.....

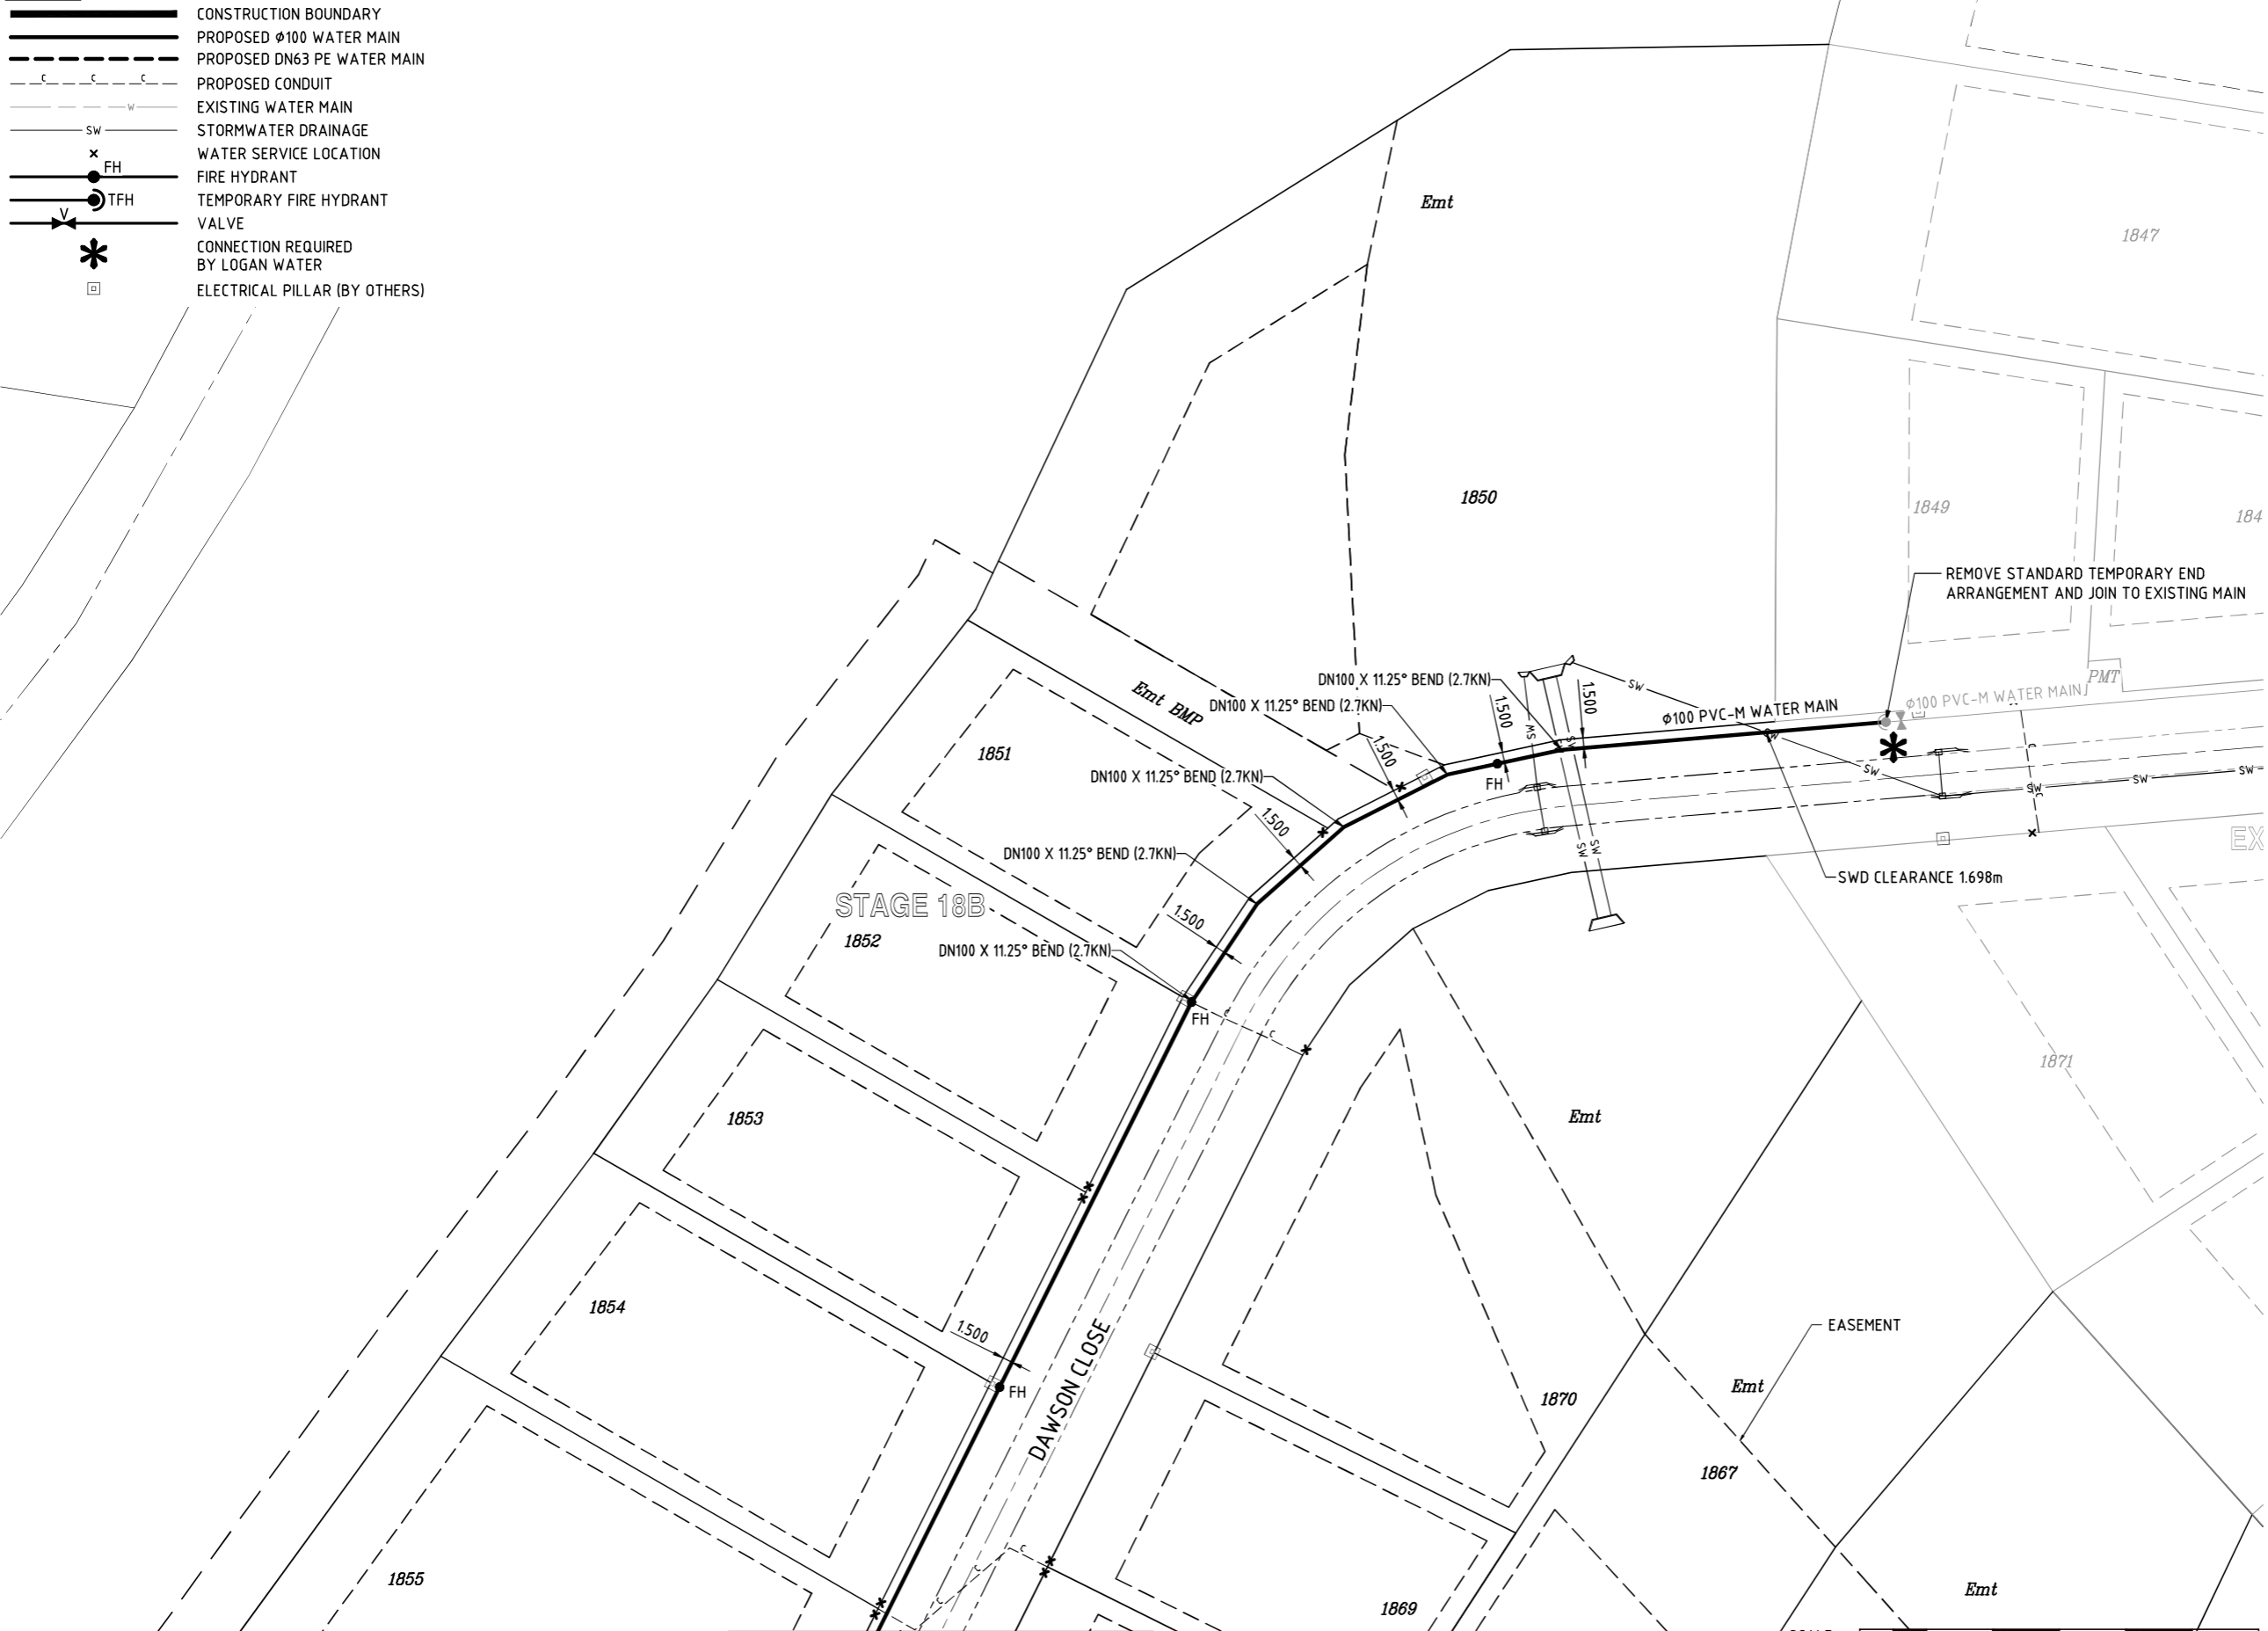

REFER KN DWG 18-201-28  
**WATER RETICULATION LAYOUT PLAN**  
 SCALE 1:500

DO NOT SCALE THIS DRAWING IF IN DOUBT - ASK!

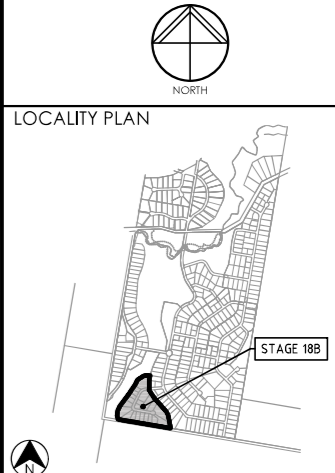

**REVISIONS**

No	Description	Date	By
A	ISSUED FOR APPROVAL	11/06/20	DES
B	REVISED LOTS / EASEMENT	23/09/20	DES
C	AS CONSTRUCTED WATER AND EWKS	04/03/21	LMS

Client

**PEET**

Project

**SPRING MOUNTAIN  
 ACREAGE ESTATE  
 STAGE 18B**

OW/106/2020

Approved

**kn group**

ABN 35 112 53 611  
 L1, 62 Astor Tce  
 Spring Hill Q 4000  
 07 3017 1900  
[www.kngroup.com.au](http://www.kngroup.com.au)

Drawing Title

**WATER RETICULATION  
 LAYOUT PLAN  
 SHEET 1**

Drawn LMS	Designed JB	Checked GG	Date JUN 20
Scale AS SHOWN	Sheet 27 of 33		Revision C


M:\2018\18201 Spring Mountain Stage 18B\Engineering\Ascon\18-201-27-28-W-LA\YOUT.dwg Plotled by: DS on 4/03/2021 10:06:33 AM



**NOTE**

- ALL LIVE CONNECTIONS TO EXISTING MAINS TO BE UNDERTAKEN BY LOGAN WATER AT DEVELOPERS COST
- WATER SERVICE CONDUITS MUST MAINTAIN MINIMUM CLEARANCES AS PER TABLE 5.5 OF THE SEQ D&C CODE


REFER KN DWG 18-201-27

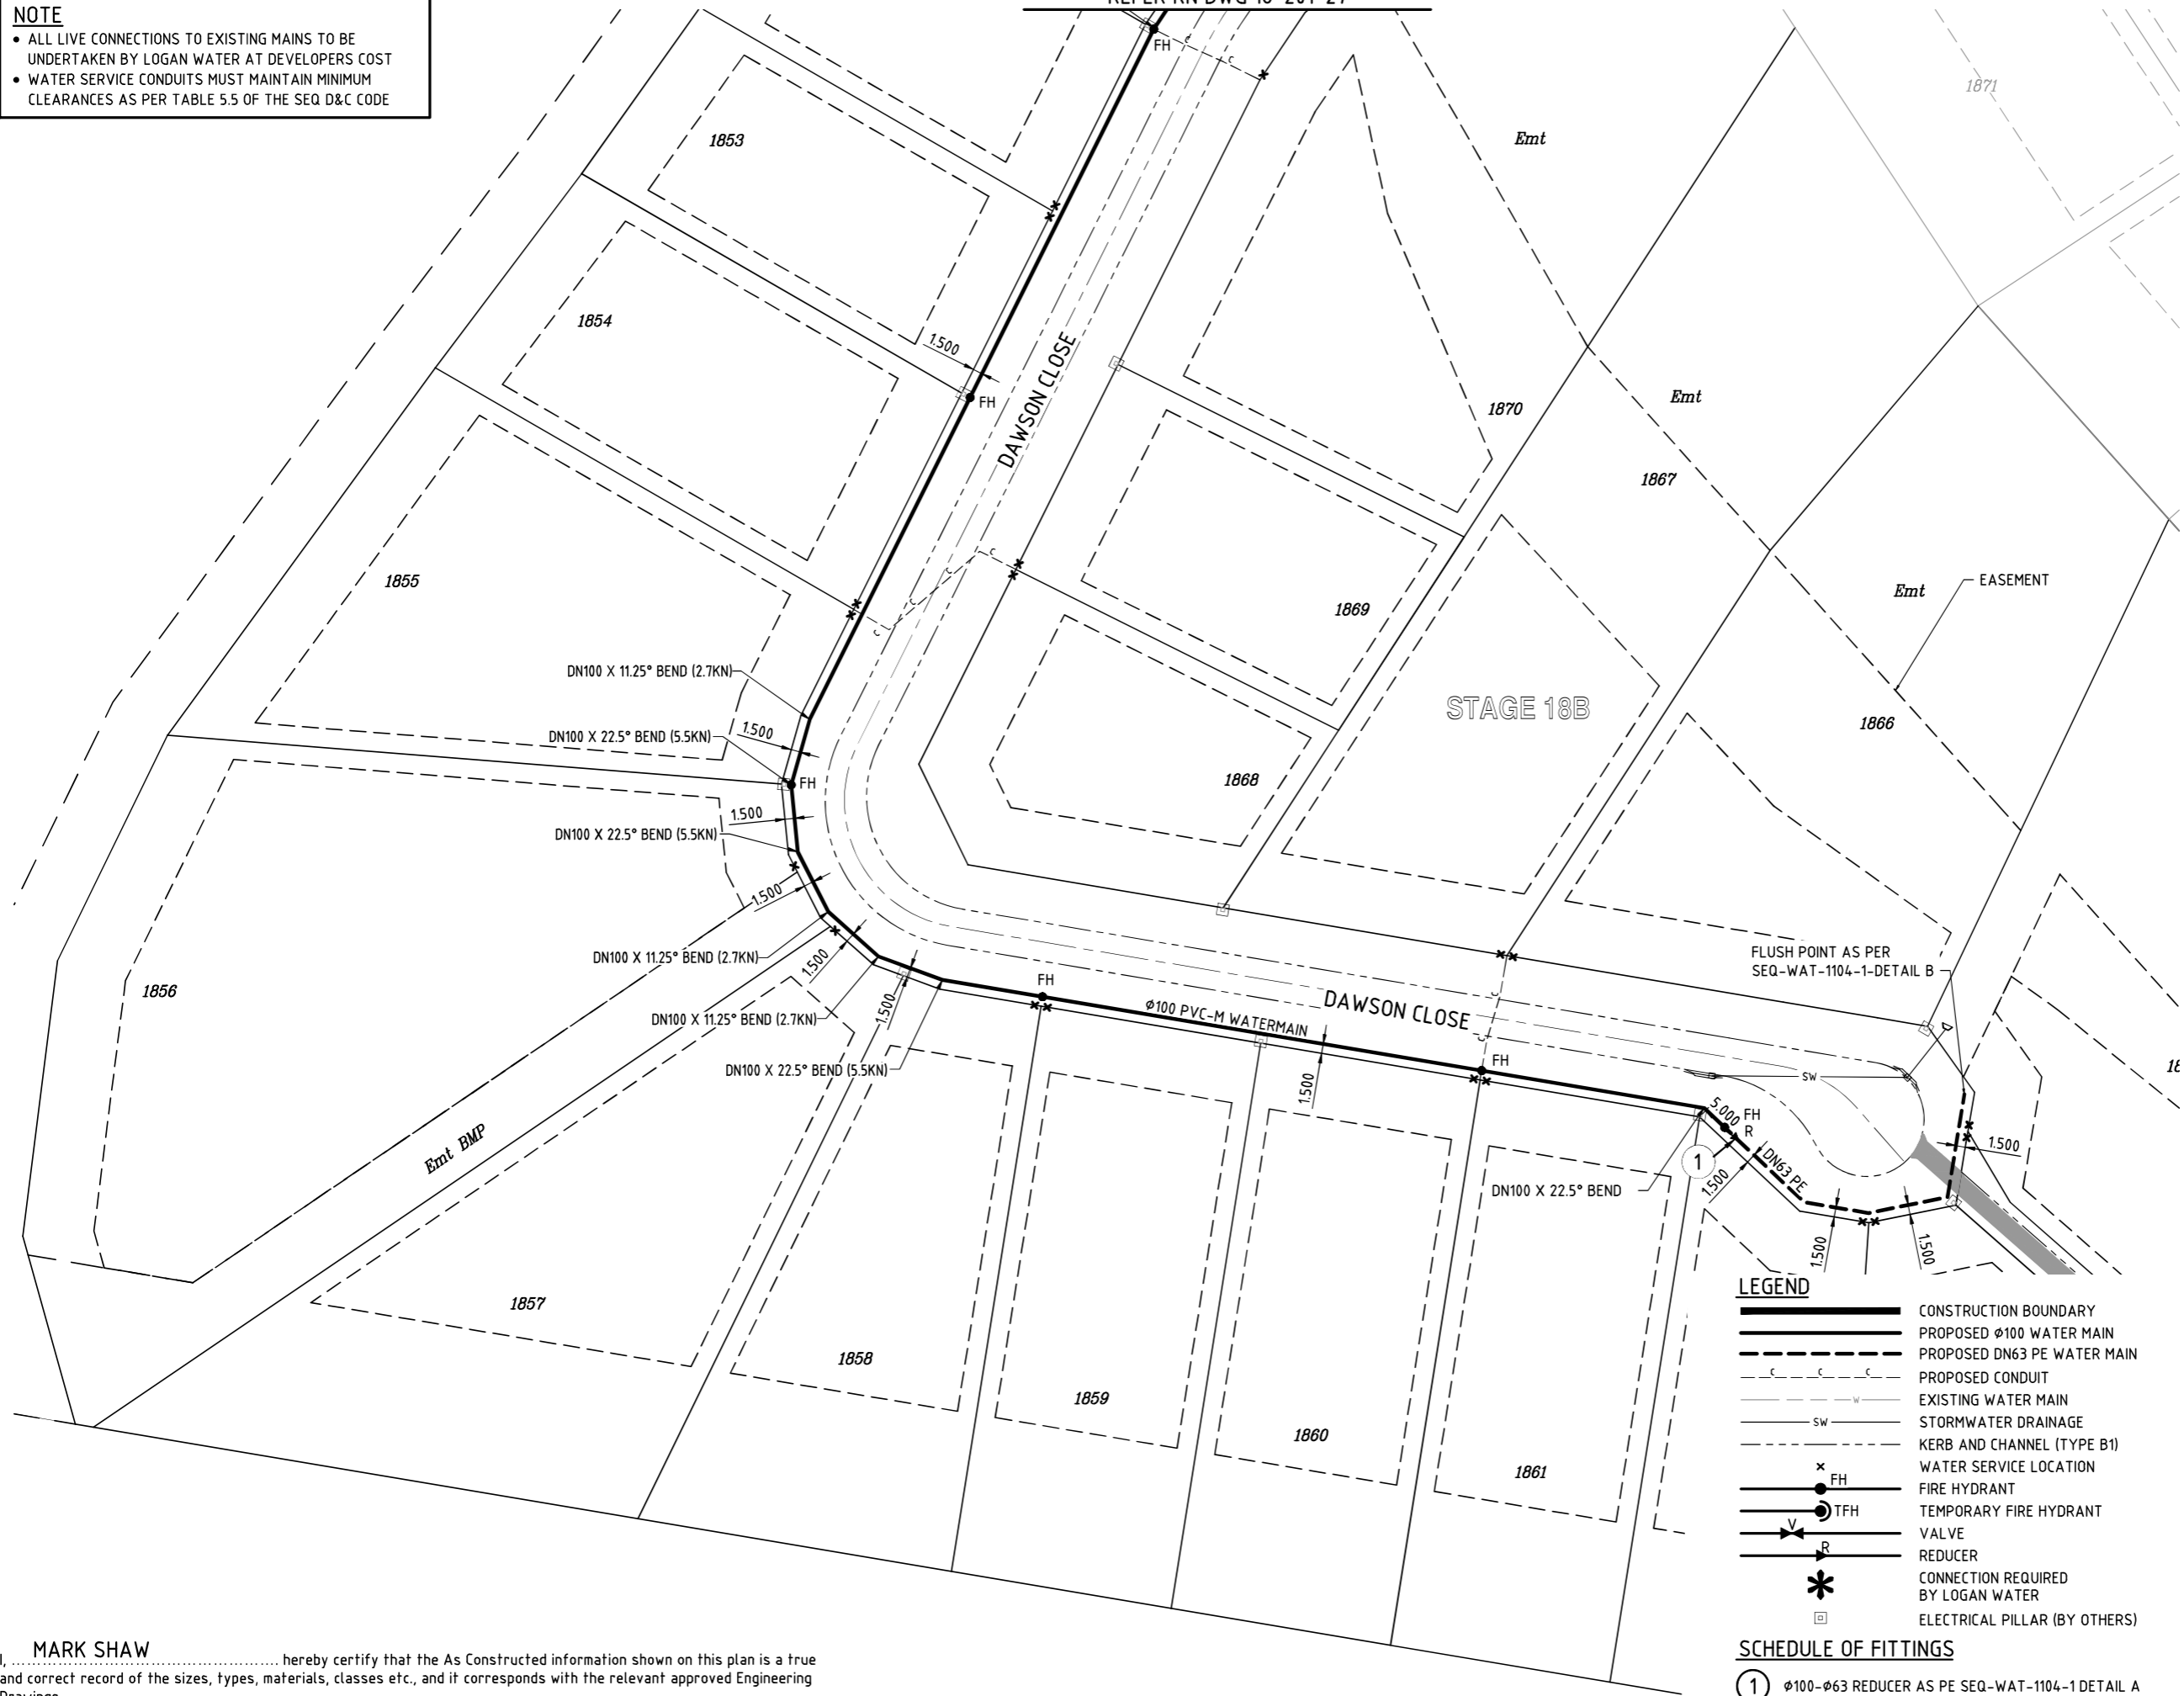

DO NOT SCALE THIS DRAWING IF IN DOUBT - ASK!



LOCALITY PLAN

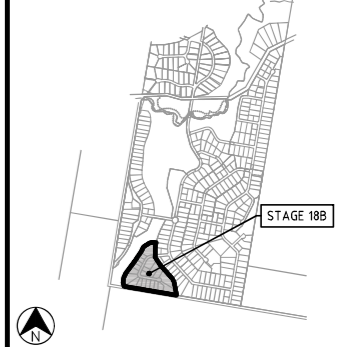

**REVISIONS**

No	Description	Date	By
A	ISSUED FOR APPROVAL	11/06/20	DES
B	REVISED LOTS / EASEMENT	23/09/20	DES
C	AS CONSTRUCTED WATER AND EWKS	04/03/21	LMS

Client

**PEET**

Project

**SPRING MOUNTAIN**  
ACREAGE ESTATE  
STAGE 18B

OW/106/2020

**kn group**  
ABN 35 112 53 611  
L1, 62 Astor Tce  
Spring Hill Q 4000  
07 3017 1900  
www.kngroup.com.au

Approved

Drawing Title  
**WATER RETICULATION  
LAYOUT PLAN  
SHEET 2**


Drawn LMS	Designed JB	Checked GG	Date JUN 20
Scale AS SHOWN	Sheet 28 of 33		Revision C
A1	Drawing No 18-201-28	Revision C	

**LEGEND**

- CONSTRUCTION BOUNDARY
- PROPOSED  $\phi$ 100 WATER MAIN
- PROPOSED DN63 PE WATER MAIN
- PROPOSED CONDUIT
- EXISTING WATER MAIN
- STORMWATER DRAINAGE
- KERB AND CHANNEL (TYPE B1)
- WATER SERVICE LOCATION
- FIRE HYDRANT
- TEMPORARY FIRE HYDRANT
- VALVE
- REDUCER
- CONNECTION REQUIRED BY LOGAN WATER
- ELECTRICAL PILLAR (BY OTHERS)

**SCHEDULE OF FITTINGS**

- ①  $\phi$ 100- $\phi$ 63 REDUCER AS PE SEQ-WAT-1104-1 DETAIL A

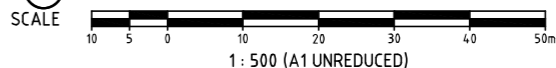

I, **MARK SHAW** hereby certify that the As Constructed information shown on this plan is a true and correct record of the sizes, types, materials, classes etc., and it corresponds with the relevant approved Engineering Drawings.


Signed RPEQ No. 17544 Dated 04.03.2021

**WATER RETICULATION LAYOUT PLAN**  
SCALE 1:500

M:\2018\18201 Spring Mountain Stage 18B\Engineering\Ascon\18-201-27-28-W-LA\YOUT.dwg Plotred by: DS on 4/03/2021 10:06:34 AM



LOCALITY PLAN

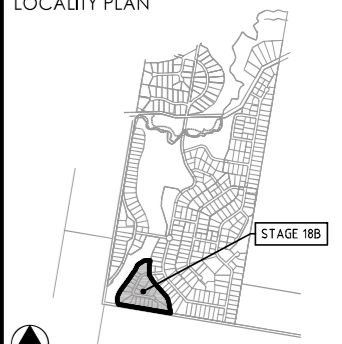

REVISIONS

No	Description	Date	By
A	ISSUED FOR APPROVAL	11/06/20	DES
B	AS CONSTRUCTED WATER AND EWKS	04/03/21	LMS



Project  
**SPRING MOUNTAIN  
ACREAGE ESTATE  
STAGE 18B**  
OW/106/2020

ABN 35 112 53 611  
L1, 62 Astor Terrace  
Spring Hill Q 4000  
07 3017 1900  
[www.kngroup.com.au](http://www.kngroup.com.au)

Approved



Drawing Title  
**WATER RETICULATION  
LIVE CONNECTION DETAILS  
AND NOTES**

Drawn LMS	Designed JB	Checked GG	Date JUN 20
Scale AS SHOWN	Sheet 29 of 33		Revision B
A1	Drawing No 18-201-29	Revision	

**GENERAL NOTES**

- ALL WORK AND MATERIALS SHALL BE IN ACCORDANCE WITH CURRENT SEQ WS&S CODE SPECIFICATIONS AND STANDARDS.
- UNLESS SPECIFIED OTHERWISE ALL MATERIALS AND WORK SHALL COMPLY WITH THE RELEVANT AUSTRALIAN STANDARDS.
- ADOPT LIP OF KERB OR SHOULDER OF ROAD AS PERMANENT LEVEL.
- CLEARANCE OVER MAINS FROM PERMANENT LEVEL TO BE AS SHOWN IN STANDARD DRAWING No. SEQ-WAT-1200-2.
- MINIMUM EMBEDMENT SHALL BE TYPE C IN ACCORDANCE WITH STANDARD DRAWING No. SEQ-WAT-1201-1.
- THRUST BLOCKS SHALL BE IN ACCORDANCE WITH AND PRESSURE TESTED TO 1200kPa AS PER STANDARD DRAWING No. SEQ-WAT-1205-1 AND SEQ-WAT-1206-1.
- CONDUITS TO BE INSTALLED IN ACCORDANCE WITH THE STANDARD DRAWING No. SEQ-WAT-1110-1.
- A WATER METER IS TO BE INSTALLED AT THE RESIDENT'S COST, BY LOGAN WATER.
- ALL MATERIALS USED IN THE WORKS SHALL BE AS FOLLOWS:
  - ALL DUCTILE IRON FITTINGS SHALL BE MANUFACTURED TO AS/NZS 2280 WITH SOCKET ENDS (UNLESS NOTED) AND DESIGNED FOR USE WITH PVC OR DI PIPES AS APPLICABLE. ALL DI PIPES SHALL BE CEMENT LINED TO AS/NZS 2280.
  - DI CL USED IN ROAD CROSSINGS WILL BE PN35 AS PER WATER AUTHORITY STANDARDS.
  - PRESSURE PIPES USED FOR WATER SUPPLY SHALL BE RRJ PIPES AND SHALL BE EITHER PVC CLASS PN16 (UNLESS NOTED OTHERWISE) MINIMUM AND MANUFACTURED TO (UPVC AS/NZS 1477), (PVC-M AS/NZS 4765) (PVC-O AS/NZS 4441) OR DI CL PN 20, 35 OR FLANGED CLASS TO AS/NZS 2280).
  - DUCTILE IRON SLUICE AND SCOUR VALVES SHALL BE PN16 RESILIENT SEATED WITH DOUBLE "O" RING STEM SEALS MANUFACTURED TO AS 2638.
  - ALL VALVES, FITTINGS AND PIPE FITTINGS TO BE COATED INTERNALLY AND EXTERNALLY WITH FACTORY APPLIED THERMAL POLYMERIC CORROSION PROTECTION TO AS 4158.
  - ALL NUTS, BOLTS AND WASHERS, SHALL BE STAINLESS STEEL GRADE 316 CLASS 50, WITH AN ANTI-SEIZE APPLIED DURING ASSEMBLY.
  - ALL DUCTILE IRON FLANGES ARE TO COMPLY WITH AS/NZS 2280 AND SHALL BE RAISED FACE TO AS 4087.


- ALL CONCRETE FOOTPATHS TO BE CLEAR OF WATER MAINS (WHERE APPLICABLE).
- MARKERS SHALL BE INSTALLED FOR ALL SERVICE CROSSINGS, HYDRANTS AND VALVES IN ACCORDANCE WITH STANDARD DRAWING Nos. SEQ-WAT-1110-1, AND SEQ-WAT-1110-2.
- THE CONSTRUCTION OF THE WATER RETICULATION WORK SHOWN ON THIS DRAWING MUST BE SUPERVISED BY AN ENGINEER WHO HAS R.P.E.Q. REGISTRATION. WORKS NOT COMPLYING WITH THIS REQUIREMENT WILL NOT BE PERMITTED TO CONNECT TO THE RETICULATION SYSTEM.
- WATER MAIN SHALL BE LAID AT 1.425m ALIGNMENT FROM PROPERTY BOUNDARY UNLESS NOTES OTHERWISE.
- WHERE PERMANENT HYDRANTS ARE NOT INSTALLED AT END OF MAINS OF EACH STAGE, A TEMPORARY HYDRANT WILL BE INSTALLED INSTEAD.
- NO WORK SHALL BE BACKFILLED UNTIL PERMISSION IS GRANTED BY THE SUPERINTENDENT OR LOGAN WATER.
- NOT ALL SERVICES HAVE NECESSARILY BEEN SHOWN. THE LOCATION OF SERVICES ON THESE PLANS ARE APPROXIMATE ONLY. NO RESPONSIBILITY IS TAKEN FOR THE ACCURACY OR COMPLETENESS OF THIS INFORMATION NO WORK IS TO BE UNDERTAKEN WITHOUT CONSULTING THE RELEVANT SERVICE AUTHORITY PRIOR TO COMMENCEMENT OF THE WORK. DEPTH OF SERVICES AT POSSIBLE CONFLICT POINTS ARE TO BE CONFIRMED PRIOR TO THE COMMENCEMENT OF CONSTRUCTION. ABOVE GROUND SERVICES AS SHOWN ON THE DRGS HAVE BEEN LOCATED BY FIELD SURVEY. ALL UNDERGROUND SERVICES HAVE BEEN PLOTTED FROM THE RELEVANT AUTHORITY'S RECORDS.
- ALL EXISTING FEATURES (eg. DRIVEWAYS, GARDENS, PATHS etc.) ARE TO BE REINSTATED WHERE DISTURBED BY THE WORKS. ALLOW FOR SUPPORT OF POWER POLES/STAYS, FENCES etc. ADJACENT TO TRENCHES.
- WHERE BEND FITTINGS ARE NOT SHOWN, MAKE CHANGES IN DIRECTION USING PIPE JOINT DEFLECTIONS. MAKE EQUAL NUMBER AND SIZE OF PIPE DEFLECTIONS EACH SIDE OF CHAINAGE SHOWN (MAX. DEFLECTION 3° PER JOINT). IL SHOWN ON LONG SECTIONS IS AT INTERSECTIONS POINT (IP). JOINT DEFLECTIONS MAY ALSO BE REQUIRED AT FITTINGS TO MEET ALIGNMENT AND LEVELS AS SPECIFIED.

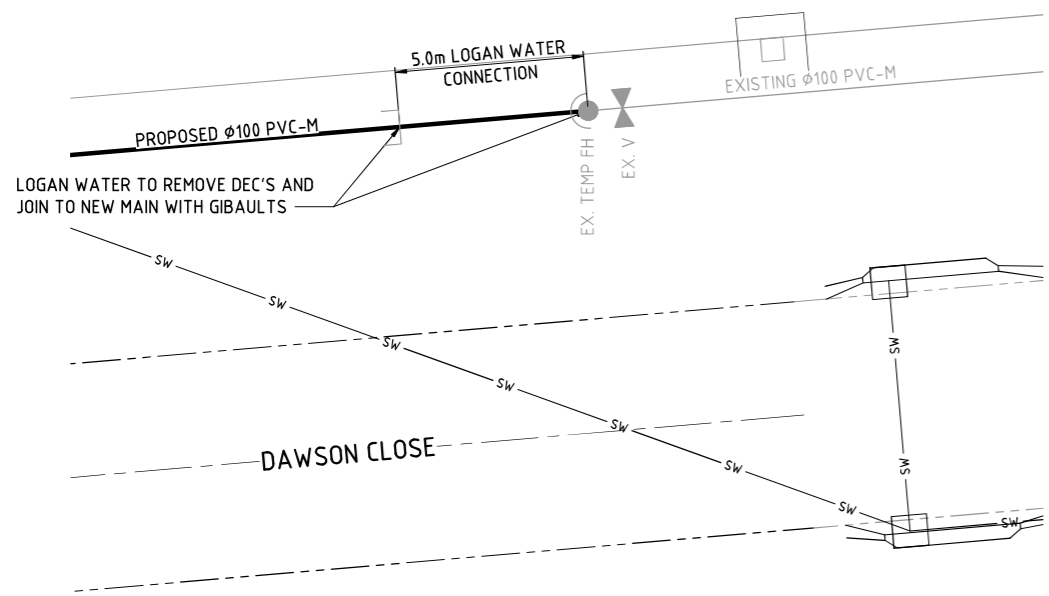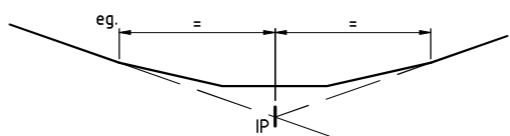

**LIVE CONNECTION DETAIL**  
**SPRING MOUNTAIN DRIVE ADJACENT LOT 1849**  
SCALE 1:100

I, MARK SHAW hereby certify that the As Constructed information shown on this plan is a true and correct record of the sizes, types, materials, classes etc., and it corresponds with the relevant approved Engineering Drawings.

Signed..... RPEQ No. 17544..... Dated... 04.03.2021.....

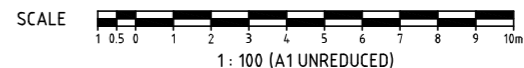



**NOTE**  
DTM SURVEY INFORMATION UTILISED FOR ROAD DESIGN WITH LIDAR SOURCED NATURAL SURFACE INFORMATION PROVIDED FOR INFORMATION PURPOSE ONLY.

- GENERAL NOTES**
- CLEARING TO BE UNDERTAKEN IN ACCORDANCE WITH THE APPROVED VEGETATION AND CLEARING FAUNA MANAGEMENT PLAN.
  - CLEARING AND CONSTRUCTION WORKS TO ADHERE TO TECHNICAL AGENCY RESPONSE (VEGETATION) CONDITIONS AND PLAN (TARP) REFERENCE NO. TARP 1902-9640 SPD.
  - TARP AREAS A1-A3. NO VEGETATION CLEARING TO OCCUR.
  - TARP AREAS B1,B3 AND B5. VEGETATION CLEARING LIMITED TO PERMITTED INFRASTRUCTURE; ROADS, FENCES AND UNDERGROUND SERVICES.
  - TARP AREAS D2 AND D3. CLEARING PERMITTED WITH REHABILITATION WORKS CARRIED OUT WHERE RELEVANT.
  - REFER BUSHFIRE HAZARD MANAGEMENT PLAN BY JENSEN BOWERS GROUP CONSULTANTS PTY LTD AND BUSHFIRE MANAGEMENT PLANS BY MERIDIAN URBAN FOR DETAILS.
  - APPROPRIATE DRAINAGE AND EROSION SEDIMENT CONTROL MEASURES TO BE IMPLEMENTED AS REQUIRED TO PREVENT SCOURING OR DAMAGE TO FIRE TRAIL SURROUNDS.

- LEGEND**
- CONSTRUCTION BOUNDARY
  - PROPOSED ROAD CENTRELINE
  - KERB AND CHANNEL (TYPE M3)
  - KERB AND CHANNEL (TYPE SM3)
  - TARP BOUNDARY
  - FINISHED SURFACE CONTOURS (DTM SURVEY INFORMATION)
  - NATURAL SURFACE CONTOURS (LIDAR SOURCED)
  - ROCK BOULDER RETAINING WALL
  - BATTER LINE - TOP
  - BATTER LINE - BOTTOM

DO NOT SCALE THIS DRAWING IF IN DOUBT - ASK!

NORTH

LOCALITY PLAN

STAGE 18B

REVISIONS

No	Description	Date	By
A	ISSUED FOR APPROVAL	11/06/20	DES
B	REVISED EARTHWORKS	20/08/20	DES
C	REVISED LOTS / EASEMENT	23/09/20	DES
D	AS CONSTRUCTED FINAL	06/05/21	LMS

Client

**PEET**

Project

**SPRING MOUNTAIN**  
ACREAGE ESTATE  
STAGE 18B

OW/106/2020

**kn group**


ABN 35 112 53 611  
L1, 62 Astor Tce  
Spring Hill Q 4000  
07 3017 1900  
www.knigroup.com.au

Approved

Drawing Title  
**TARP EXTENTS SHEET 1**

Drawn LMS	Designed JB	Checked GG	Date JUN 20
Scale AS SHOWN	Sheet 31 of 33		Revision D

Drawing No  
A1 18-201-31

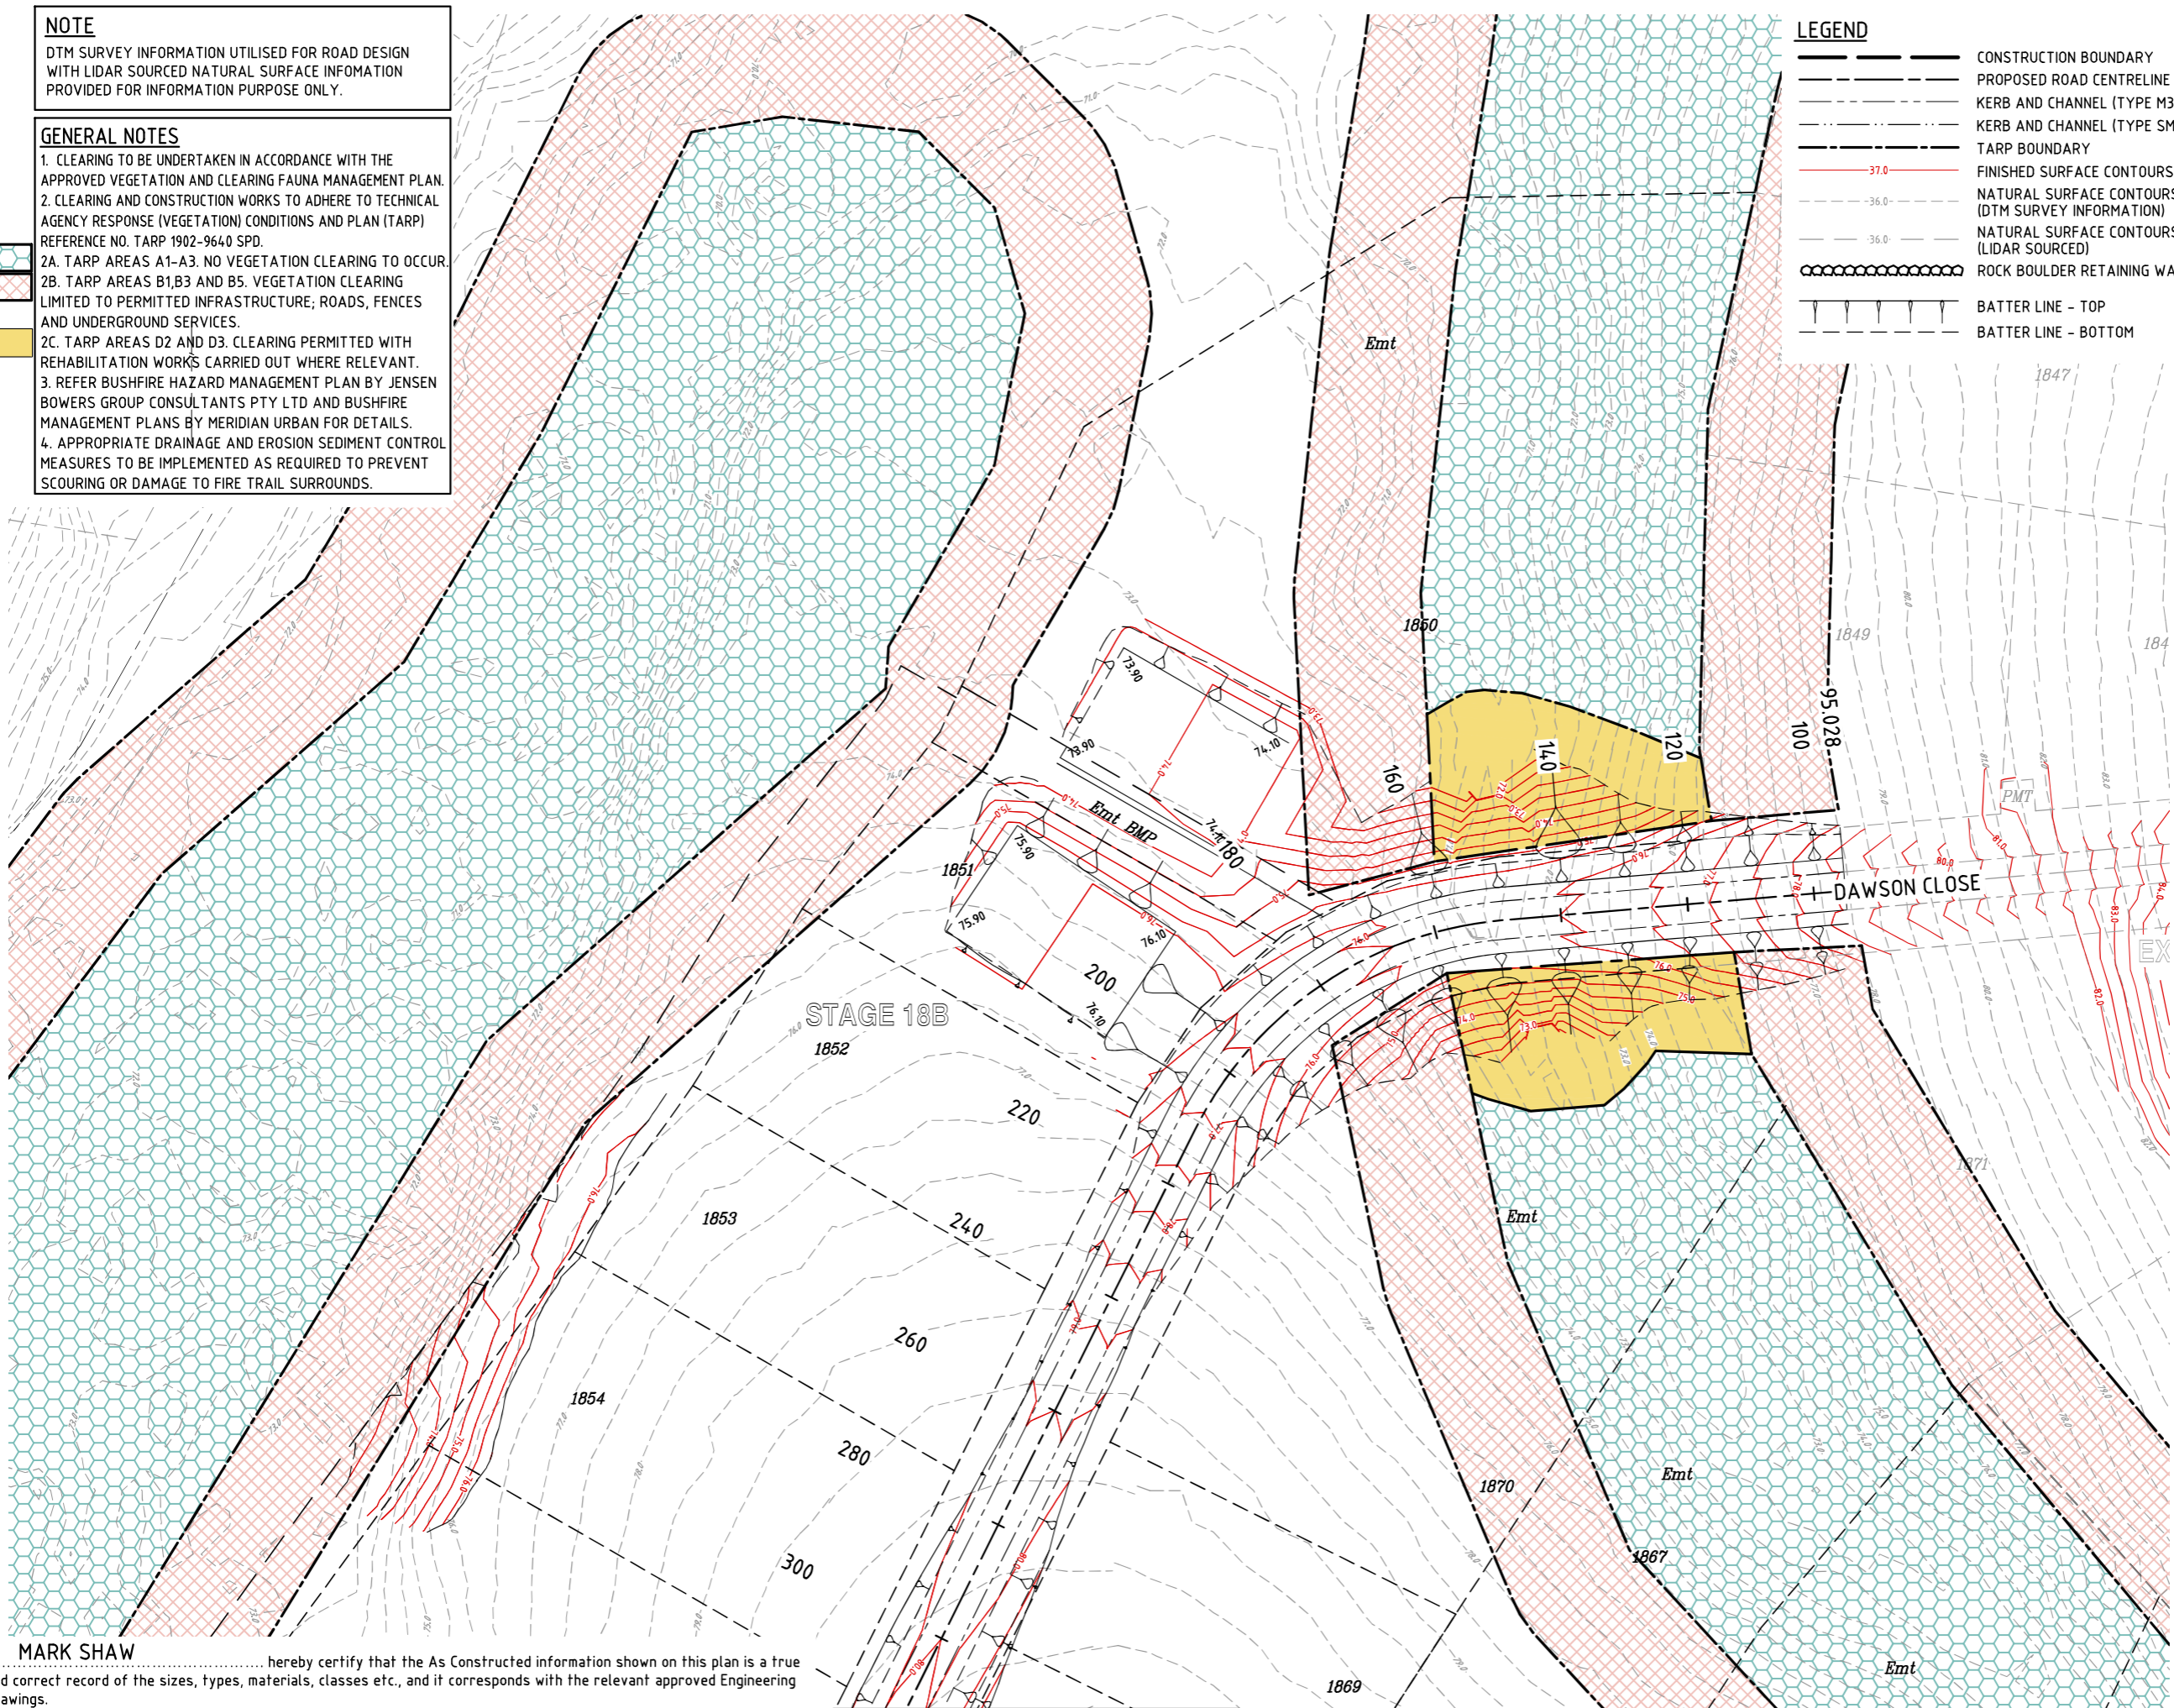

M:\2018\18201 Spring Mountain Stage 18B\Engineering\Ascon\18-201-31-TARP-EXTENTS.dwg Plotted by: DS on 6/05/2021 12:04:00 PM

I, **MARK SHAW** hereby certify that the As Constructed information shown on this plan is a true and correct record of the sizes, types, materials, classes etc., and it corresponds with the relevant approved Engineering Drawings.

Signed: *M. Shaw* Mark Andrew Shaw  
BEng (Civil), MEng (Struct),  
1989/93/17544  
2021/05/08 12:58:34  
110787


REFER KN DWG 18-201-32

**LAYOUT PLAN**  
SCALE 1:500

SCALE 1: 500 (A1 UNREDUCED)



REFER KN DWG 18-201-31

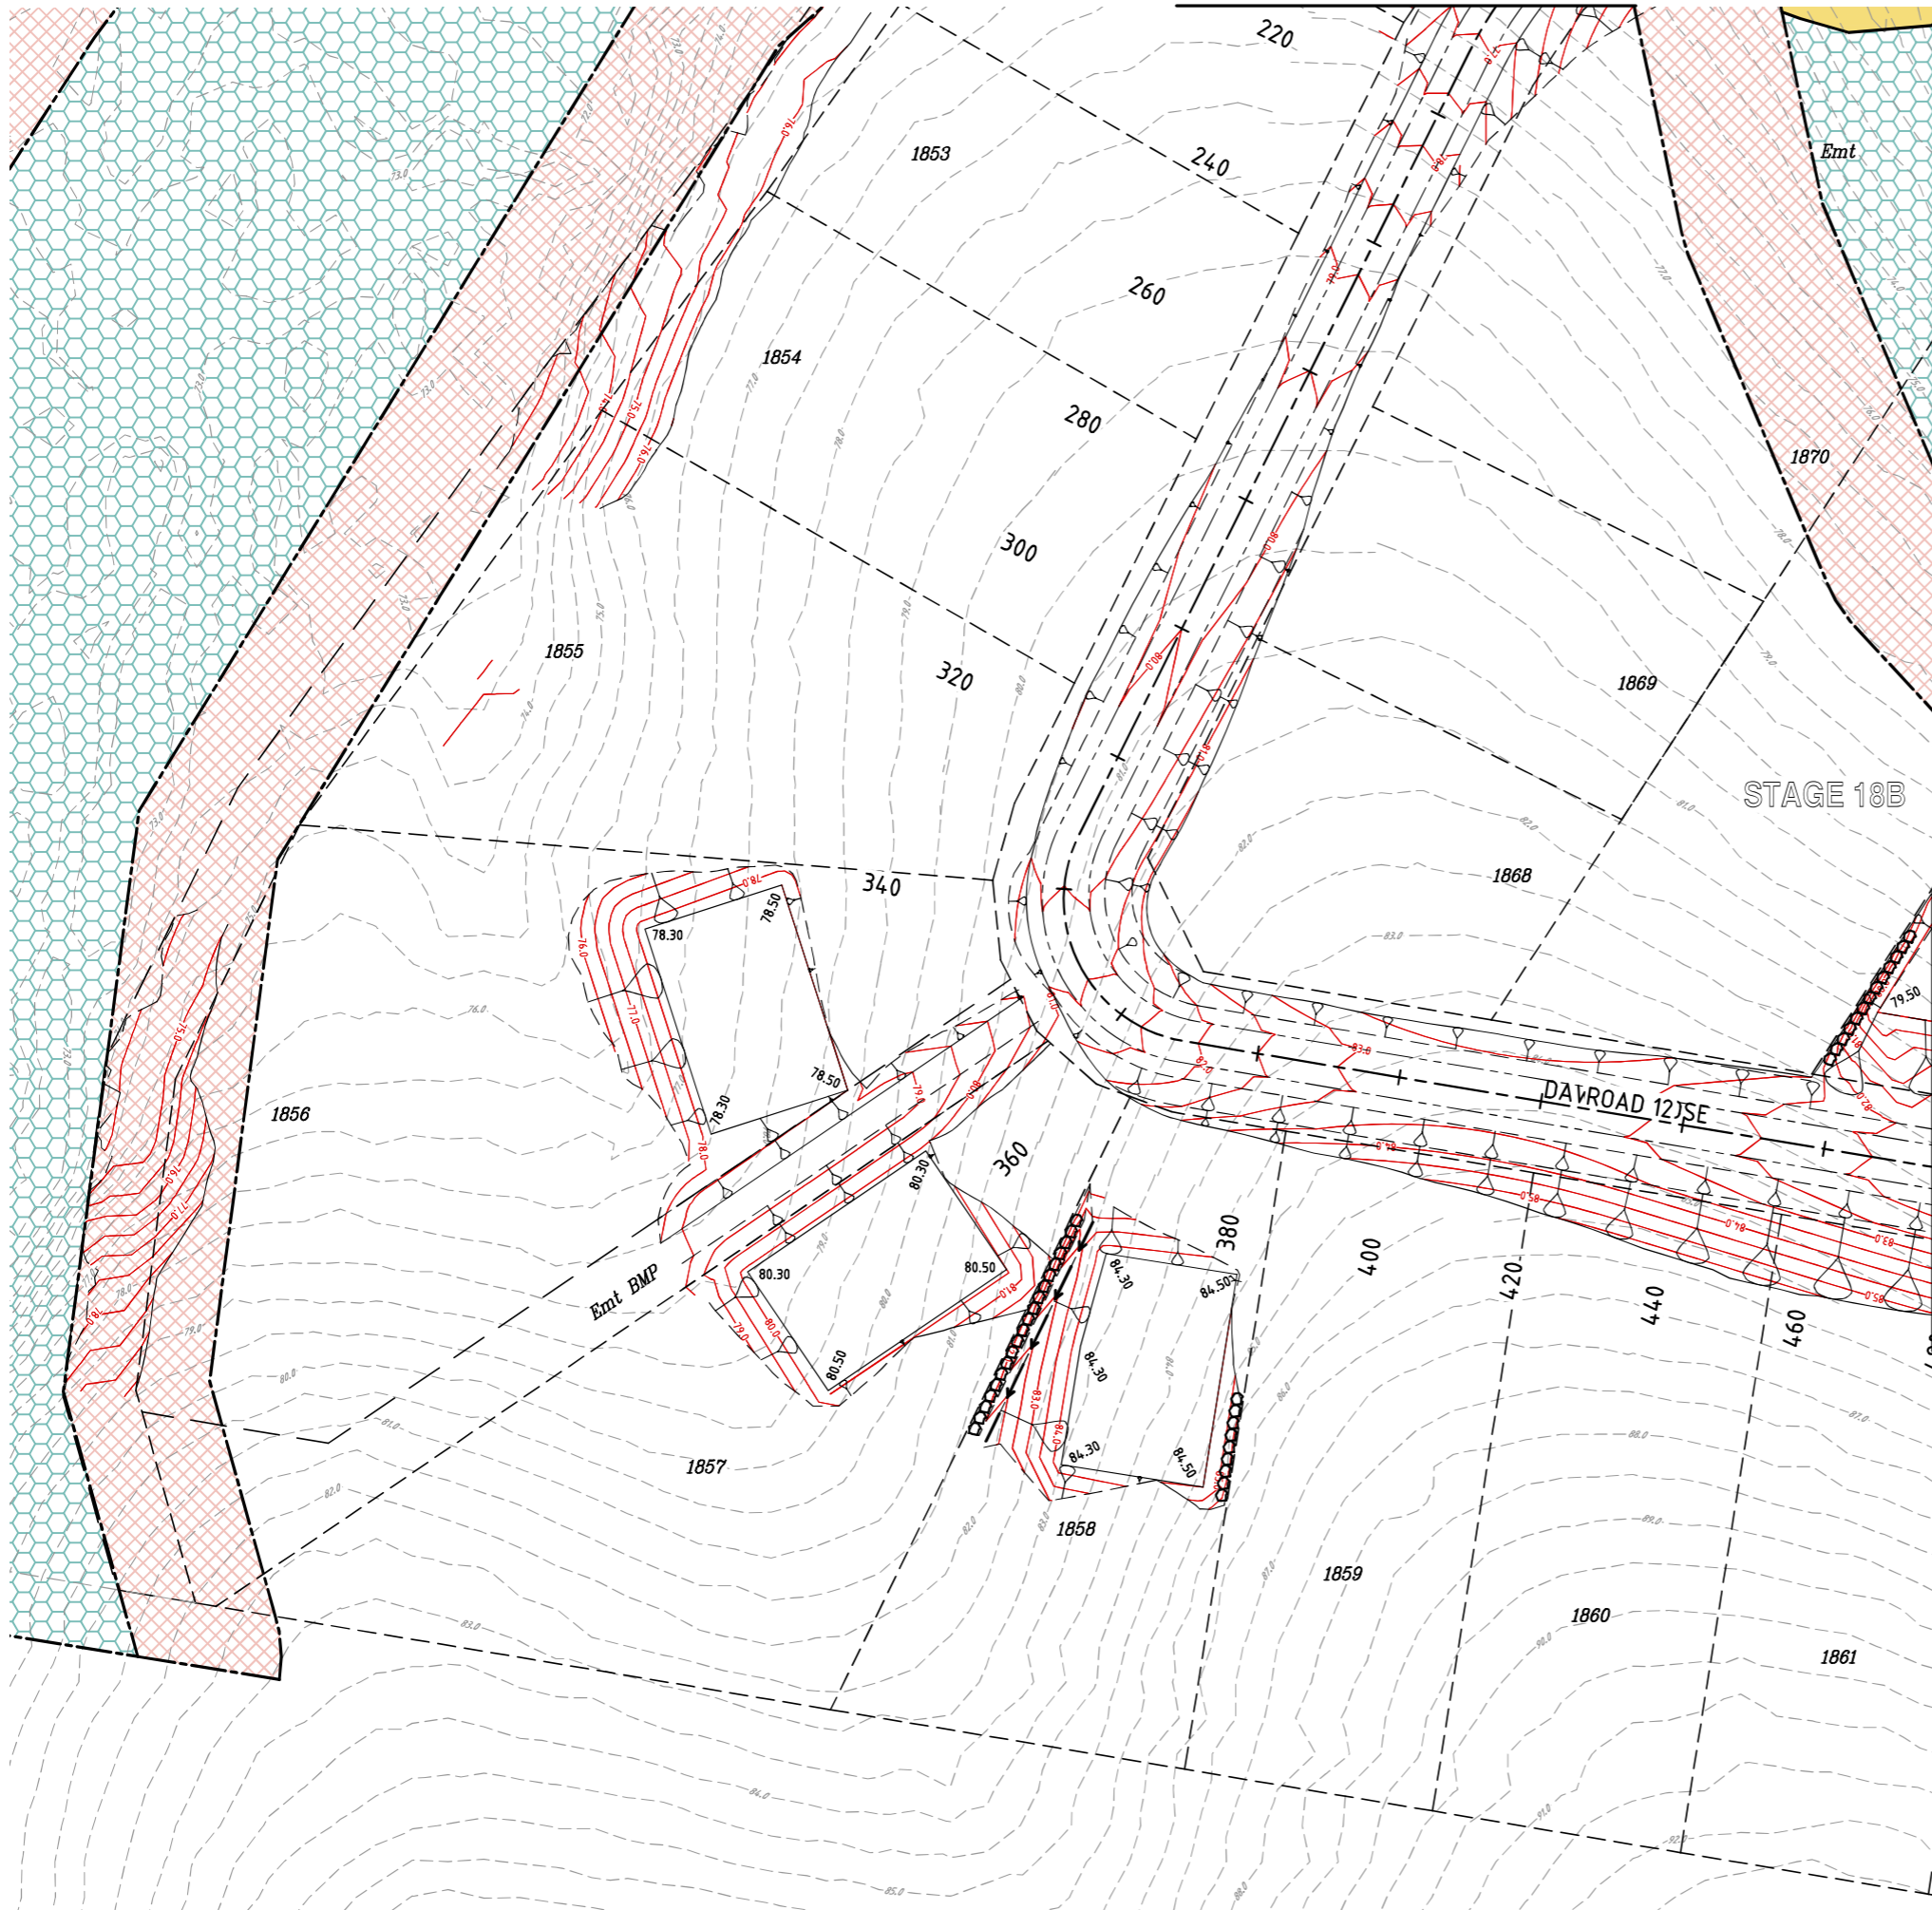

LAYOUT PLAN  
SCALE 1:500

**GENERAL NOTES**

- CLEARING TO BE UNDERTAKEN IN ACCORDANCE WITH THE APPROVED VEGETATION AND CLEARING FAUNA MANAGEMENT PLAN.
- CLEARING AND CONSTRUCTION WORKS TO ADHERE TO TECHNICAL AGENCY RESPONSE (VEGETATION) CONDITIONS AND PLAN (TARP) REFERENCE NO. TARP 1902-9640 SPD.
  - TARP AREAS A1-A3. NO VEGETATION CLEARING TO OCCUR.
  - TARP AREAS B1,B3 AND B5. VEGETATION CLEARING LIMITED TO PERMITTED INFRASTRUCTURE, ROADS, FENCES AND UNDERGROUND SERVICES.
  - TARP AREAS D2 AND D3. CLEARING PERMITTED WITH REHABILITATION WORKS CARRIED OUT WHERE RELEVANT.
- REFER BUSHFIRE HAZARD MANAGEMENT PLAN BY JENSEN BOWERS GROUP CONSULTANTS PTY LTD AND BUSHFIRE MANAGEMENT PLANS BY MERIDIAN URBAN FOR DETAILS.
- APPROPRIATE DRAINAGE AND EROSION SEDIMENT CONTROL MEASURES TO BE IMPLEMENTED AS REQUIRED TO PREVENT SCOURING OR DAMAGE TO FIRE TRAIL SURROUNDS.

DO NOT SCALE THIS DRAWING  
IF IN DOUBT - ASK!

NORTH

LOCALITY PLAN

REVISIONS


No	Description	Date	By
A	ISSUED FOR APPROVAL	11/06/20	DES
B	REVISED EARTHWORKS	20/08/20	DES
C	REVISED LOTS / EASEMENT	23/09/20	DES
D	AS CONSTRUCTED FINAL	06/05/21	LMS

I, **MARK SHAW**, hereby certify that the As Constructed information shown on this plan is a true and correct record of the sizes, types, materials, classes etc., and it corresponds with the relevant approved Engineering Drawings.

Signed..... RPEQ No. 17544..... Dated...06.05.2021.....

Mark Andrew Shaw (RPEQ) (Civil) MESA No. RPEQ 11044 2011.01.08 12.58.48 1990

- LEGEND**
- CONSTRUCTION BOUNDARY
  - PROPOSED ROAD CENTRELINE
  - KERB AND CHANNEL (TYPE M3)
  - KERB AND CHANNEL (TYPE SM3)
  - TARP BOUNDARY
  - 37.0 --- FINISHED SURFACE CONTOURS
  - 36.0 --- NATURAL SURFACE CONTOURS (DTM SURVEY INFORMATION)
  - 36.0 --- NATURAL SURFACE CONTOURS (LIDAR SOURCED)
  - ROCK BOULDER RETAINING WALL
  - BATTER LINE - TOP
  - BATTER LINE - BOTTOM

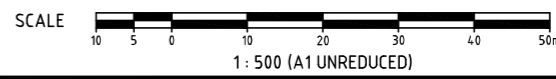

Client

**PEET**

Project

**SPRING MOUNTAIN**  
ACREAGE ESTATE  
STAGE 18B

OW/106/2020

Approved

Drawing Title

**TARP EXTENTS SHEET 2**

Drawn LMS	Designed JB	Checked GG	Date JUN 20
Scale AS SHOWN	Drawing No 18-201-32		Sheet 32 of 33
A1	Revision D		

ABN 35 112 53 611  
L1, 62 Astor Tee  
Spring Hill Q 4000  
07 3017 1900  
www.knigroup.com.au


M:\2018\18201 Spring Mountain Stage 18B Engineering\Ascon\18-201-31-TARP-EXTENTS.dwg Plotted by: DS on 6/05/2021 12:04:03 PM



DO NOT SCALE THIS DRAWING  
IF IN DOUBT - ASK!




LOCALITY PLAN

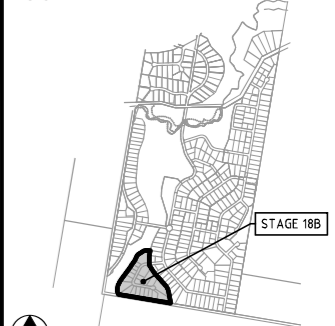

**GENERAL NOTES**

1. CLEARING TO BE UNDERTAKEN IN ACCORDANCE WITH THE APPROVED VEGETATION AND CLEARING FAUNA MANAGEMENT PLAN.
2. CLEARING AND CONSTRUCTION WORKS TO ADHERE TO TECHNICAL AGENCY RESPONSE (VEGETATION) CONDITIONS AND PLAN (TARP) REFERENCE NO. TARP 1902-9640 SPD.
- 2A. TARP AREAS A1-A3. NO VEGETATION CLEARING TO OCCUR.
- 2B. TARP AREAS B1,B3 AND B5. VEGETATION CLEARING LIMITED TO PERMITTED INFRASTRUCTURE; ROADS, FENCES AND UNDERGROUND SERVICES.
- 2C. TARP AREAS D2 AND D3. CLEARING PERMITTED WITH REHABILITATION WORKS CARRIED OUT WHERE RELEVANT.
3. REFER BUSHFIRE HAZARD MANAGEMENT PLAN BY JENSEN BOWERS GROUP CONSULTANTS PTY LTD AND BUSHFIRE MANAGEMENT PLANS BY MERIDIAN URBAN FOR DETAILS.
4. APPROPRIATE DRAINAGE AND EROSION SEDIMENT CONTROL MEASURES TO BE IMPLEMENTED AS REQUIRED TO PREVENT SCOURING OR DAMAGE TO FIRE TRAIL SURROUNDS.

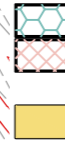


**NOTE**


DTM SURVEY INFORMATION UTILISED FOR ROAD DESIGN WITH LIDAR SOURCED NATURAL SURFACE INFORMATION PROVIDED FOR INFORMATION PURPOSE ONLY.

**LEGEND**

- CONSTRUCTION BOUNDARY
- PROPOSED ROAD CENTRELINE
- KERB AND CHANNEL (TYPE M3)
- KERB AND CHANNEL (TYPE SM3)
- TARP BOUNDARY
- FINISHED SURFACE CONTOURS
- NATURAL SURFACE CONTOURS (DTM SURVEY INFORMATION)
- NATURAL SURFACE CONTOURS (LIDAR SOURCED)
- ROCK BOULDER RETAINING WALL
- BATTER LINE - TOP
- BATTER LINE - BOTTOM

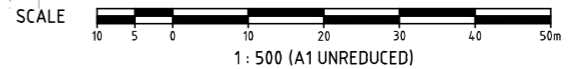

**EARTHWORKS CONTOUR PLAN**  
SCALE 1:500

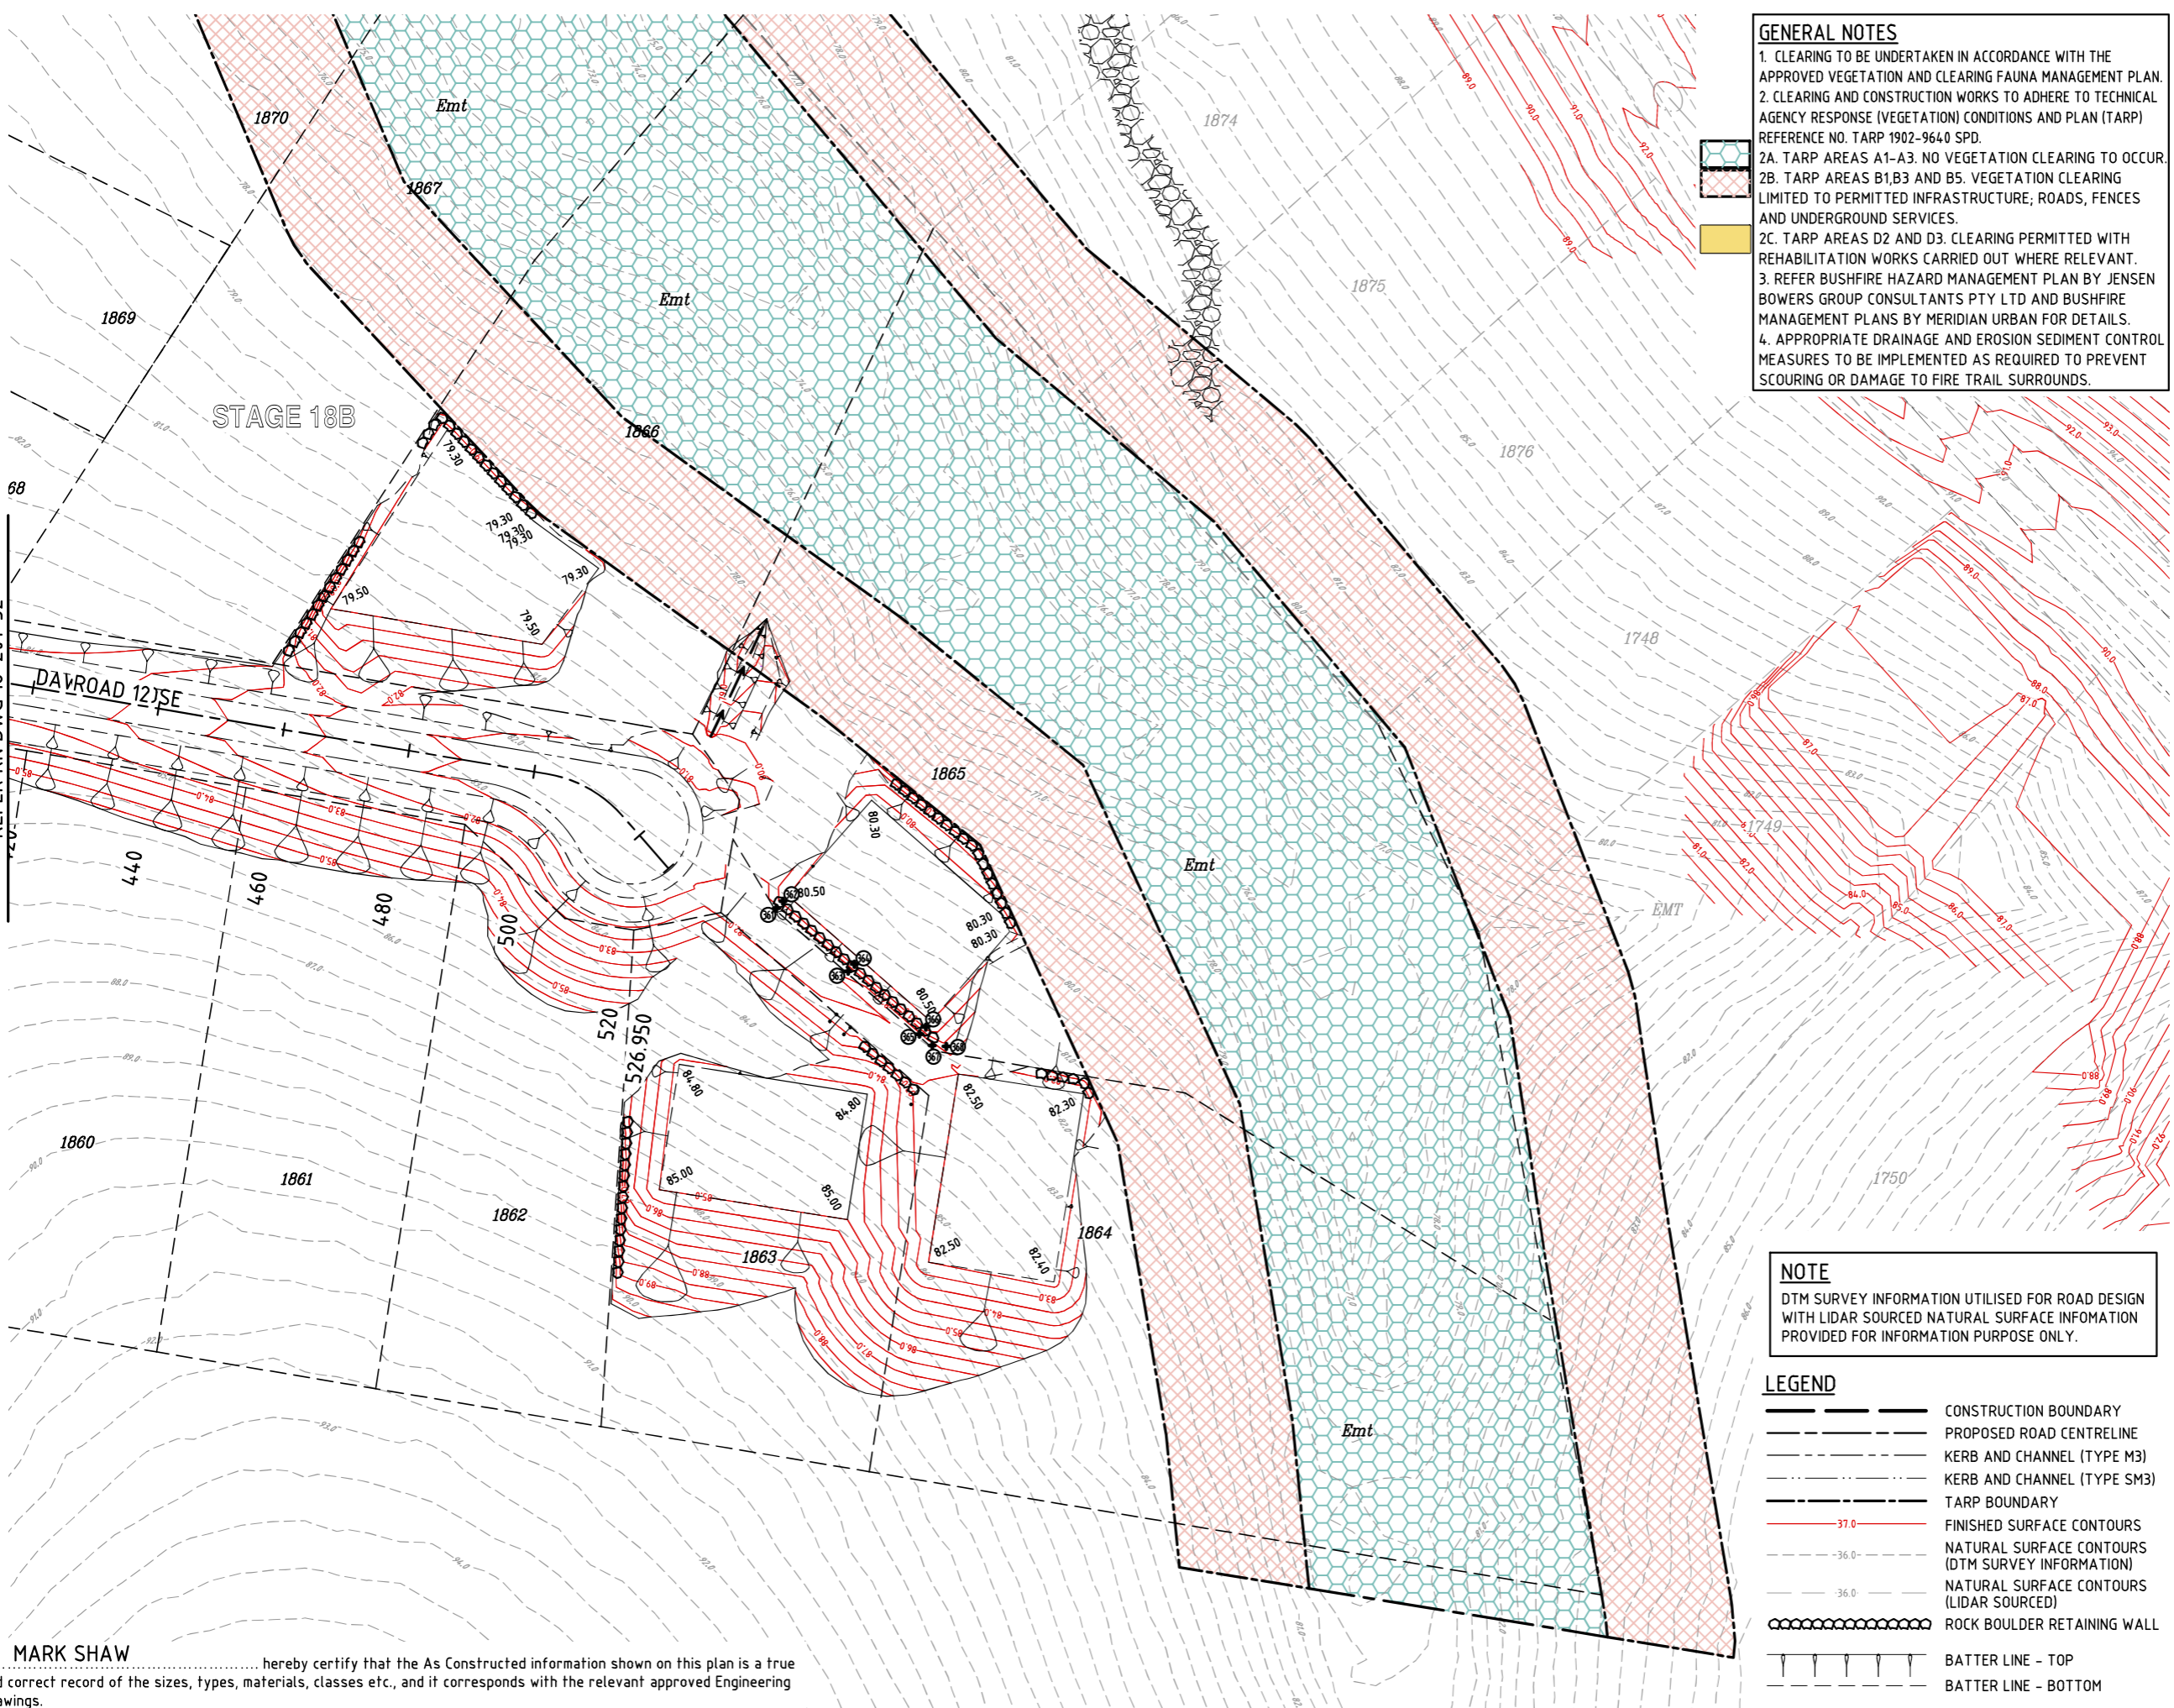

**REVISIONS**

No	Description	Date	By
A	ISSUED FOR APPROVAL	11/06/20	DES
B	REVISED EARTHWORKS	20/08/20	DES
C	AS CONSTRUCTED FINAL	06/05/21	LMS

Client

**PEET**

Project

**SPRING MOUNTAIN**  
ACREAGE ESTATE  
STAGE 18B

OW/106/2020

**kn group**  
ABN 35 112 53 611  
L1, 62 Astor Tce  
Spring Hill Q 4000  
07 3017 1900  
www.knigroup.com.au

Approved

Drawing Title  
**TARP EXTENTS**  
**SHEET 3**

Drawn	Designed	Checked	Date
LMS	JB	GG	JUN 20
Scale AS SHOWN			Sheet 33 of 33
A1	Drawing No 18-201-33	Revision C	

**MARK SHAW** hereby certify that the As Constructed information shown on this plan is a true and correct record of the sizes, types, materials, classes etc., and it corresponds with the relevant approved Engineering Drawings.

Signed RPEQ No. 17544 Dated 06.05.2021

M:\2018\18201 Spring Mountain Stage 18B Engineering\Ascon\18-201-33-TARP-EXTENTS.dwg Plotted by: DS on 6/05/2021 12:04:06 PM






**LEGEND**

- CONSTRUCTION BOUNDARY
- RP EMT
- KERB AND CHANNEL (TYPE M3)
- KERB AND CHANNEL (TYPE SM3)
- EASEMENT

DO NOT SCALE THIS DRAWING  
IF IN DOUBT - ASK!

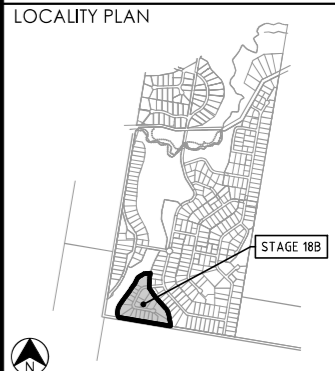

REVISIONS

No	Description	Date	By
A	ISSUED FOR APPROVAL	20/08/20	DES
B	REVISED LOTS / EASEMENT	23/09/20	DES
C	AS CONSTRUCTED FINAL	06/05/21	LMS



Project

**SPRING MOUNTAIN**  
ACREAGE ESTATE  
STAGE 18B

OW/106/2020



Approved

Drawing Title  
**EASEMENT PLAN**

Drawn LMS	Designed JB	Checked GG	Date JUN 20
Scale AS SHOWN			Sheet 34 of 33
A1	Drawing No 18-201-34	Revision C	

I, **MARK SHAW** hereby certify that the As Constructed information shown on this plan is a true and correct record of the sizes, types, materials, classes etc., and it corresponds with the relevant approved Engineering Drawings.

Signed *M. Shaw* RPEQ No. 17544 Dated 06.05.2021

**LAYOUT PLAN**  
SCALE 1:1000

P:\2018\18201 Spring Mountain Stage 18B\Engineering\Ascon\18-201-34-Emt.dwg Plotted by: DS on 6/05/2021 12:04:11 PM