

1524 SEE DIAGRAM

1525

1526

1527


1528

1529

1530

1531

1532

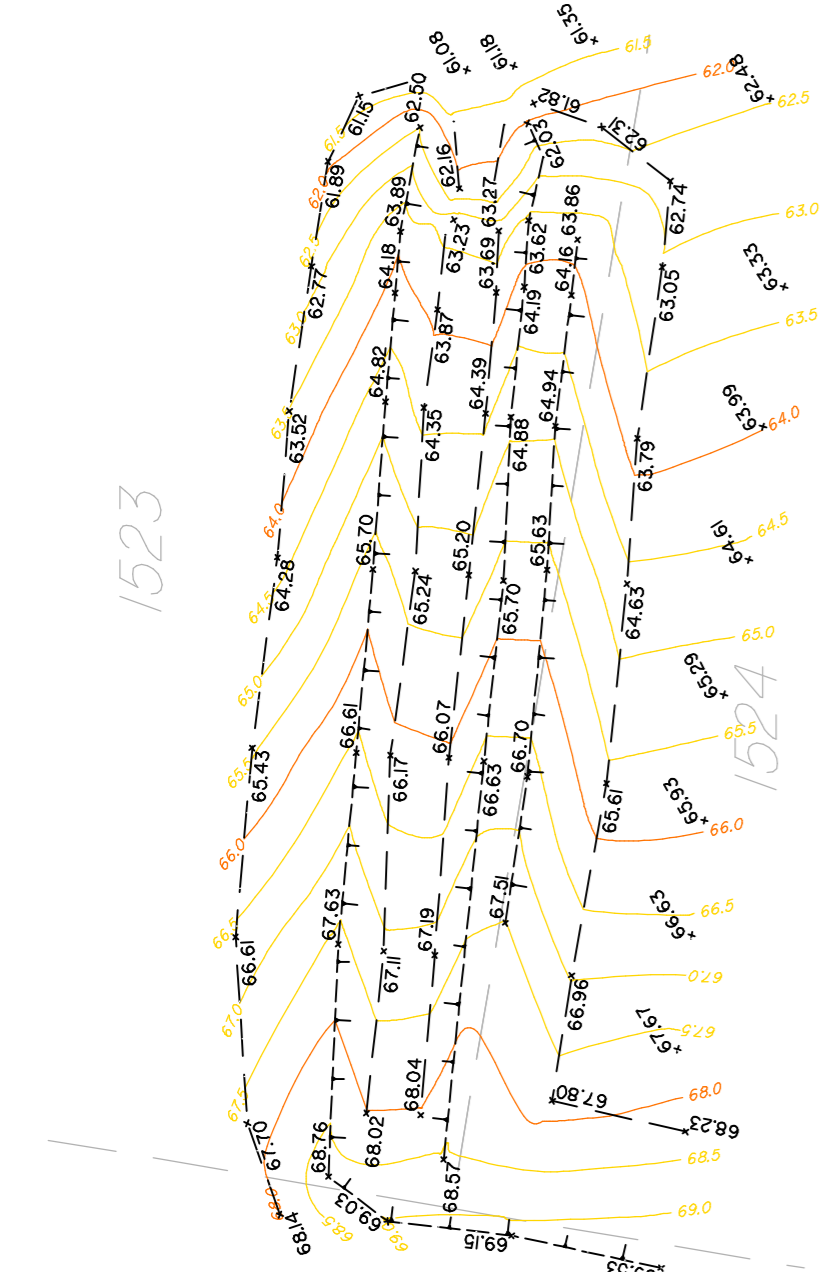


DIAGRAM

Scale 1 : 500 @ A1 paper size - Lengths are : Metres.

0 10 20 30 40 50 60 70 80 90 100 110 120 130 140



<p>REGISTERED SURVEYOR'S CERTIFICATION :</p> <p>I, Bruce Victor DALTON hereby certify that the vertical and horizontal locations, and dimensions, and this drawing has been accurately prepared, and I or my authorised representatives have inspected the works at all stages of construction.</p> <p>I certify that the works have been constructed in accordance with the approved drawings, the Logan Planning Scheme 2006 and any relevant planning scheme policies and standards specifications.</p> <p>Signed: Date: 21/6/2019 For and on behalf of Schlenker Surveying (Qld) Pty. Ltd.</p>	<p>CONSULTING ENGINEER'S CERTIFICATION :</p> <p>I, I state that the works described on this drawing have been constructed under my supervision, and I or my authorised representatives have inspected the works at all stages of construction.</p> <p>I certify that the works have been constructed in accordance with the approved drawings, the Logan Planning Scheme 2006 and any relevant planning scheme policies and standards specifications.</p> <p>Project Name: Company: RP/CD/CP/Eng Membership No.: Signature: Date:</p>	<p>REGISTERED SURVEYOR'S CERTIFICATION :</p> <p>I, Bruce Victor DALTON hereby certify that the vertical and horizontal locations, and dimensions, and this drawing has been accurately prepared, and I or my authorised representatives have inspected the works at all stages of construction.</p> <p>I certify that the works have been constructed in accordance with the approved drawings, the Logan Planning Scheme 2006 and any relevant planning scheme policies and standards specifications.</p> <p>Signed: Date: 21/6/2019 For and on behalf of Schlenker Surveying (Qld) Pty. Ltd.</p>	<p>REGISTERED SURVEYOR'S CERTIFICATION :</p> <p>I, Bruce Victor DALTON hereby certify that the vertical and horizontal locations, and dimensions, and this drawing has been accurately prepared, and I or my authorised representatives have inspected the works at all stages of construction.</p> <p>I certify that the works have been constructed in accordance with the approved drawings, the Logan Planning Scheme 2006 and any relevant planning scheme policies and standards specifications.</p> <p>Signed: Date: 21/6/2019 For and on behalf of Schlenker Surveying (Qld) Pty. Ltd.</p>
<p>IMPORTANT NOTE:</p> <p>This Plan has been prepared for Logan City Council for the purpose of recording the As Constructed details of a new service constructed under specific Council Approval and should not be used for any other purpose. No report is made on any other service/s, nor any service/s that may exist before or be constructed after, the time of survey, or constructed under any other approval. The property boundaries, easements and lot numbers shown hereon may be proposed only and subject to registration by the Department of Natural Resources & Mines. All property information should be determined from the registered Survey Plans.</p>			
<p>AS CONSTRUCTED LEVELS</p> <p>Spring Mountain Estate, Stage 15A GREENBANK</p> <p>OW / 334 / 2018 RL / 44 / 2008 / E</p> <p>SCALE: 1:500 (@A1) PLAN NO: 15159-72</p> <p>SHEET: 2 OF 2</p>			

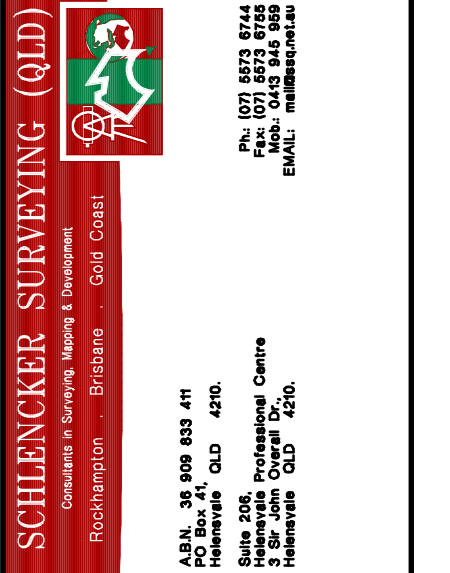

151599.PEET - Spring Mountain 15/10/2019
A:\151599.PEET - Spring Mountain 15/10/2019
A:\151599.PEET - Spring Mountain 15/10/2019
A:\151599.PEET - Spring Mountain 15/10/2019