


**REGISTERED SURVEYOR'S CERTIFICATION**  
 I, Bruce Victor Dalton, hereby certify that the vertical and horizontal locations and dimensions shown on this plan are a true and correct record and were located by survey.  
*B. Dalton*  
 Registered Surveyor (sig) Reg Surveyor No. 3239 Date: 10/08/2018  
 of Schlencker Surveying (Qld) Pty Ltd

**ENGINEER'S CERTIFICATION**  
 I, G. Klemke, hereby certify that:  
 1. The information contained in this drawing / document is in compliance with approved drawings and design.  
 2. The new water and sewerage works defined by this drawing have been designed and constructed in accordance with the SEO Code.  
 3. This represents an accurate record of as-constructed works.  
 4. I accept responsibility for the information contained in this drawing / document.  
*G. Klemke*  
 RPEQ (signature) RPEQ No. 980 Date: 13/8/18

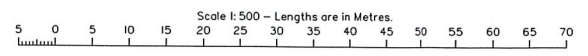

**NOTES**

**SCHLENCKER SURVEYING (QLD)**  
 Gold Coast • Brisbane  
 Consultants in Surveying, Mapping & Development  
 Suite 208, Helensvale Professional Centre, 3 Sir John Overell Dr., Helensvale QLD 4212  
 Ph: (07) 5573 6744 Fax: (07) 5573 6755 Mob: 0413 945 969 EMAIL: info@sqsl.net.au

Amendments		DETAILS
ISSUE	DATE	INITIAL VERSION
A	10/08/2018	

**PLAN:**  
**PLAN OF AS CONSTRUCTED LOT DETAIL**  
 SPRING MOUNTAIN ESTATE  
 STAGE 17A

OPW NUMBER:	OW / 26 / 2018
LGA:	LOGAN CITY COUNCIL
SUBURB:	NEW BEITH
ORIGIN:	MGA

SCALE:	1:500
DATUM:	AHD
DATE OF SURVEY:	09/07/2018
SURVEYED BY:	SCHLENCKER SURVEYING
DRAWN BY:	QSD

CLIENT:	PEET
PLAN REFERENCE:	15159-43


ISSUE	A
SHEET	1 OF 2



Table of mm  
440  
430  
420  
**REGISTERED SURVEYOR'S CERTIFICATION**  
 I, Bruce Victor Dalton, hereby certify that the vertical and horizontal locations and dimensions shown on this plan are a true and correct record and were located by survey.  
B.V. Dalton  
 Registered Surveyor (sig) Reg. Surveyor No. 3239 Date: 10/08/2018  
 \* of Schlencker Surveying (Qld) Pty Ltd

**ENGINEER'S CERTIFICATION**  
 I, G. Greenhalgh, hereby certify that:  
 1. The information contained in this drawing / document is in compliance with approved drawings and design.  
 2. The new water and sewerage works defined by this drawing have been designed and constructed in accordance with the SEQ Code.  
 3. This represents an accurate record of as-constructed works.  
 4. I accept responsibility for the information contained in this drawing / document.  
G. Greenhalgh  
 RPEQ (signature) RPEQ No. 17000 Date: 13-8-18

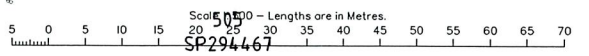

**NOTES**

**SCHLENCKER SURVEYING (QLD)**  
 Gold Coast • Brisbane  
 Consultants in Surveying, Mapping & Development  
 A.B.N. 56 909 833 411  
 PO Box 41, Hensvale QLD 4212  
 Suite 206, Hensvale Professional Centre  
 3 Sir John Overall Dr, Hensvale QLD 4212  
 Ph: (07) 5572 6744  
 Fax: (07) 5572 6756  
 Mob: 0413 945 959  
 EMAIL: [me@schlencker.com.au](mailto:me@schlencker.com.au)

Amendments		DETAILS
ISSUE	DATE	INITIAL VERSION
A	10/08/2018	

PLAN:  
**PLAN OF AS CONSTRUCTED LOT DETAIL**  
 SPRING MOUNTAIN ESTATE  
 STAGE 17A

OPW NUMBER: OW / 26 / 2018  
 LGA: LOGAN CITY COUNCIL  
 SUBURB: NEW BEITH  
 ORIGIN: MGA

SCALE: 1:500  
 DATUM: AHD  
 DATE OF SURVEY: 09/07/2018  
 SURVEYED BY: SCHLENCKER SURVEYING  
 DRAWN BY: QSD

CLIENT: PEET  
 PLAN REFERENCE: 15159-43

ISSUE: A  
 SHEET: 2 OF 2