


REGISTERED SURVEYOR'S CERTIFICATION
 I, Bruce Victor Dalton, hereby certify that the vertical and horizontal locations and dimensions shown on this plan are a true and correct record and were located by survey.
 Registered Surveyor (Sig) Reg. Surveyor No. 3339 Date: 10/08/2018
 * of Schlencker Surveying (Qld) Pty Ltd

ENGINEER'S CERTIFICATION
 I, [Signature], hereby certify that:
 1. The information contained in this drawing / document is in compliance with approved drawings and design.
 2. The new water and sewerage works defined by this drawing have been designed and constructed in accordance with the SEQ Code.
 3. This represents an accurate record of as-constructed works.
 4. I accept responsibility for the information contained in this drawing / document.
 Date: 13.8.18

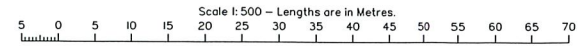

SCHLENCKER SURVEYING (QLD)
 Gold Coast • Brisbane
 Consultants in Surveying, Mapping & Development

A.B.N. 36 909 833 411
 PO Box 41, Helensvale QLD 4212
 Suite 206, Helensvale Professional Centre
 3 Sir John Oxley Dr, Helensvale QLD 4212

Ph: (07) 5573 8744
 Fax: (07) 5573 8755
 Mob: 0413 945 959
 EMAIL: info@scs.net.au

Amendments		DETAILS
ISSUE	DATE	INITIAL VERSION
A	10/08/2018	

PLAN:
PLAN OF AS CONSTRUCTED STORMWATER
 SPRING MOUNTAIN ESTATE
 STAGE 17A

OPW NUMBER: OW / 26 / 2018
 LGA: LOGAN CITY COUNCIL
 SUBURB: NEW BEITH
 ORIGIN: MGA

SCALE: 1:500
 DATUM: AHD
 DATE OF SURVEY: 09/07/2018
 SURVEYED BY: SCHLENCKER SURVEYING
 DRAWN BY: QSD

CLIENT: PEET
 ISSUE: A
 PLAN REFERENCE: 15159-41
 SHEET: 1 OF 1