

Scale 1 : 500 @ A1 paper size - Lengths are : Metres.

**AS CONSTRUCTED**  
**STORMWATER**  
 Spring Mountain Estate, Stage 11A  
 GREENBANK  
 RL / 94 / 2008 / A  
 OW / 218 / 2010

SURVEYOR : PAN  
 DRAWN BY : SPR  
 CHECKED BY : LOGAN  
 LOCAL AUTHORITY : LOGAN  
 PARISH : STAPYLTON  
 COUNTY : STANLEY  
 LEVEL DATUM : AHD Der  
 LEVEL ORIGIN : RL98.148

3. I certify the approved drawings have been carefully checked and dimensions and this drawing has been amended; all respects as to constitute a true record of the works.  
 Project Name :  
 Consultant :  
 RPEQ/CP/Eng Membership No. :  
 Date :  
 Signature :  
 Date :

Consulting Engineer's Certification :  
 1. I state the the works described on this drawing have been constructed under my supervision, and I or my authorised representatives have inspected the works at all stages of construction.  
 2. I certify that the works have been constructed in accordance with the Logan Planning Scheme 2006 and any relevant planning scheme policies and standards specifications.

Registered Surveyor's Certification :  
 Bruce Victor DALTON hereby certify that the vertical and horizontal locations, and dimensions shown on this plan are a true and correct record of the As Constructed information.  
 Signed :  
 Date 6/10/2015  
 For and on behalf of Schlenker Surveying (Qld) Pty. Ltd.


**SCHLENCKER SURVEYING (QLD)**  
 Contains a Service Marking & Document  
 Gold Coast  
 Brisbane  
 Gold Coast  
 A.B.N. 25 809 833 411  
 Suite 2006 Professional Centre  
 3/80 James Street QLD 4210  
 Phone 07 5522 4444  
 Fax 07 5522 4444  
 Email info@schlenckersurveying.com.au

**IMPORTANT NOTE:**  
 This plan has been prepared for Logan City Council for the purpose of recording the As Constructed details of a new service constructed under specific Council Approval and should not be used for any other purpose. No report is made on any other service/s, nor any service/s that may exist before or be constructed after, the time of survey, or constructed under any other approval. The property boundaries, easements and lot number shown hereon may be proposed, altered, amended and subject to registration by the Department of Natural Resources & Mines. All property information should be determined from the registered Survey Plans.

THIS NOTE IS AN INTEGRAL PART OF THIS PLAN.

REVISIONS	DATE	BY	CHKD
A MINOR AMENDMENTS	6.10.15	SPR	BVD



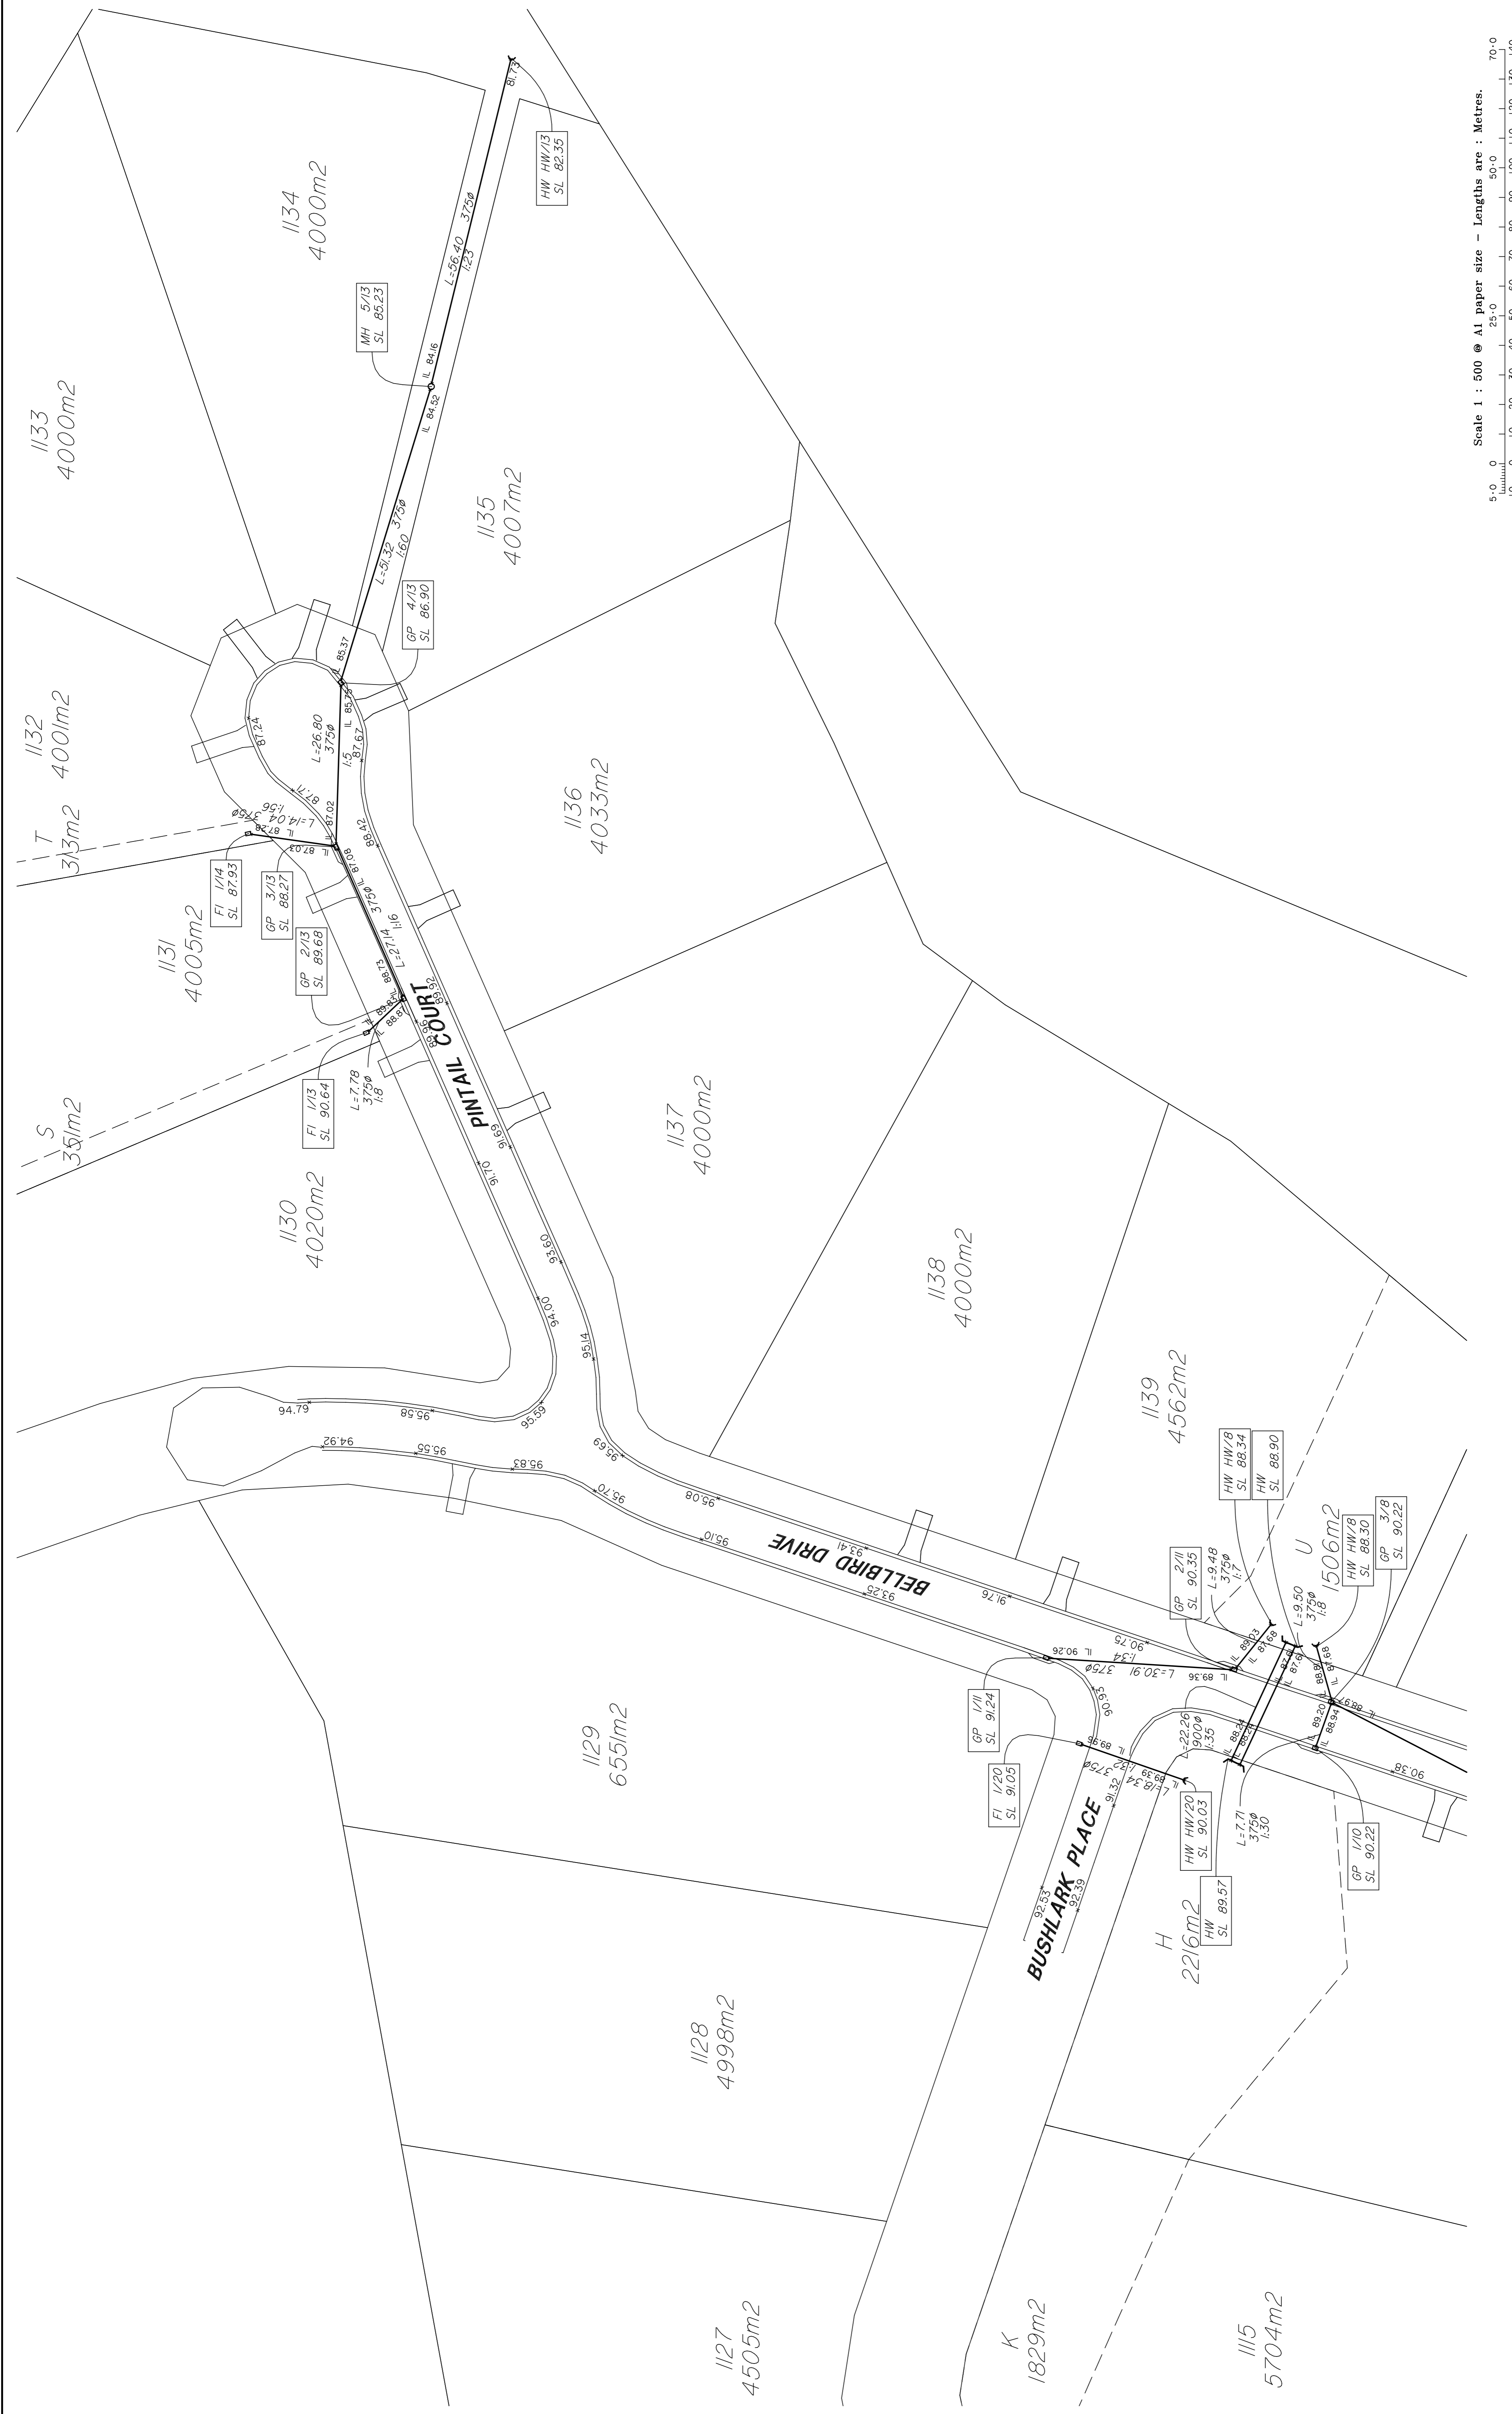

Scale 1 : 500 @ A1 paper size - Lengths are : Metres.

**AS CONSTRUCTED STORMWATER**  
 Spring Mountain Estate, Stage 11A  
 GREENBANK  
 RL / 94 / 2008 / A  
 OW / 218 / 2010

**CONSULTING ENGINEER'S CERTIFICATION:**  
 1. I state the works described on this drawing have been constructed under my supervision, and I or my authorised representatives have inspected the works at all stages of construction.  
 2. I certify that the works have been constructed in accordance with the Logan Planning Scheme 2006 and any relevant planning scheme policies and standards specifications.

**REGISTERED SURVEYOR'S CERTIFICATION:**  
 Bruce Victor DALTON hereby certifies that the vertical and horizontal locations, and dimensions shown on this plan are a true and correct record of the As Constructed information.

**IMPORTANT NOTE:**  
 This plan has been prepared for Logan City Council for the purpose of recording the As Constructed details of a new service constructed under specific Council Approval and should not be used for any other purpose. No report is made on any other service/s, nor any service/s that may exist before or be constructed after, the time of survey, or constructed under any other approval. The property boundaries, easements and lot number shown hereon may be proposed, or subject to registration by the Department of Natural Resources & Mines. All property information should be determined from the registered Survey Plans.

**MINOR AMENDMENTS:** 6.10.15 SPR. BVD  
 DATE BY CHKD THIS NOTE IS AN INTEGRAL PART OF THIS PLAN.

Printed Oct 7 2008 10:26:44 AM  
 SHEET : 2 OF 2  
 SCALE: 1:500 (A1)  
 PLAN NO: 14030-15