


WARNING


THE LOCATIONS OF UNDERGROUND SERVICES ARE APPROXIMATE ONLY AND THEIR EXACT POSITION SHOULD BE PROVEN ON SITE. NO GUARANTEE IS GIVEN THAT ALL EXISTING SERVICES ARE SHOWN.

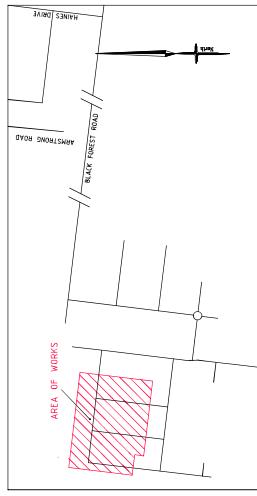

LOCALITY PLAN

These plans are design plans and are indicative only and parties must not make any objection, requisition or claim for compensation in relation to the plans. The final condition of lots upon completion may vary from the condition described in the plans.

The Property may have been filed, raised, levelled, compacted or cut prior to the Vendor becoming registered proprietor of the Property and the condition of the Property may change after completion of works due to circumstances beyond the Vendor's control. No warranty or representation is given or to be construed in respect of such works or changes in condition. Parties should review the plans carefully, make their own inquiries and obtain independent advice before taking any action in relation to the Property.

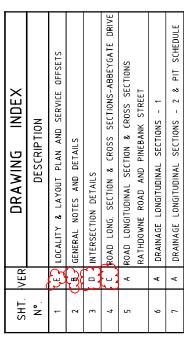

ALL LENGTHS ARE IN METRES

SERVICES OFFSETS AND LOCATIONS

STREET	NAME	ROAD RESERVE (IN) ^a	WATER PIPE (IN)	WATER PIPE (IN)	GAS PIPE (IN)	ELECTRICITY CABLES (IN)	POLES	TELECOM PIPE (IN)	BACK OF TRENCH	JOINT PIPE (IN)
ABBEY GATE DRIVE	ABBEY GATE DRIVE ALONG DRAINE RESEVE	14.50	270 W	270 E	225 E	115 M	0.80 BOK	0.65 M	4.35 E	2.55 W
ABBEY GATE DRIVE	ABBEY GATE DRIVE ALONG DRAINE RESEVE	16.00	270 N	320 N	225 N	260 S	0.80 BOK	185 S	4.35 S	2.55 N
PINEBANK STREET	PINEBANK STREET	16.00	270 W	320 W	225 W	260 E	0.80 BOK	185 E	4.35 W	2.55 W
RAHTONNE ROAD	RAHTONNE ROAD	16.00	270 W	320 W	225 W	260 E	0.80 BOK	185 E	4.35 W	2.55 W

10 of 10

on pty. ltd.	ESTATE	WYNDHAM	£ / 05
engineers			
1/9, Gato Street Telephone 8823 2500 Fax no. 8823 2310	1/9, Gato Street 3173 Telephone 8823 2500 Fax no. 8823 2310	MUNICIPALITY	REFERENCE 8890