

CIVIL GEOTECHNICAL SERVICES ABN 26 474 013 724 PO Box 678 Croydon Vic 3136 Telephone: 9723 0744 Facsimile: 9723 0799

16th March 2016

Our Reference: 15321:DK136

Winslow Constructors Pty Ltd 50 Barry Road CAMPBELLFIELD VIC 3061

Dear Sirs,

RE: LEVEL 1 EARTHWORKS INSPECTION AND TESTING LIVINGSTON ESTATE (STAGE 13) – CRANBOURNE

Please find attached our Report Nos 15321/R001 to 15321/R002 that relate to the field density testing that was conducted within the filled allotments at the above subdivision. The level 1 inspections and associated field density testing commenced in early July 2015 and was completed in late July 2015.

The inspections and testing of the earthworks was undertaken in general accordance with the Level 1 requirements of AS 3798 - Guidelines on Earthworks for Commercial and Residential Developments.


The site inspections and testing was performed by an experienced geotechnician from this office. Any areas that were deemed unsatisfactory were reworked and retested under their supervision. The testing was performed to the relevant Australian Standards and the accompanying test reports carry NATA endorsement. The attached compaction results, which were located randomly throughout the fill profile, are considered to be representative of the bulk fill materials that were placed across the filled allotments by Winslow Constructors during the aforementioned period. The approximate locations of the field density tests can be seen on the attached plan (Figure 1).

We are of the view that the bulk fill materials that have been placed across the filled allotments by Winslow Constructors during the aforementioned period can be considered as having been placed in a controlled manner to a minimum density ratio of 95% (standard compactive effort).

Please contact the undersigned if you require any additional information.

Civil Geotechnical Services

Dino Kondzic

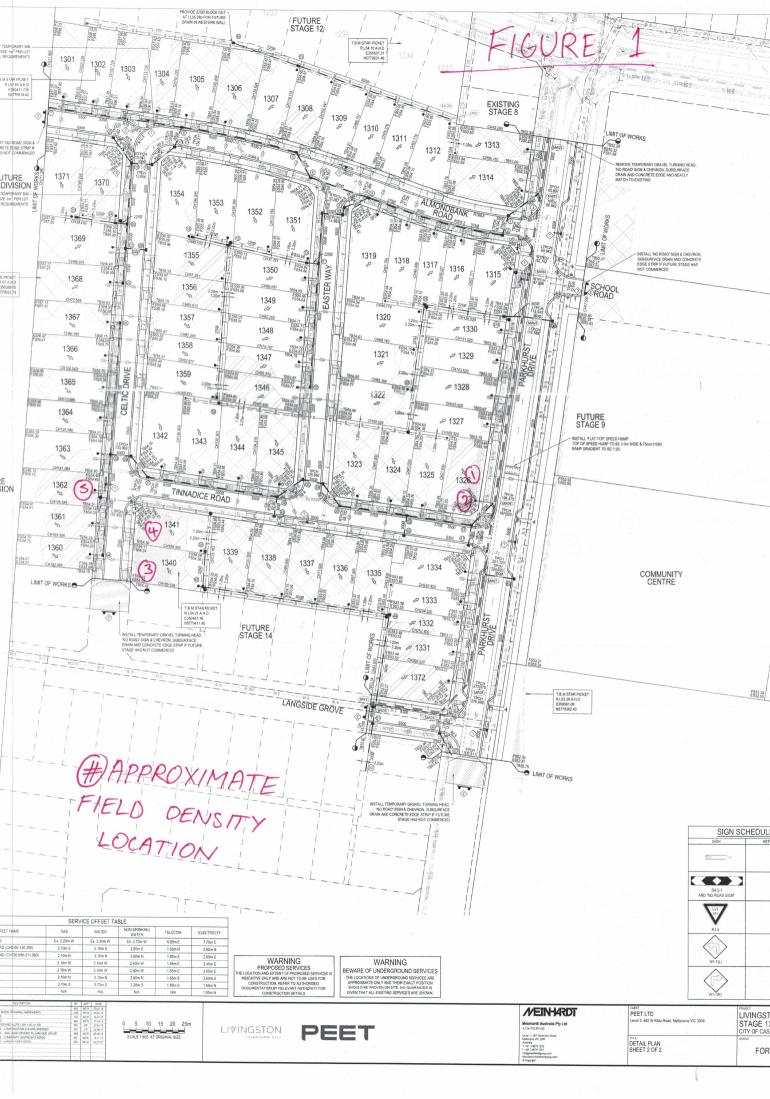



COMPACTION ASSESSMENT

Test procedure AS 12	WORKS		Laye	er thickness	200		Checked by Time	JHF 11:00
TaafNa	289.2.1.1 & 5.8.	1						
Test No			1	2	3	-	-	-
			REFER TO FIGURE 1	REFER TO FIGURE 1	REFER TO FIGURE 1			
Approximate depth belo	ow FSL							
Measurement depth		mm	175	175	175	-	-	-
Field wet density Field moisture content		t/m³ %	1.80 38.1	1.75 40.2	1.72 38.4	-	-	-
Test procedure AS 12 Test No Compactive effort	289.5.7.1		1	2	3 Stan	- dard	-	-
Oversize rock retained	on sieve	тт	19.0	19.0	19.0	-	-	-
Percent of oversize ma		wet	0	0	0	-	-	-
Peak Converted Wet D	ensity	t∕m³	1.74	1.70	1.68	-	-	-
Adjusted Peak Converted Wet Density		t∕m³	-	-	-	-	-	-
Optimum Moisture Con	tent	%	38.5	39.0	39.0	-	-	-
Moisture Variat Optimum Moistu			0.5% dry	1.0% wet	0.5% dry	-	-	-
Density Ratio(R _{HD})		%	103.5	103.0	102.0	-	-	-

ACCREDITED FOR TECHNICAL COMPETENCE

Funder 12 C

Approved Signatory : Justin Fry



COMPACTION ASSESSMENT

CIVIL GEOTECHNICAL SERVICES - 8 Rose Avenue, Croydon 3136 Client WINSLOW CONSTRUCTORS PTY LTD (CAMPBELLFIELD) Project UVINCETON								15321 15321/R00 / 17/08/15 JWM
Project Location	LIVINGSTON - STAGE 13 CRANBOURNE						Date tested Checked by	
Feature	EARTHWORKS		Layer thickness		200 mm		<i>Time:</i> 09:00	
-	lure AS 1289.2.1.1 & 5.8.	.1						
Test No			4	5	-	-	-	-
			REFER TO FIGURE 1	REFER TO FIGURE 1				
Approximate	depth below FSL							
Measuremen	-	тт	175	175	-	-	-	-
Field wet der Field moistur		t/m³ %	1.72 33.8	1.83 33.3	-	-	-	-
Test proced Test No Compactive (lure AS 1289.5.7.1		4	5	- Stand	- lard	-	-
	k retained on sieve	тт	19.0	19.0	-	-	-	-
Percent of ov	/ersize material	wet	0	0	-	-	-	-
Peak Converted Wet Density		t∕m³	1.81	1.79	-	-	-	-
Adjusted Peak Converted Wet Density		t∕m³	-	-	-	-	-	-
	isture Content	%	33.0	33.0	-	-	-	-
Optimum Mo			-	0.5%	-	-	-	-
Mois	ture Variation From		0.5%	0.5%				
Mois	ture Variation From num Moisture Content		0.5% wet	wet				

NATA TECHNICAL COMPETENCE The results of the tests, calibrations and/or measurements included in this document are traceable to Australian/National standards. Accredited for compliance to ISO/IEC 17025. Accreditation No 9909

Approved Signatory : Justin Fry